


O.D.O.T. DISTRICT 2 SURVEY OFFICE (USE ONLY)


PERSONNEL _____ REFERENCE NO. 43 SHEET 46 OF 54
 NOTES RHOADES DATE 9/13/16 ROUTE SR 105
 H.C. O'DONNELL WEATHER FAIR COUNTY WOOD
 R.C. TODD TEMP. 58° TOWNSHIP WEBSTER
 _____ SECTION 7
 _____ T 5 N R 11 E

TYPE MONUMENT P.K.NAIL
 ON SURFACE - ~~BELOW~~ ON _____
 LEFT - ☉ PAV'T - RIGHT ON _____
9.9' TO RT EDGE PAVEMENT
 S.L.M. 290+80

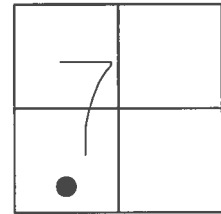

GRID: NORTHING: 633264.686 EASTING: 1686379.633


RECORD: P.O.T.
 STA. 291+99.90
 FD P.K./WASHER
 4/15/02, DCH
 SET P.K./WASHER
 6/13/02, DCH
 FD P.K.NAIL
 REF43
 6/10/16, JFO
 SET 1" MAG/WASHER
 8/2/17, DCH

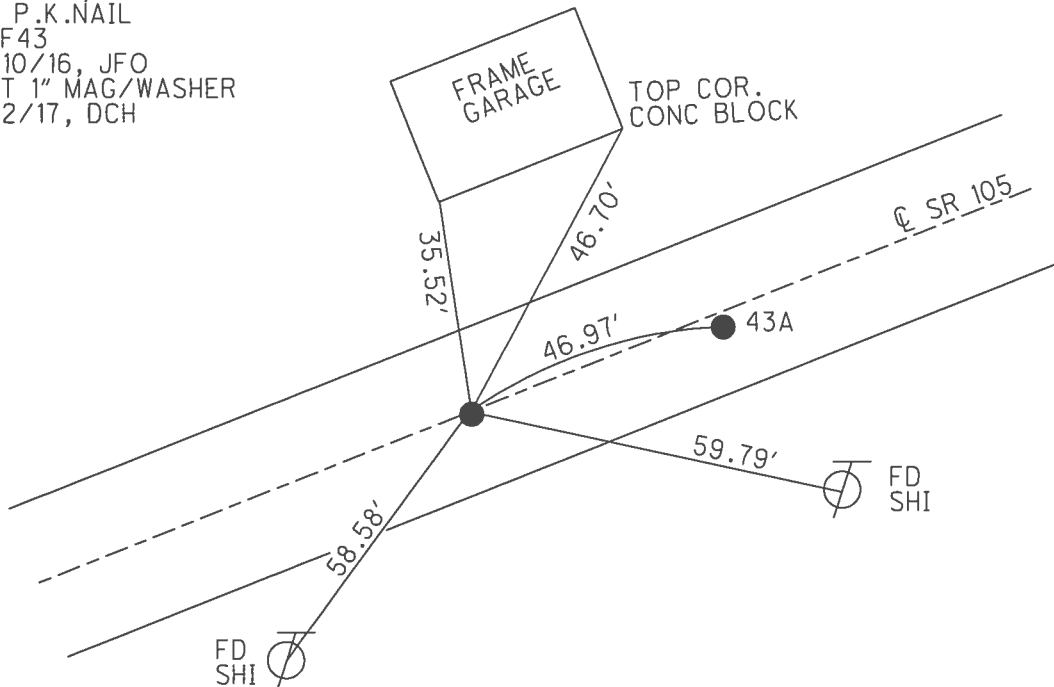

O.D.O.T. DISTRICT 2 SURVEY OFFICE (USE ONLY)


PERSONNEL _____ REFERENCE NO. 43 SHEET 46 OF 54
 NOTES ROUSOS DATE 4/15/02 ROUTE SR 105
 H.C. HOMAN WEATHER SUNNY COUNTY WOOD
 R.C. BROWN TEMP. 74° TOWNSHIP WEBSTER
 _____ SECTION 7
 _____ T 5 N R 11 E

TYPE MONUMENT P.K./WASHER
 ON SURFACE - ~~BELOW~~ ON _____
 LEFT - ☉ PAV'T - RIGHT ON _____
9.9' TO RT EDGE PAVEMENT
 S.L.M. 290+80

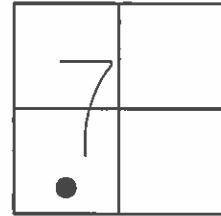

GRID: NORTHING: _____ EASTING: _____

RECORD: P.O.T.
 STA. 291+99.90
 SET P.K./WASHER
 6/13/02, DCH

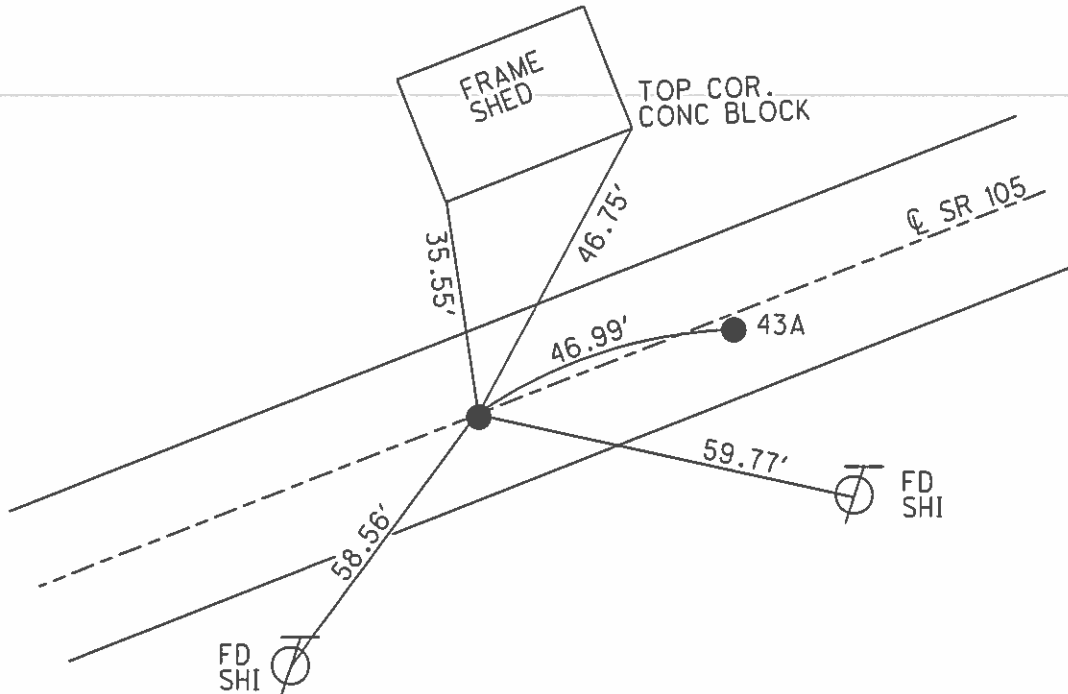

O.D.O.T. DISTRICT 2 SURVEY OFFICE

PERSONNEL _____

REFERENCE NO. 43

SHEET 53 OF 57

NOTES LONG

H.C. VANDUSEN

R.C. BARNHISEL

DATE 8-27-91

WEATHER SUNNY

TEMP. 88°

ROUTE 105

COUNTY WOOD

TOWNSHIP WEBSTER

SECTION 7

T 5 N R 11 E



TYPE MONUMENT P.K. Washer ~ PT. "A"

ON SURFACE - BELOW YES

~~LEFT~~ - PAV'T. - RIGHT YES

9.9 TO RT EDGE PAVEMENT

S.L.M. 290+80

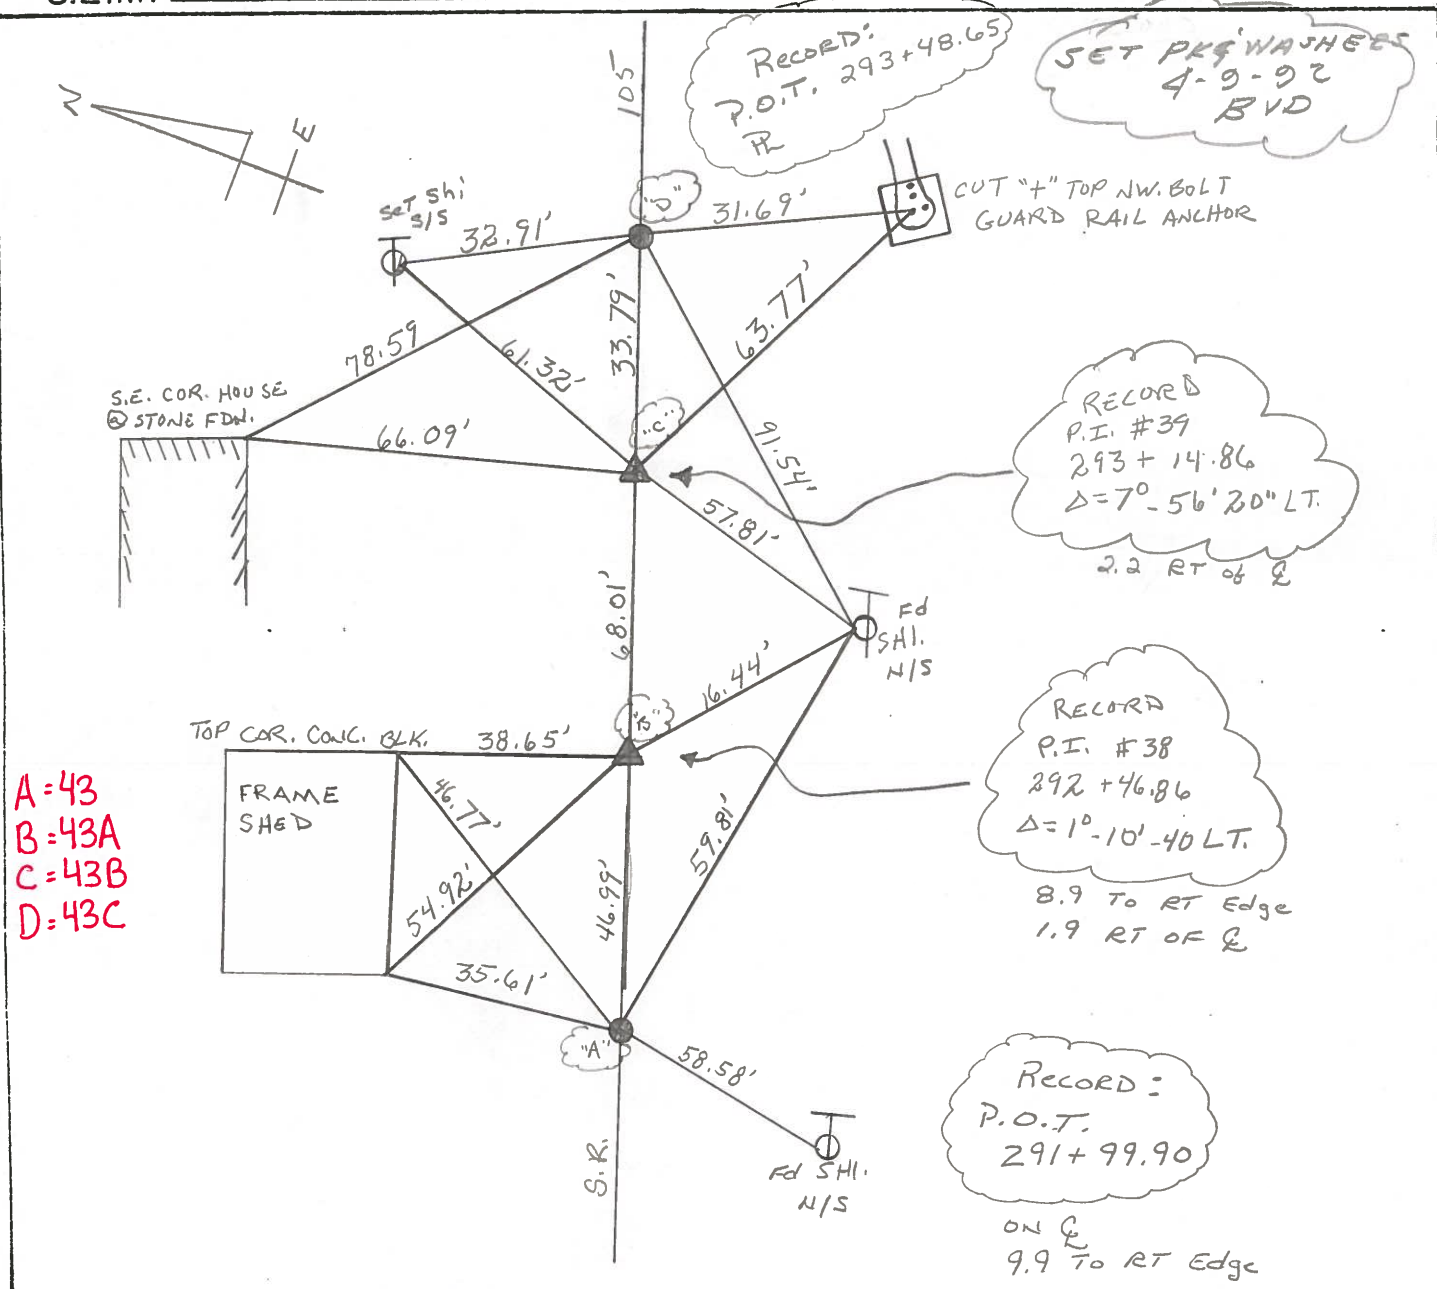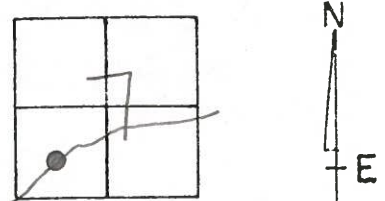

A=43
B=43A
C=43B
D=43C

RECORD:
P.O.T. 293+48.65
R

SET PK'S WASHERS
4-9-92
BVD

RECORD
P.I. #39
293+14.86
 $\Delta=7^{\circ}-56'-20''$ LT.
2.2 RT of \mathcal{Q}

RECORD
P.I. #38
292+46.86
 $\Delta=1^{\circ}-10'-40''$ LT.
8.9 To RT Edge
1.9 RT OF \mathcal{Q}

RECORD:
P.O.T.
291+99.90
ON \mathcal{Q}
9.9 To RT Edge

County WOOD S.R. 105

Date 4-21-82

Township WEBSTER

Weather WINDY

Section 7

Temp. +45°


T, N, R, E

Personnel HOFFMAN


HOUSEHOLDER

LOEHRKE

#43

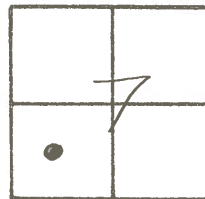

A=43
B=43A
C=43B
D=43C

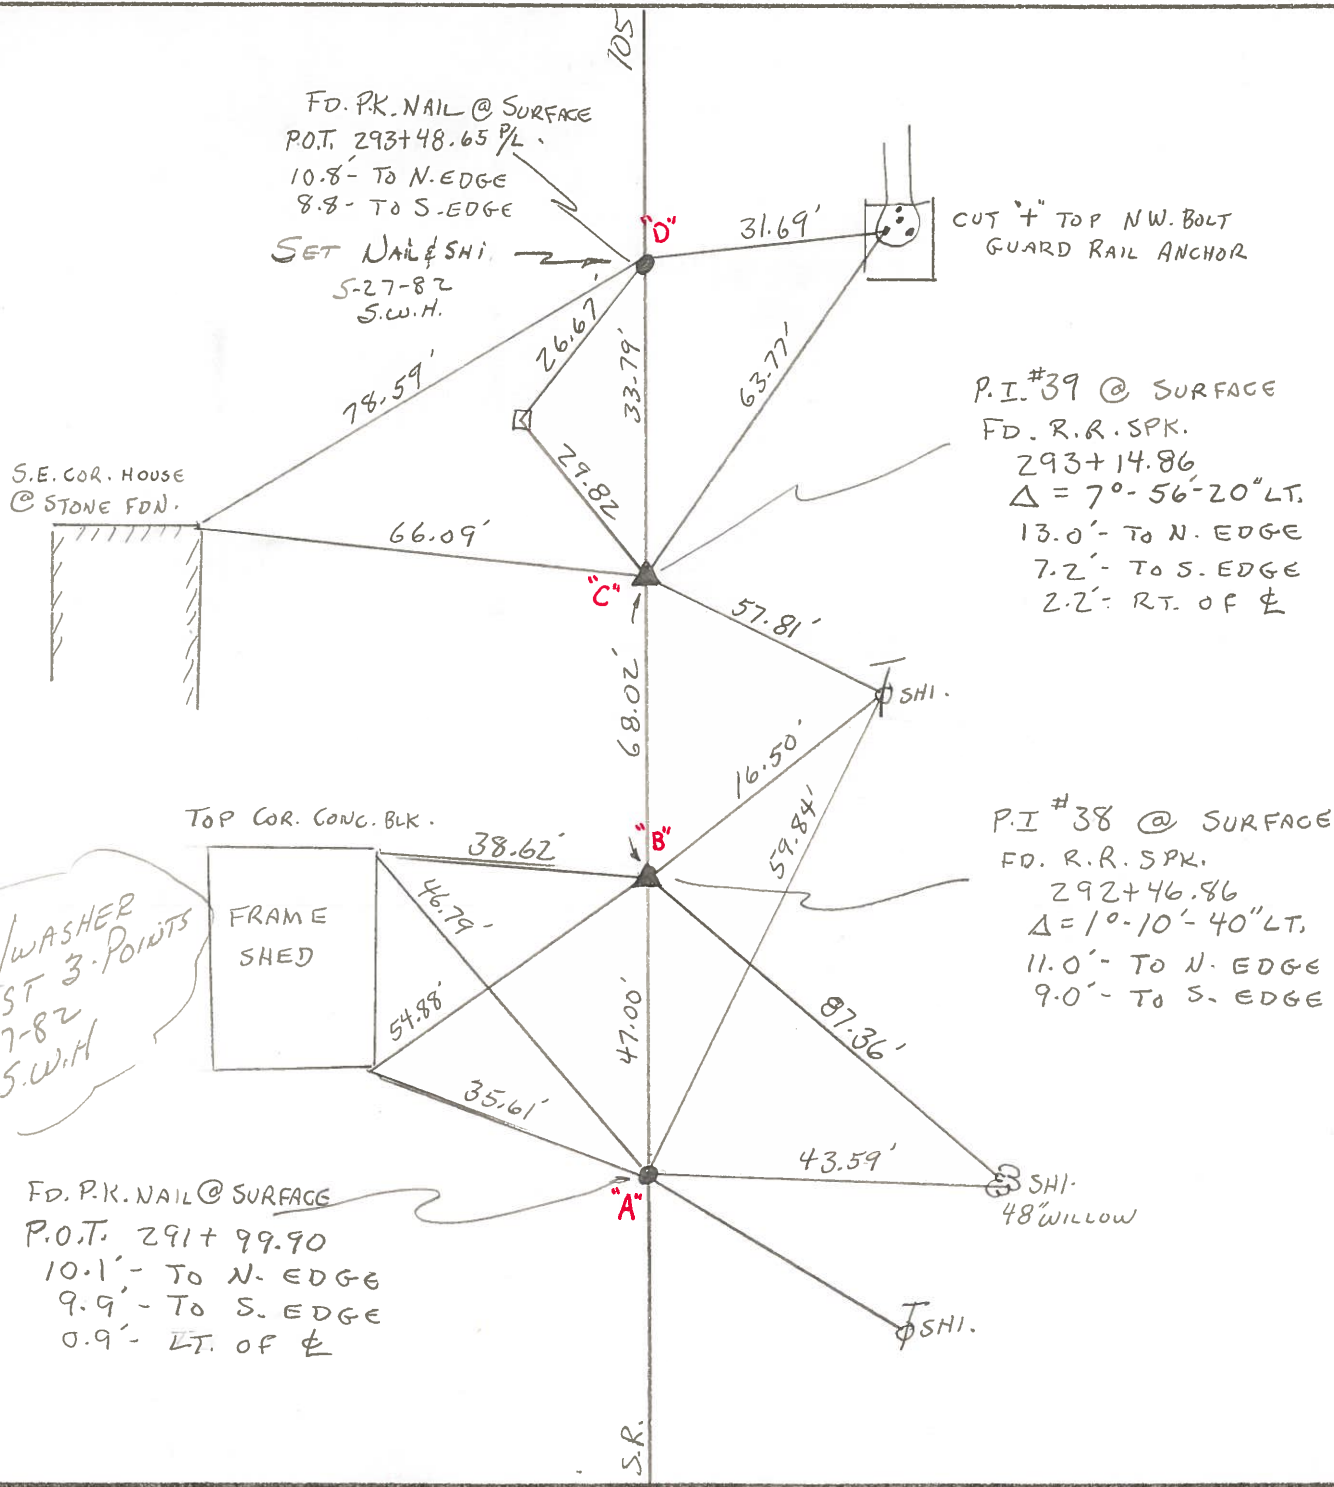

PERSONNEL TITLE PERSONNEL TITLE

COUNTY Wood DATE 16 July 73

Stone Brennan

S. R. #105 WEATHER Fair

Michalski

SEC. Webster Twp. TEMP. 78°

Dennis

Curtis

DESCRIPTION References to Control Points JOB NO.

