


O.D.O.T. DISTRICT 2 SURVEY OFFICE (USE ONLY)

PERSONNEL	REFERENCE NO. <u>51</u>	SHEET <u>2</u> OF <u>33</u>
NOTES <u>RHOADES</u>	DATE <u>6/12/13</u>	ROUTE <u>SR 105</u>
H.C. <u>CODER</u>	WEATHER <u>FAIR</u>	COUNTY <u>WOOD</u>
R.C. <u>RHOADES</u>	TEMP. <u>68°</u>	TOWNSHIP <u>WEBSTER</u>
		SECTION <u>7</u>
		T <u>5</u> N R <u>12</u> E

TYPE MONUMENT P.K./WASHER
 ON SURFACE - ~~BELOW~~ ON
~~LEFT~~ - CL PAV'T - RIGHT 2.7'
5.7' TO RT EDGE PAVEMENT
 S.L.M. 310+95
 Grid: Northing: 634219.191 Easting: 1688133.354

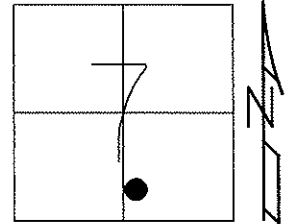


RECORD P.O.T.
 STA. 312+45.00

SET P.K./WASHER
 6/13/02, DCH

FD P.K./WASHER
 GPS, REF51
 10/11/11, RJL

SET MAG/WASHER
 GPS, FINREF51
 10/3/13, SDC

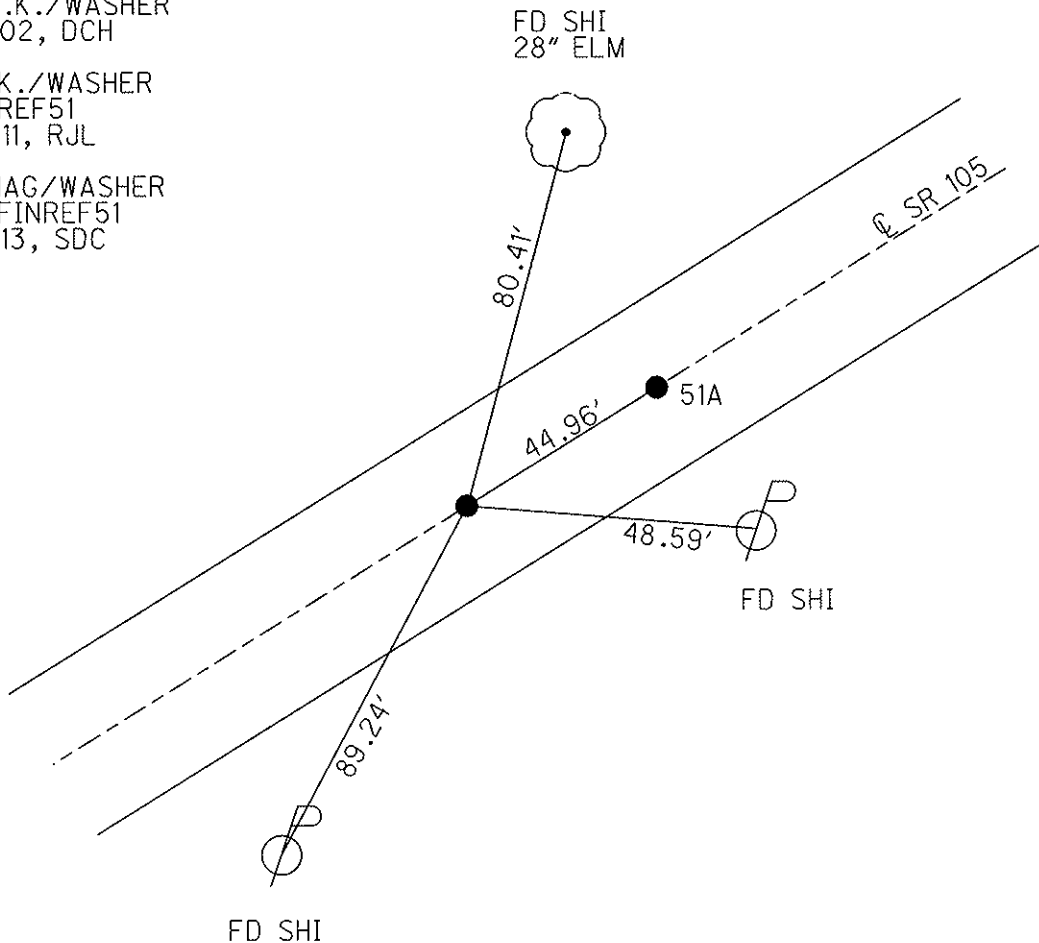

O.D.O.T. DISTRICT 2 SURVEY OFFICE

PERSONNEL

REFERENCE NO. 51

SHEET 60 OF 63

NOTES ROUSOS

DATE 4-16-02

ROUTE SR 105

H.C. HOMAN

WEATHER SUNNY

COUNTY WOOD

R.C. BROWN

TEMP. 70°

TOWNSHIP WEBSTER

SECTION 13

T 5 N R 12 E


TYPE MONUMENT PK'S & WASHER'S

ON SURFACE - ~~BELOW~~ ON SURFACE


LEFT - ℄ PAVT - RIGHT SEE BELOW

TO EDGE PAVEMENT

S.L.M. 310+95 311+40

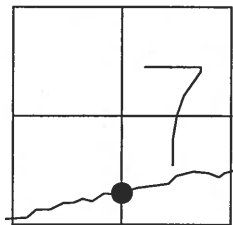

SET PK'S & WASHER'S
6-13-02 D.C.H.

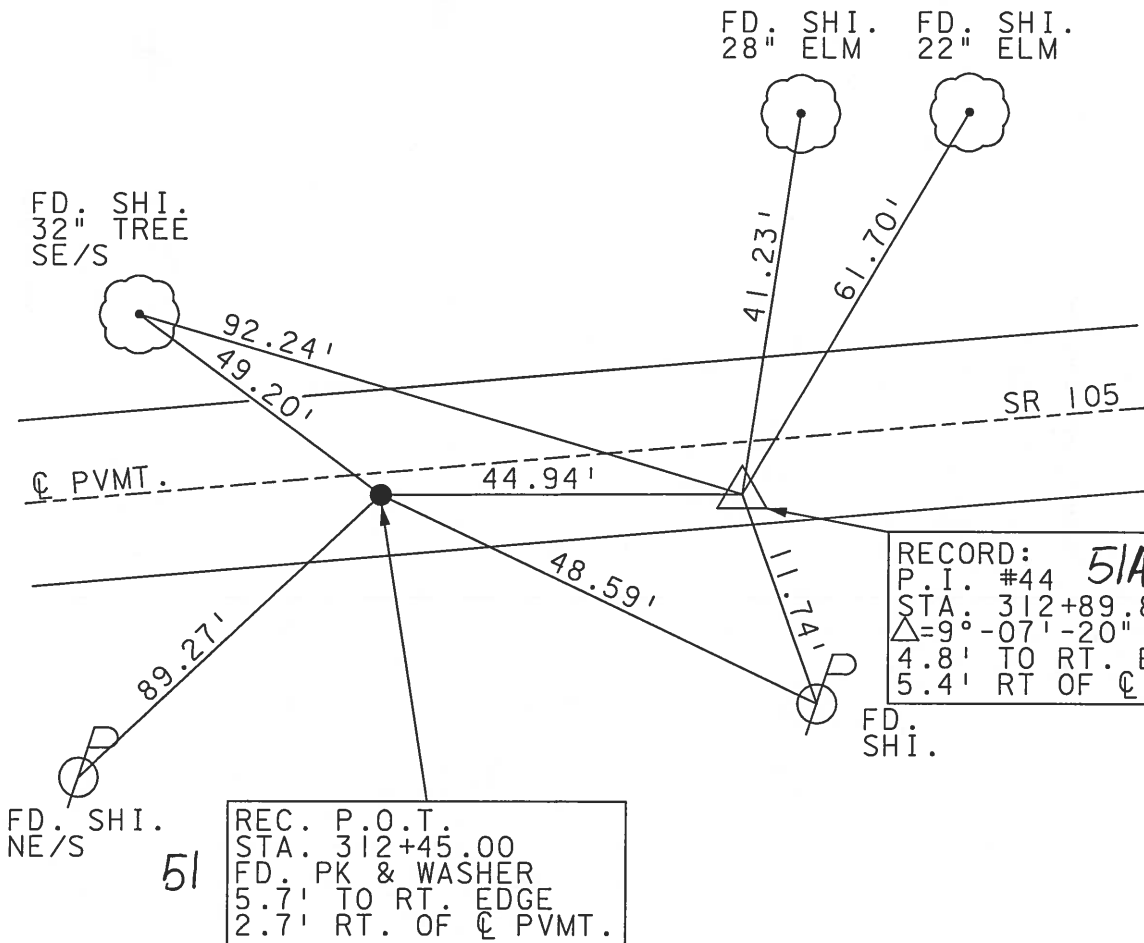

O.D.O.T. DISTRICT 2 SURVEY OFFICE

PERSONNEL _____

REFERENCE NO. 51

SHEET 1 OF 49

NOTES LOEHRKE

H.C. CANTERBURY

R.C. MOSER

DATE 8-1-94

WEATHER FAIR

TEMP. +80

ROUTE S.R.105

COUNTY WOOD

TOWNSHIP WEBSTER

SECTION 7

T. S N. R 12. E

TYPE MONUMENT P.K. / WASHERS



Reset 11-9-94
C.L.

ON SURFACE - BELOW Yes

~~LEFT~~ - Q PAV'T. - RIGHT 2.7 and 5.4

TO EDGE PAVEMENT

S.L.M. 312+45 AND 312+90

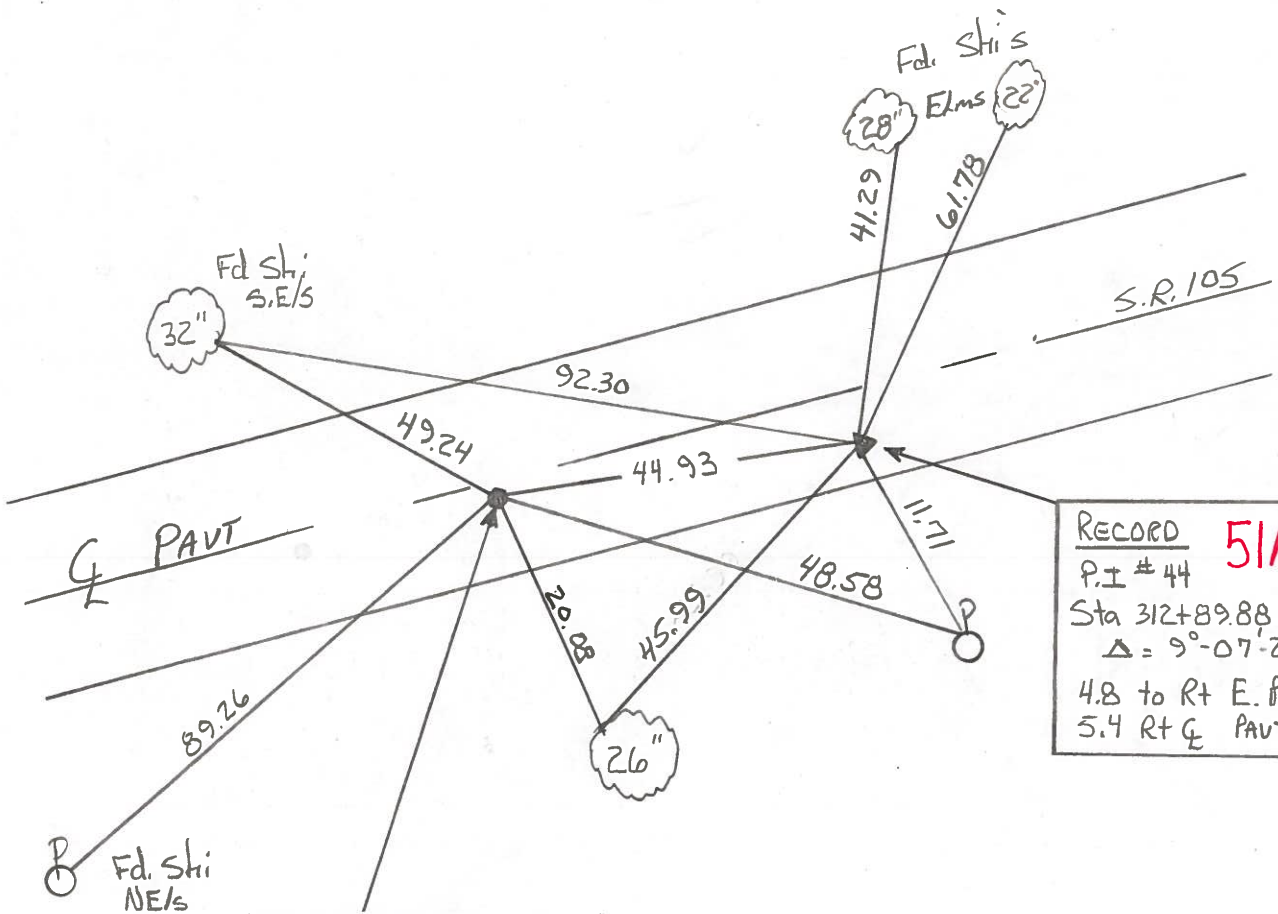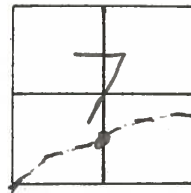

RECORD **51A**
 P.I. # 44
 Sta 312+89.88
 $\Delta = 9^{\circ}-07'-20''$ Lt.
 4.8 to Rt E. PAVT
 5.4 Rt Q PAVT

51

Rec. P.O.T. Sta 312+45.00
 Fd P.K. / WASHER
 5.7' to Rt E. PAVT
 2.7 Rt. of Q PAVT.

Resurveyed 1994

ODOT DISTRICT 2 SURVEY OFFICE

SHEET _____ OF _____

County Wood S.R. 105

Date 5-29-84

Township WEBSTER

Weather CLOUDY

Section 7

Temp. +50°


T5N, R12E

Personnel LOEHRKE II

BARWISSEL HC

HOUSEHOLDER RC

#51

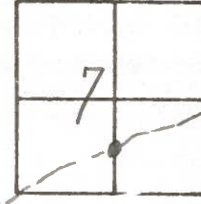

PI #44

PI 311+59


312+89.88

SET PK

9-27-84

C.L.

$\Delta = 9^{\circ} - 07' - 20''$

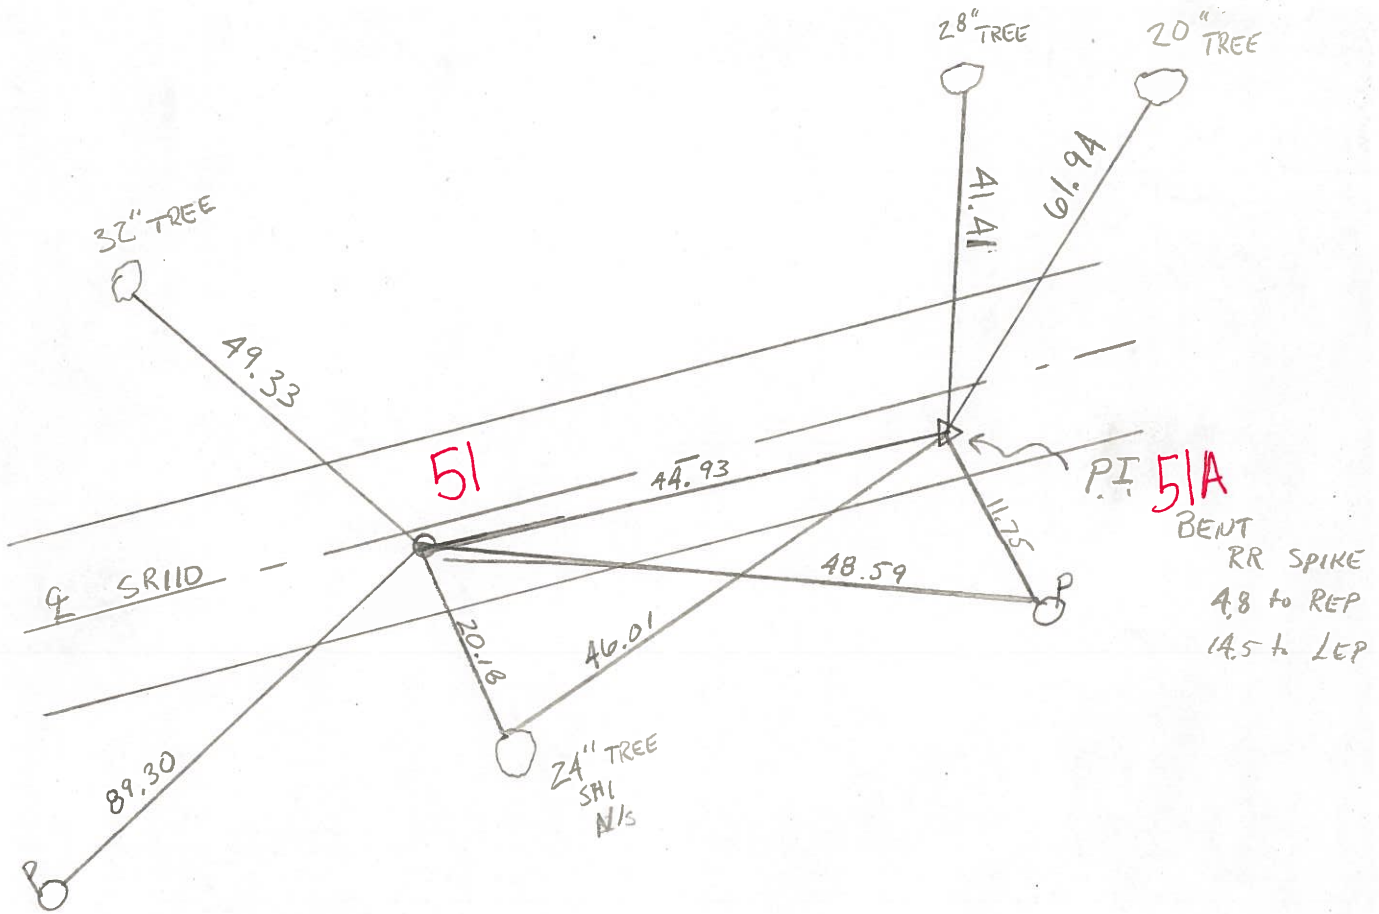

POT

312+45.00

SMALL RR SPIKE

7.0 to REP

12.3 to LEP

County WOOD S.R. 105

Date SEPT. 27-73

Township WEBSTER

Weather MILD

Section 7

Temp. 70°


T_N, R_E

Personnel STONE

MICHALAK

CURTIS

DENNO

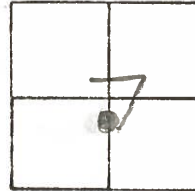

#51

P.I. #44

312+89.88

$\Delta = 9^{\circ}-07'-20''$ LT.

105

SHI. 28" TREE

41.61'

SET R.R. SPK. TO SURFACE
4.8'-TO S. EDGE PVT.
14.5'-TO N. EDGE PVT.

51A

11.49'

P.O.T. 312+45.00

SET SPK. ON

SECTION 7

7.0'-TO S. EDGE PVT.

12.3'-TO N. EDGE PVT.

44.88'

47.34'

46.09'

20.27'

SHI. 24" TREE

51

49.40'

89.21'

SHI. 32" TREE

S.R.