


O.D.O.T. DISTRICT 2 SURVEY OFFICE (USE ONLY)

PERSONNEL	REFERENCE NO. <u>52</u>	SHEET <u>4</u> OF <u>33</u>
NOTES <u>RHOADES</u>	DATE <u>6/12/13</u>	ROUTE <u>SR 105</u>
H.C. <u>CODER</u>	WEATHER <u>FAIR</u>	COUNTY <u>WOOD</u>
R.C. <u>RHOADES</u>	TEMP. <u>68°</u>	TOWNSHIP <u>WEBSTER</u>
		SECTION <u>7</u>
		T <u>5</u> N R <u>12</u> E

TYPE MONUMENT P.K./WASHER
 ON SURFACE - ~~BELOW~~ ON
 LEFT - Q PAV'T - ~~RIGHT~~ 6.0'
- TO - EDGE PAVEMENT
 S.L.M. 314+63

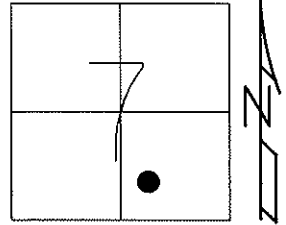


Grid: Northing: 634422.573 Easting: 1688440.087

RECORD P.I.#35
 STA. 316+13.75
 $\Delta = 13^\circ 06' 20''$

SET P.K./WASHER
 6/3/02, DCH

FD P.K./WASHER
 GPS, REF52
 10/11/11, RJL

SET MAG/WASHER
 GPS, FINREF52
 10/3/13, SDC

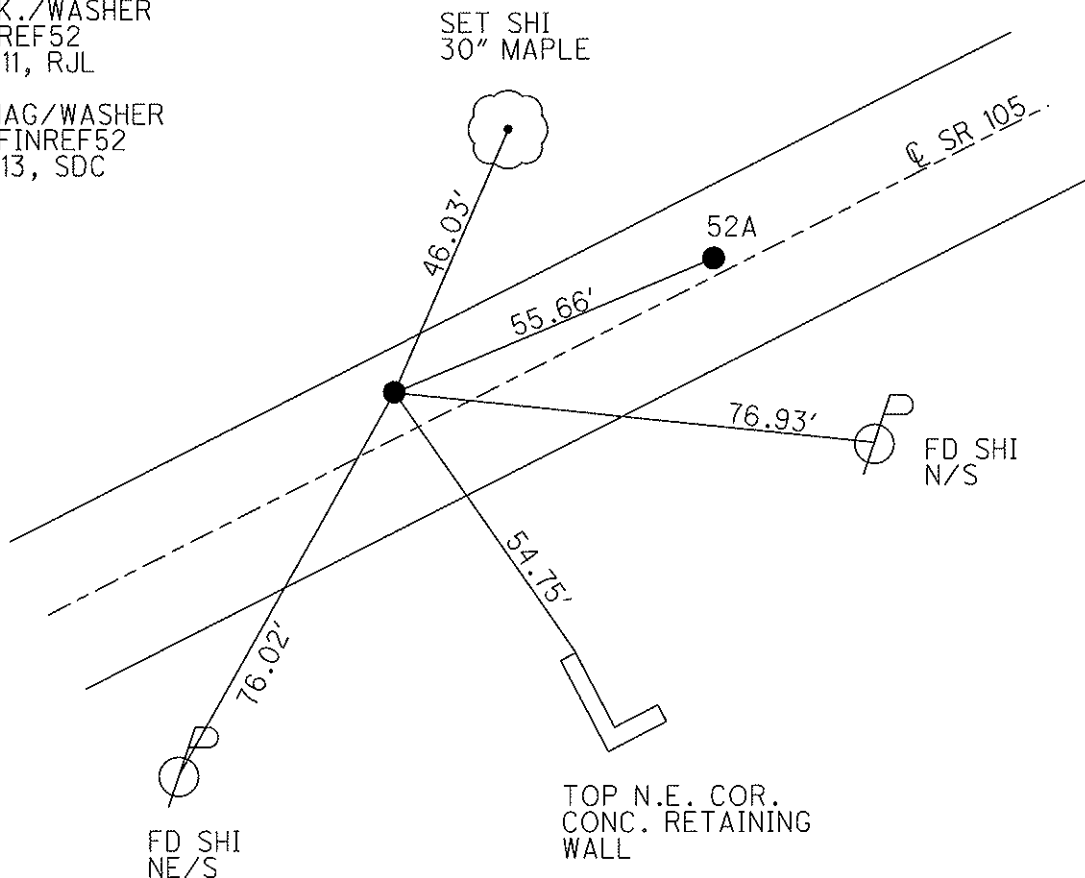

O.D.O.T. DISTRICT 2 SURVEY OFFICE

PERSONNEL

REFERENCE NO. 52

SHEET 61 OF 63

NOTES ROUSOS

DATE 4-16-02

ROUTE SR 105

H.C. HOMAN

WEATHER SUNNY

COUNTY WOOD

R.C. BROWN

TEMP. 70°

TOWNSHIP WEBSTER

SECTION 7

T 5 N R 12 E


TYPE MONUMENT PK'S & WASHER'S

ON SURFACE - ~~BELOW~~ ON SURFACE


LEFT - CL PAV'T - ~~RIGHT~~ 6.0' & 1.0'

9.0' TO LT. EDGE PAVEMENT

S.L.M. A=314+63 B=315+18

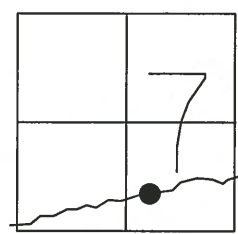

SET PK & WASHER
6-03-02 D.C.H.

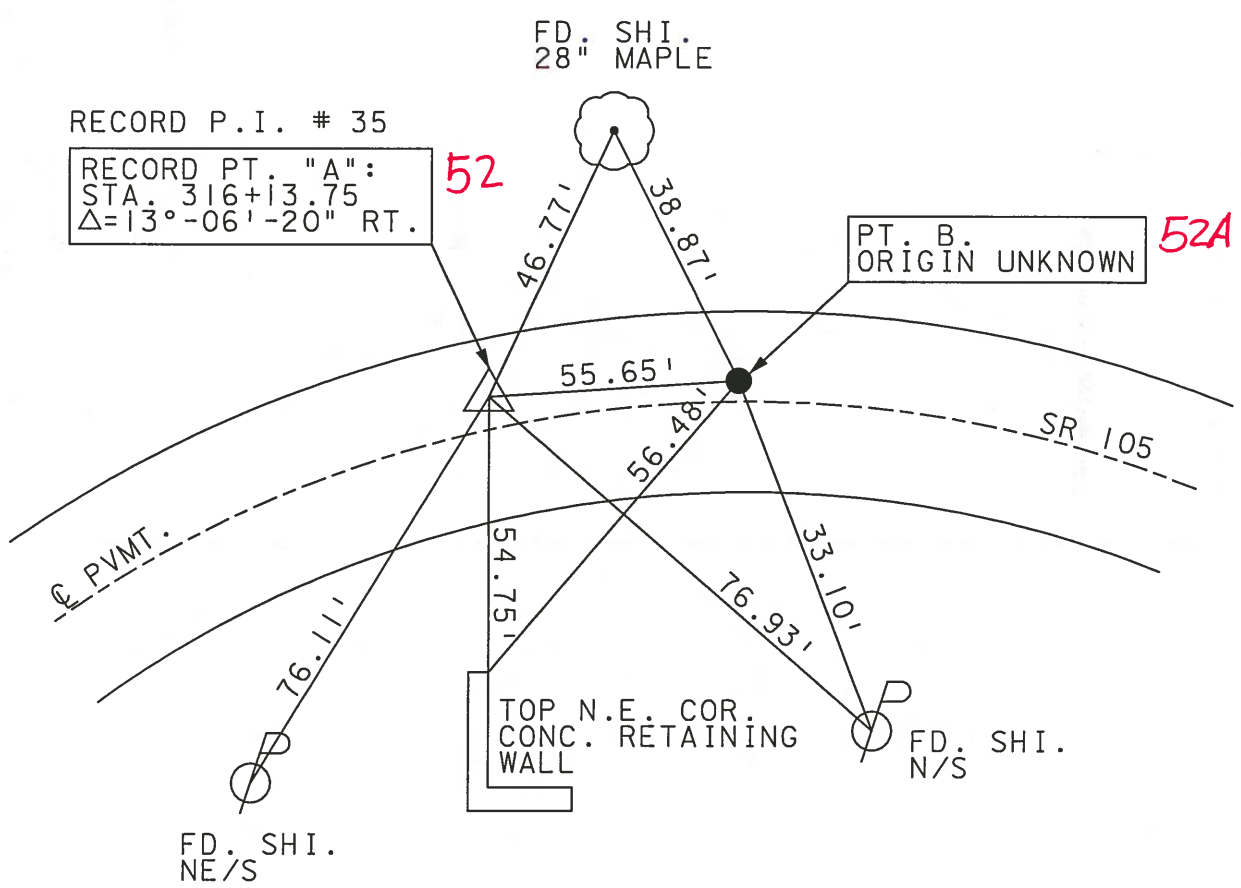

O.D.O.T. DISTRICT 2 SURVEY OFFICE

PERSONNEL _____

REFERENCE NO. 52

SHEET 2 OF 49

NOTES CHANEY

H.C. RIPPLE

R.C. BARBOUR

DATE 8-1-94

WEATHER FAIR

TEMP. +80

ROUTE S.R. 105

COUNTY Wood

TOWNSHIP Webster

SECTION 7

T. 5 N. R. 12 E

TYPE MONUMENT P.K./WASHERS Reset


11-8-94
C.L.

ON SURFACE - BELOW Yes


LEFT - C. PAV'T. - RIGHT 6.0' and 1.0'

9.0' TO Lt EDGE PAVEMENT P+A

S.L.M. A=3/6+13 B=3/6+68

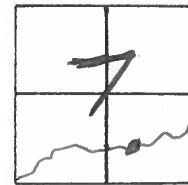

Pt. A
RECORD P.I. #45
Sta 3/6+13.75
 $\Delta = 13^{\circ}-06'-20''$ Rt

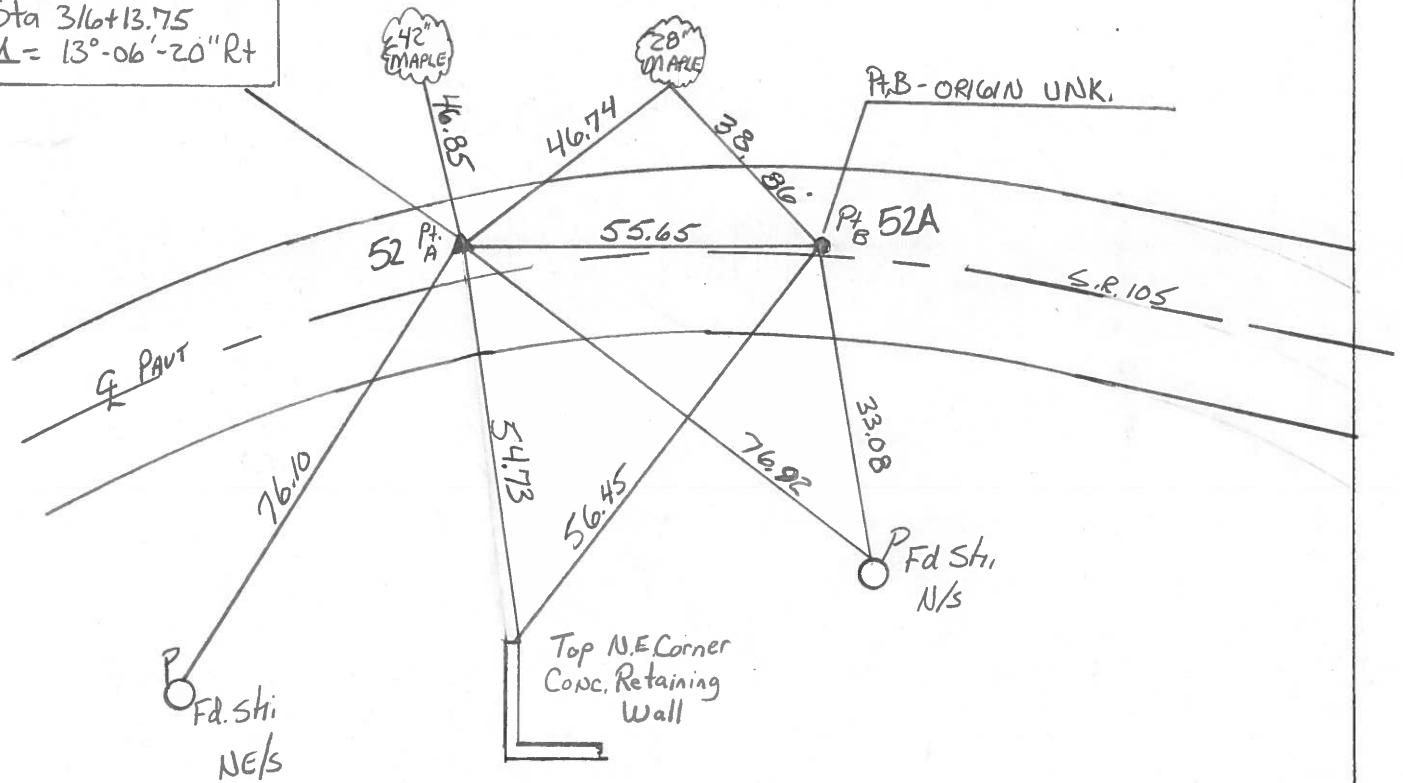

County WOOD S.R. 105

Date 7-10-84

Township WEBSTER

Weather Hot, Humid

Section 7

Temp. +90

T&N, R12E


Personnel Hoffman

HOUSE HOLDER RC

BARNHISEL HC

LOETHRIKE III

52

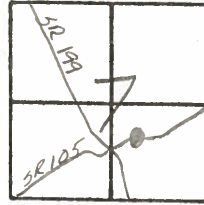

RECORDED
P.I. # 450

316 + 13.75

$\Delta = 13^{\circ} - 06' - 20''$ R.F.

Fd: RR Spike @ SURFACE

15.8 to REP

3.8 to LEP

SLM 314+81


SET PK

9-27-84

C.L.

SR PAVT - SR 105

"B" PK of UNKNOWN ORIGIN
@ SURFACE
& PAVT SR 105
10.5 REP
0.8 LEP

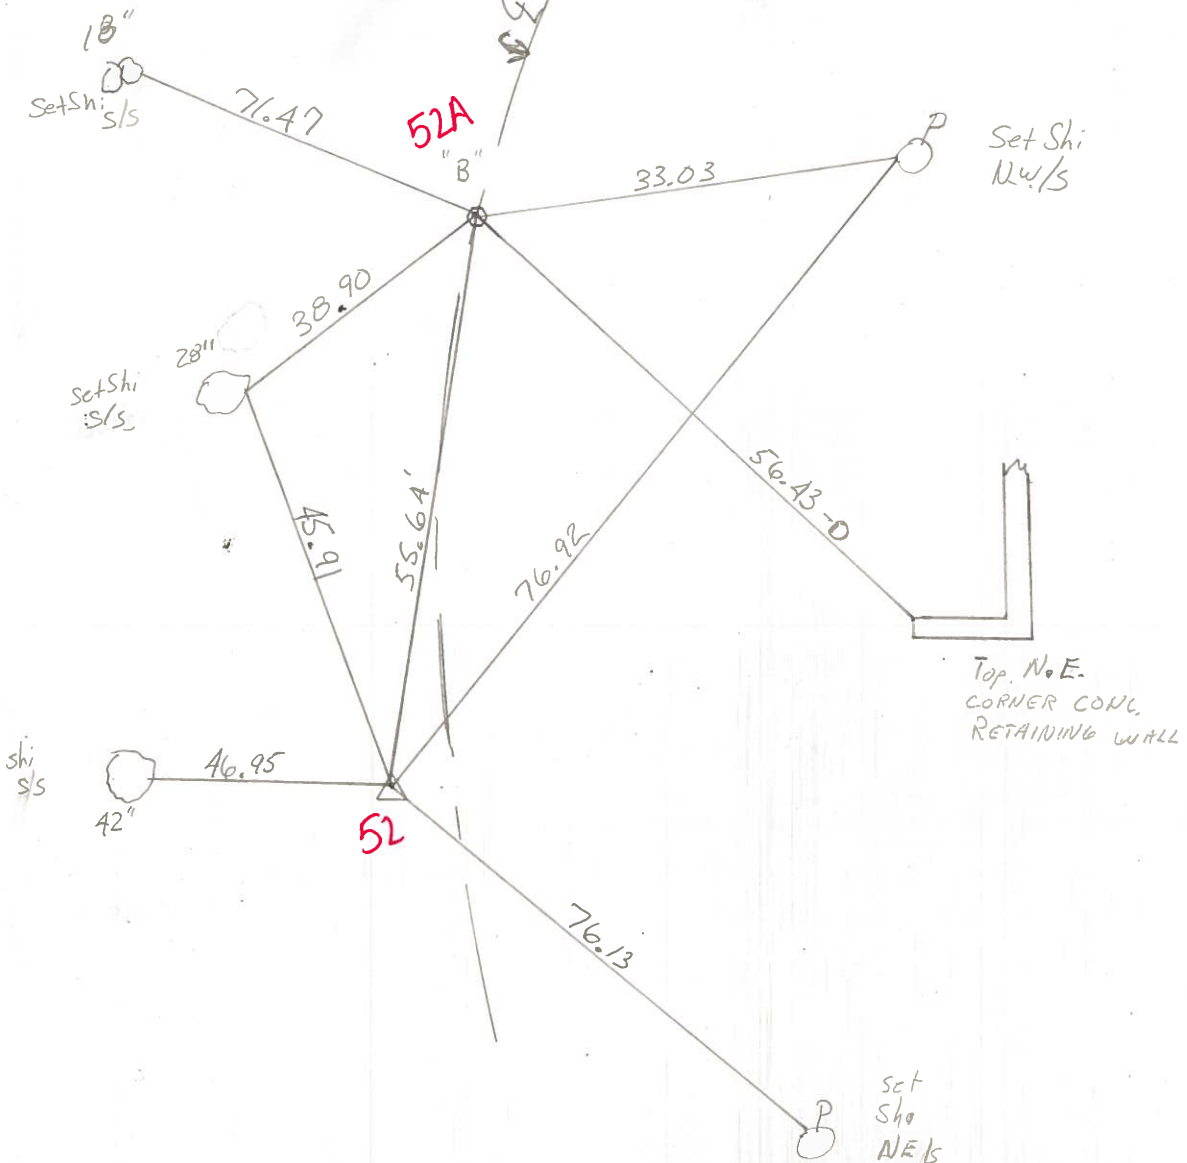

ODOT. DISTRICT 2 SURVEY OFFICE

SHEET _____ OF _____

County Wood S.R. 105

Date 5-29-84

Township WEBSTER

Weather CLOUDY

Section 7

Temp. +50°


TSN, R12E

Personnel LOEHRKE II

BARNHISEL AC

HOUSE HOLDER RC

#52

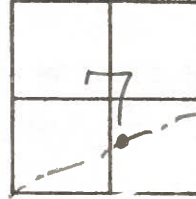


PI S_h RR spk @ SURFACE

314 +81

PI #45

316 +13.75

$\Delta = 13^{\circ} - 06' - 20''$ RT

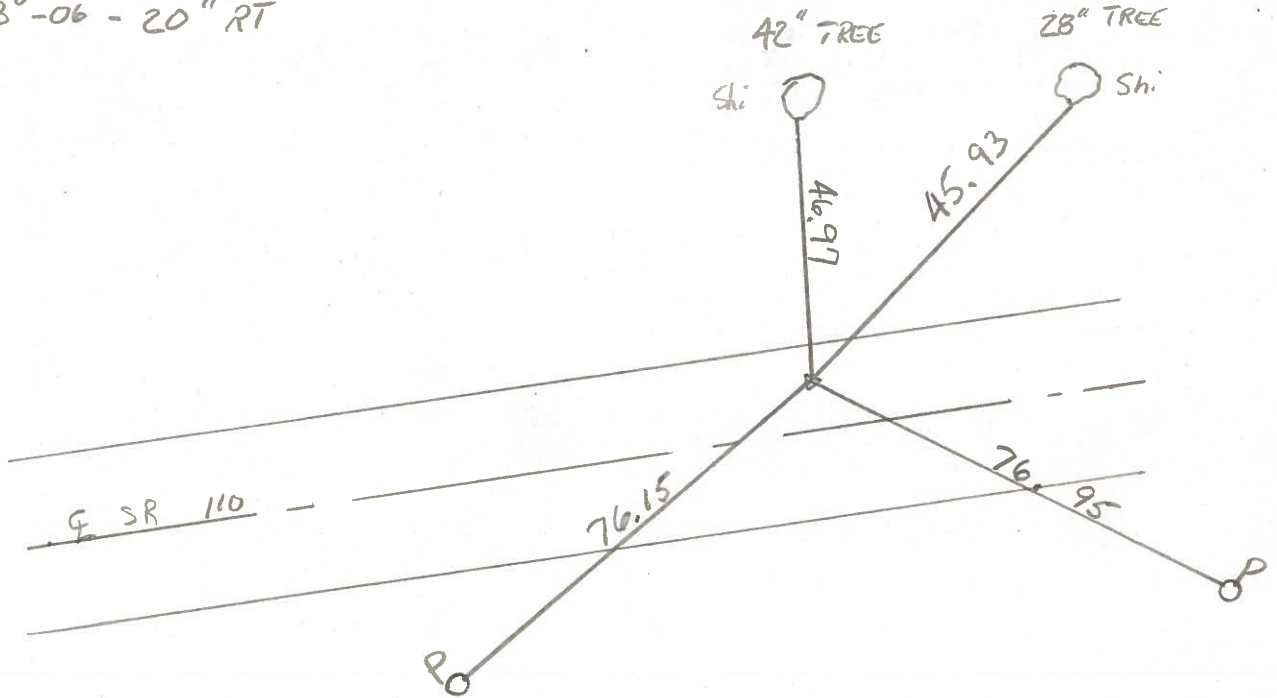

15.8 TO REP

3.8 TO LEP

O.D.O.T. DISTRICT 2 SURVEY OFFICE

SHEET _____ OF _____

County WOOD S.R. 105

Date SEPT.-27-73

Township WEBSTER

Weather MILD

Section 7

Temp. 70°


T N, R E

Personnel STONE

MICHALAK

CURTIS

DENNO

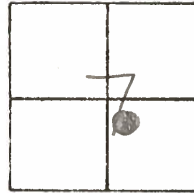

#52
 P.I. #45
 316+13.75
 $\Delta = 13^{\circ}-06'-20''$ RT

