


O.D.O.T. DISTRICT 2 SURVEY OFFICE (USE ONLY)

PERSONNEL	REFERENCE NO. <u>52 A</u>	SHEET <u>5</u> OF <u>33</u>
NOTES <u>RHOADES</u>	DATE <u>6/12/13</u>	ROUTE <u>SR 105</u>
H.C. <u>CODER</u>	WEATHER <u>FAIR</u>	COUNTY <u>WOOD</u>
R.C. <u>RHOADES</u>	TEMP. <u>68°</u>	TOWNSHIP <u>WEBSTER</u>
		SECTION <u>7</u>
		T <u>5</u> N R <u>12</u> E

TYPE MONUMENT P.K./WASHER
 ON SURFACE - ~~BELOW~~ ON
 LEFT - ☉ PAV'T - ~~RIGHT~~ 1.0'
9.0' TO LT EDGE PAVEMENT
 S.L.M. 315+18

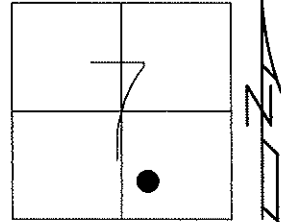


Grid: Northing: 634442.956 Easting: 1688491.839

ORIGIN UNKNOWN

SET P.K./WASHER
6/13/02, DCH

FD P.K./WASHER
GPS, REFA52
10/11/11, RJL

SET MAG/WASHER
GPS, FINREFA52
10/3/13, SDC

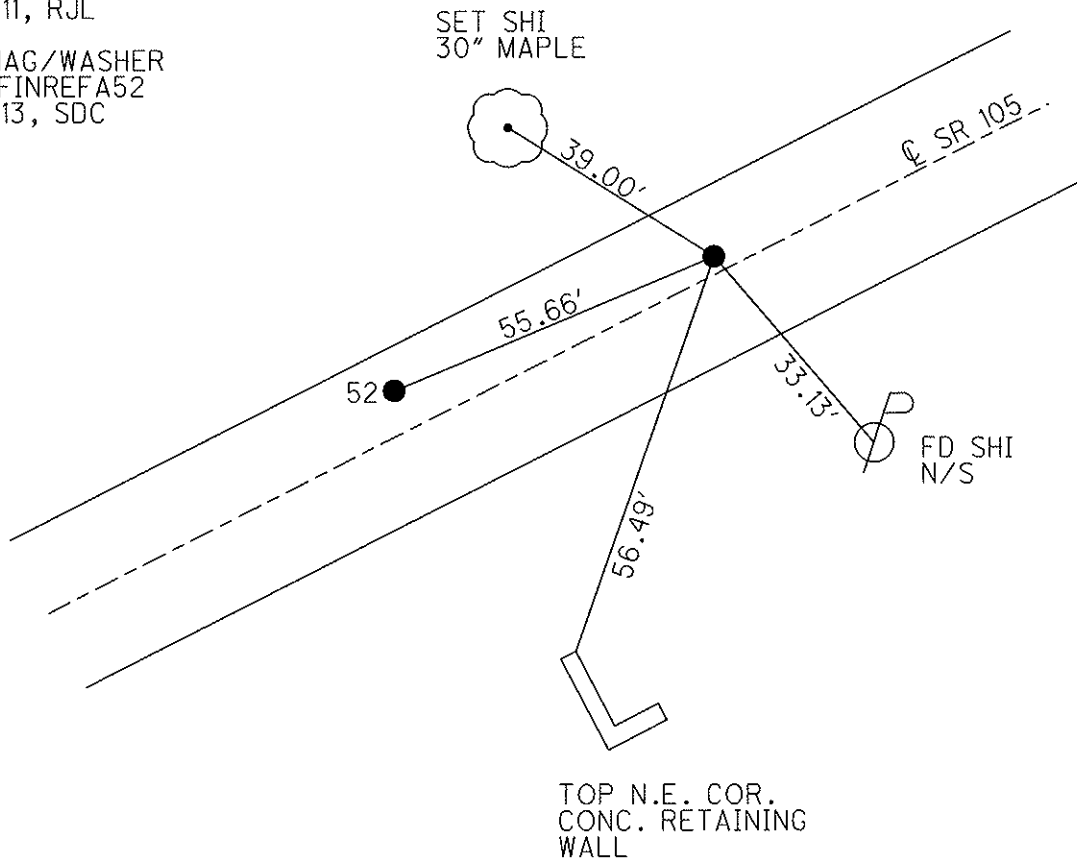

O.D.O.T. DISTRICT 2 SURVEY OFFICE

PERSONNEL

REFERENCE NO. 52

SHEET 61 OF 63

NOTES ROUSOS

DATE 4-16-02

ROUTE SR 105

H.C. HOMAN

WEATHER SUNNY

COUNTY WOOD

R.C. BROWN

TEMP. 70°

TOWNSHIP WEBSTER

SECTION 7

T 5 N R 12 E


TYPE MONUMENT PK'S & WASHER'S

ON SURFACE - ~~BELOW~~ ON SURFACE


LEFT - Q PAVT - ~~RIGHT~~ 6.0' & 1.0'

9.0' TO LT. EDGE PAVEMENT

S.L.M. A=314+63 B=315+18

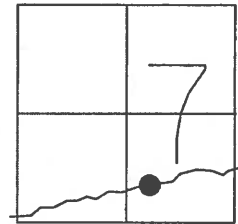

SET PK & WASHER
6-03-02 D.C.H.

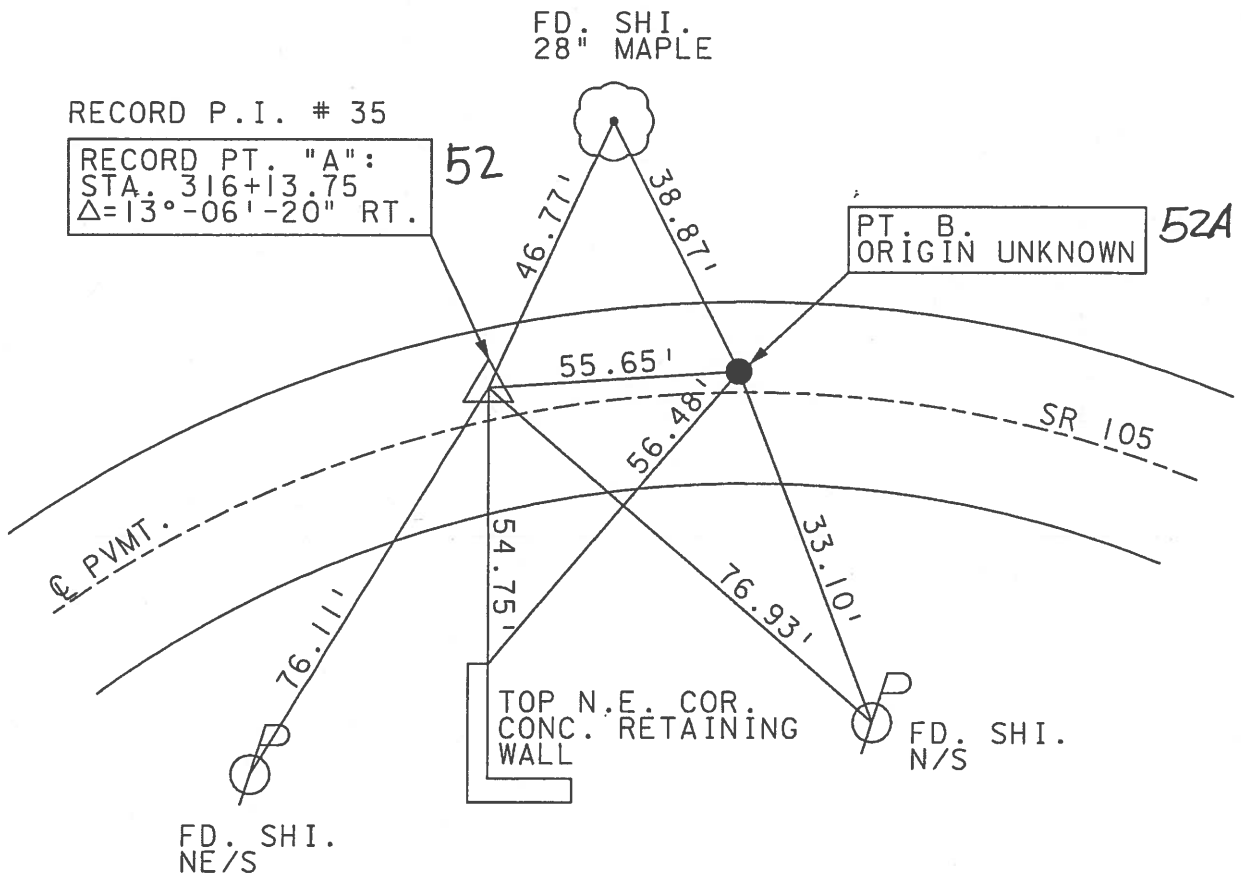

O.D.O.T. DISTRICT 2 SURVEY OFFICE

PERSONNEL

REFERENCE NO. 52

SHEET 2 OF 49

NOTES CHANNEY

H.C. RIPLLE

R.C. BARBOUR

DATE B-1-94

WEATHER FAIR

TEMP. +80

ROUTE S.R. 105

COUNTY Wood

TOWNSHIP Webster

SECTION 7

T. 5 N. R. 12 E.


TYPE MONUMENT P.K./WASHERS ^{Reset} 11-8-94 C.L.

ON SURFACE - ~~BELOW~~ Yes


LEFT - ~~C~~ PAV'T. - ~~RIGHT~~ 6.0' and 1.0'

90' TO Lt EDGE PAVEMENT Pt A

S.L.M. A = 3/6 + 13 B = 3/6 + 68

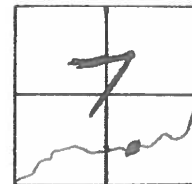

Pt. A
 RECORD P.I. #45
 Sta 3/6 + 13.75
 $\Delta = 13^{\circ} - 06' - 20''$ Rt

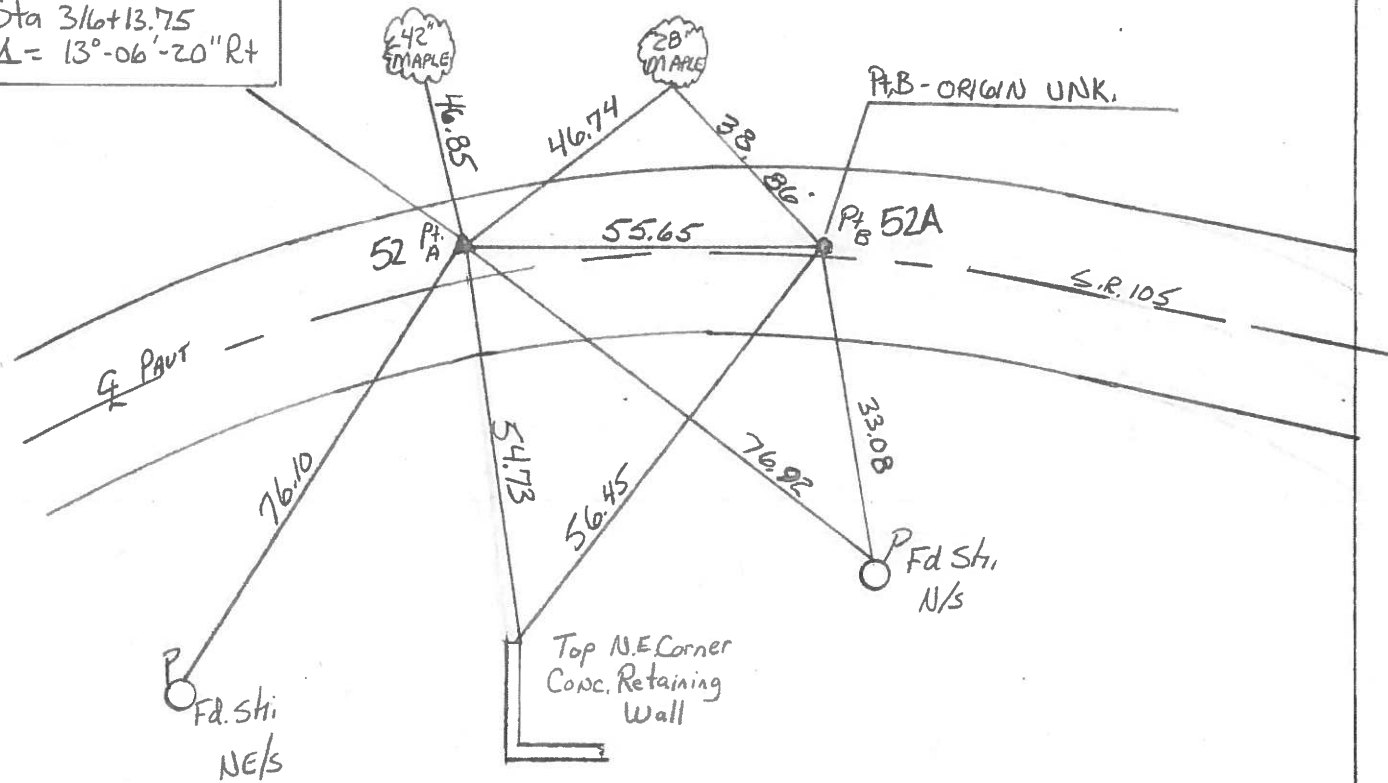

County WOOD S.R. 105

Date 7-10-84

Township WEBSTER

Weather Hot, Humid

Section 7

Temp. +90

T5N, R12E


Personnel Hoffman

HOUSE HOLDER RC

BARWISER HC

LOEHRKE TD

52

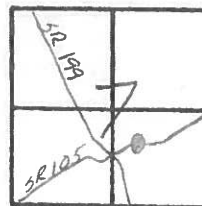

RECORDED
P.I. # 45

316 + 13.75

$\Delta = 13^\circ - 06' - 20''$ RT.

RR Spike @ SURFACE

15.8 to REP

3.8 to LEP


m 314+81

SET PK

9-27-84

CL.

"B" PK of UNKNOWN ORIGIN
@ SURFACE
2 PAVT SR 105
10.5 REP
0.0 LEP

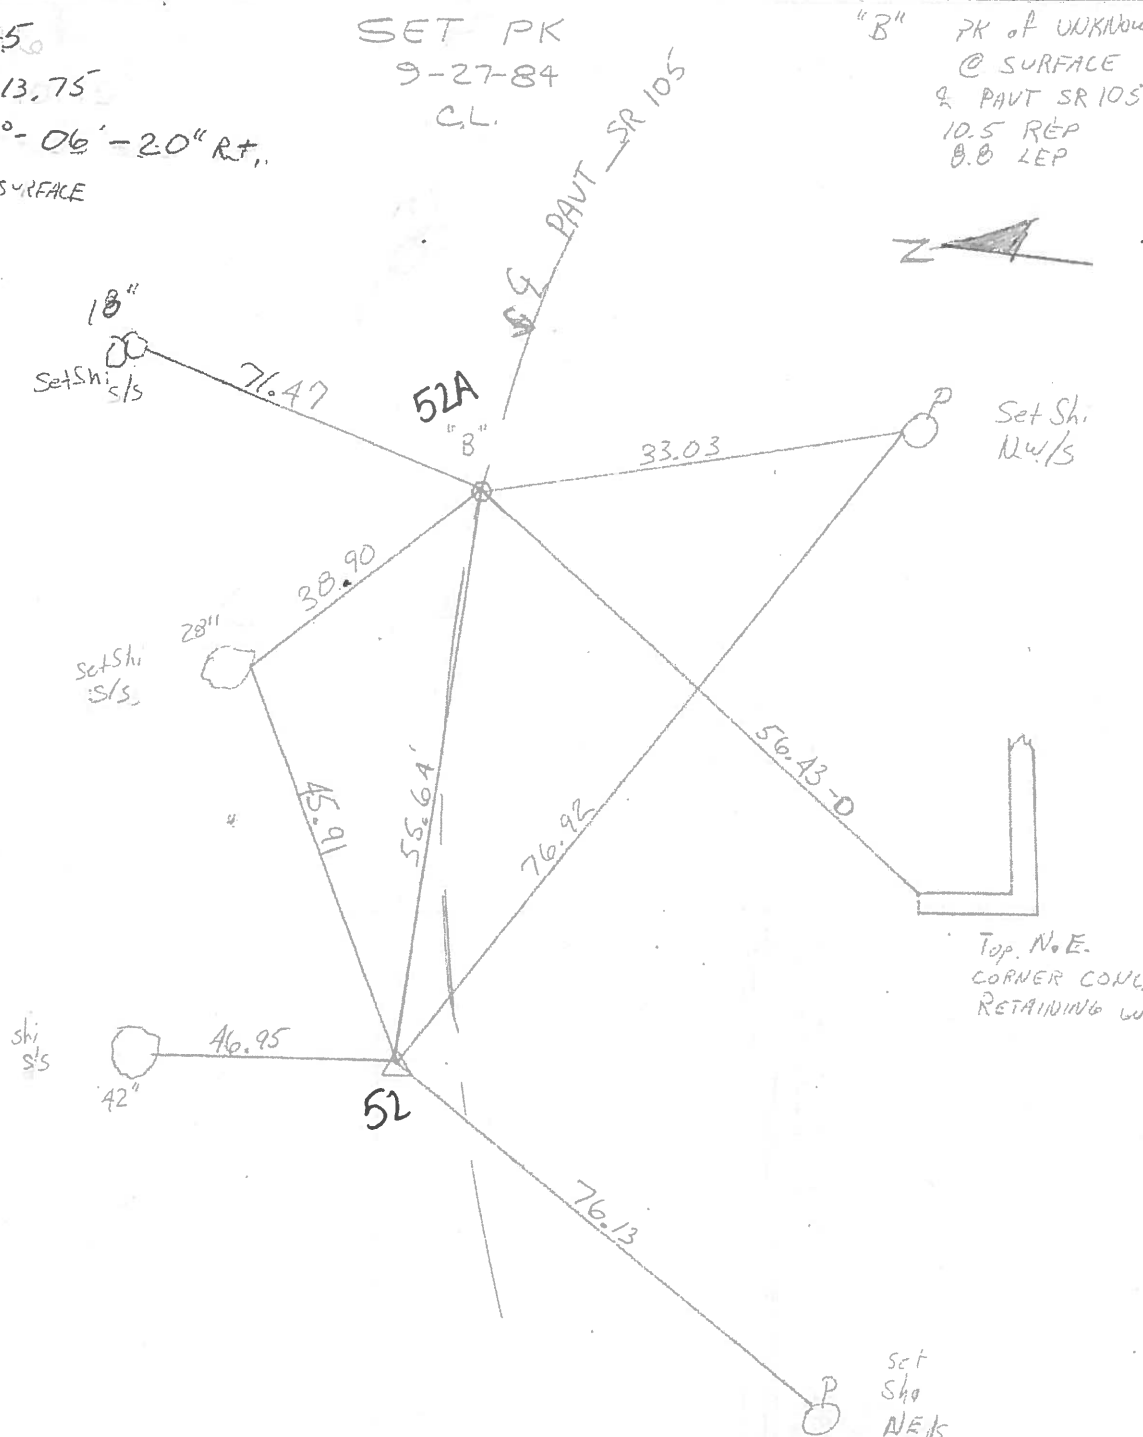

Top. N.E.
CORNER CONG.
RETAINING WALL