


O.D.O.T. DISTRICT 2 SURVEY OFFICE (USE ONLY)


PERSONNEL \_\_\_\_\_ REFERENCE NO. 53 SHEET 6 OF 33  
 NOTES NIESE DATE 5/19/23 ROUTE SR 105  
 H.C. AUBLE WEATHER SUNNY COUNTY WOOD  
 R.C. NIESE TEMP. 70° TOWNSHIP WEBSTER  
 DWG BY RHOADES PID PAVING TRAIN SECTION 7  
 T 5 N R 12 E

TYPE MONUMENT P.K./WASHER  
 ON SURFACE - ~~BELOW~~ ON \_\_\_\_\_  
 OFFSET  $\odot$  PAVEMENT 1.5' LT : ~~RT~~  
 - TO - EDGE PAVEMENT  
 STATION: 317+08.88

HORZ.DATUM: NAD83 2011 GEOID: NAVD88 2018  
 GRID: NORTHING: 634510.067 EASTING: 1688661.355

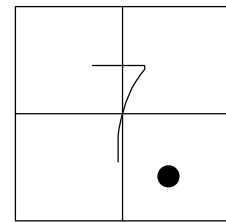


RECORD:  
 UNKNOWN POINT  
 SET P.K./WASHER  
 6/3/02, DCH  
 FD P.K./WASHER  
 REF53  
 10/11/11, RJL  
 SET MAG/WASHER  
 FINREF53  
 10/3/13, SDC  
 FD P.K./WASHER  
 REF53  
 5/19/23, TDN

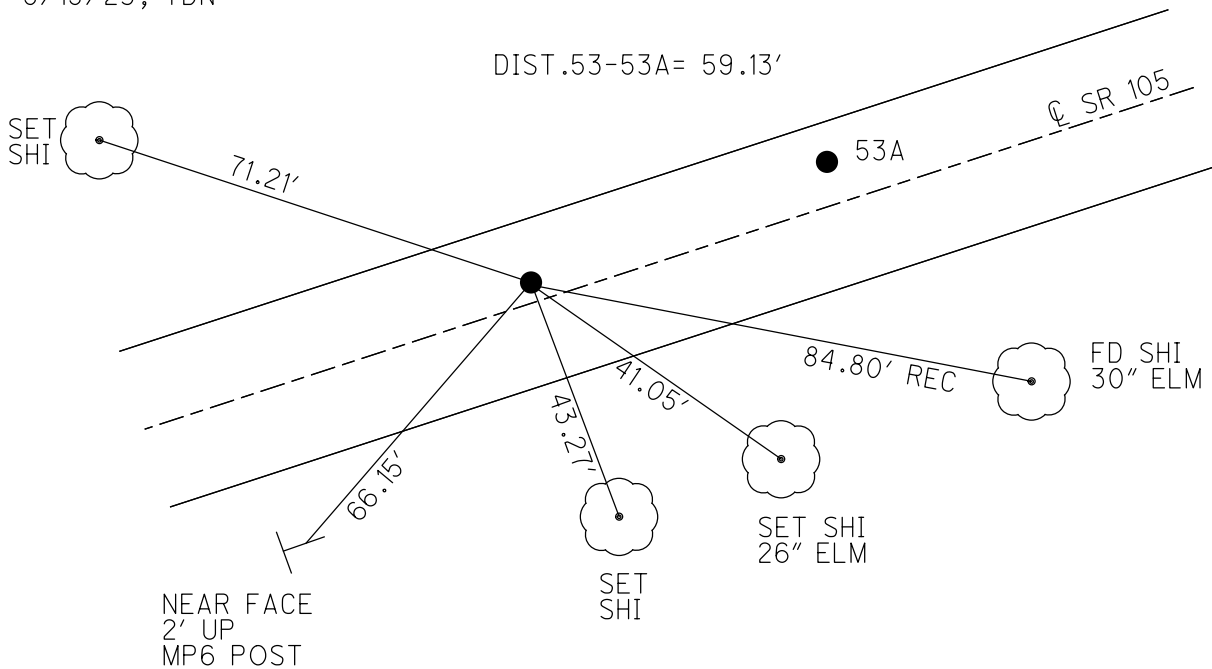


O.D.O.T. DISTRICT 2 SURVEY OFFICE (USE ONLY)

PERSONNEL	REFERENCE NO. <u>53</u>	SHEET <u>6</u> OF <u>33</u>
NOTES <u>RHOADES</u>	DATE <u>6/12/13</u>	ROUTE <u>SR 105</u>
H.C. <u>CODER</u>	WEATHER <u>FAIR</u>	COUNTY <u>WOOD</u>
R.C. <u>RHOADES</u>	TEMP. <u>68°</u>	TOWNSHIP <u>WEBSTER</u>
		SECTION <u>7</u>
		T <u>5</u> N R <u>12</u> E

TYPE MONUMENT P.K./WASHER  
 ON SURFACE - ~~BELOW~~ ON  
 LEFT - Q PAV'T - ~~RIGHT~~ 1.5'  
TO - EDGE PAVEMENT  
 S.L.M. 317+08.88  
 Grid: Northing: 634510.067 Easting: 1688661.355

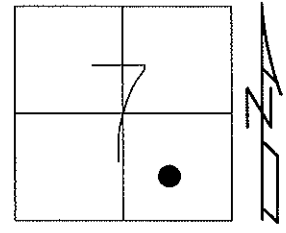

UNKNOWN POINT  
 SET P.K./WASHER  
 6/3/02, DCH  
 FD P.K./WASHER  
 GPS, REF53  
 10/11/11, RJL  
 SET MAG/WASHER  
 GPS, FINREF53  
 10/3/13, SDC

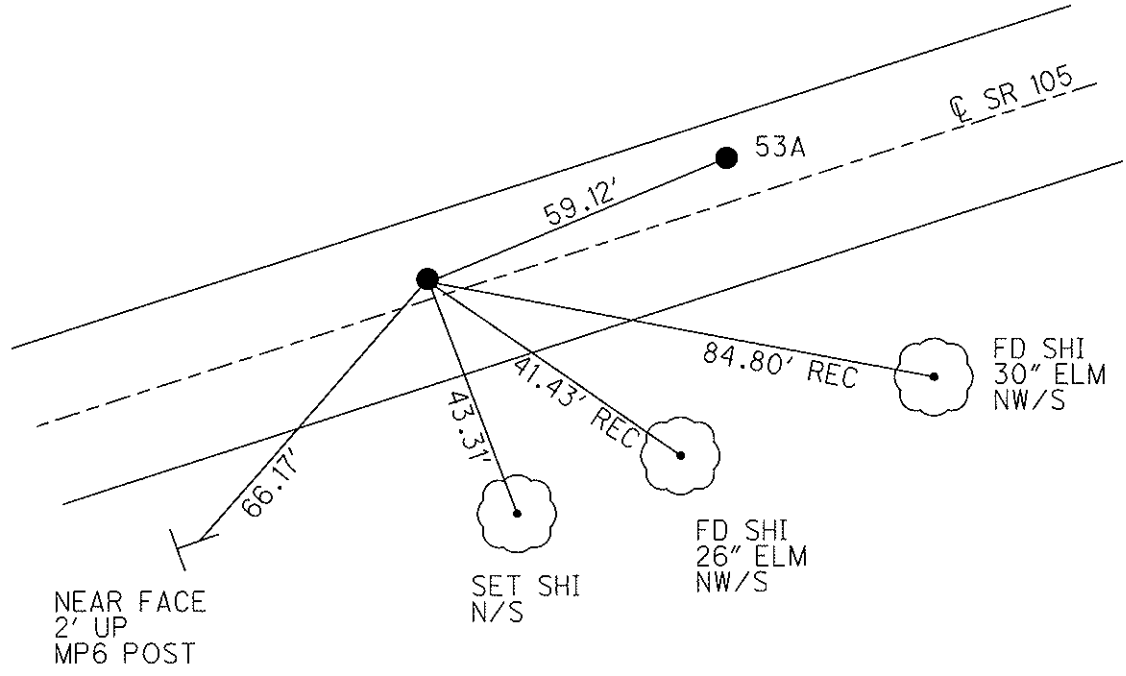

O.D.O.T. DISTRICT 2 SURVEY OFFICE

PERSONNEL

REFERENCE NO. 53

SHEET 62 OF 63

NOTES ROUSOS

DATE 4-16-02

ROUTE SR 105

H.C. HOMAN

WEATHER SUNNY

COUNTY WOOD

R.C. BROWN

TEMP. 70°

TOWNSHIP WEBSTER

SECTION 7

T 5 N R 12 E


TYPE MONUMENT PK & WASHER

ON SURFACE - ~~BELOW~~ ON SURFACE

LEFT - Q PAV'T - ~~RIGHT~~ 5.4' LT.

4.2' TO LT. EDGE PAVEMENT

S.L.M. 317+68 P.I. STA.

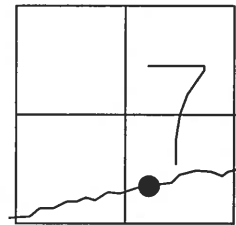


SET PK & WASHER  
6-03-02 D.C.H.


RES  
#6422

DRIVEWAY

16" MAPLE

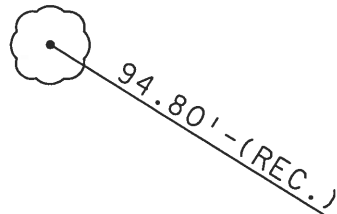

UNKNOWN POINT 53

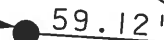

53A

RECORD P.I. # 46  
STA. 319+10.75  
 $\Delta=7^{\circ}-55'-00''$  RT.

