

O.D.O.T. DISTRICT 2 SURVEY OFFICE (USE ONLY)

PERSONNEL

REFERENCE NO. 56

SHEET 10 OF 33

NOTES RHOADES

DATE 8/19/22

ROUTE SR 105

H.C. AUBLE

WEATHER SUNNY

COUNTY WOOD

R.C. NIESE

TEMP. 64°

TOWNSHIP WEBSTER

SECTION 7

DWG BY RHOADES

PID PAVETRAIN

T 5 N R 12 E

TYPE MONUMENT P.K./WASHER

~~ON SURFACE~~ - BELOW ON

OFFSET \varnothing PAVEMENT ON ~~±~~ : RT

12' RT TO RT EDGE PAVEMENT



STATION: 339+48.21

HORZ.DATUM: NAD83 2011

GEOID: NAVD88 2018

GRID: NORTHING: 635037.453

EASTING: 1690800.606

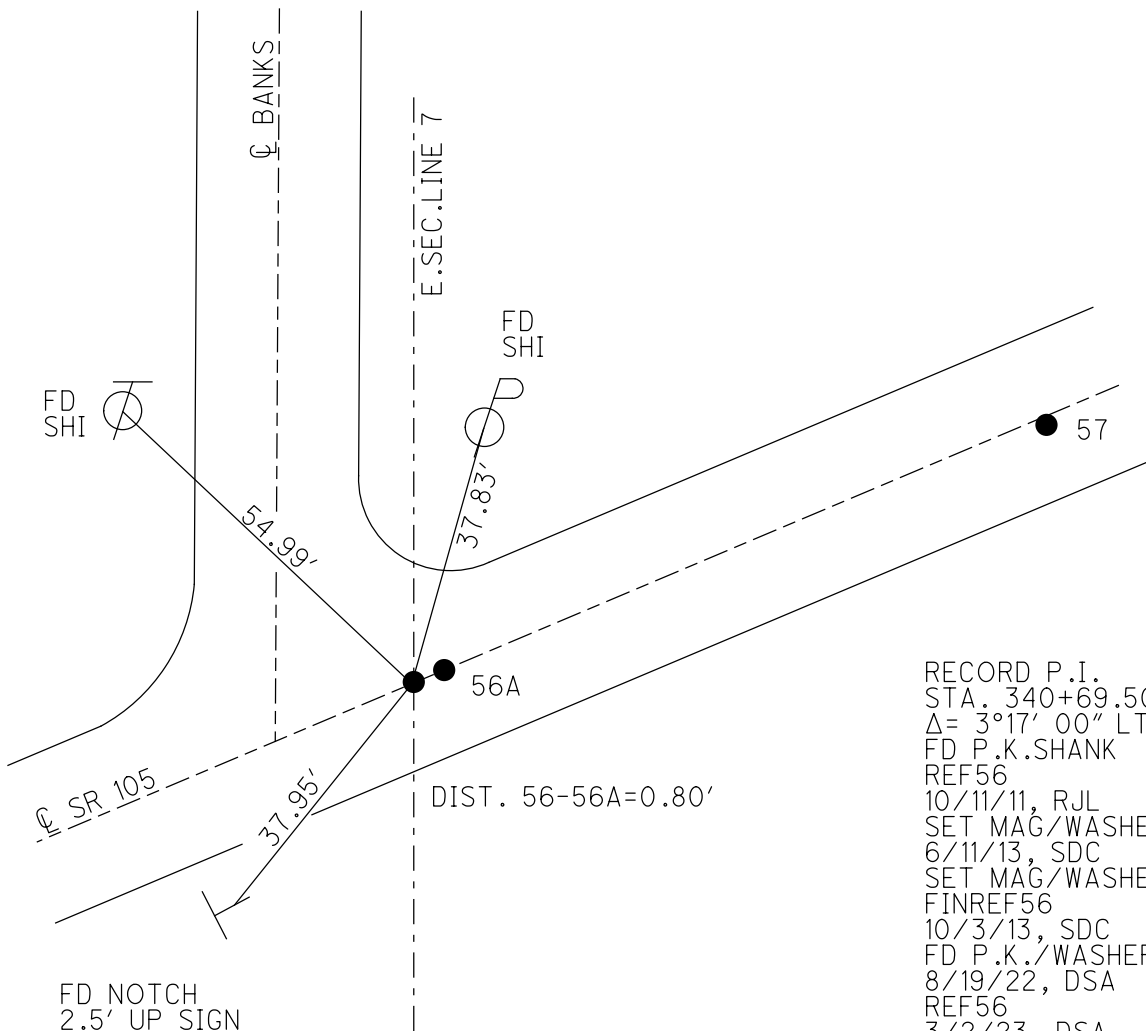
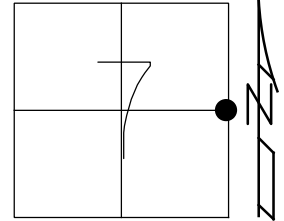


RECORD P.I.
 STA. 340+69.50
 $\Delta = 3^{\circ}17' 00''$ LT
 FD P.K. SHANK
 REF56
 10/11/11, RJL
 SET MAG/WASHER
 6/11/13, SDC
 SET MAG/WASHER
 FINREF56
 10/3/13, SDC
 FD P.K./WASHER
 8/19/22, DSA
 REF56
 3/2/23, DSA

O.D.O.T. DISTRICT 2 SURVEY OFFICE (USE ONLY)

PERSONNEL	REFERENCE NO. <u>56</u>	SHEET <u>10</u> OF <u>33</u>
NOTES <u>HOMAN</u>	DATE <u>6/11/13</u>	ROUTE <u>SR 105</u>
H.C. <u>HOMAN</u>	WEATHER <u>FAIR</u>	COUNTY <u>WOOD</u>
R.C. <u>CODER</u>	TEMP. <u>65°</u>	TOWNSHIP <u>WEBSTER</u>
		SECTION <u>7</u>
		T <u>5</u> N R <u>12</u> E

TYPE MONUMENT SET MAG/WASHER
 ON SURFACE - ~~BELOW~~ ON
 LEFT - ☉ PAV'T - RIGHT ON, 27' EAST OF ☉ BANKS RD.
- TO - EDGE PAVEMENT
 S.L.M. 340+69
 Grid: Northing: 635037.475 Easting: 1690800.578

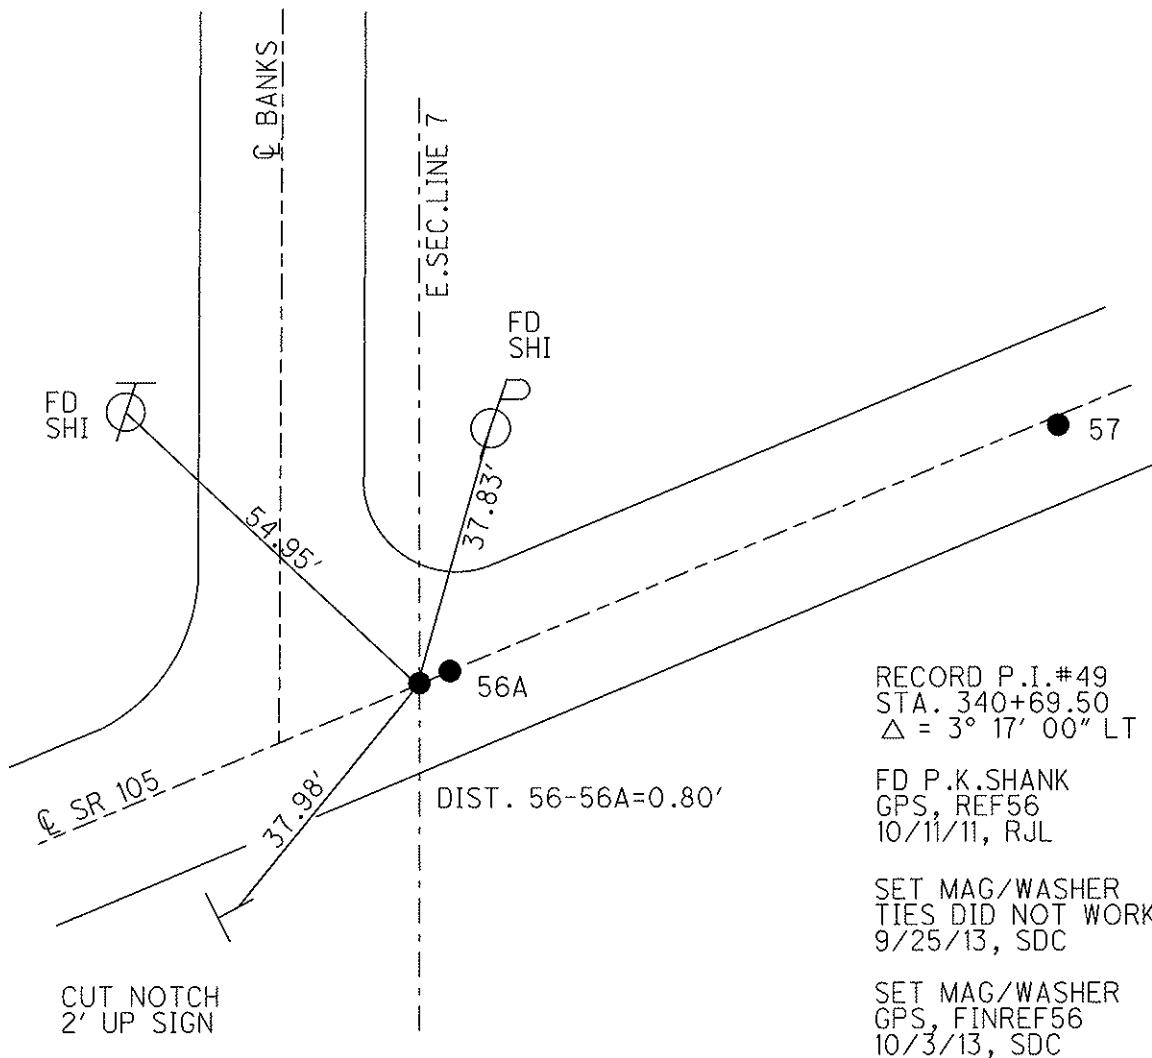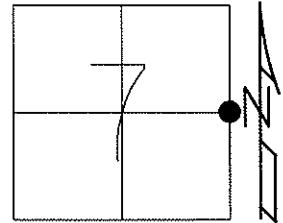

O.D.O.T. DISTRICT 2 SURVEY OFFICE

PERSONNEL _____

REFERENCE NO. 56 & 57

SHEET 6 OF 49

NOTES CHANEY

H.C. RIPLLE

R.C. BARBOUR

DATE 8-1-94

WEATHER FAIR

TEMP. +82

ROUTE S.R. 105

COUNTY WOOD

TOWNSHIP WEBSTER

SECTION 8

T S N R 12 E

Reset 11-8-94


TYPE MONUMENT P.K Nails

ON SURFACE - BELOW Yes


LEFT - ℄ PAV'T. - RIGHT A&B ON ℄ C 70.8' Rt

TO EDGE PAVEMENT

S.L.M. A=340+69 B=340+70 C=341+70

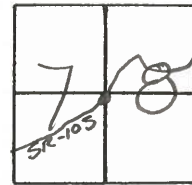

A: 56
B: 56A
C: 57

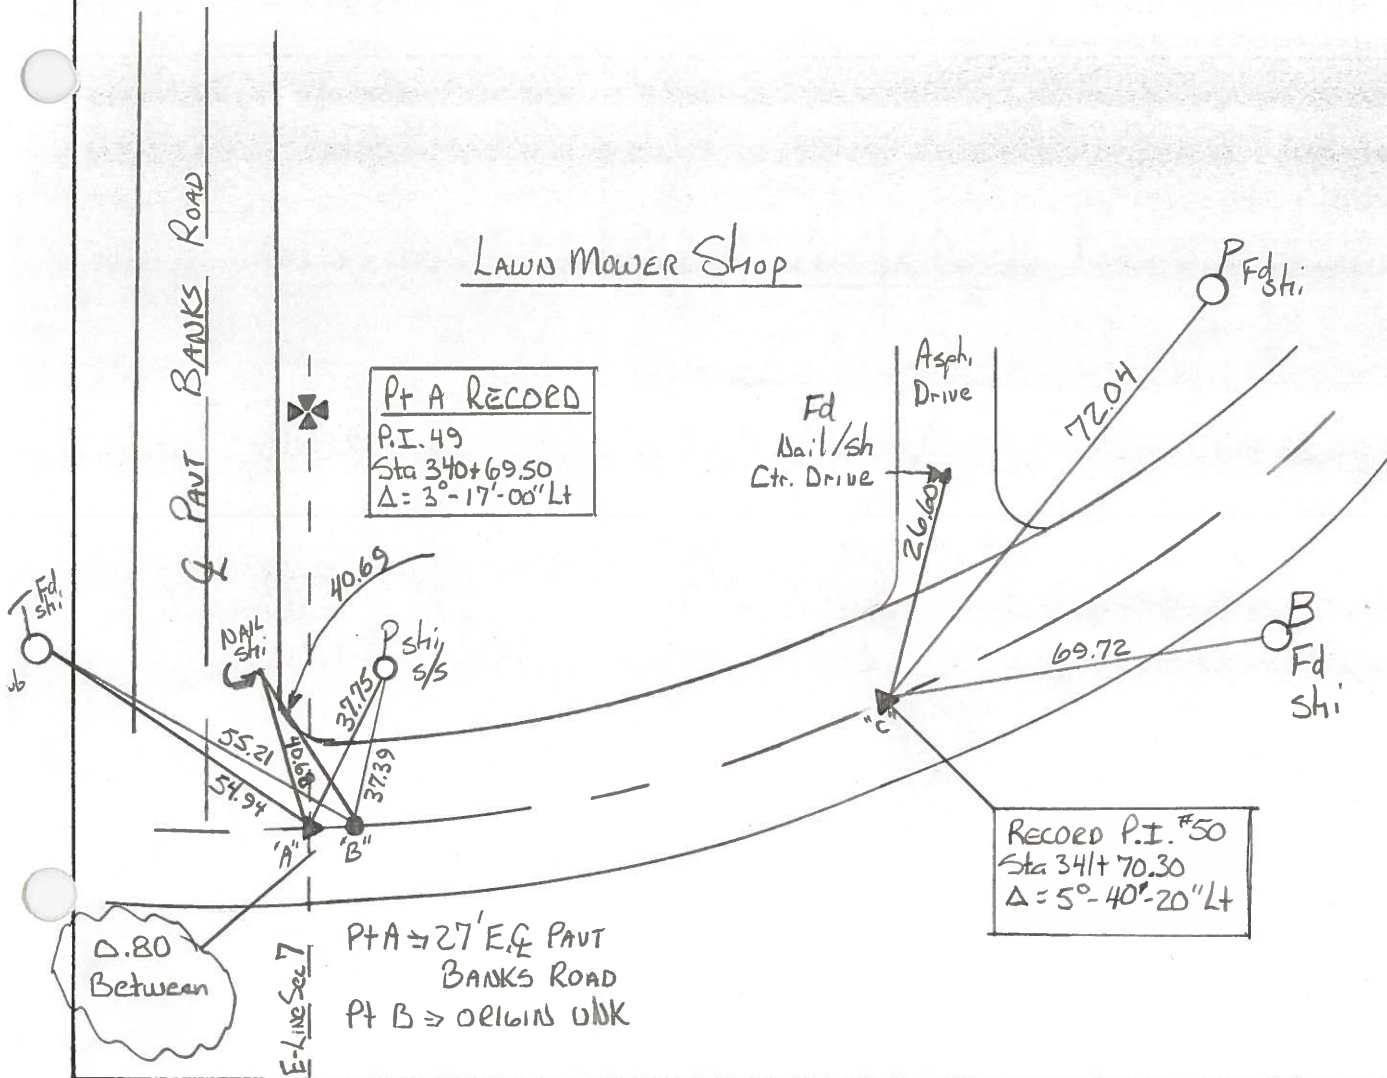

County WOOD S.R. 105

Date 7-10-84

Township WEBSTER

Weather CLEAR HUMID

Section 7

Temp. + 92


T5N, R12E

Personnel Aoffman

House RC

BARNEY HC

LOEHARKE II

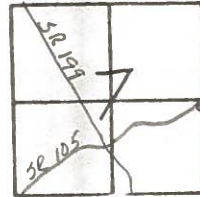

56

RECORDED
P.I. # 49

340+69.50

Δ = 30'-17"-00" Lt.

Fed. PK @ SURFACE 27' E of ♀ PAUT BANKS Rd
9.8 to RGP

SLM 339+33

ON W.LINE SEC. 8

"B" Boat Spoke @ SURFACE

9.8 to REP

SLM 339+34


"B" to P.I. 0.80"

SET PK

9-27-84

A=56

B=56A

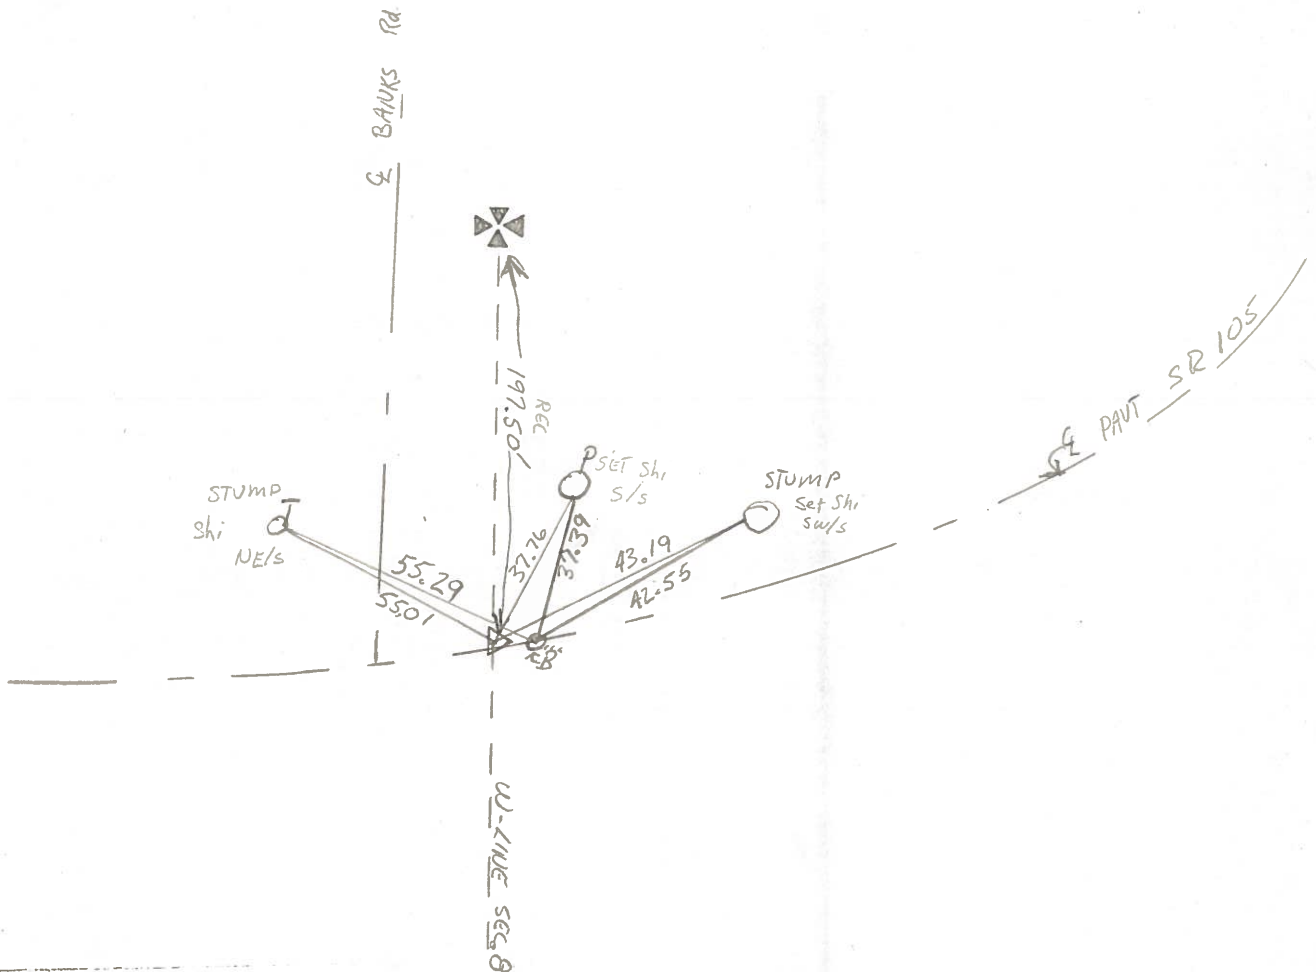

O.D.O.T. DISTRICT 2 SURVEY OFFICE

SHEET _____ OF _____

County WOOD S.R. 105

Date SEPT-27-73

Township WEBSTER

Weather MILD

Section 7

Temp. 73°

T N, R E

Personnel STONE

MICHALAK

CURTIS

DENNO

