

O.D.O.T. DISTRICT 2 SURVEY OFFICE (USE ONLY)

PERSONNEL _____

REFERENCE NO. 57 A

SHEET 13 OF 33

NOTES CHANEY DATE 8/1/94

ROUTE SR 105

H.C. RIPPLE WEATHER FAIR

COUNTY WOOD

R.C. BARBOUR TEMP. 80°

TOWNSHIP WEBSTER

SECTION 8

DWG BY RHOADES PID _____

T 5 N R 12 E

TYPE MONUMENT P.K./WASHER

ON SURFACE - ~~BELOW~~ ON


OFFSET ☉ PAVEMENT ON LT : RT

- TO - EDGE PAVEMENT


STATION: 346+40.85

HORZ. DATUM: _____ GEOID: _____

GRID: NORTHING: _____ EASTING: _____

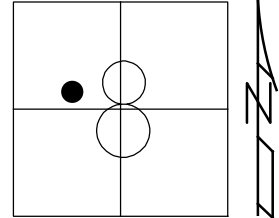

RECORD:
 STA. 347+61.76
 DNF POINT
 10/20/11, RJL

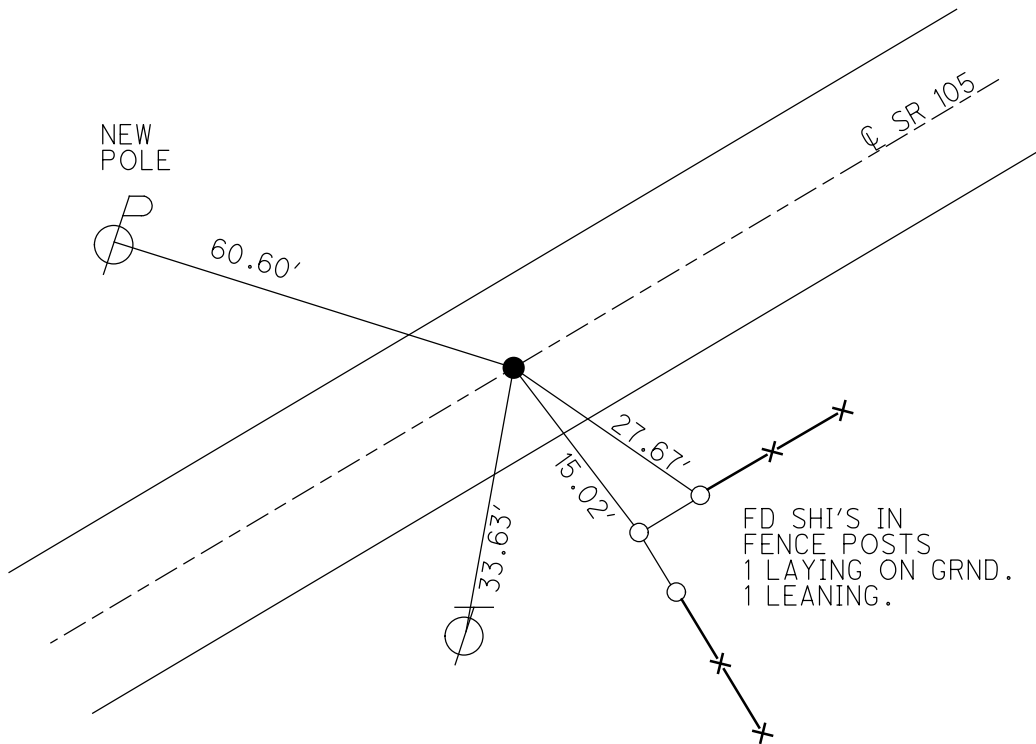

O.D.O.T. DISTRICT 2 SURVEY OFFICE (USE ONLY)

PERSONNEL

REFERENCE NO. 57 A

SHEET 13 OF 33

NOTES CHANEY

DATE 8/1/94

ROUTE SR 105

H.C. RIPPLE

WEATHER FAIR

COUNTY WOOD

R.C. BARBOUR

TEMP. 80°

TOWNSHIP WEBSTER

SECTION 8

T 5 N R 12 E

TYPE MONUMENT P.K./WASHER


ON SURFACE - ~~BELOW~~ ON

LEFT - Q PAV'T - RIGHT ON

- TO - EDGE PAVEMENT


S.L.M. 347+61.76

Grid: Northing: _____ Easting: _____

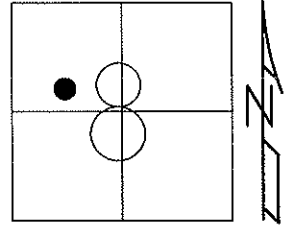

DNF POINT
10/20/11, RJL

NOTE: ALL DISTANCES
ARE FROM 8/1/94

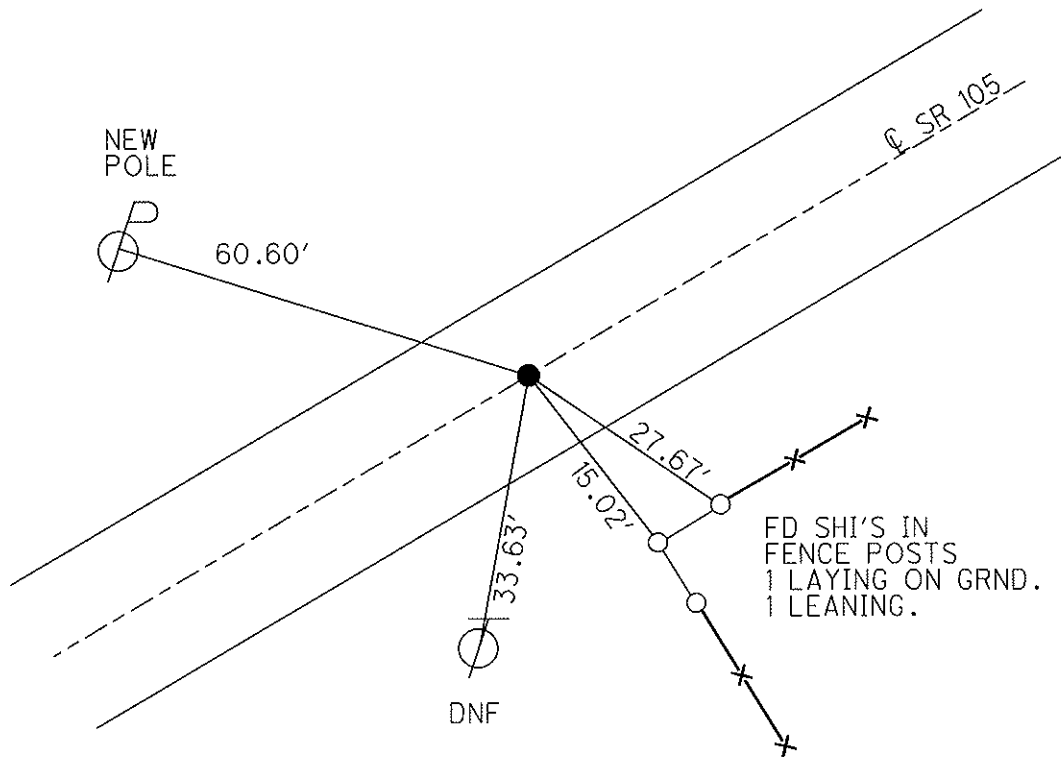

O.D.O.T. DISTRICT 2 SURVEY OFFICE

PERSONNEL

REFERENCE NO. 57-A

SHEET 7 OF 49

NOTES CHANEY

H.C. RIPPLE

R.C. BARBOUR

DATE 8-1-94

WEATHER FAIR

TEMP. +80°

Reset 11-9-94

ROUTE S.R. 105

COUNTY WOOD

TOWNSHIP WEBSTER

SECTION 8

T R



TYPE MONUMENT PK/WASHER

ON SURFACE - BELOW YES

LEFT - Q PAV'T. - RIGHT ON Q PAV'T.

 TO EDGE PAVEMENT

S.L.M. 347+61.76

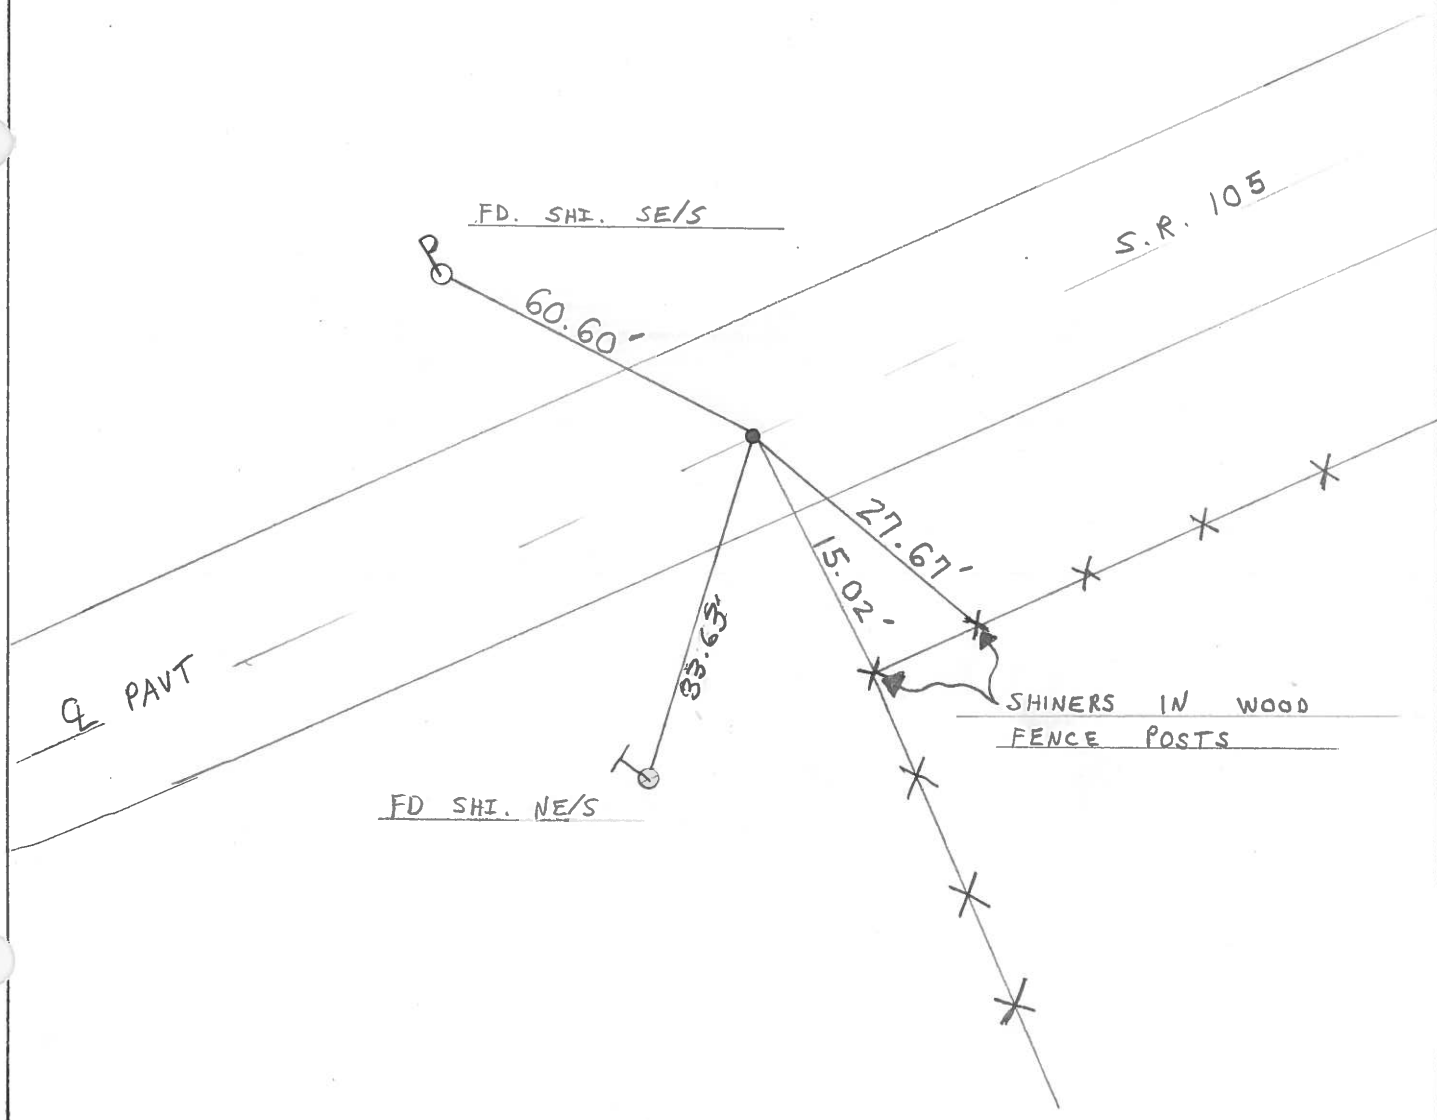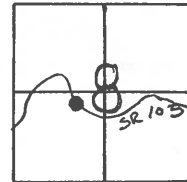

ODOT. DISTRICT 2 SURVEY OFFICE

SHEET OF

County WOOD S.R. 105

Date OCT-31-73

Township WEBSTER

Weather CLOUDY

Section 8

Temp. 45°


T N, R E

Personnel STONE

MICHALAK

CURTIS

DENNO

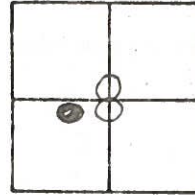

57-A

DID NOT FIND

346+26

P.O.T. 347+61.76

46 24

1 45

FD NAIL TO SURFACE

9.6'-TO N. EDGE PUT.

9.6'-TO S. EDGE PUT.

SHI. P

60.60'

27.67'

15.02'

33.63'

SHI.

SHINERS IN WOOD FENCE POSTS.

