


O.D.O.T. DISTRICT 2 SURVEY OFFICE (USE ONLY)


PERSONNEL _____ REFERENCE NO. 60 SHEET 17 OF 33
 NOTES RHOADES DATE 8/18/22 ROUTE SR 105
 H.C. AUBLE WEATHER SUNNY COUNTY WOOD
 R.C. NIESE TEMP. 80° TOWNSHIP WEBSTER
 DWG BY RHOADES PID PAVETRAIN SECTION 8
 T 5 N R 12 E

TYPE MONUMENT P.K./WASHER
 ON SURFACE - ~~BELOW~~ ON
 OFFSET \perp PAVEMENT 3.3' ~~±~~ : RT
6.5' TO RT EDGE PAVEMENT
 STATION: 370+43.85

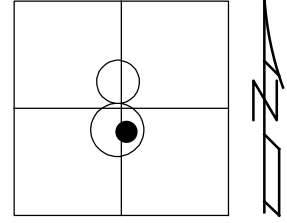

HORZ.DATUM: NAD83 2011 GEOID: NAVD88 2018
 GRID: NORTHING: 634839.741 EASTING: 1693468.941

RECORD: P.I.
 STA.= 373+62.28
 $\Delta = 8^{\circ}40'00''$ LT
 FD P.K. SHANK
 REF60
 10/11/11, RJL
 6/11/13, SDC
 SET MAG/WASHER
 FINREF60
 10/3/13, SDC
 FD P.K./WASHER
 8/18/22, DSA
 REF60
 3/2/23, DSA

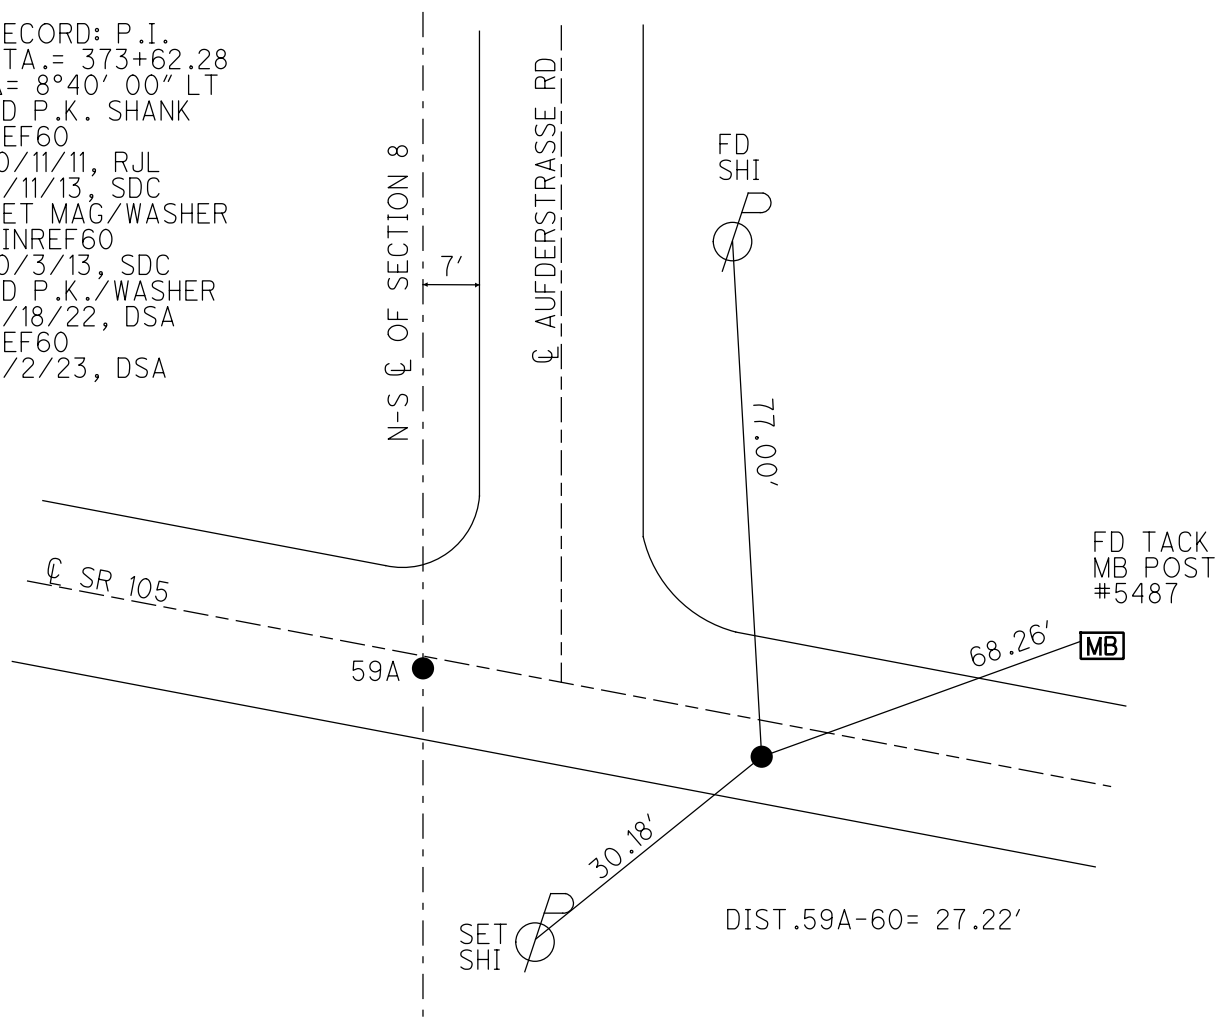

O.D.O.T. DISTRICT 2 SURVEY OFFICE (USE ONLY)

PERSONNEL _____

REFERENCE NO. 60

SHEET 17 OF 33

NOTES HOMAN

DATE 6/11/13

ROUTE SR 105

H.C. HOMAN

WEATHER FAIR

COUNTY WOOD

R.C. CODER

TEMP. 65°

TOWNSHIP WEBSTER

SECTION 8

T 5 N R 12 E

TYPE MONUMENT P.K.SHANK


ON SURFACE - ~~BELOW~~ ON _____

~~LEFT~~ - Q PAV'T - RIGHT 3.3'

6.5' TO RT EDGE PAVEMENT


S.L.M. 371+98

Grid: Northing: 634839.805 Easting: 1693468.849

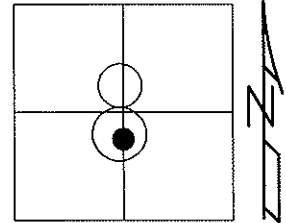

RECORD: P.I. #53
 STA.= 373+62.28
 $\Delta = 8^{\circ} 40' 00''$ LT
 FD PK SHANK
 GPS, REF60
 10/11/11, RJL

SET PNT. W/GPS,
 2 TIES REMAIN.
 SET MAG/WASHER
 GPS, FINREF60
 10/3/13, SDC

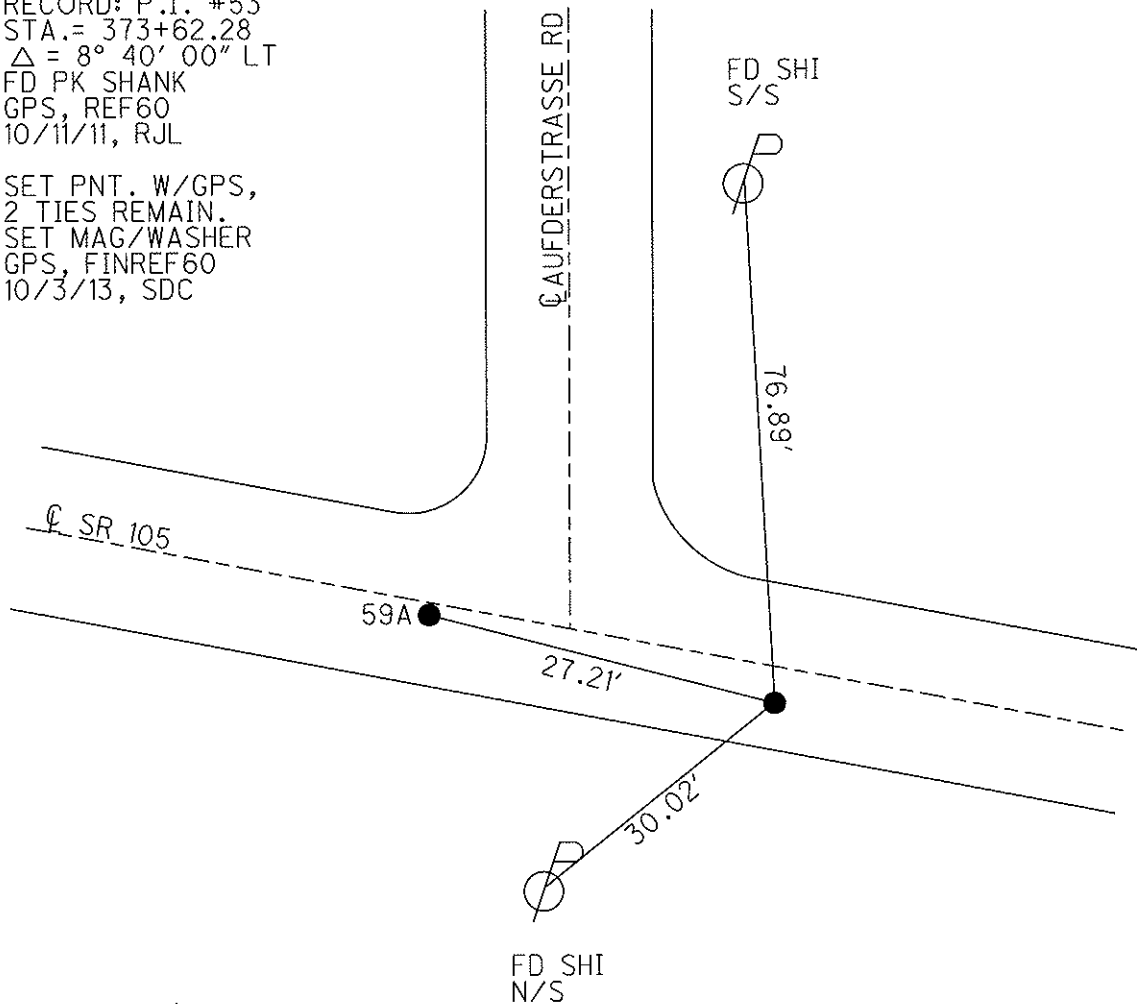

O.D.O.T. DISTRICT 2 SURVEY OFFICE

PERSONNEL

REFERENCE NO. 60

SHEET 12 OF 49

NOTES CHANEY

H.C. RIPPLE

R.C. BARBOUR

DATE 8-1-94

WEATHER FAIR

TEMP. +80°

ROUTE S.R. 105

COUNTY WOOD

TOWNSHIP WEBSTER

SECTION 8

T 5 N R 12 E


TYPE MONUMENT PK/WASHER

ON SURFACE - BELOW Yes

LEFT - ~~C~~ PAV'T. - RIGHT Yes 3.3 RT


6.5' TO RT EDGE PAVEMENT

S.L.M. 371 + 98

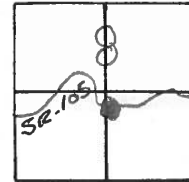


RECORD: P.I. #53
 STA - 373 + 62.28
 $\Delta = 8^\circ - 40' - 00''$ LT.

Aufderstrasse Rd.

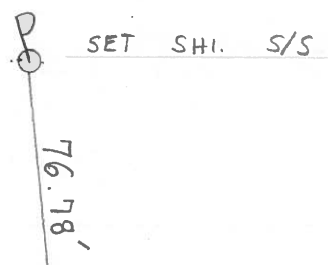

Δ Pavt.

S.R. 105

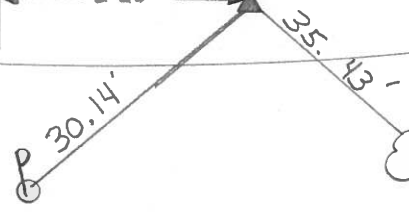

SET SHI. NE/S

Fd. SHI. N/S
 20" MAPLE
 3' UP

County WOOD S.R. 105

Township WEBSTER

Section 8

T₅N, R₁₂E

Personnel BARNHISEL HC

HOUSEHOLDER RC


LOEHRKE LD

HOFFMAN F

Date 8-8-84

Weather CLEAR, HUMID

Temp. 84

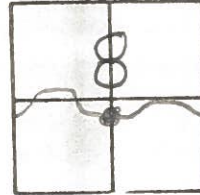

60

RECORDED
P.I. # 53

373+62.28


$\Delta = 8^{\circ} - 40' - 00''$ Lt.

SLM 370+54

- Fd Sm. RR spike @ SURFACE
- 0.5 REP
- 1.24 LEP
- 3.3 RT of & PAVT SR105
- 20 E. of & PAVT. Co. Rd.

SET PK W/WASHER

10-3-84

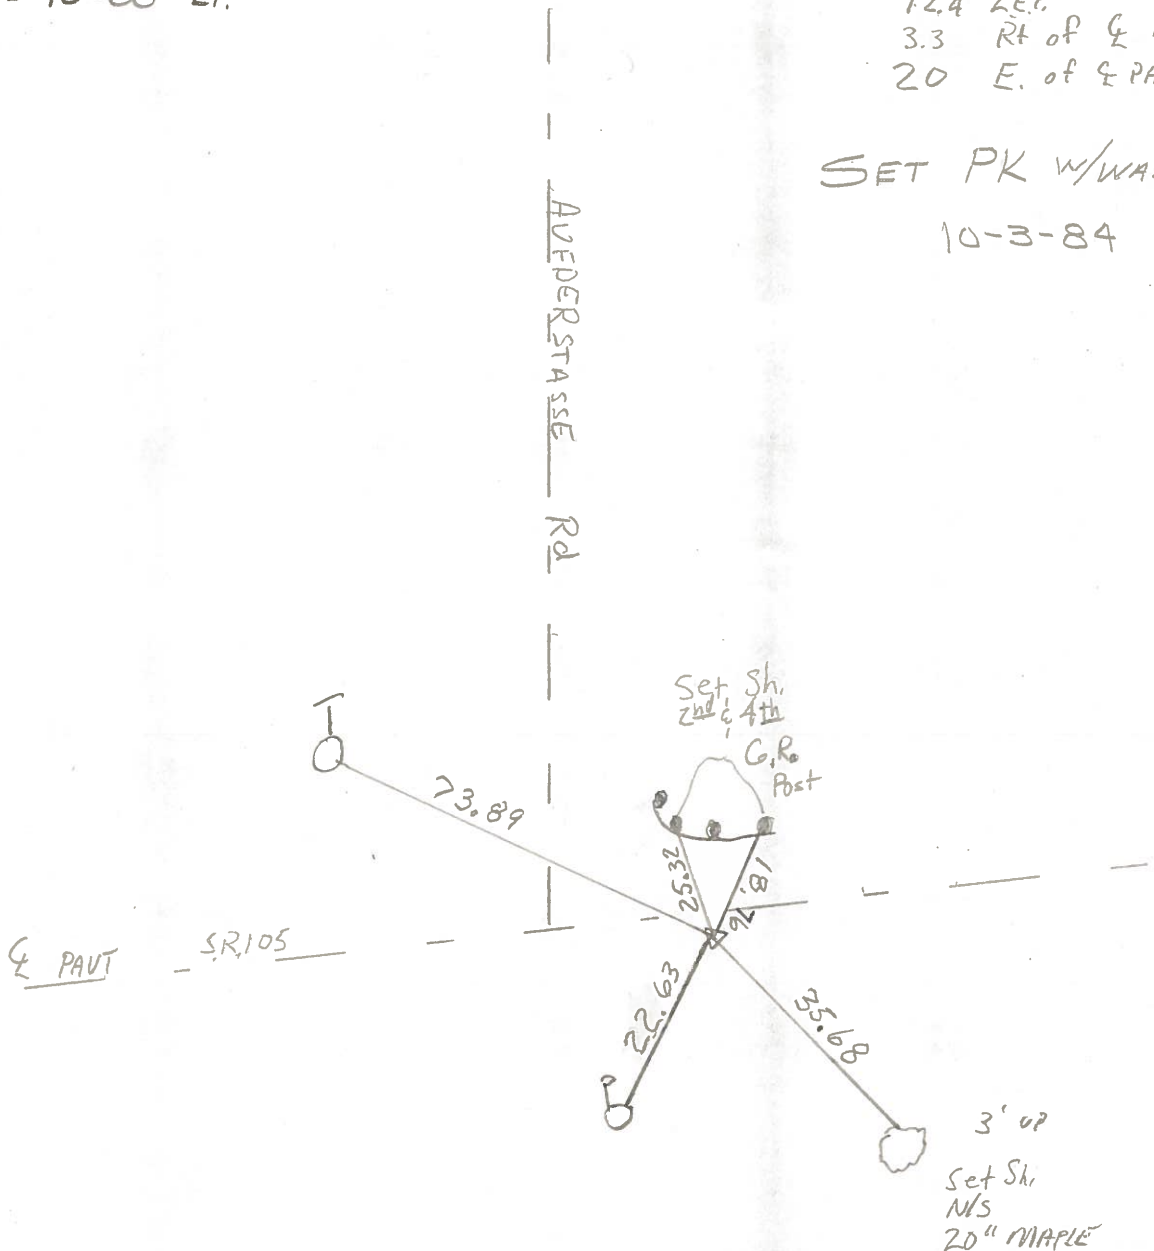

OD.OT. DISTRICT 2 SURVEY OFFICE

SHEET _____ OF _____

County WOOD S.R. 105

Date OCT-16-73

Township WEBSTER

Weather CLOUDY

Section 8

Temp. 50°


T N, R E

Personnel STONE

MICHALAK

CURTIS

DENNO

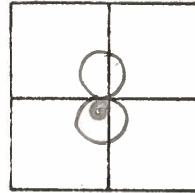

#60

P.I #53

373+62.28

$\Delta = 8^{\circ}-40'-00''$ Lt.

