

O.D.O.T. DISTRICT 2 SURVEY OFFICE (USE ONLY)

PERSONNEL _____

REFERENCE NO. 66

SHEET 23 OF 33

NOTES HOMAN

DATE 6/11/13

ROUTE SR 105

H.C. HOMAN

WEATHER PT.CLOUDY

COUNTY WOOD

R.C. CODER

TEMP. 84°

TOWNSHIP WEBSTER

SECTION 8

DWG BY RHOADES PID _____

T 5 N R 12 E

TYPE MONUMENT LG.R.R.SPIKE

~~ON SURFACE~~ - BELOW 1/2"

OFFSET ☉ PAVEMENT - ~~LT~~ : RT

25' TO RT EDGE PAVEMENT


STATION: 394+47.30

HORZ.DATUM: NAD83


GEOID: NAVD88 2009

GRID: NORTHING: 634473.490

EASTING: 1696041.551

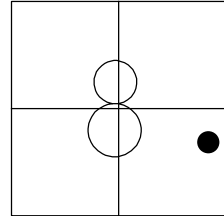


RECORD: P.I.
 STA. = 397+60.41
 $\Delta = 32^{\circ}15'20''$ LT
 FD LG.R.R.SPIKE
 PAINTED YELLOW
 REF66
 10/11/11, RJL

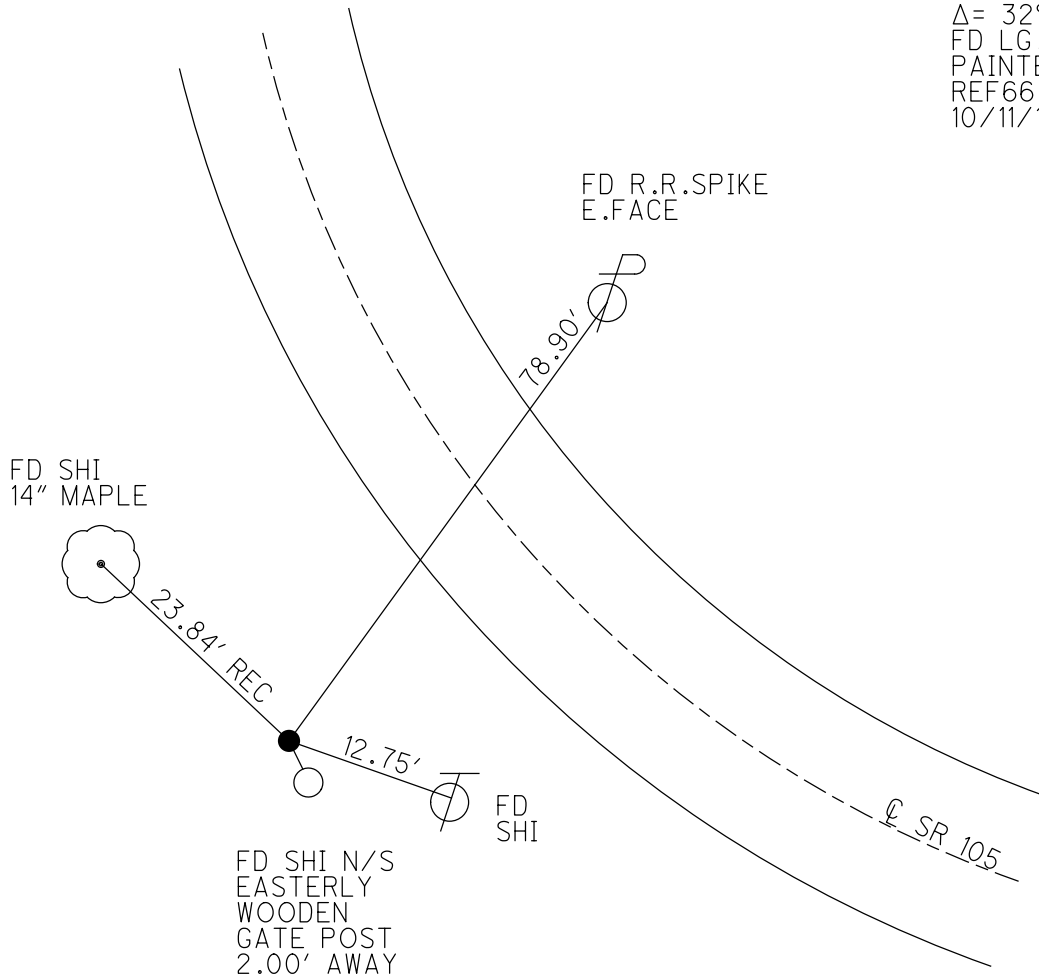


O.D.O.T. DISTRICT 2 SURVEY OFFICE (USE ONLY)

PERSONNEL	REFERENCE NO. <u>66</u>	SHEET <u>23</u> OF <u>33</u>
NOTES <u>HOMAN</u>	DATE <u>6/11/13</u>	ROUTE <u>SR 105</u>
H.C. <u>HOMAN</u>	WEATHER <u>PT.CLDY.</u>	COUNTY <u>WOOD</u>
R.C. <u>CODER</u>	TEMP. <u>84°</u>	TOWNSHIP <u>WEBSTER</u>
		SECTION <u>8</u>
		T <u>5</u> N R <u>12</u> E

TYPE MONUMENT LG.R.R.SPIKE, PAINTED YELLOW
~~ON SURFACE~~ - BELOW 1/2"
~~LEFT~~ - CL PAV'T - RIGHT -
25' TO RT EDGE PAVEMENT
 S.L.M. 396+00
 Grid: Northing: 634473.490 Easting: 1696041.551

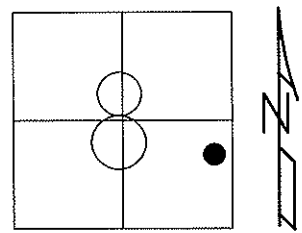

RECORD: P.I. #59
 STA.= 397+60.41
 $\Delta = 32^{\circ} 15' 20''$ LT
 FD LG.R.R.SPIKE
 PAINTED YELLOW.
 GPS, REF66
 10/11/11, RJL

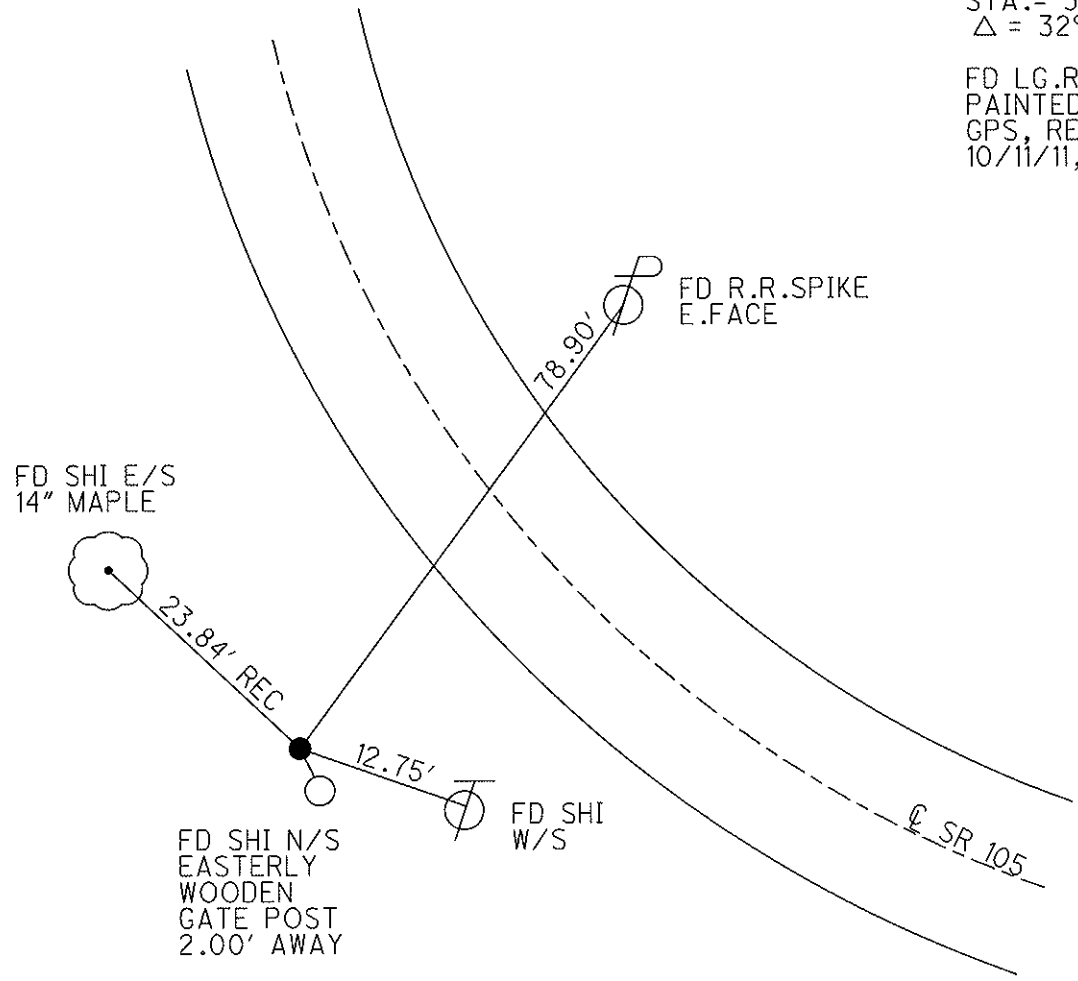

O.D.O.T. DISTRICT 2 SURVEY OFFICE

PERSONNEL _____

REFERENCE NO. 66

SHEET 18 OF 49

NOTES CHANEY

H.C. RIPPLE

R.C. BARBOUR

DATE 8-1-94

WEATHER FAIR

TEMP. +80°

ROUTE S.R. 105

COUNTY WOOD

TOWNSHIP WEBSTER

SECTION 8

T 5 N R 12 E


TYPE MONUMENT Lg. RR SPIKE

ON SURFACE - BELOW Yes 1/2" DOWN


LEFT - ~~C~~ PAV'T. - RIGHT Yes

25' RT TO RT EDGE PAVEMENT

S.L.M. 396+00

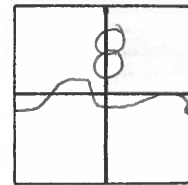

RECORD: P.I. # 59
 STA - 397+60.41
 $\Delta = 32^\circ - 15' - 20''$ LT.

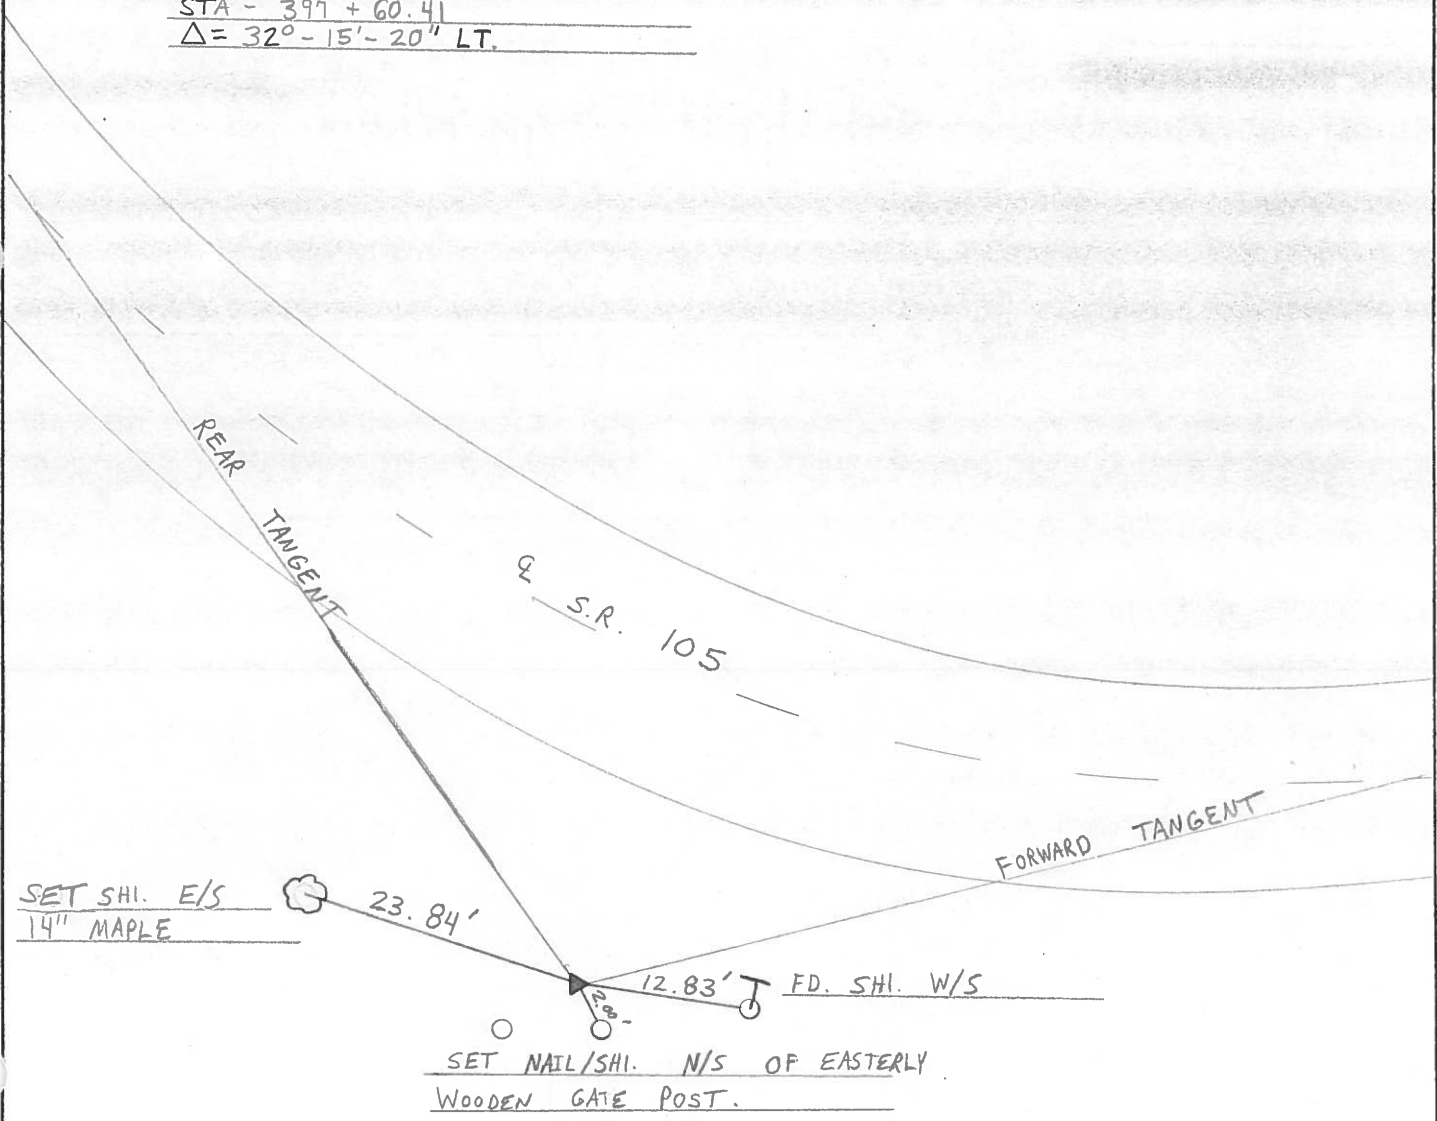

County WOOD S.R. 105

Township WEBSTER

Section 8

T5N, R12E

Personnel BARNHISEL HC

HOUSEHOLDER RC


LOEHRKE ID

Hoffman P

Date 8-8-84

Weather CLOUDY HUMID

Temp. +86

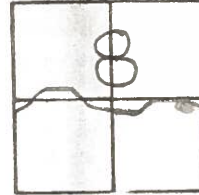

66


RECORDED
P.I. # 59

397+60.41

$\Delta = 32^{\circ} - 15' - 20'' \text{ Lt.}$

Fd: RR spike in STONE DRIVEWAY
NEAR EAST EDGE of DRIVE
10.8 Rt of REP

SLM 394+36

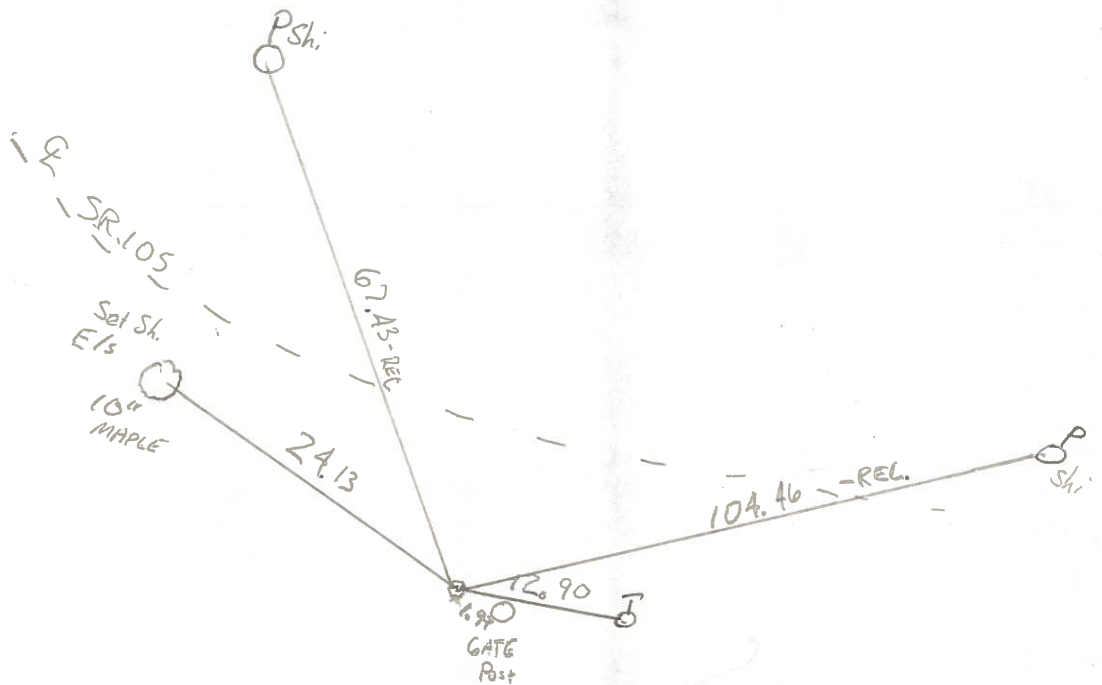

O.D.O.T. DISTRICT 2 SURVEY OFFICE

SHEET OF

County WOOD S.R. 105

Date OCT.-31-73

Township WEBSTER

Weather CLOUDY

Section 8

Temp. 50°


T N, R E

Personnel STONE

MICHALAK

CURTIS

DENNO

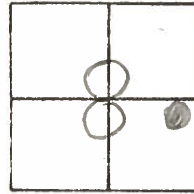

#66

P.I. #59

397+60.41

A = 32°-15'-20" LT.

