


O.D.O.T. DISTRICT 2 SURVEY OFFICE (USE ONLY)


PERSONNEL _____ REFERENCE NO. 68 SHEET 25 OF 33
 NOTES RHOADES DATE 8/18/22 ROUTE SR 105
 H.C. AUBLE WEATHER SUNNY COUNTY WOOD
 R.C. NIESE TEMP. 74° TOWNSHIP FREEDOM
 DWG BY RHOADES PID PAVETRAIN SECTION 9
 T 5 N R 12 E

TYPE MONUMENT MAG/WASHER
 ON SURFACE - ~~BELOW~~ ON _____
 OFFSET \odot PAVEMENT 8.5' \pm : RT
1.5' TO LT EDGE PAVEMENT
 STATION: 411+81.83

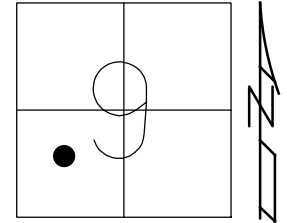

HORZ. DATUM: NAD83 2011 GEOID: NAVD88 2018
 GRID: NORTHING: 634364.159 EASTING: 1697328.456


RECORD: P.I.
 STA.= 414+95.43
 $\Delta = 10^{\circ}07' 20''$ RT
 SET P.K./WASHER
 11/8/94, CL
 FD P.K. SHANK
 REF68
 10/11/11, RJL
 6/10/13, SDC
 SET MAG/WASHER
 FINREF68
 10/3/13, SDC
 FD MAG/WASHER
 8/18/22, DSA

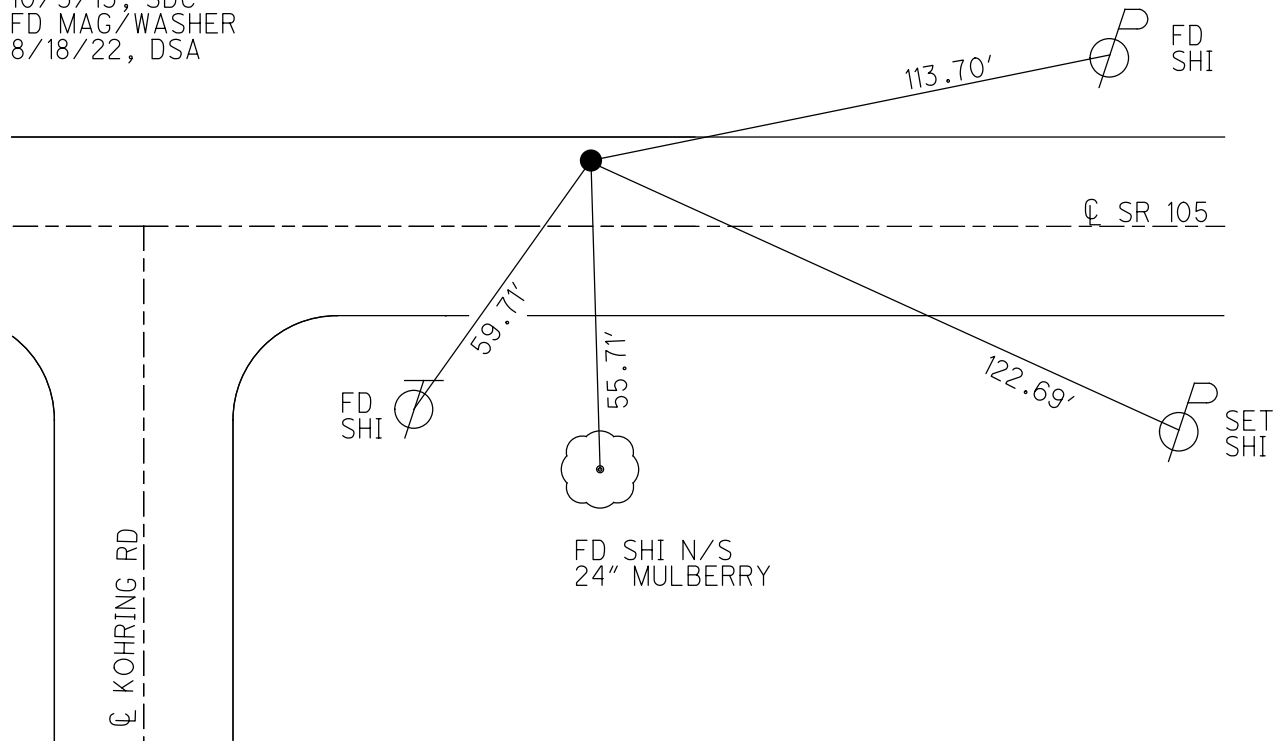

O.D.O.T. DISTRICT 2 SURVEY OFFICE (USE ONLY)

PERSONNEL	REFERENCE NO. <u>68</u>	SHEET <u>26</u> OF <u>33</u>
NOTES <u>RHOADES</u>	DATE <u>6/10/13</u>	ROUTE <u>SR 105</u>
H.C. <u>CODER</u>	WEATHER <u>CLOUDY</u>	COUNTY <u>WOOD</u>
R.C. <u>RHOADES</u>	TEMP. <u>72°</u>	TOWNSHIP <u>FREEDOM</u>
		SECTION <u>9</u>
		T <u>5</u> N R <u>12</u> E

TYPE MONUMENT P.K.SHANK
 ON SURFACE - ~~BELOW~~ ON
 LEFT - Q PAV'T - ~~RIGHT~~ 8.5'
1.5' TO LT EDGE PAVEMENT
 S.L.M. 413+29
 Grid: Northing: 634364.156 Easting: 1697328.339

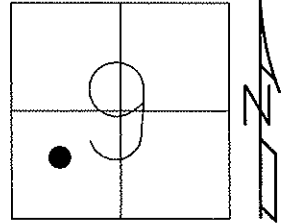


RECORD: P.I. #61
 STA.= 414+95.43
 $\Delta = 10^{\circ} 07' 20''$ RT
 RESET P.K./WASHER
 11/8/94, C.L.

FD P.K.SHANK
 GPS, REF68
 10/11/11, RJL

SET MAG/WASHER
 9/25/13, SDC
 GPS, FINREF68
 10/3/13, SDC

FD SHI
 W/S

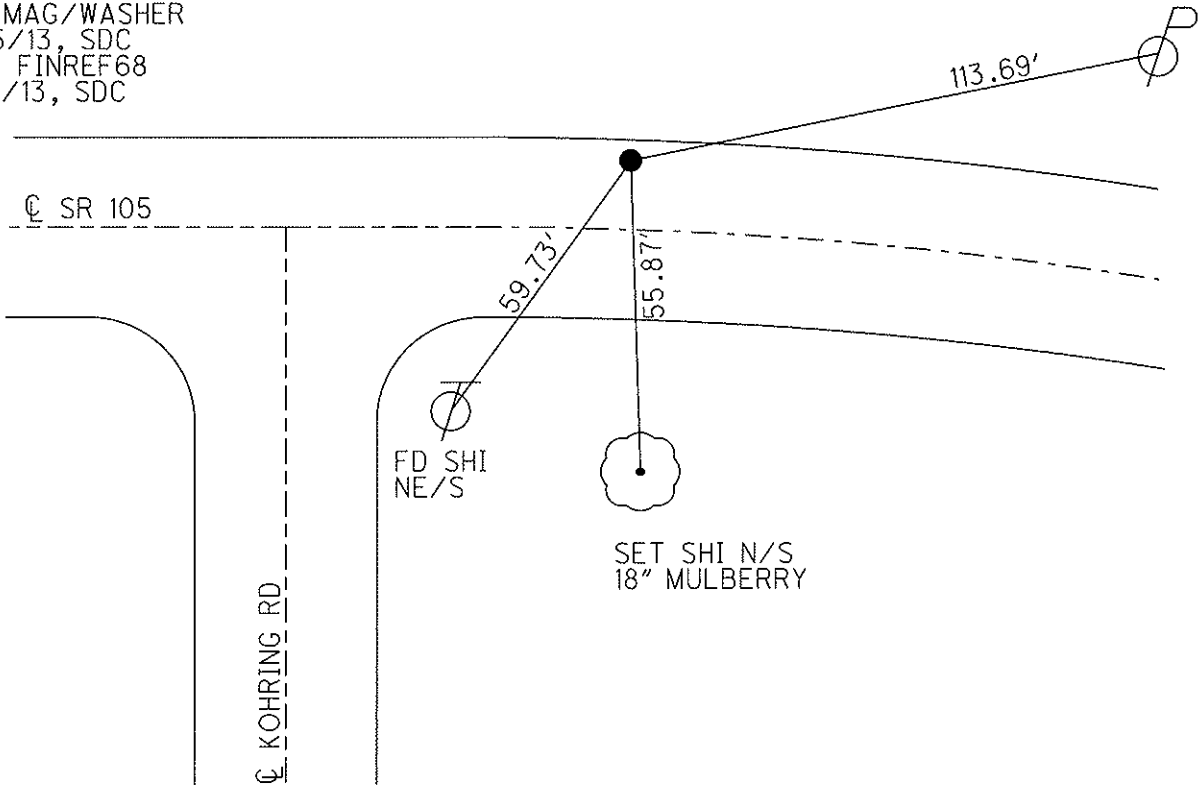

O.D.O.T. DISTRICT 2 SURVEY OFFICE

PERSONNEL _____

REFERENCE NO. 68

SHEET 20 OF 49

NOTES CHANEY

H.C. RIPPLE

R.C. BARBOUR

DATE 8-1-94

WEATHER FAIR

TEMP. +80°

ROUTE S.R. 105

COUNTY WOOD

TOWNSHIP FREEDOM

SECTION 9

T 5 N R 12 E

Reset 11-8-94


TYPE MONUMENT PK/WASHER C.L.

ON SURFACE - BELOW YES

LEFT - PAVT. - RIGHT YES 8.5' LT. &

1.5' TO LT. EDGE PAVEMENT


S.L.M. 413 + 29

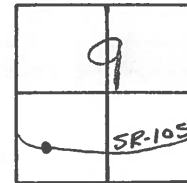

RECORD: P.I. # 61

STA - 414 + 95.43

$\Delta = 10^{\circ} - 07' - 20''$ R+.

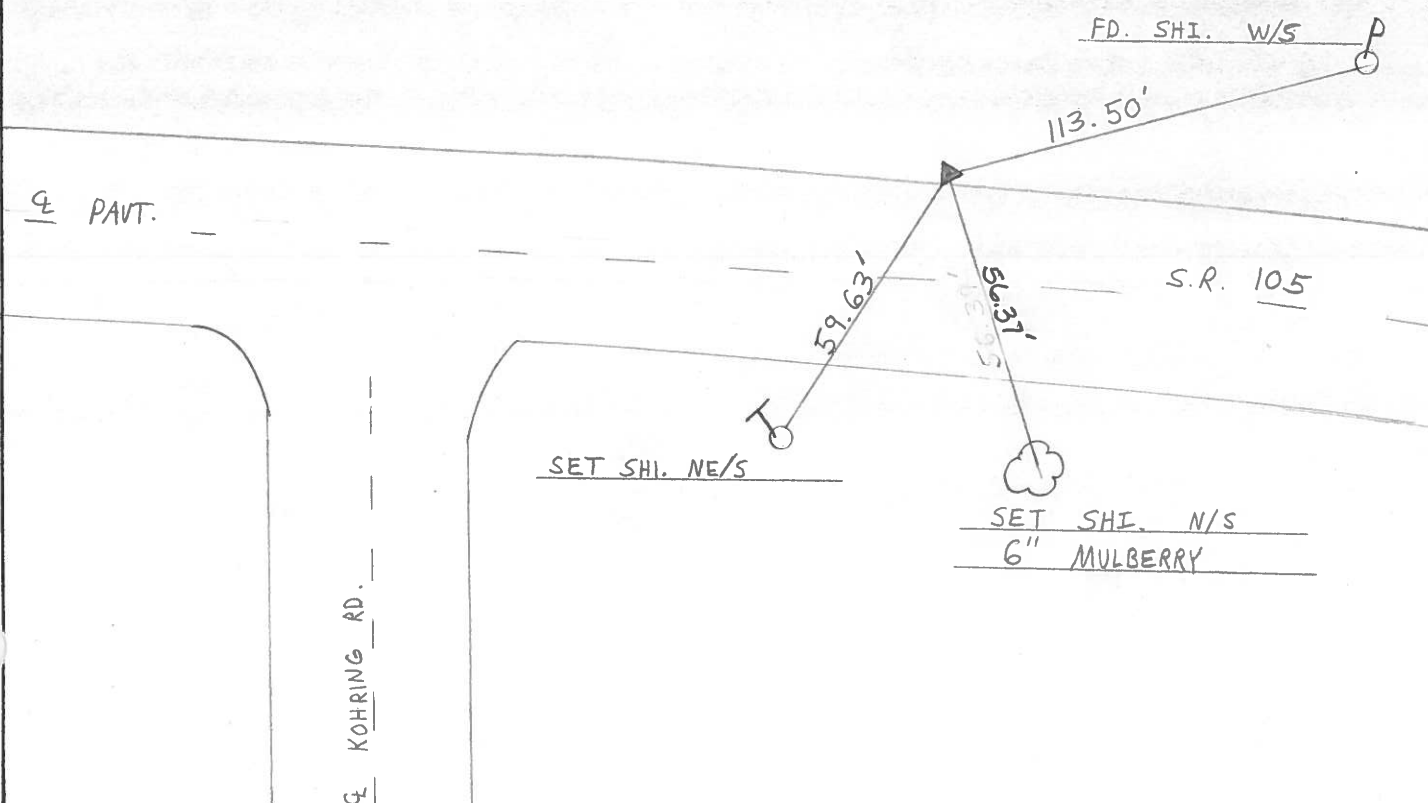

County WOOD S.R. 105

Township FREEDOM

Section 9


TSN, R12E

Personnel	<u>BIRNEY</u>	<u>HC</u>
	<u>HOUSEHOLDER</u>	<u>RC</u>
	<u>LOHRKE</u>	<u>LD</u>
	<u>H6 PFAU</u>	<u>P</u>

Date 8-8-84

Weather Pt CLOUDY Humid

Temp. + 81

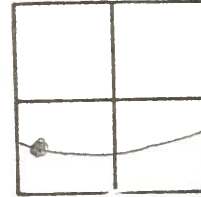


#60

PI STA 414+95.43
 $\Delta = 10^{\circ} 07' 20''$ Rt

Fd: RR SPIKE @ SURFACE
0.9 LEP
18.7 REP
8.5 LFOF & PAUT

SLM 411+63

SET PK W/WASHER
10-3-84
C.L.

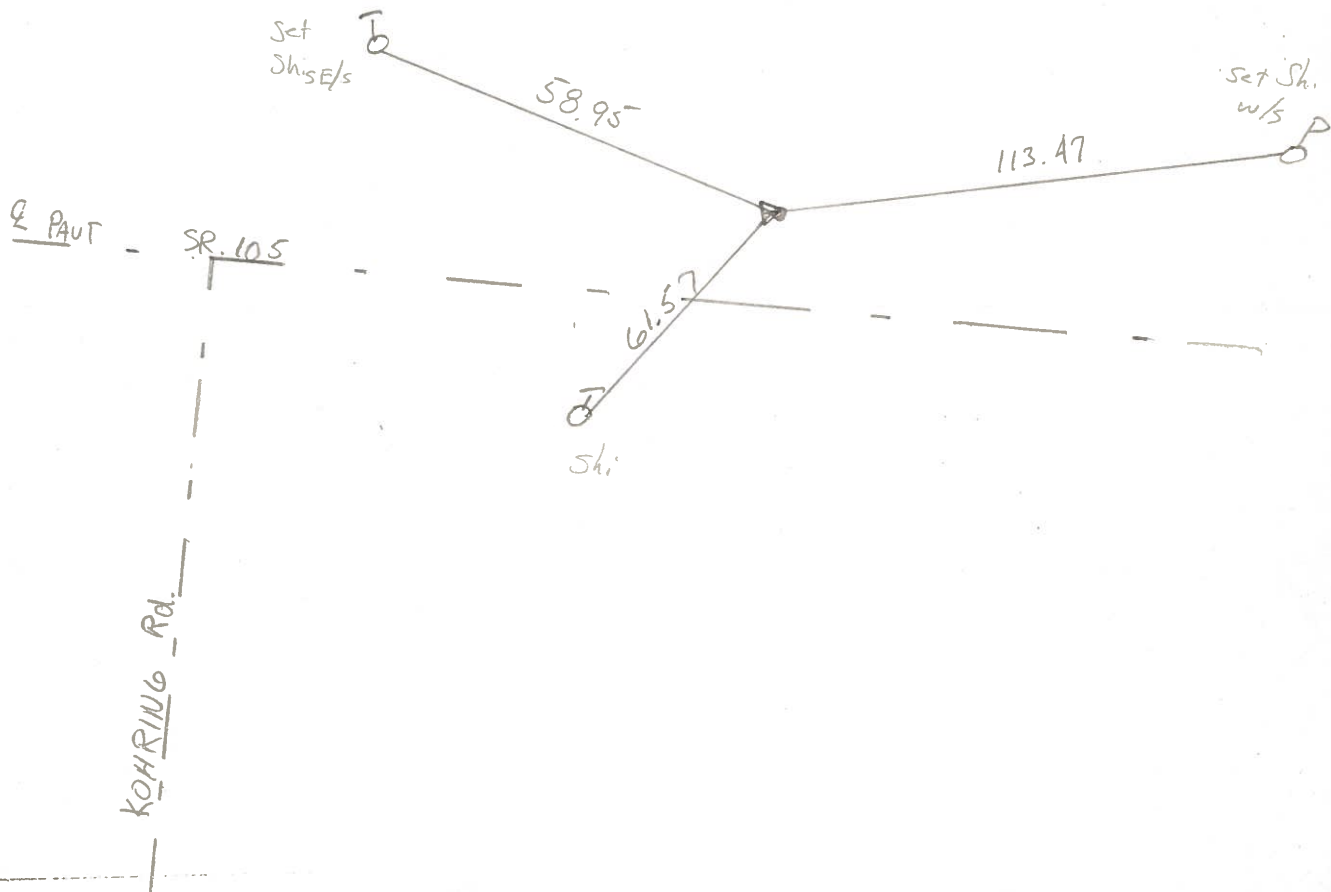

County WOOD S.R. 105

Date 10-31-73

Township WEBSTER-FREEDOM


Weather CLOUDY

Section 9

Temp. 50°

T5N, R12E

Personnel STONE
MICHALAK
DENNO
CURTIS

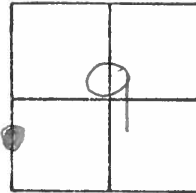

#68

P.I. STA. 414+95.43

$\Delta = 10^{\circ} - 07' - 20''$ RT.

1.0' TO N. EDGE PVT.

18.2' TO S. EDGE PVT.

