

O.D.O.T. DISTRICT 2 SURVEY OFFICE (USE ONLY)

PERSONNEL

REFERENCE NO. 70

SHEET 28 OF 33

NOTES RHOADES

DATE 8/18/22

ROUTE SR 105

H.C. AUBLE

WEATHER SUNNY

COUNTY WOOD

R.C. NIESE

TEMP. 74°

TOWNSHIP FREEDOM

SECTION 9

DWG BY RHOADES

PID PAVETRAIN

T 5 N R 12 E

TYPE MONUMENT MAG/WASHER

ON SURFACE - ~~BELOW~~ ON

OFFSET CL PAVEMENT 9.9' ~~±~~ : RT

6.8' TO RT EDGE PAVEMENT


STATION: 423+72.36

HORIZ.DATUM: NAD83 2011

GEOID: NAVD88 2018

GRID: NORTHING: 634109.828

EASTING: 1698490.546

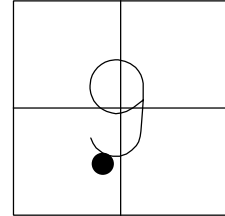

FD
SHI

129.22'

FD
SHI

38.00'

FD "+"
2" IPIPE
2.25' DOWN

69.25' REC

CL SR 105

87.28'


SET NOTCH
1' UP
GR POST

RECORD: P.I.
STA.= 426+85.79
 $\Delta = 16^{\circ}34'20''$ LT
SET P.K./WASHER
11/8/94, CL
SET MAG/WASHER
REF70
10/11/11, RJL
FD MAG/WASHER
6/10/13, SDC
SET MAG/WASHER
FINREF70
10/3/13, SDC
FD MAG/WASHER
8/18/22, DSA
REF70
3/2/23, DSA


O.D.O.T. DISTRICT 2 SURVEY OFFICE (USE ONLY)

PERSONNEL	REFERENCE NO. <u>70</u>	SHEET <u>28</u> OF <u>33</u>
NOTES <u>RHOADES</u>	DATE <u>6/10/13</u>	ROUTE <u>SR 105</u>
H.C. <u>CODER</u>	WEATHER <u>CLOUDY</u>	COUNTY <u>WOOD</u>
R.C. <u>RHOADES</u>	TEMP. <u>72°</u>	TOWNSHIP <u>FREEDOM</u>
		SECTION <u>9</u>
		T <u>5</u> N R <u>12</u> E

TYPE MONUMENT MAG / WASHER
 ON SURFACE - ~~BELOW~~ ON
~~LEFT~~ - C PAV'T - RIGHT 9.9'
0.9' TO RT EDGE PAVEMENT
 S.L.M. 425+24
 Grid: Northing: 634109.847 Easting: 1698490.473

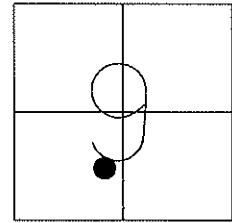



SET
SHI

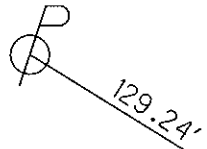

FD SHI
SE/S



FD "+" CUT IN 2"
IPIPE. 2.25' DOWN

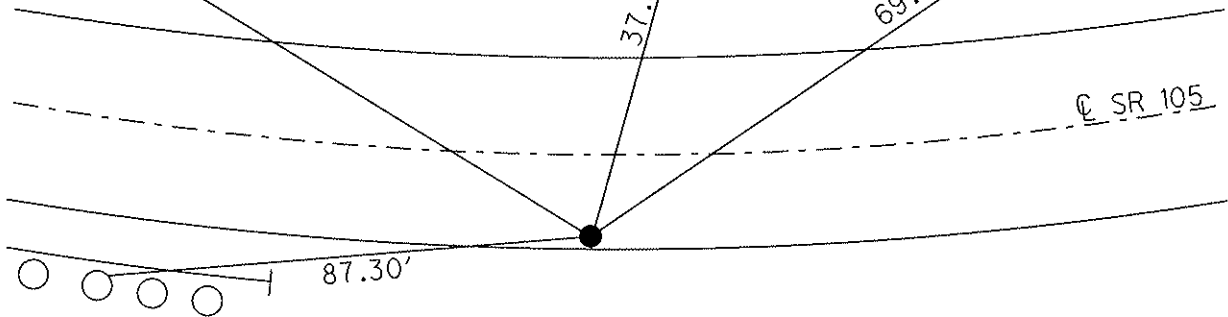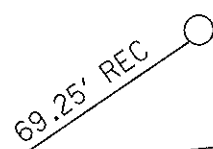

3rd G.R. POST
1' UP, NEAR EDGE

RECORD: P.I. #63
 STA.= 426+85.79
 $\Delta = 16^\circ 34' 20''$ LT
 RESET P.K./WASHER
 11/8/94, C.L.

DNF P.K./WASHER. FD HOLE.
 SET MAG/WASHER WITH TIES.
 GPS, REF70
 10/11/11, RJL

SET MAG/WASHER
 9/25/13, SDC
 GPS, FINREF70
 10/3/13, SDC

O.D.O.T. DISTRICT 2 SURVEY OFFICE

PERSONNEL _____

REFERENCE NO. 70

SHEET 22 OF 49

NOTES CHANEY

H.C. RIPPLE

R.C. BARBOUR

DATE 8-4-94

WEATHER CLOUDY

TEMP. +80°

ROUTE S.R. 105

COUNTY WOOD

TOWNSHIP FREEDOM

SECTION 9

T 5 N R 12 E


TYPE MONUMENT PK/WASHER Reset 11-8-94

ON SURFACE - ~~BELOW~~ YES

~~LEFT - & PAV'T.~~ - RIGHT YES 9.9' RT of &

0.9' TO RT EDGE PAVEMENT


S.L.M. 425 + 24

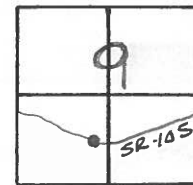

RECORD: P.I. # 63

STA - 426 + 85.79

▲ = 16° - 34' - 20" LT.

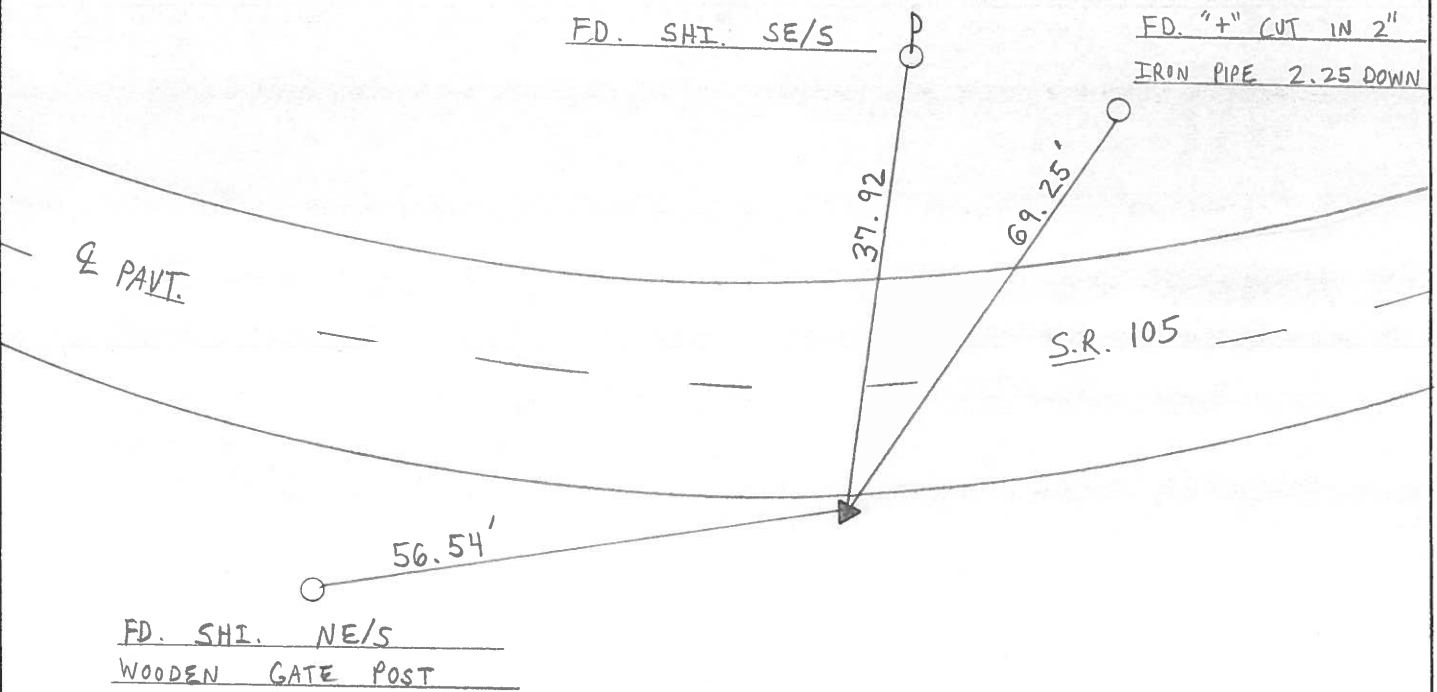

County Wood S.R. 105

Township FREEDOM

Section 9

T5N, R12E

Personnel BARNHISZ HC

HOUSEHOLDERS RC


LOENRKE D

HOFFMAN P

Date 8-8-84

Weather CLOUDY

Temp. +84

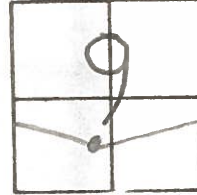

70

RECORDED
P.I. # 63

426+85.79

$\Delta = 160^\circ - 34' - 20''$ Lt.

fd Small RR spike @ SURFACE

0.1 REP

20.2 LEP


9.9 RE.P & PAVT

SLM 423 +51

SET PK W/WASHER

10-3-84

CL.

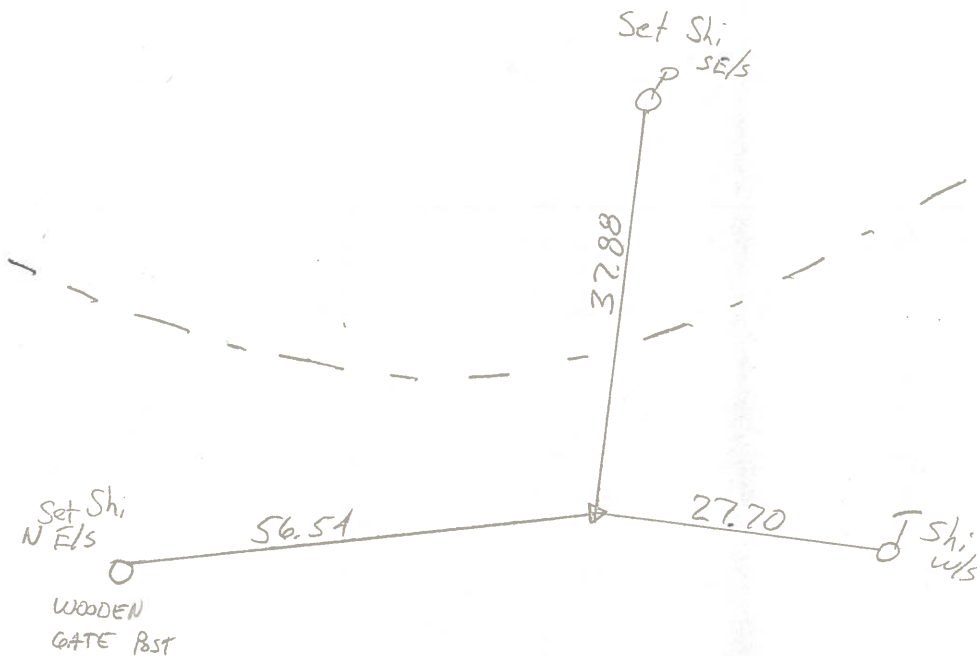

PERSONNEL	TITLE	PERSONNEL	TITLE	COUNTY	DATE	WEATHER	TEMP.
Stone				Wood	31 Oct. 75	Cloudy	50°
Michalok				S. R. 105			
Denno				SEC. Freedom Twp.			
Curtis							

DESCRIPTION References to Control Points JOB NO. _____
 LEFT CENTER LINE RIGHT

