

O.D.O.T. DISTRICT 2 SURVEY OFFICE (USE ONLY)

PERSONNEL

REFERENCE NO. 71

SHEET 29 OF 33

NOTES RHOADES

DATE 8/18/22

ROUTE SR 105

H.C. AUBLE

WEATHER SUNNY

COUNTY WOOD

R.C. NIESE

TEMP. 74°

TOWNSHIP FREEDOM

SECTION 9

DWG BY RHOADES

PID PAVETRAIN

T 5 N R 12 E

TYPE MONUMENT MAG/WASHER

ON SURFACE - ~~BELOW~~ ON

OFFSET $\text{\textcircled{C}}$ PAVEMENT ON LT : RT

9.7' TO LT EDGE PAVEMENT


STATION: 432+40.36

HORZ.DATUM: NAD83 2011


GEOID: NAVD88 2018

GRID: NORTHING: 634215.109

EASTING: 1699352.196

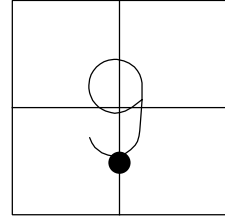


RECORD: P.I.
 STA.= 435+54.22
 $\Delta = 0^{\circ}30' 20''$ RT
 SET P.K./WASHER
 11/8/94, CL
 FD P.K./WASHER
 REF71
 10/11/11, RJL
 6/10/13, SDC
 SET MAG/WASHER
 FINREF71
 10/3/13, SDC
 FD MAG/WASHER
 8/18/22, DSA
 REF71
 3/2/23, DSA

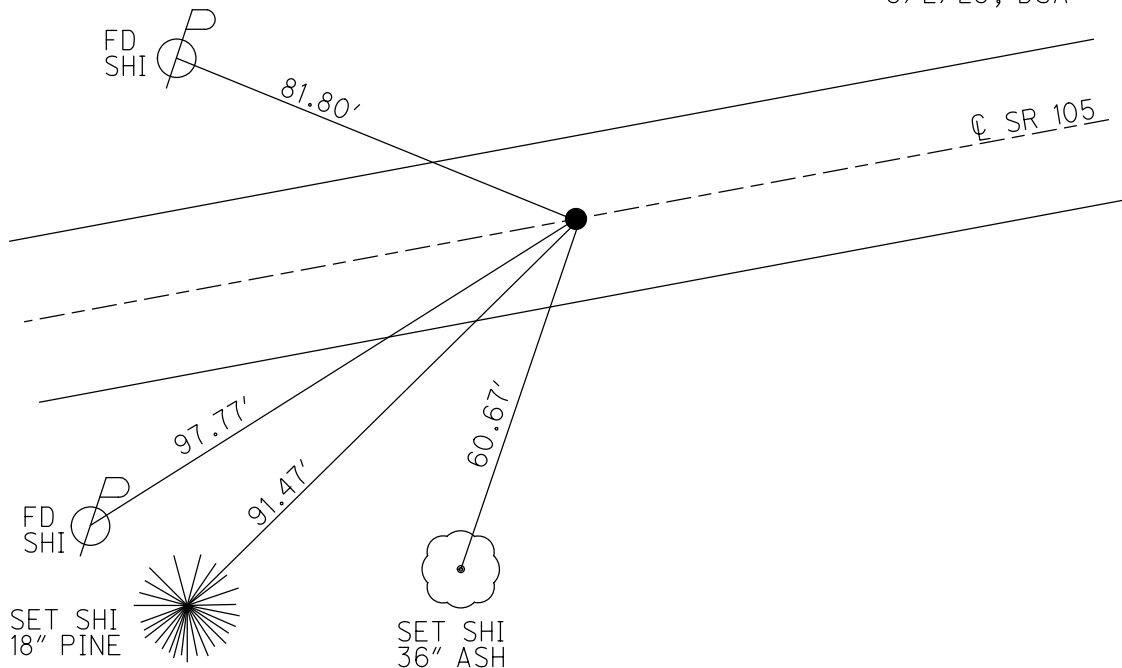

O.D.O.T. DISTRICT 2 SURVEY OFFICE (USE ONLY)

PERSONNEL	REFERENCE NO. <u>71</u>	SHEET <u>29</u> OF <u>33</u>
NOTES <u>RHOADES</u>	DATE <u>6/10/13</u>	ROUTE <u>SR 105</u>
H.C. <u>CODER</u>	WEATHER <u>RAIN</u>	COUNTY <u>WOOD</u>
R.C. <u>RHOADES</u>	TEMP. <u>72°</u>	TOWNSHIP <u>FREEDOM</u>
		SECTION <u>9</u>
		T <u>5</u> N R <u>12</u> E

TYPE MONUMENT P.K./WASHER
 ON SURFACE - ~~BELOW~~ ON
 LEFT - Q PAV'T - RIGHT ON
9.7' TO LT EDGE PAVEMENT
 S.L.M. 433+90

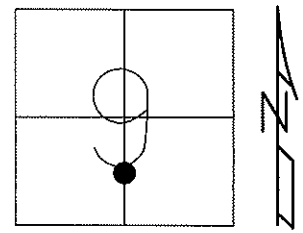


Grid: Northing: 634215.067 Easting: 1699352.150

RECORD: P.I. #64
 STA. = 435+54.22
 $\Delta = 0^\circ 30' 20''$ RT
 RESET P.K./WASHER
 11/8/94, C.L.

FD P.K./WASHER
 GPS, REF71
 10/11/11, RJL

SET MAG/WASHER
 9/25/13, SDC
 GPS, FINREF71
 10/3/13, SDC

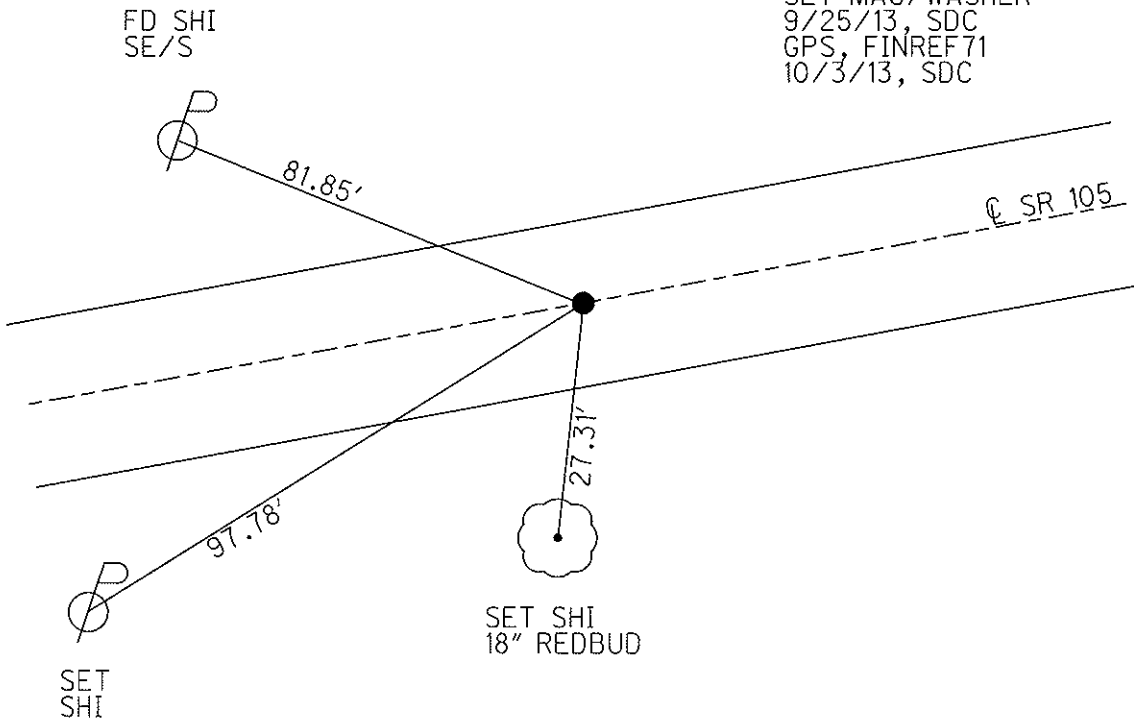

O.D.O.T. DISTRICT 2 SURVEY OFFICE

PERSONNEL _____

REFERENCE NO. 71

SHEET 23 OF 49

NOTES CHANEY

H.C. RIPPLE

R.C. BARBOUR

DATE 8-4-94

WEATHER CLOUDY

TEMP. +80°

ROUTE S.R. 105

COUNTY WOOD

TOWNSHIP FREEDOM

SECTION 9

T 5 N R 12 E

Reset 11-8-94


TYPE MONUMENT PK/WASHER

ON SURFACE - BELOW YES

~~LEFT - & PAVT.~~ - ~~RIGHT~~ YES ON &

9.7' TO LT. EDGE PAVEMENT

S.L.M. 433+90

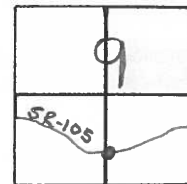

RECORD: P.I. # 64

STA - 435+54.22

$\Delta = 0^\circ - 30' - 20''$ RT.

ED. SHI. SE/S

P
81.89'

& PAVT.

S.R. 105

27.66'

80.60'

SET SHI. NE/S 10" TREE

SET SHI. NW/S

WOODEN FENCE

POST

County WOOD S.R. 105

Township FREE DOM

Section 9

T5N, R12E

Personnel BARNHISEL HC

HOUSEHOLDER RC

LOEHRKE TA


Hoffmann P

71

Date 8-8-84

Weather PT. CLOUDY HUMID

Temp. 85

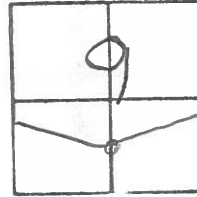

RECORDED

P.I. # 64

435+54.22

$\Delta = 0^\circ - 30' - 20''$ Rt.

Fd Sm RR spike @ SURF

ON & PAVT

9.8 REP


9.0 LEP

SLM 432+19

SET PK + WASHER

10-3-84

C.L.

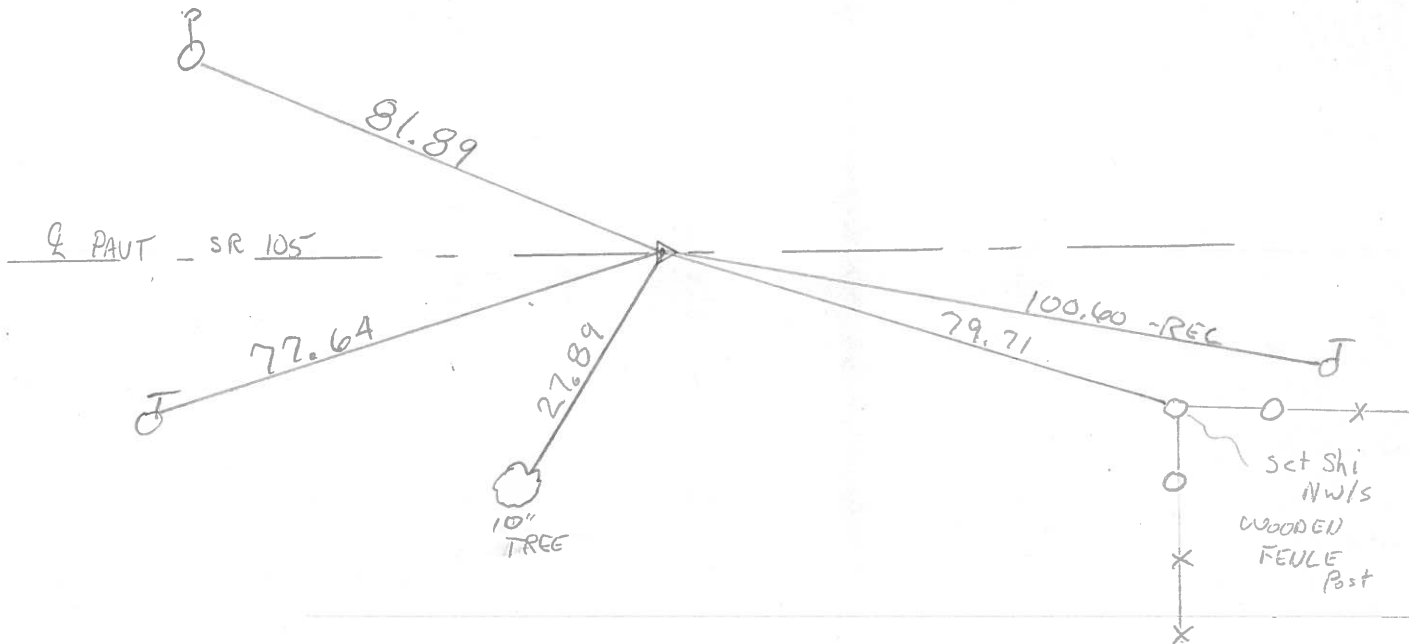

PERSONNEL	TITLE	PERSONNEL	TITLE	COUNTY	DATE	WEATHER	TEMP.
<u>Stone</u>				<u>Wood</u>	<u>31 Oct. 73</u>	<u>Cloudy</u>	<u>55°</u>
<u>Michalak</u>				<u>S. R. 105</u>			
<u>Dana</u>				<u>SEC. Freedom Twp.</u>			
<u>Curtis</u>							

DESCRIPTION References to Control Points JOB NO. _____
 LEFT CENTER LINE RIGHT

