

O.D.O.T. DISTRICT 2 SURVEY OFFICE (USE ONLY)

PERSONNEL

REFERENCE NO. 72

SHEET 30 OF 33

NOTES RHOADES

DATE 8/18/22

ROUTE SR 105

H.C. AUBLE

WEATHER SUNNY

COUNTY WOOD

R.C. NIESE

TEMP. 74°

TOWNSHIP FREEDOM

DWG BY RHOADES

PID PAVETRAIN

SECTION 9

T 5 N R 12 E

TYPE MONUMENT MAG/WASHER

ON SURFACE - ~~BELOW~~ ON

OFFSET CL PAVEMENT 10.6' ~~LT~~ : RT

0.7' TO RT EDGE PAVEMENT


STATION: 443+54.85

HORZ.DATUM: NAD83 2011


GEOID: NAVD88 2018

GRID: NORTHING: 634340.513

EASTING: 1700459.616

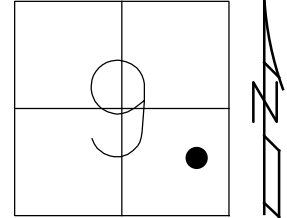


RECORD: P.I.
 STA.= 446+68.97
 $\Delta = 10^{\circ}00'00''$ LT
 SET P.K./WASHER
 11/8/94, CL
 SET MAG/WASHER
 REF72
 10/11/11, RJL
 FD MAG/WASHER
 6/10/13, SDC
 SET MAG/WASHER
 FINREF72
 10/3/13, SDC
 FD MAG/WASHER
 8/18/22, DSA
 REF72
 3/2/23, DSA

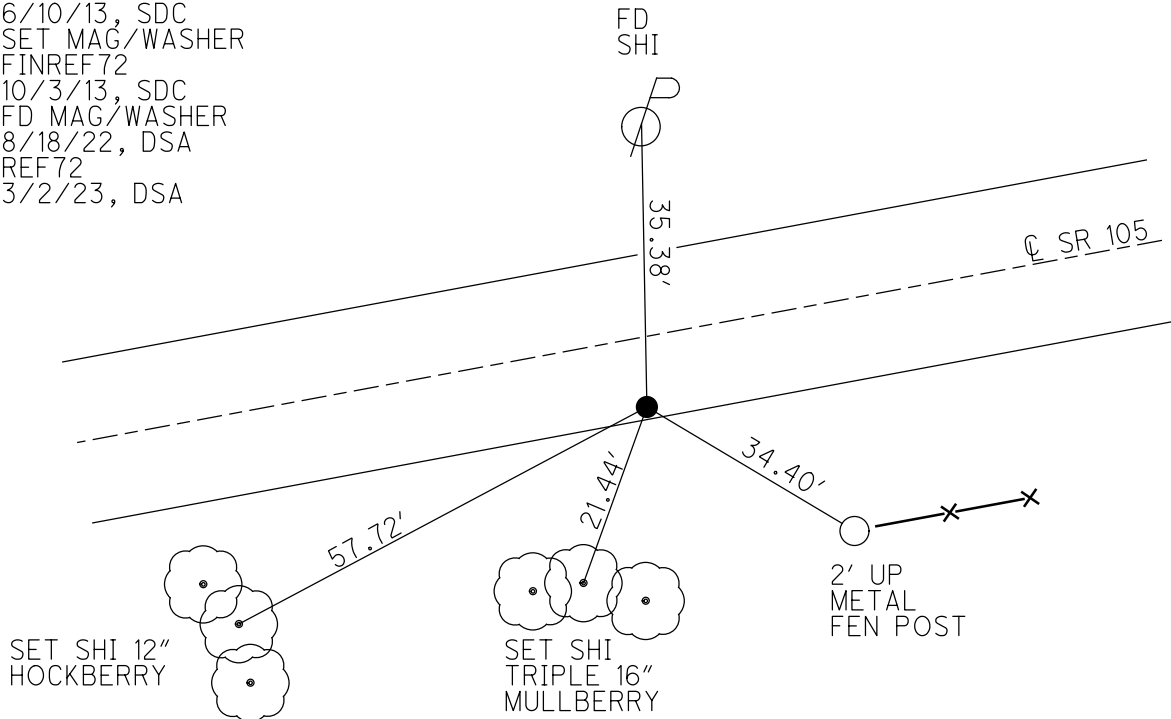

O.D.O.T. DISTRICT 2 SURVEY OFFICE (USE ONLY)

PERSONNEL	REFERENCE NO. <u>72</u>	SHEET <u>30</u> OF <u>33</u>
NOTES <u>RHOADES</u>	DATE <u>6/10/13</u>	ROUTE <u>SR 105</u>
H.C. <u>CODER</u>	WEATHER <u>CLOUDY</u>	COUNTY <u>WOOD</u>
R.C. <u>RHOADES</u>	TEMP. <u>72°</u>	TOWNSHIP <u>FREEDOM</u>
		SECTION <u>9</u>
		T <u>5</u> N R <u>12</u> E

TYPE MONUMENT MAG / WASHER
 ON SURFACE - ~~BELOW~~ ON
~~LEFT~~ - Q PAV'T - RIGHT 10.6'
0.7' TO RT EDGE PAVEMENT
 S.L.M. 445+05

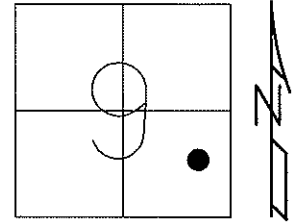


Grid: Northing: 634340.546 Easting: 1700459.580

RECORD: P.I. #65
 STA. = 446+68.97
 $\Delta = 10^{\circ} 00' 00''$ LT
 RESET P.K./WASHER
 11/8/94, C.L.

DNF P.K./WASHER. FD HOLE
 W/YELLOW PAINT.
 SET MAG/WASHER
 GPS, REF72
 10/11/11, RJL

SET MAG/WASHER
 9/25/13, SDC
 GPS, FINREF72
 10/3/13, SDC

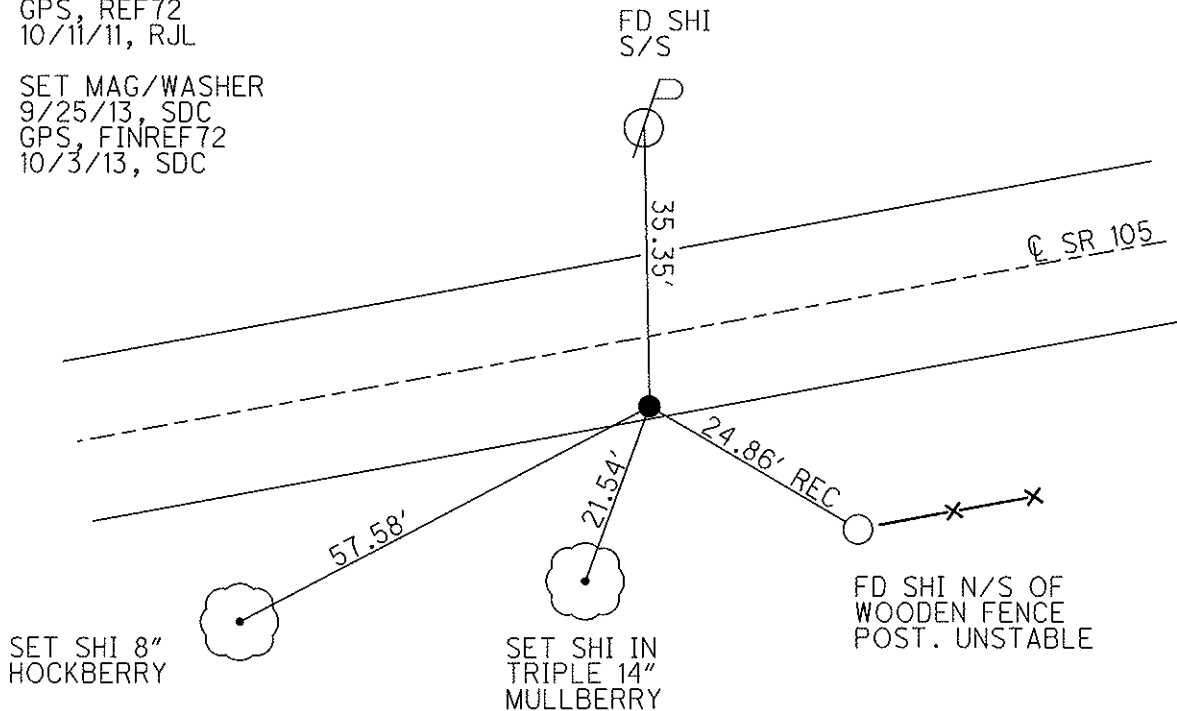

O.D.O.T. DISTRICT 2 SURVEY OFFICE

PERSONNEL _____

REFERENCE NO. 72

SHEET 24 OF 49

NOTES CHANEY

H.C. RIPPLE

R.C. BARBOUR

DATE 8-4-94

WEATHER CLOUDY

TEMP. +80°

ROUTE S.R. 105

COUNTY WOOD

TOWNSHIP FREEDOM

SECTION 9

T. 5 N R. 12 E

Reset 11-8-94


TYPE MONUMENT PK/WASHER

ON SURFACE - ~~BELOW~~ YES

~~LEFT - & PAV'T.~~ - RIGHT YES 10.6 RT &

0.7' TO RT. EDGE PAVEMENT


S.L.M. 445 + 05

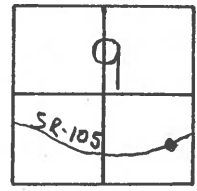

RECORD: PI. # 65

STA 446 + 68.97

$\Delta = 10^\circ - 00' - 00''$ LT.

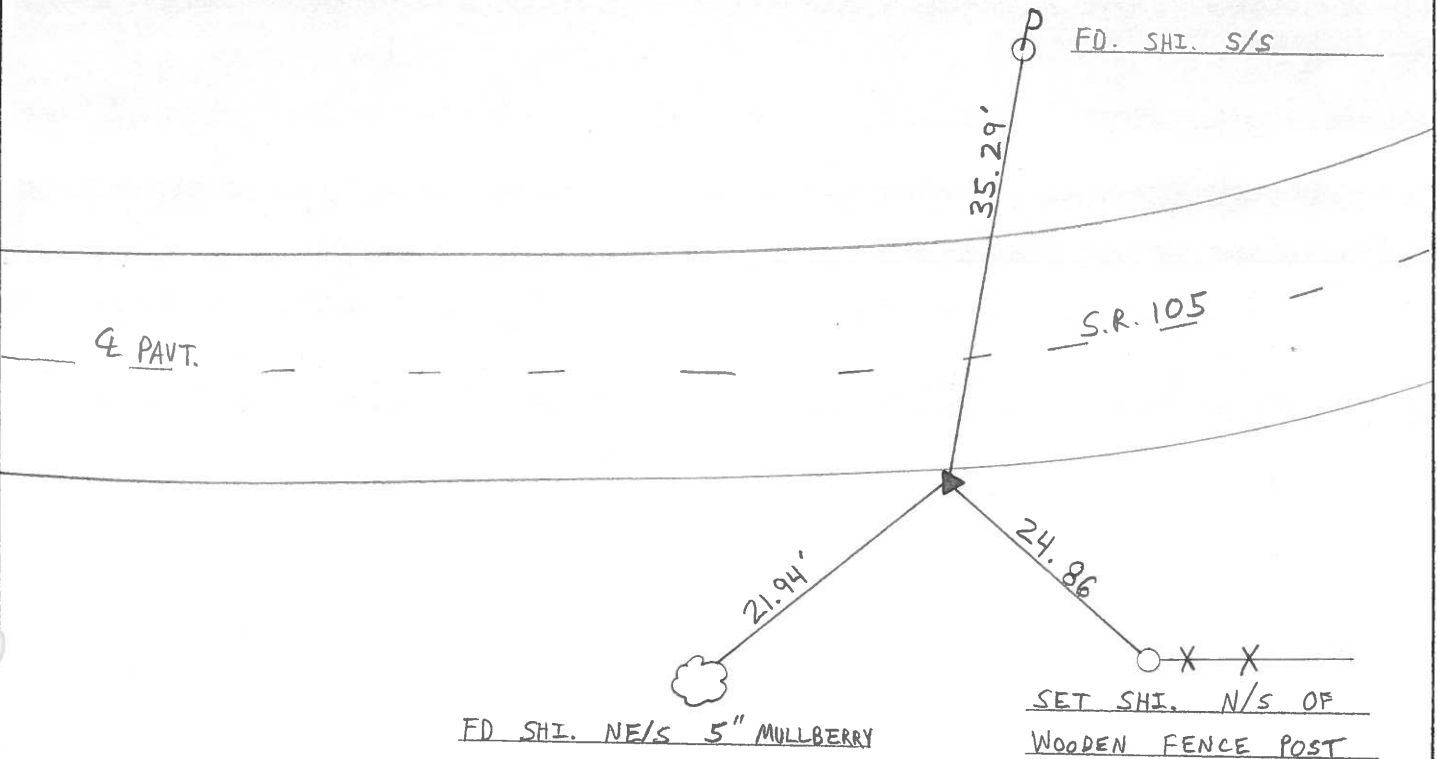

County WOOD S.R. 105

Township FREEDOM

Section 9

T5N, R12E

Personnel BARNY HC

HOUSEHOLDER RC

LOEHRKE □


HUFFMAN F

72

Date 8-8-84

Weather PT CLOUDY HUMID

Temp. 86

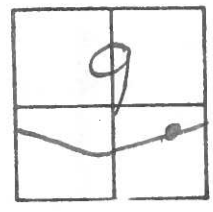

RECORDED
P.I. # 65

446+68.97

Δ = 10°-00'-00" Lt.

fd sm RR Spike 1" Below
0.7 Rt of REP

20.3 LEP


10.5 Rt of E PAUT

SLM 443+33

SET PK W/WASHER

10-3-84

C.L.

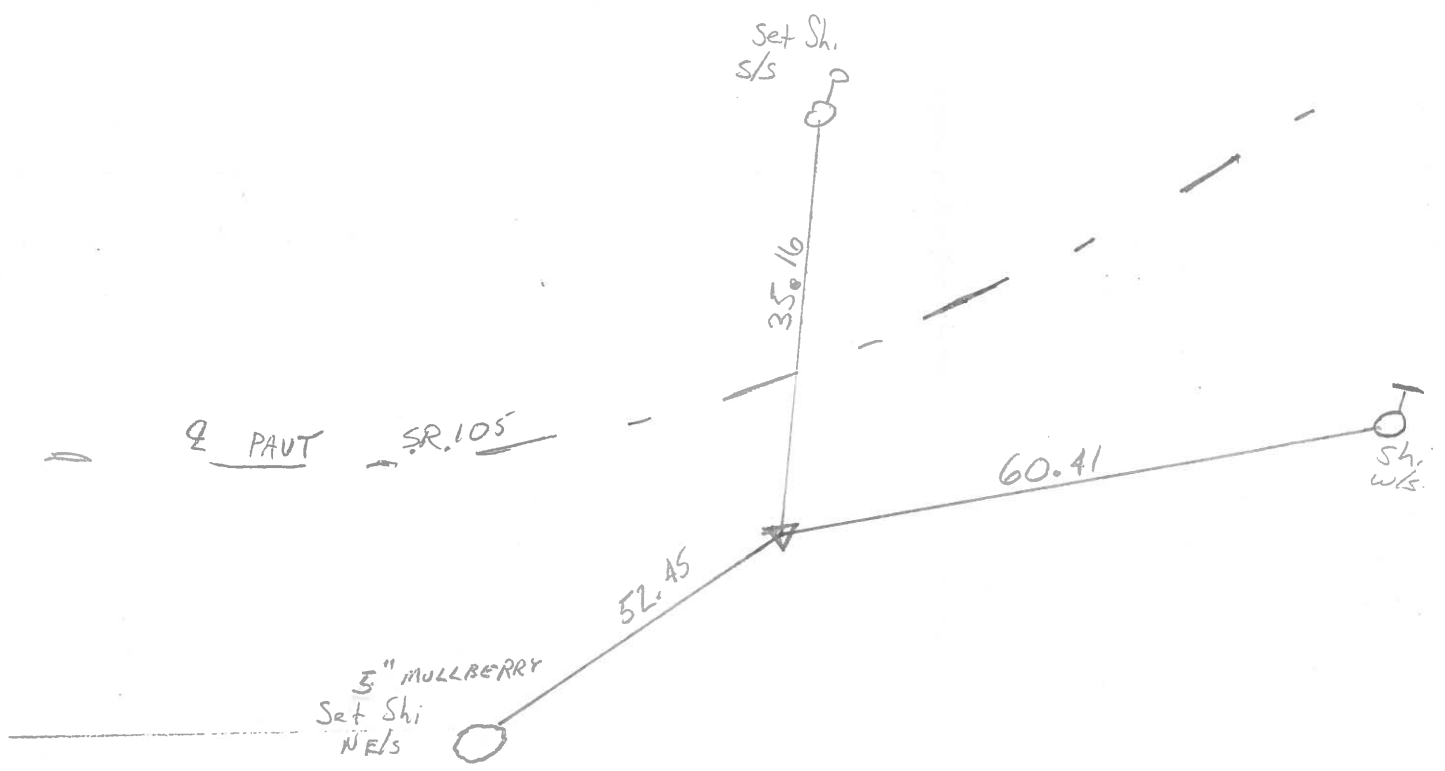

PERSONNEL	TITLE	PERSONNEL	TITLE	COUNTY	Wood	DATE	31 Oct. 73
Stone				S. R.	105	WEATHER	Cloudy
Michalak				SEC.	Freedom Twp.	TEMP.	55°
Danao							
Curtis							

DESCRIPTION References to Control Points LEFT CENTER LINE RIGHT JOB NO.

