

O.D.O.T. DISTRICT 2 SURVEY OFFICE (USE ONLY)

PERSONNEL

REFERENCE NO. 73

SHEET 31 OF 33

NOTES RHOADES

DATE 8/18/22

ROUTE SR 105

H.C. AUBLE

WEATHER SUNNY

COUNTY WOOD

R.C. NIESE

TEMP. 74°

TOWNSHIP FREEDOM

SECTION 9

DWG BY RHOADES

PID PAVETRAIN

T 5 N R 12 E

TYPE MONUMENT MAG/WASHER

ON SURFACE - ~~BELOW~~ ON

OFFSET CL PAVEMENT 0.6' ~~±~~ : RT

9.7' TO RT EDGE PAVEMENT



STATION: 448+57.29

HORIZ.DATUM: NAD83 2011

GEOID: NAVD88 2018

GRID: NORTHING: 634482.978

EASTING: 1700941.417

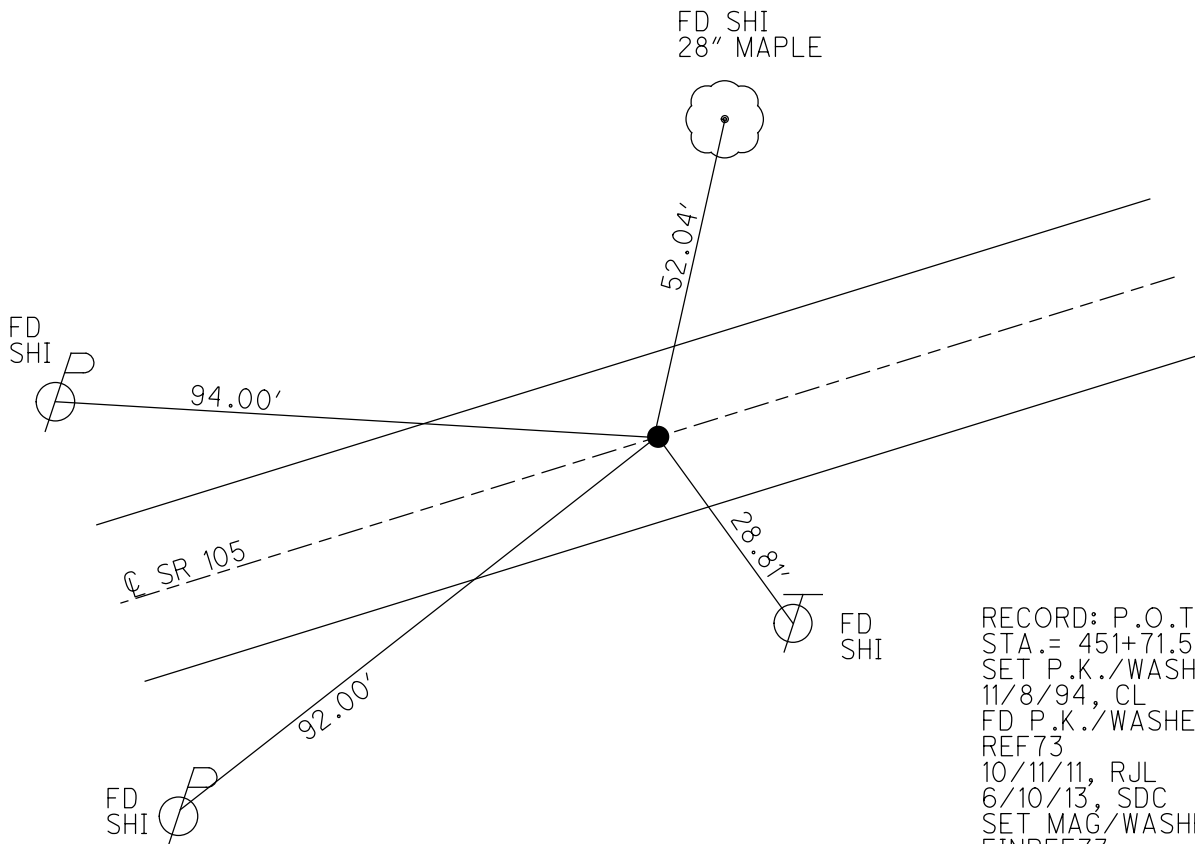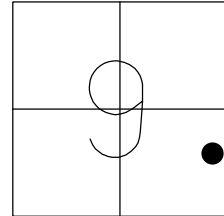

RECORD: P.O.T.
 STA. = 451+71.53
 SET P.K./WASHER
 11/8/94, CL
 FD P.K./WASHER
 REF73
 10/11/11, RJL
 6/10/13, SDC
 SET MAG/WASHER
 FINREF73
 10/3/13, SDC
 FD MAG/WASHER
 8/18/22, DSA
 REF73
 3/2/23, DSA

O.D.O.T. DISTRICT 2 SURVEY OFFICE (USE ONLY)

PERSONNEL

REFERENCE NO. 73

SHEET 31 OF 33

NOTES RHOADES

DATE 6/10/13

ROUTE SR 105

H.C. CODER

WEATHER CLOUDY

COUNTY WOOD

R.C. RHOADES

TEMP. 72°

TOWNSHIP FREEDOM

SECTION 9

T 5 N R 12 E

TYPE MONUMENT P.K./WASHER



ON SURFACE - ~~BELOW~~ ON

LEFT - Q PAV'T - RIGHT ON

9.7' TO RT EDGE PAVEMENT

S.L.M. 450+08

Grid: Northing: 634483.017 Easting: 1700941.411

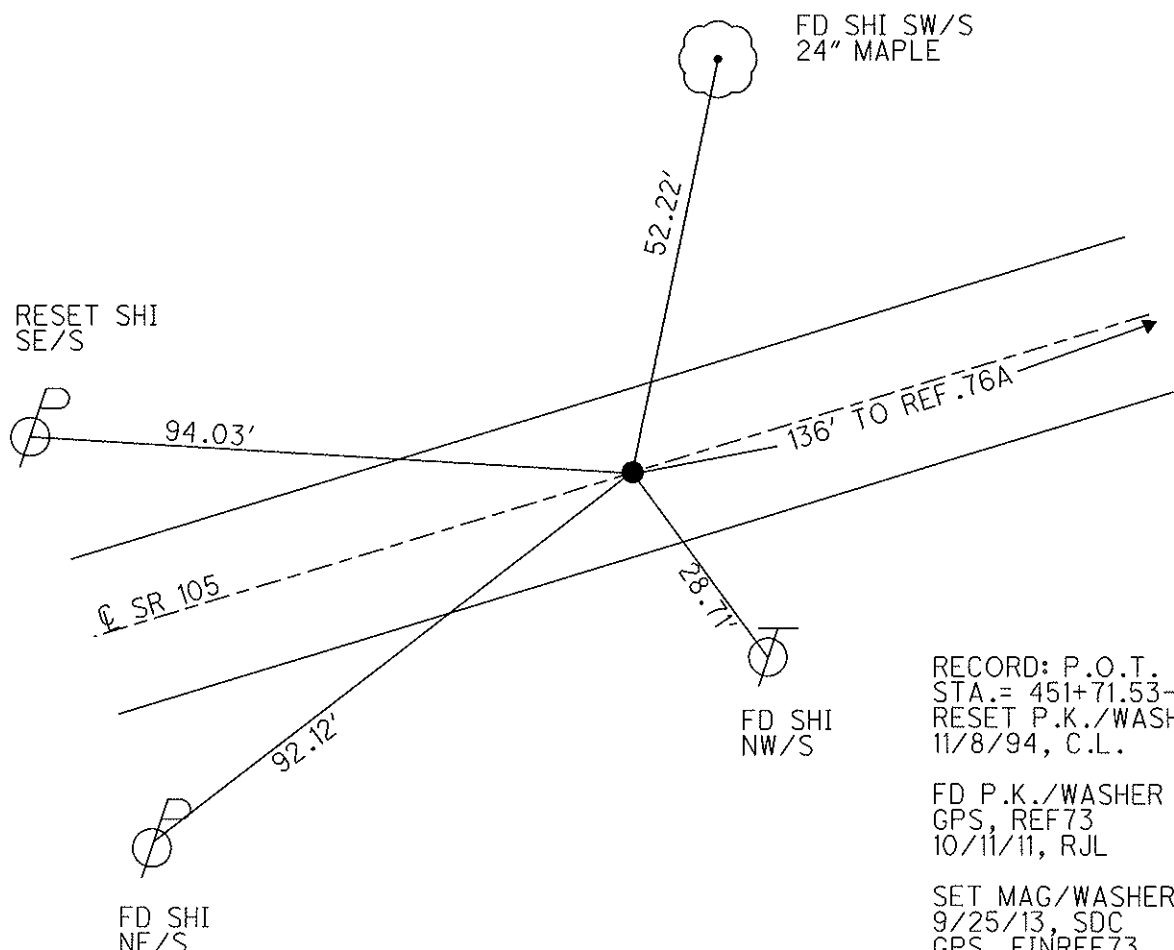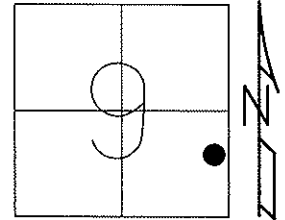

RECORD: P.O.T.
 STA.= 451+71.53-P.L.
 RESET P.K./WASHER
 11/8/94, C.L.

FD P.K./WASHER
 GPS, REF73
 10/11/11, RJL

SET MAG/WASHER
 9/25/13, SDC
 GPS, FINREF73
 10/3/13, SDC

O.D.O.T. DISTRICT 2 SURVEY OFFICE

PERSONNEL _____

REFERENCE NO. _____

SHEET 25 OF 49

NOTES CHANEY

H.C. RIPPLE

R.C. BARBOUR

DATE 8-4-94

WEATHER CLOUDY

TEMP. +80°

ROUTE S.R. 105

COUNTY WOOD

TOWNSHIP FREEDOM

SECTION 9

T. 5 N R. 12 E

Reset 11-8-94


TYPE MONUMENT BOTH PK/WASHER

ON SURFACE - BELOW YES

~~LEFT - & PAV'T. - RIGHT~~ YES ON &

TO EDGE PAVEMENT

S.L.M. PT "A" = 450+08 PT "B" = 451+44

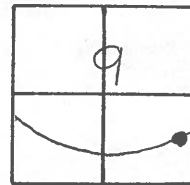

PT "A" - STA-450+08 73


9.7' TO RT. EP, 10.2' TO LT. EP

RECORD: P.O.T. STA 451+71.53 - P.L.

73A PT "B" - STA 451+44

9.4' TO RT. EP, 10.5' TO LT. EP

RECORD: P.O.T. STA 453+06.45 - P.L.

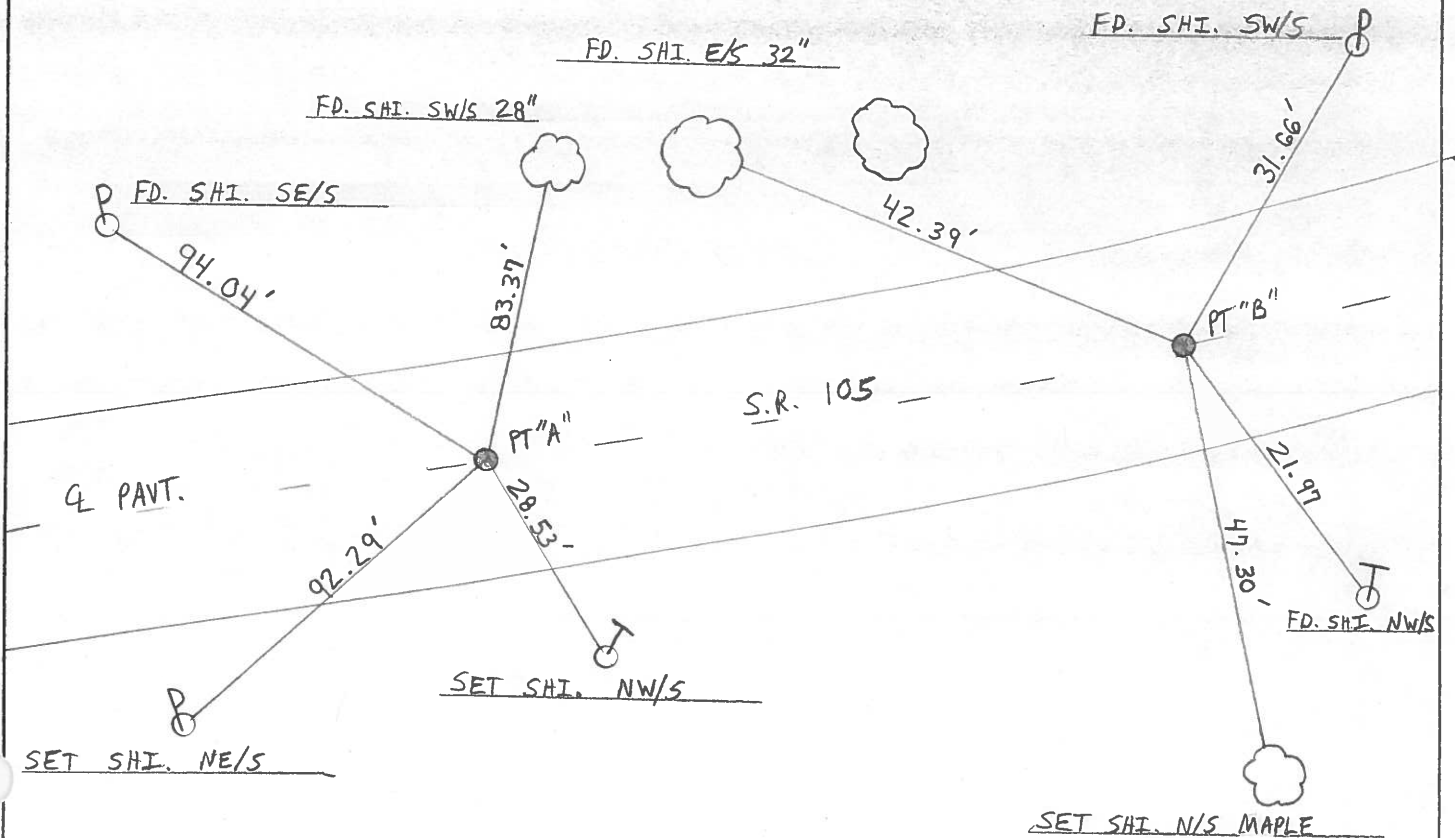

County Wood S.R. 105

Township Freedom

Section 9


TSN, R12E

Personnel	<u>BARWISZEL</u>	<u>HC</u>
	<u>HOUSEHOLDER</u>	<u>RC</u>
	<u>LOCHRIKE</u>	<u>□</u>
	<u>HOPMAN</u>	<u>P</u>

Date 8-8-84

Weather CLEARING


Temp. +85

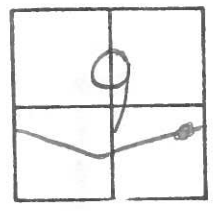

RECORDED
P.O.T.
451+71.53 - P/L
 $\Delta = 0^{\circ}-00'-00''$

SET P.K. & WASHER
FOR BOTH POINTS
10-3-84
C.L.

Fd: RR Spike @ SURFACE
9.0 REP
10.7 LEP
1.0 R of & PAVT
SLM 448+35

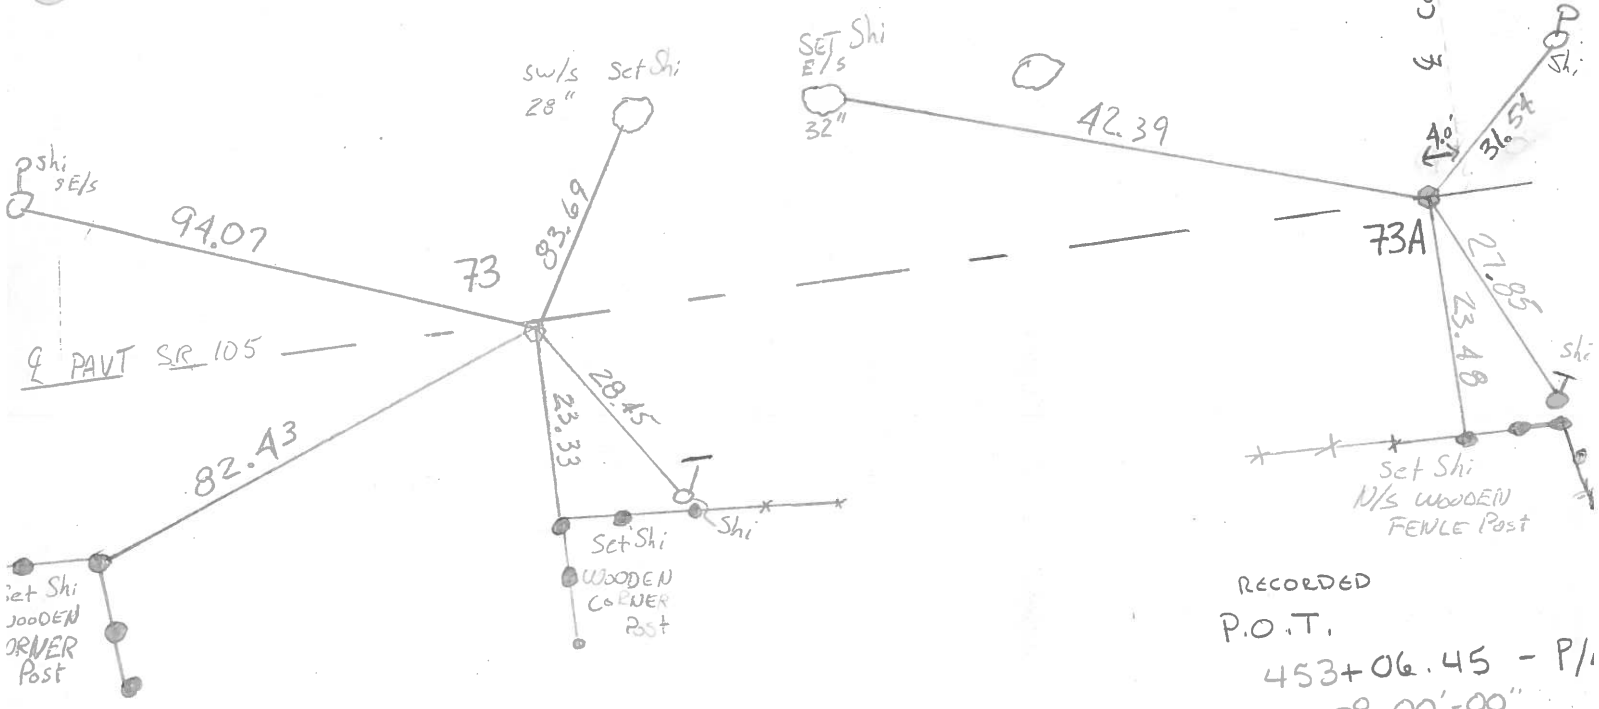

RECORDED
P.O.T.
453+06.45 - P/L
 $\Delta = 0^{\circ}-00'-00''$
Fd: RR Spike @ SURFACE
ON & PAVT
9.5 REP
10.0 LEP
SLM 449+70

PERSONNEL	TITLE	PERSONNEL	TITLE	COUNTY	DATE	WEATHER	TEMP.
Stone				Wood	31 Oct. 73	Cloudy	55°
Michalak				S. R. 105			
Drao				SEC. Freedom Twp.			
Curtis							

DESCRIPTION References to Control Points JOB NO. _____

LEFT CENTER LINE RIGHT

