


O.D.O.T. DISTRICT 2 SURVEY OFFICE (USE ONLY)

PERSONNEL	REFERENCE NO.	79 A	SHEET	8	OF	17
NOTES	LEU	DATE	04-25-16	ROUTE	SR 105	
H.C.	HOMAN	WEATHER	PARTLY CLDY	COUNTY	WOOD	
R.C.	LEU	TEMP.	52°F	TOWNSHIP	FREEDOM	
				SECTION	10	
				T	5	N
				R	12	E

TYPE MONUMENT MAG/WASHER  
 ON SURFACE - ~~BELOW~~ ON  
 LEFT - Q PAV'T - RIGHT ON  
- TO - EDGE PAVEMENT  
 S.L.M. 490+37

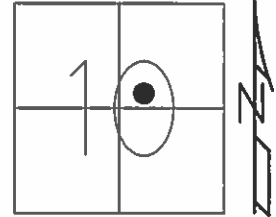


GRID: NORTHING: 636213.3985 EASTING: 1704561.957

RECORD:  
 STA 490+37  
 17.4 TO RT OF  
 EDGE OF PAVEMENT  
 $\Delta=0^{\circ}00'$

DIST.  
 79A-79B = 0.30'  
 79A-79C = 65.79'  
 79B-79C = 65.49'

SET PK/WASHER  
 11-14-94, MRC  
 SET MAG/WASHER  
 GPS, NEWREFA79  
 09-22-16, DCH

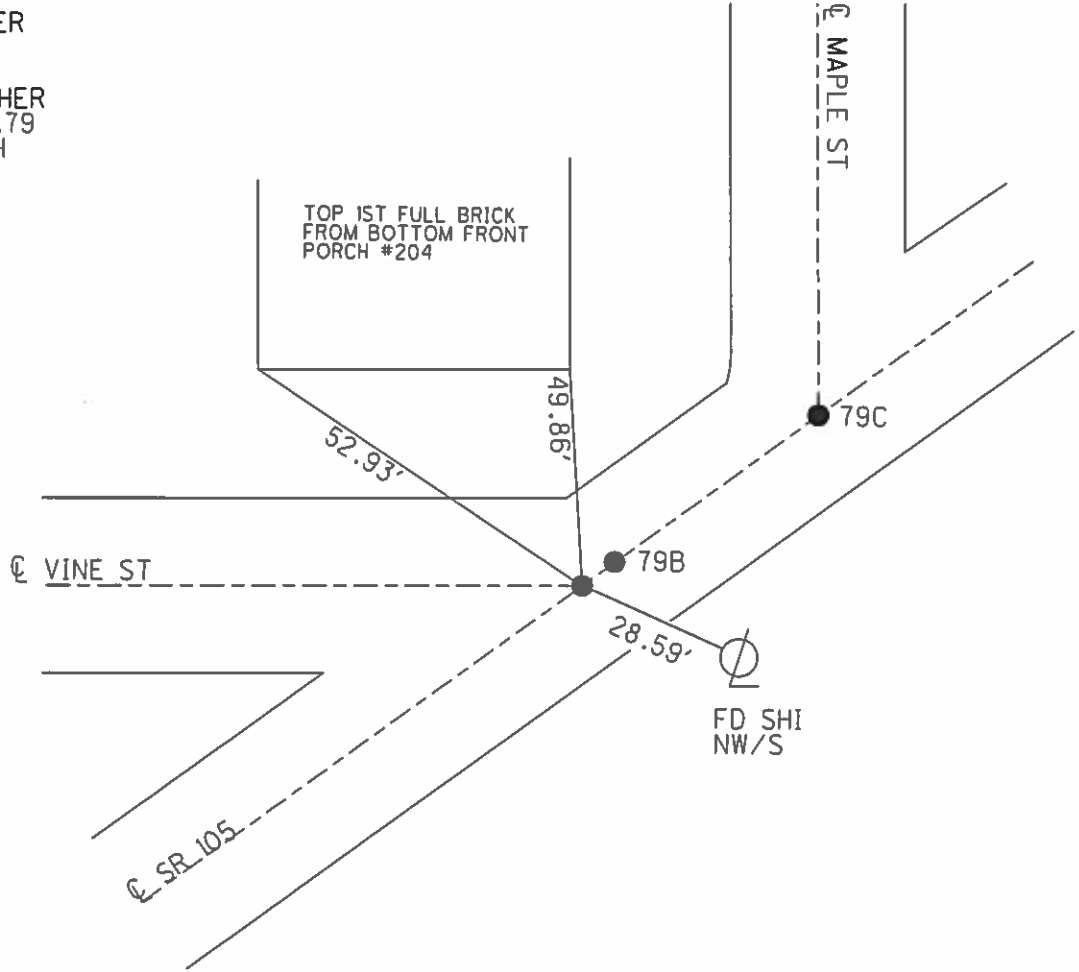

# O.D.O.T. DISTRICT 2 SURVEY OFFICE

PERSONNEL \_\_\_\_\_

REFERENCE NO. \_\_\_\_\_

SHEET 32 OF 49

NOTES CHANEY

H.C. RIPPLE

R.C. BARBOUR

DATE 8-5-94

WEATHER OVERCAST

TEMP. +80°

ROUTE S.R. 105

COUNTY WOOD

TOWNSHIP FREEDOM

SECTION 10

T 5 N R 12 E


TYPE MONUMENT PK/WASHER

ON SURFACE - BELOW YES

~~LEFT - & PAV'T. - RIGHT~~ YES ON & OF BOTH

TO EDGE PAVEMENT

S.L.M. 490 + 37

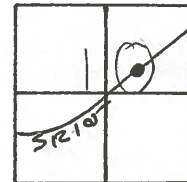

PT. "A" - STA 490 + 37

PT. "B" - STA 491 + 02.81

17.4 TO RT. EDGE OF PAVEMENT

17.3 TO RT. EDGE OF PAVEMENT

Δ 0° 00'


Δ 00° 00'

NOTE: 65.81 BETWEEN PT "A" and "B"

SET PK/WASHER  
BOTH POINTS  
11-14-94 MRC

A = 79A

B = 79C

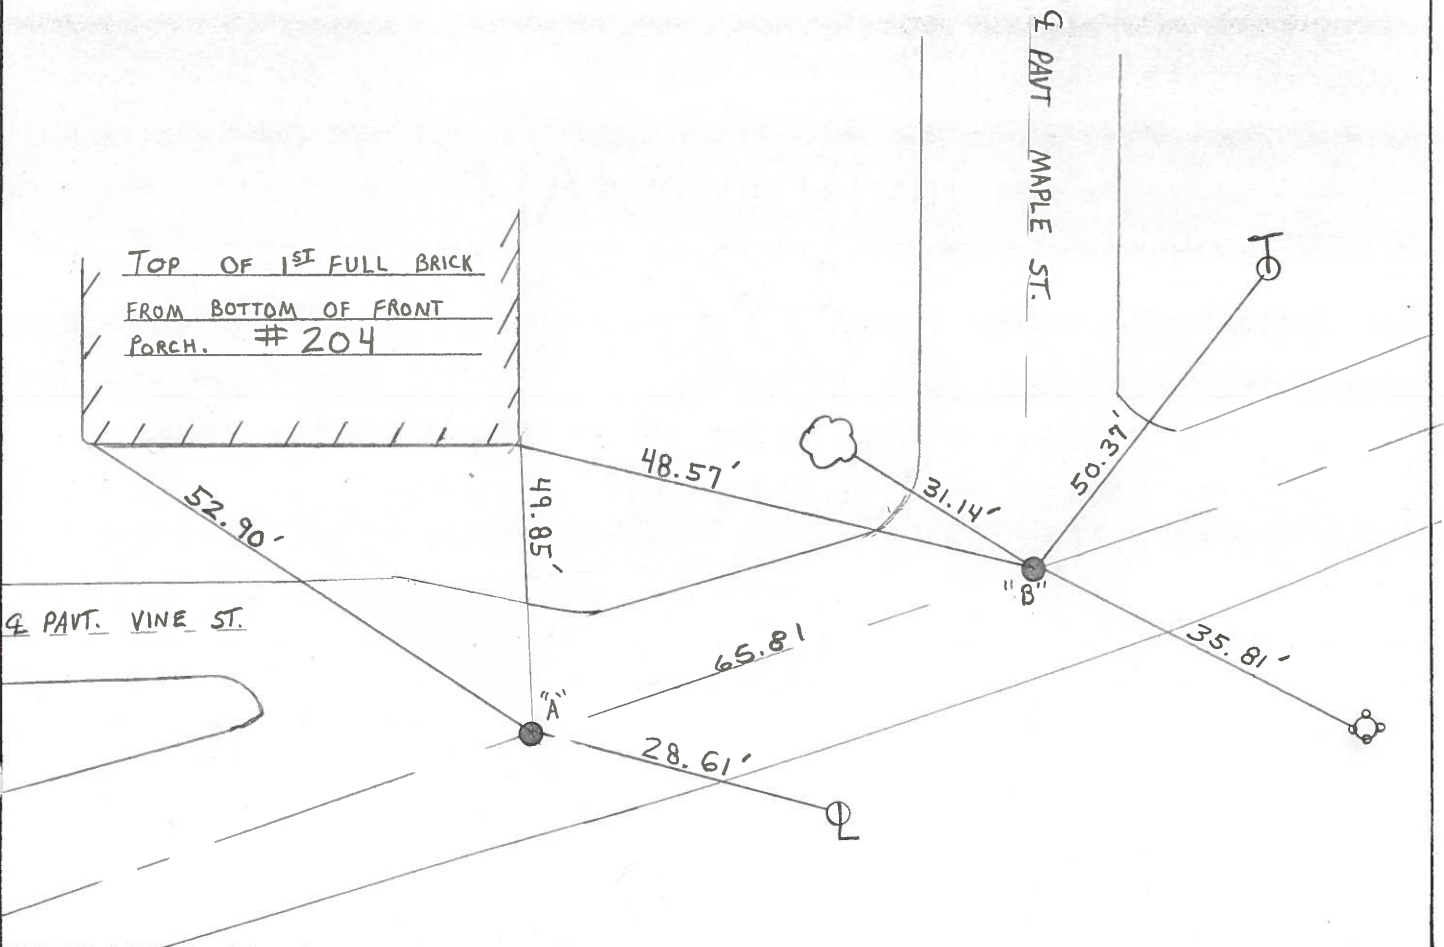

County WOOD S.R. 105

Township FREEDOM - PEMBERVILLE

Section 10

T5N, R12E

Personnel BARNHISEL HC

HOUSE HOLDER RC


LOHRKE TD

Hoffman F

Date 8-9-84

Weather PT CLOUDY

Temp. +84

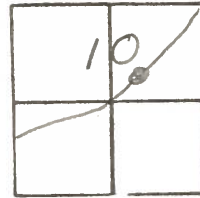

A = 79A

B = 79C

SET PK+WASHER

BOTH POINTS

10-3-84

C.L.

RECORDED

P.O.T.

491+98.60

$\Delta = 0^\circ - 00'$

A

Fd: PK @ SURFACE  
ON & BOTH PAUTS

17.4 REP

17.2 LEP

SLM 488+59

MAPLE ST.

Top of 1st FULL  
FROM BOTTOM

FRONT PORCH

# 204

Set Shi  
SE/Root

50.31  
Q PAUT SR 105

48.58

35.82

Cut "7"  
LOWER  
NW Bolt.

49.88

Shi 32" TREE

43.23

65.80

42.19

VINE ST

33.41

Shi

B

Fd: PK @ SURFACE

ON & BOTH PAUT

17.3 REP

17.4 LEP

SLM 489+25

RECORDED

P.O.T.

492+64.35

$\Delta = 0^\circ - 00'$

51.50

Shi N, NE

SIDE WALK

Shi 46" TREE


28" TREE

Q SR 105

PERSONNEL	TITLE	PERSONNEL	TITLE
Denno			
Michalak			
Curtis			


COUNTY Wood DATE Mar. 20, '74  
 S. R. 105 WEATHER Mild  
 SEC. \_\_\_\_\_ TEMP. 34°

DESCRIPTION Alignment LEFT CENTER LINE RIGHT JOB NO. \_\_\_\_\_

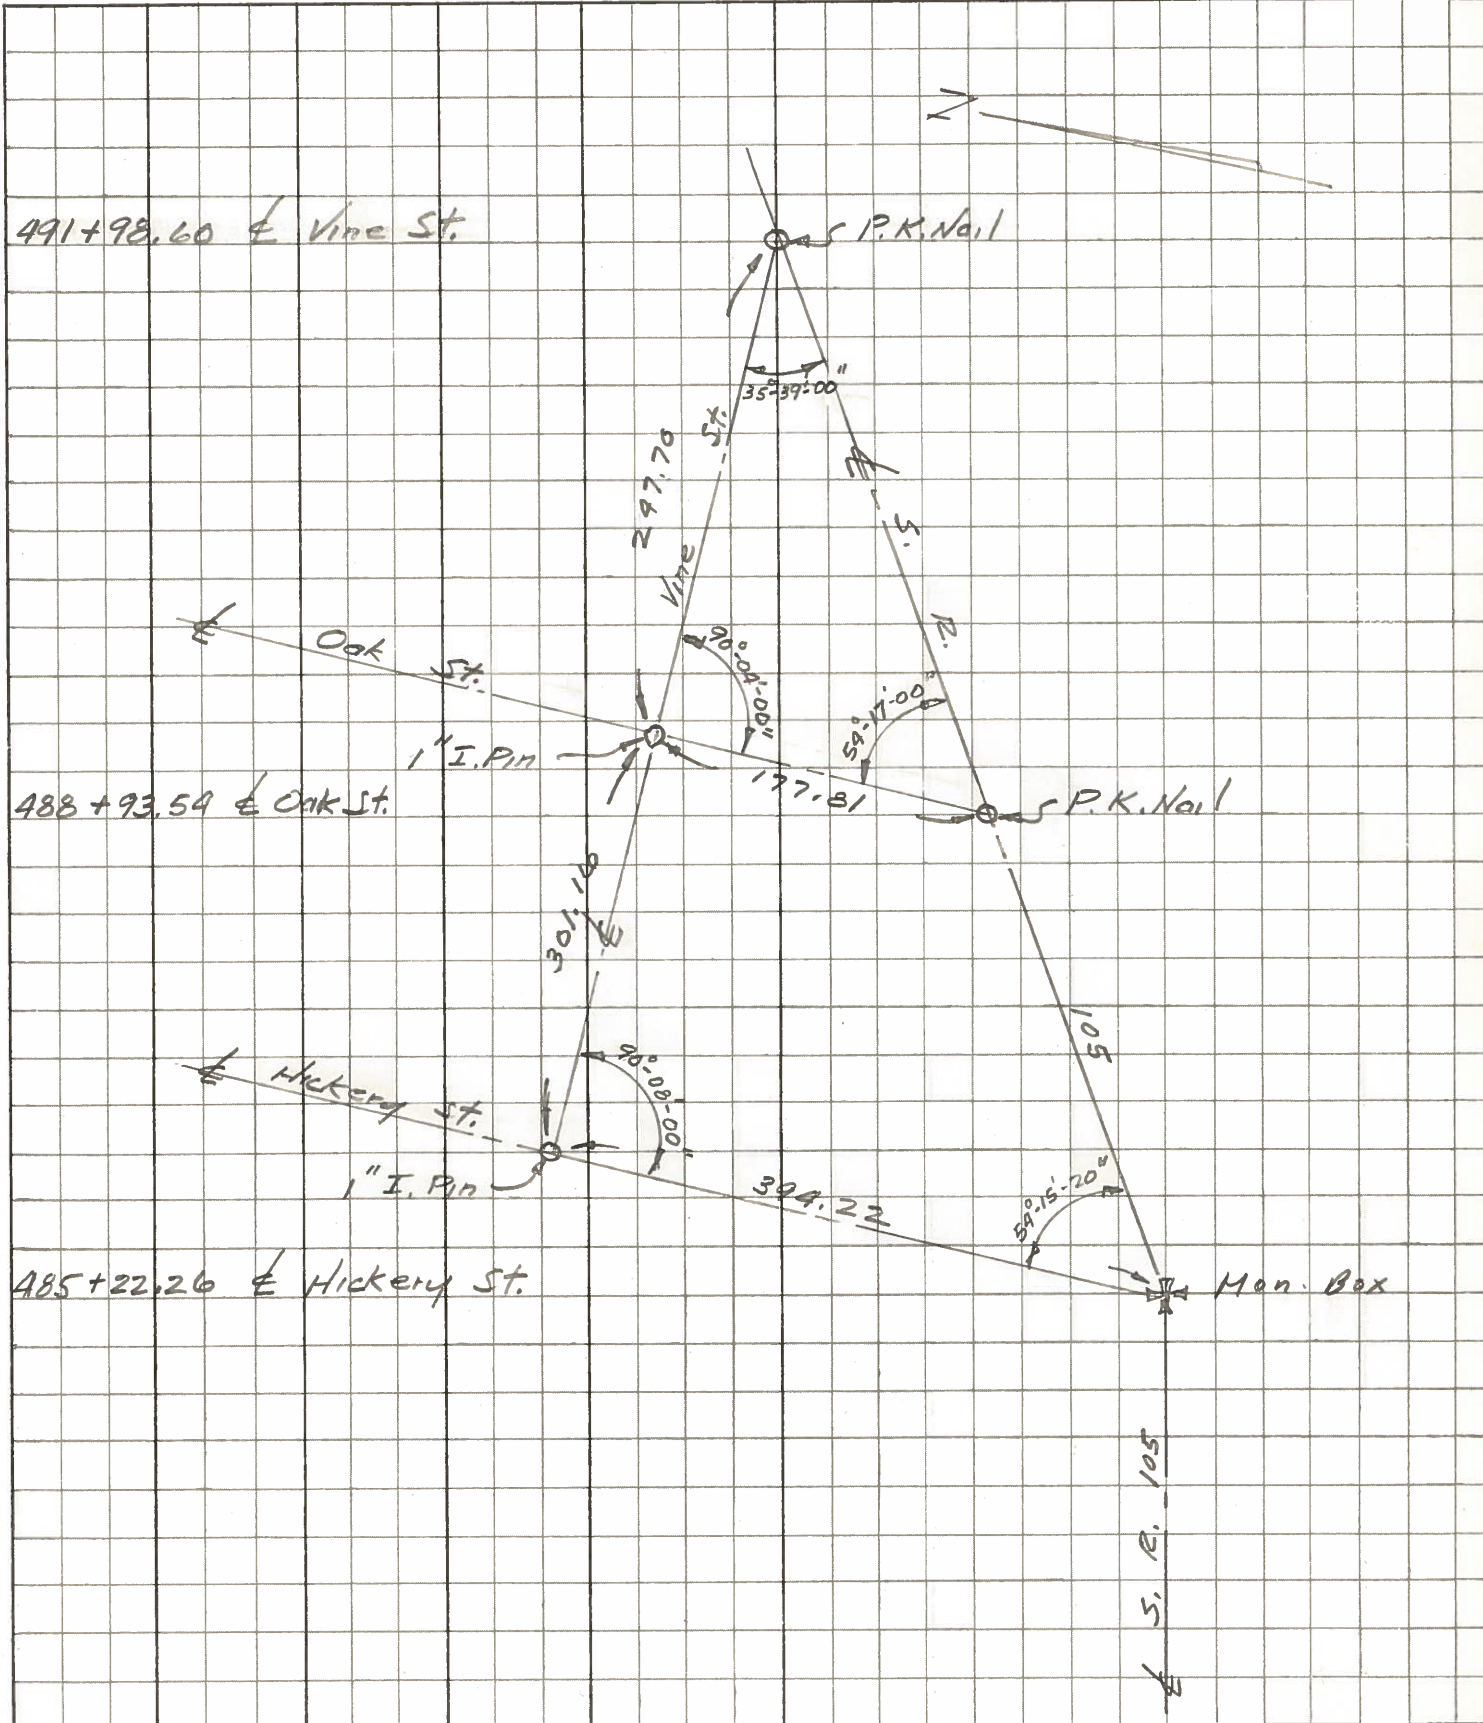

PERSONNEL	TITLE	PERSONNEL	TITLE	COUNTY	DATE	WEATHER	TEMP.
Stone				Wood	1 Nov. 73	Cool	44°
Michalak				S. R. 105			
Deung				SEC. Pomeroyville			
Curtis							

DESCRIPTION References to Control Points JOB NO. \_\_\_\_\_

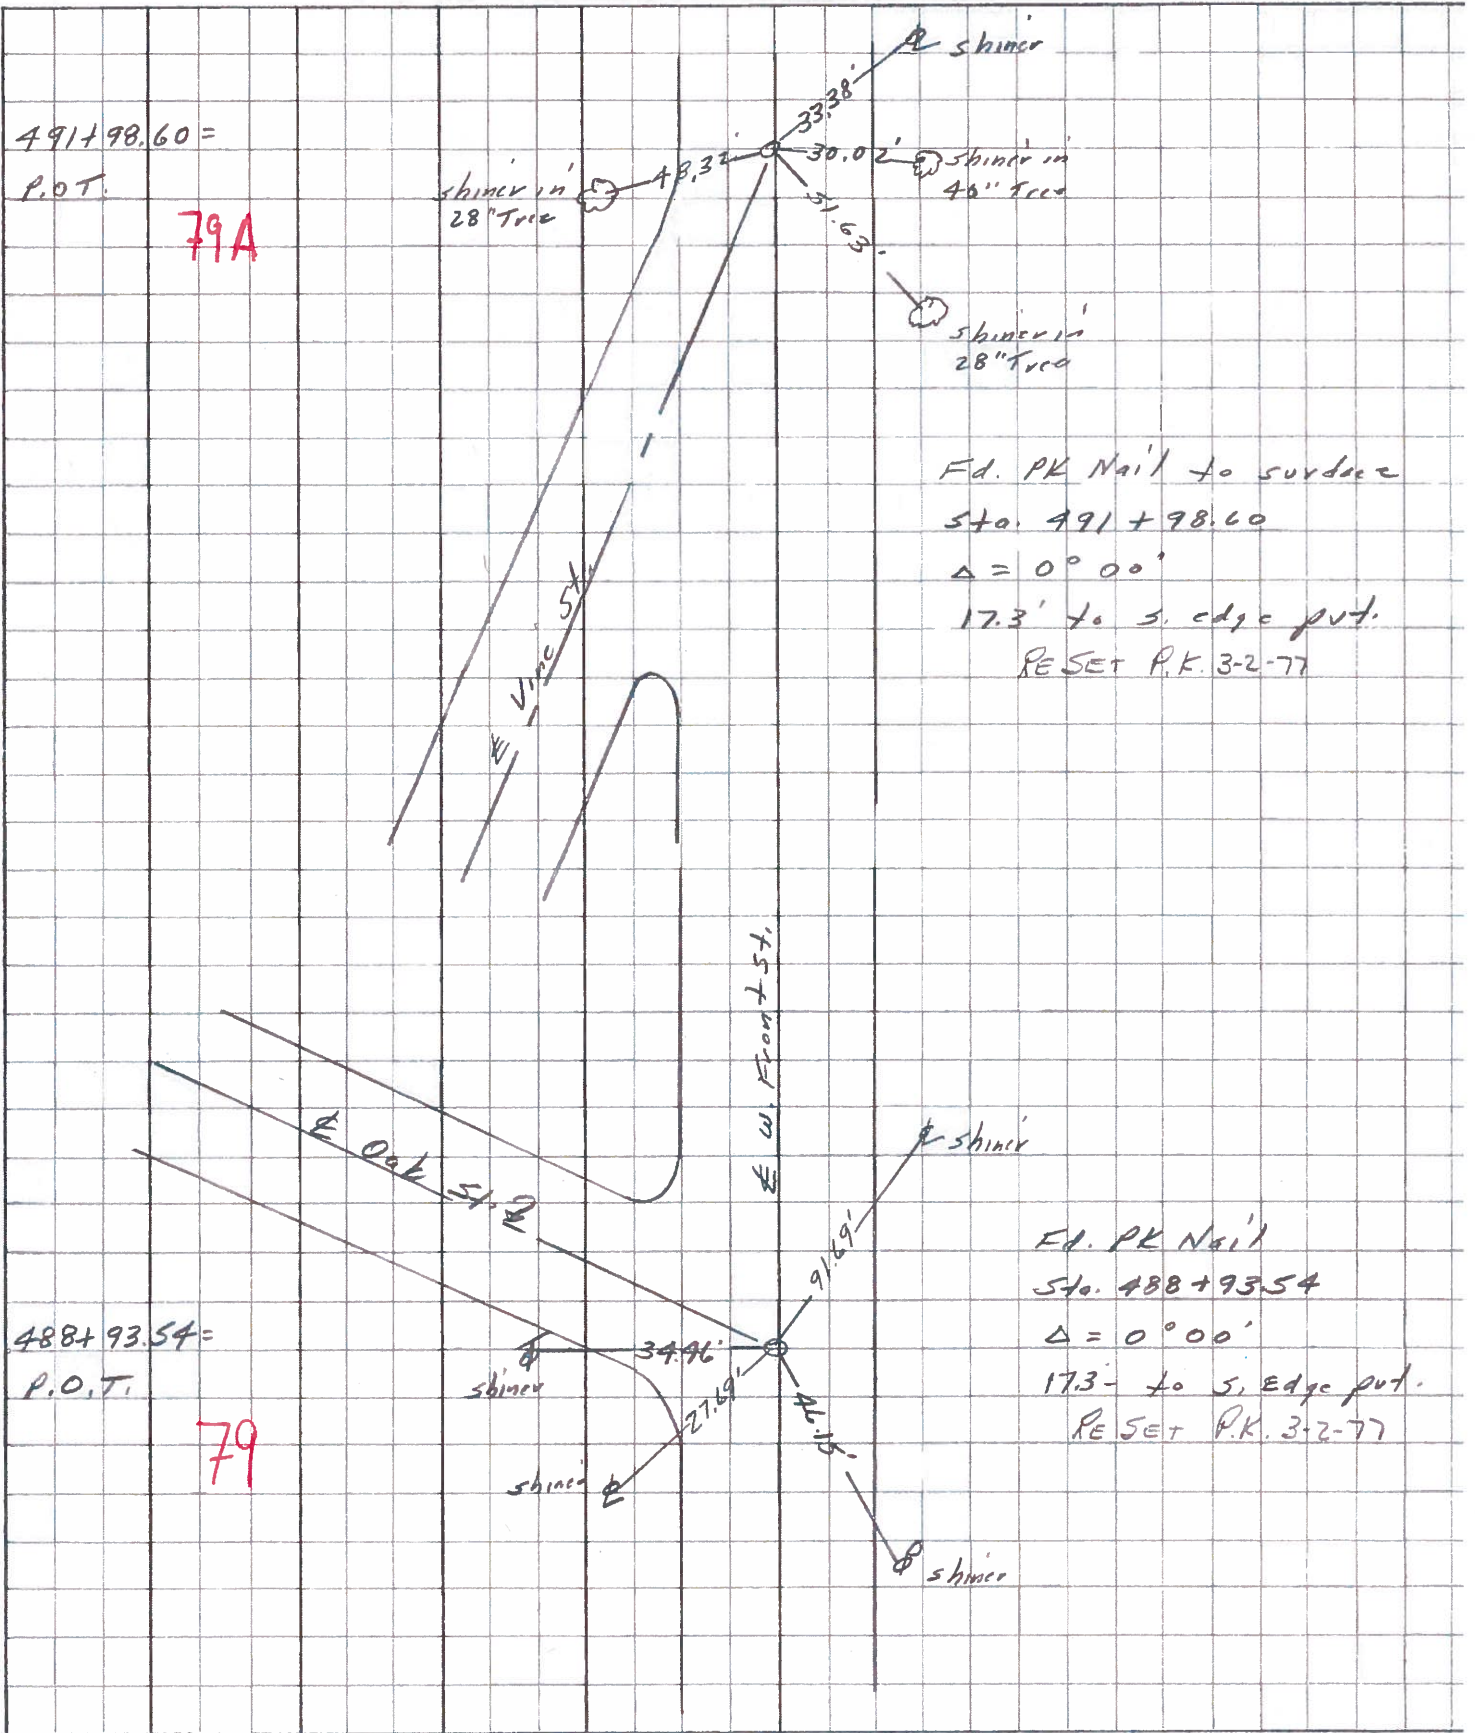


PERSONNEL TITLE PERSONNEL TITLE

COUNTY Wood DATE OK-9-15-70

S. R. #105 WEATHER \_\_\_\_\_

SEC. PEMBERVILLE TEMP. \_\_\_\_\_

DESCRIPTION LEFT CENTER LINE RIGHT JOB NO.

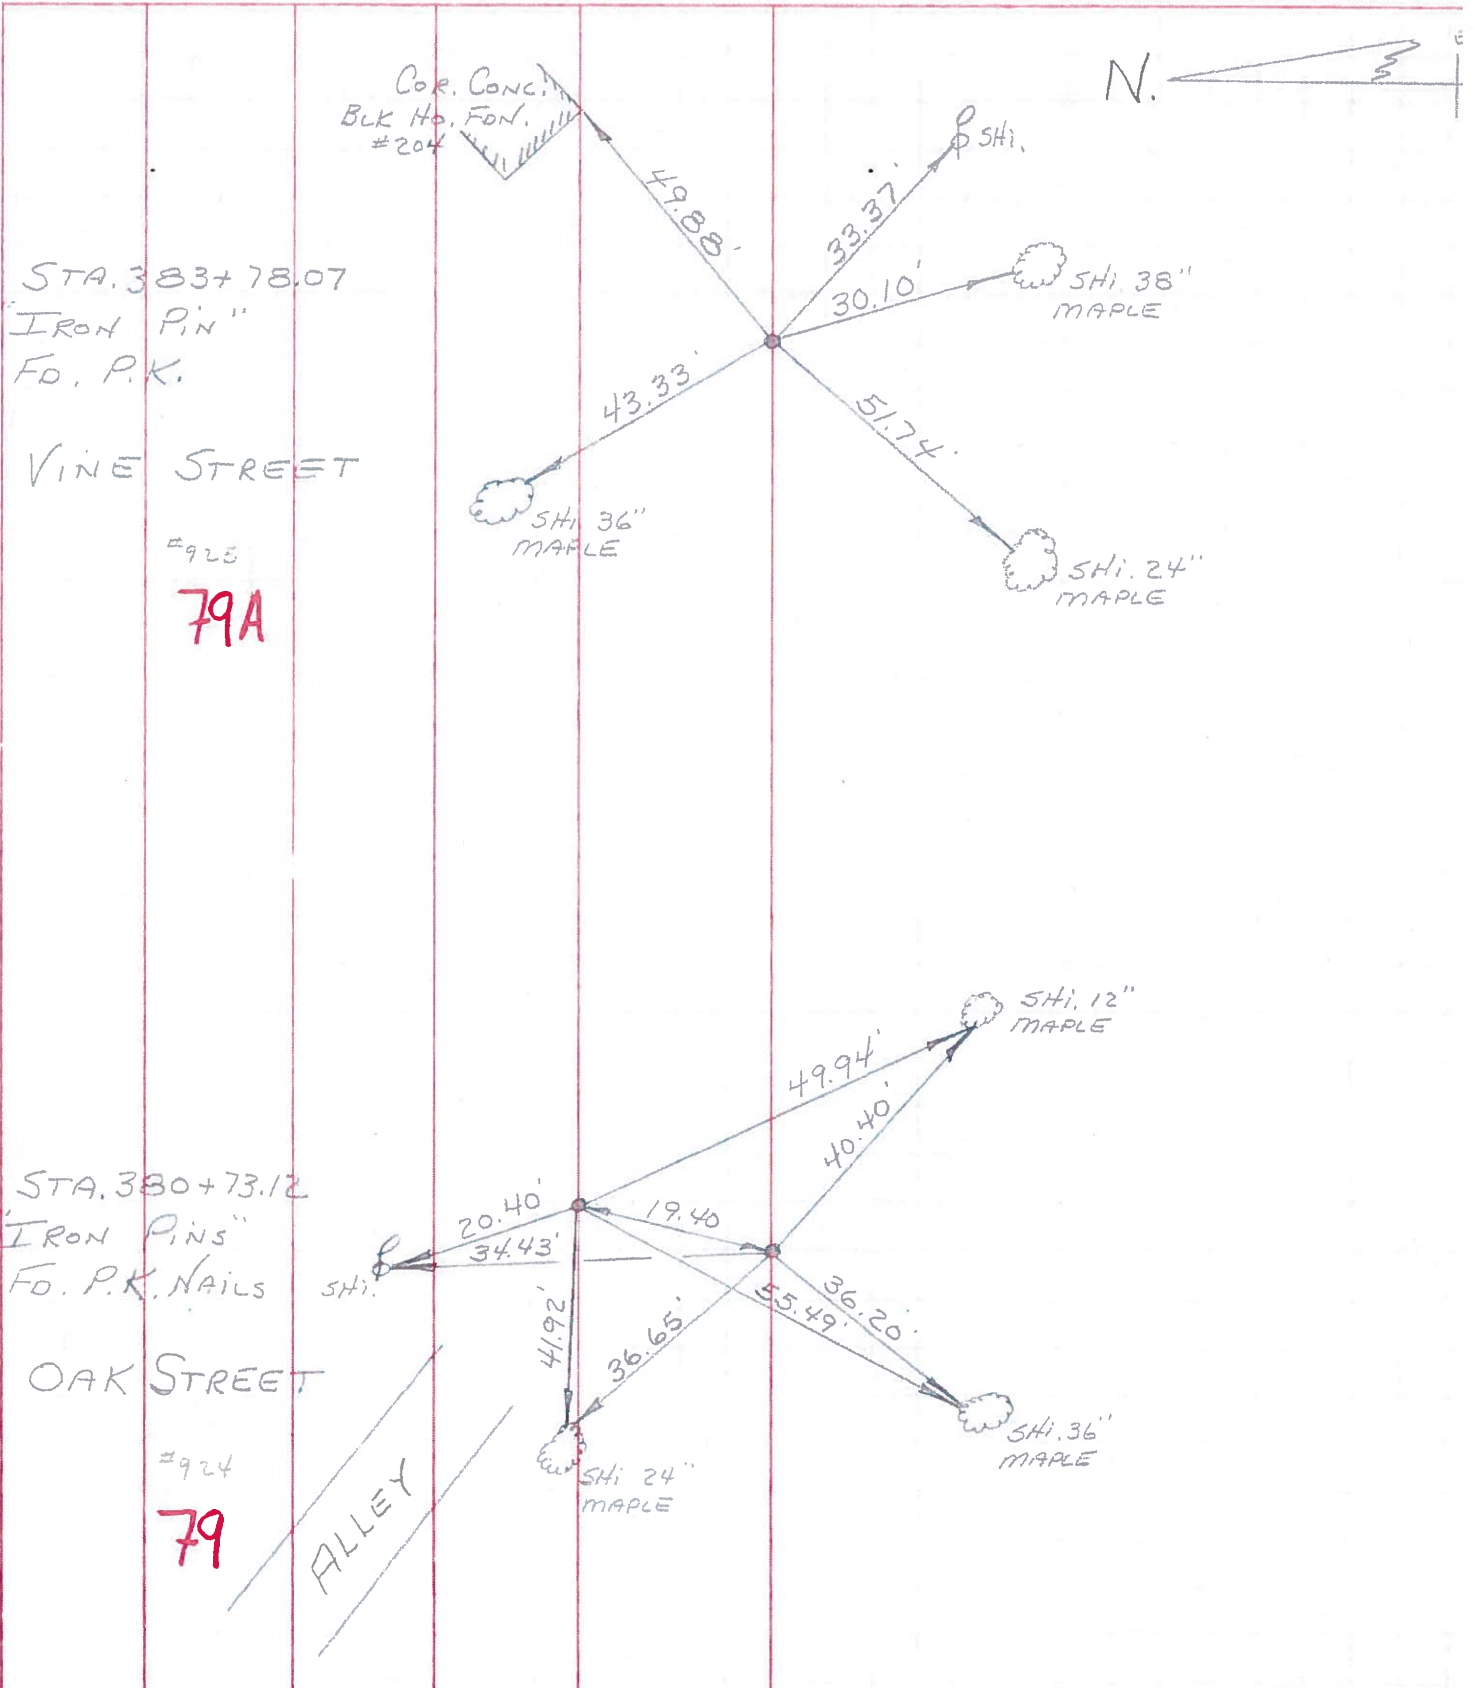

PERSONNEL	TITLE	PERSONNEL	TITLE

COUNTY Wood DATE OK 12-24-57  
OK 9-15-70

S. R. #105 WEATHER \_\_\_\_\_

SEC. Pemberville TEMP. \_\_\_\_\_

DESCRIPTION \_\_\_\_\_ LEFT \_\_\_\_\_ CENTER LINE \_\_\_\_\_ RIGHT \_\_\_\_\_ JOB NO. \_\_\_\_\_

