


O.D.O.T. DISTRICT 2 SURVEY OFFICE (USE ONLY)

PERSONNEL _____ REFERENCE NO. 79 C SHEET 10 OF 17
 NOTES LEU DATE 4-25-16 ROUTE SR 105
 H.C. HOMAN WEATHER PARTLY CLDY COUNTY WOOD
 R.C. LEU TEMP. 52°F TOWNSHIP FREEDOM
 _____ SECTION 10
 _____ T 5 N R 12 E

TYPE MONUMENT PK/WASHER
 ON SURFACE - ~~BELOW~~ ON
 LEFT - Q PAV'T - RIGHT ON
- TO - EDGE PAVEMENT
 S.L.M. 490+37

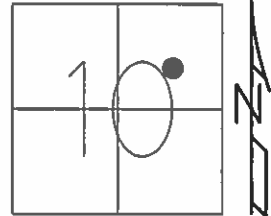


GRID: NORTHING: 636250.5187 EASTING: 1704616.241

RECORD:
 STA 491+02.81
 17.3 TO RT OF
 EDGE OF PAVEMENT
 $\Delta=0^{\circ}00'$

DIST.
 79A-79B = 0.30'
 79A-79C = 65.79'
 79B-79C = 65.49'

SET PK/WASHER
 11-14-94, MRC

SET MAG/WASHER
 GPS, NEWREFA79
 09-22-16, DCH

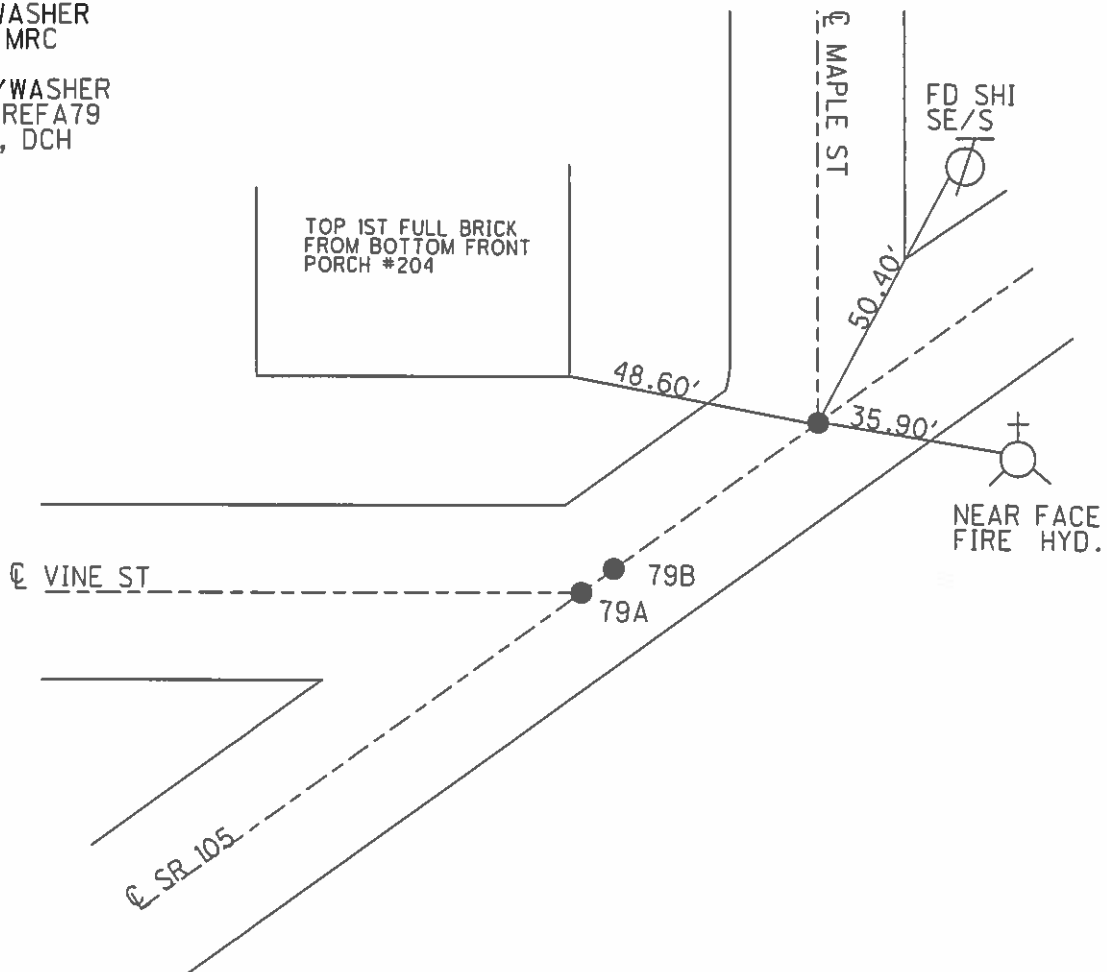

O.D.O.T. DISTRICT 2 SURVEY OFFICE

PERSONNEL _____

REFERENCE NO. _____

SHEET 32 OF 49

NOTES CHANEY

H.C. RIPPLE

R.C. BARBOUR

DATE 8-5-94

WEATHER OVERCAST

TEMP. +80°

ROUTE S.R. 105

COUNTY WOOD

TOWNSHIP FREEDOM

SECTION 10

T 5 N R 12 E


TYPE MONUMENT PK/WASHER

ON SURFACE - BELOW YES

~~LEFT - & PAV'T. - RIGHT~~ YES ON & OF BOTH

TO EDGE PAVEMENT

S.L.M. 490 + 37

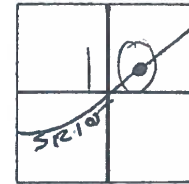

PT. "A" - STA 490 + 37

17.4 TO RT. EDGE OF PAVEMENT

Δ 0° 00'

PT. "B" - STA 491 + 02.81

17.3 TO RT. EDGE OF PAVEMENT


Δ 00° 00'

NOTE: 65.81 BETWEEN PT "A" and "B"

SET PK/WASHER
BOTH POINTS
11-14-94 MRC

A = 79A


B = 79C

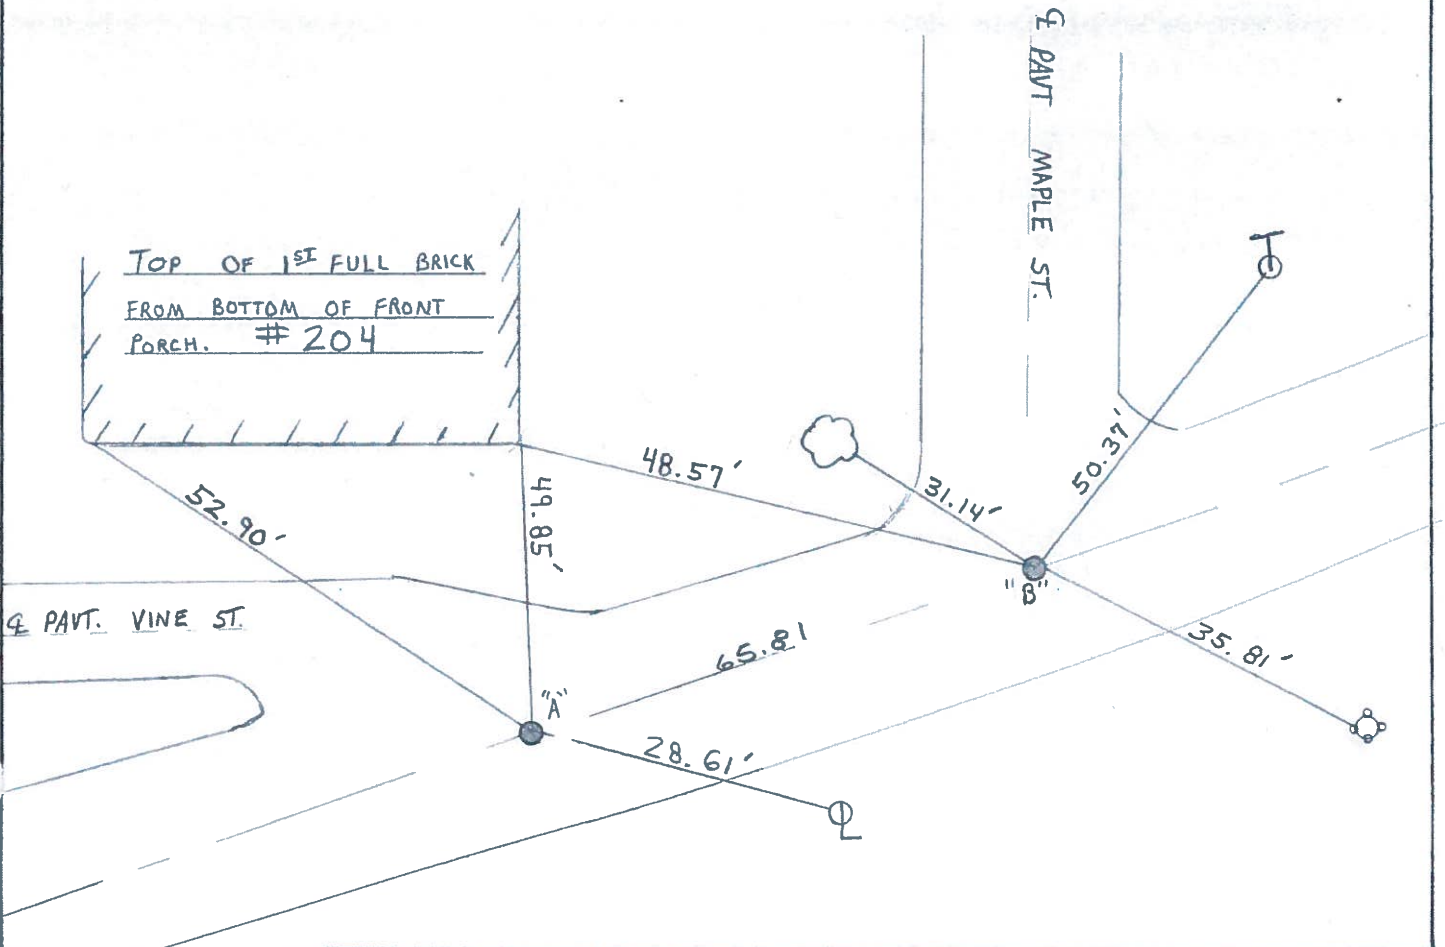

County WOOD S.R. 105
 Township FREEDOM - PEMBERVILLE
 Section 10
 T5N, R12E

Date 8-9-84
 Weather Pt CLOUDY
 Temp. +84


Personnel	BARNHISEL	HC
	HOUSE HOLDER	R
	LOHRKE	□
	HOTTMAN	P

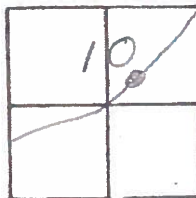

RECORDED
 P.O.T.
 491+98.60
A Δ = 0°-00'
 Fd: PK @ SURFACE
 ON & BOTH PAVTS
 7.4 REP
 7.2 LEP
 SLM 488+59

A = 79A
B = 79C

SET PK + WASHER
 BOTH POINTS
 10-3-84
 C.L.

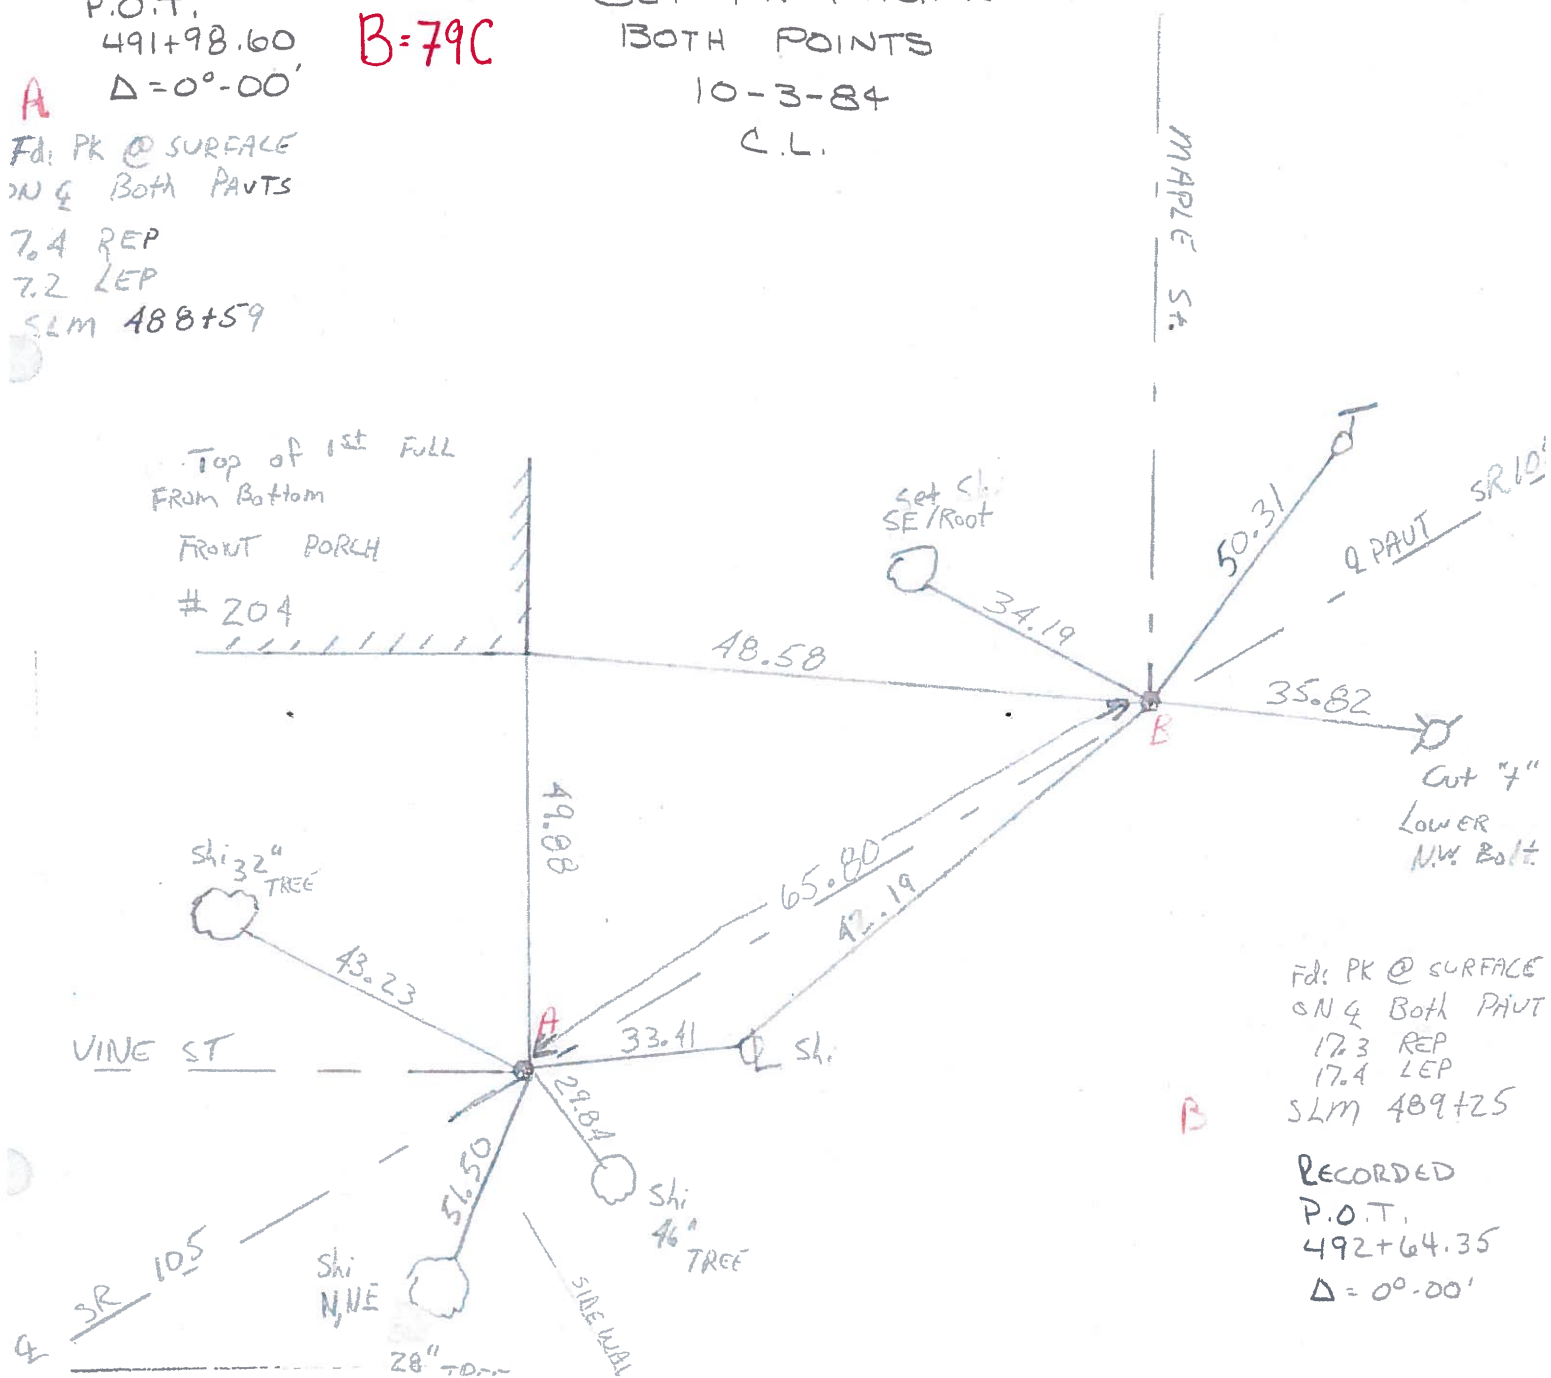


Fd: PK @ SURFACE
 ON & BOTH PAVT
 17.3 REP
 17.4 LEP
 SLM 489+25

RECORDED
 P.O.T.
 492+64.35
 Δ = 0°-00'

PERSONNEL	TITLE	PERSONNEL	TITLE	COUNTY	DATE	WEATHER	TEMP.
Stone				Wood	1 Nov. 73	Cool	44°
Michalak				S. R. 105			
Danae				SEC. Pemberville			
Curtis							

DESCRIPTION References to Control Points JOB NO. _____

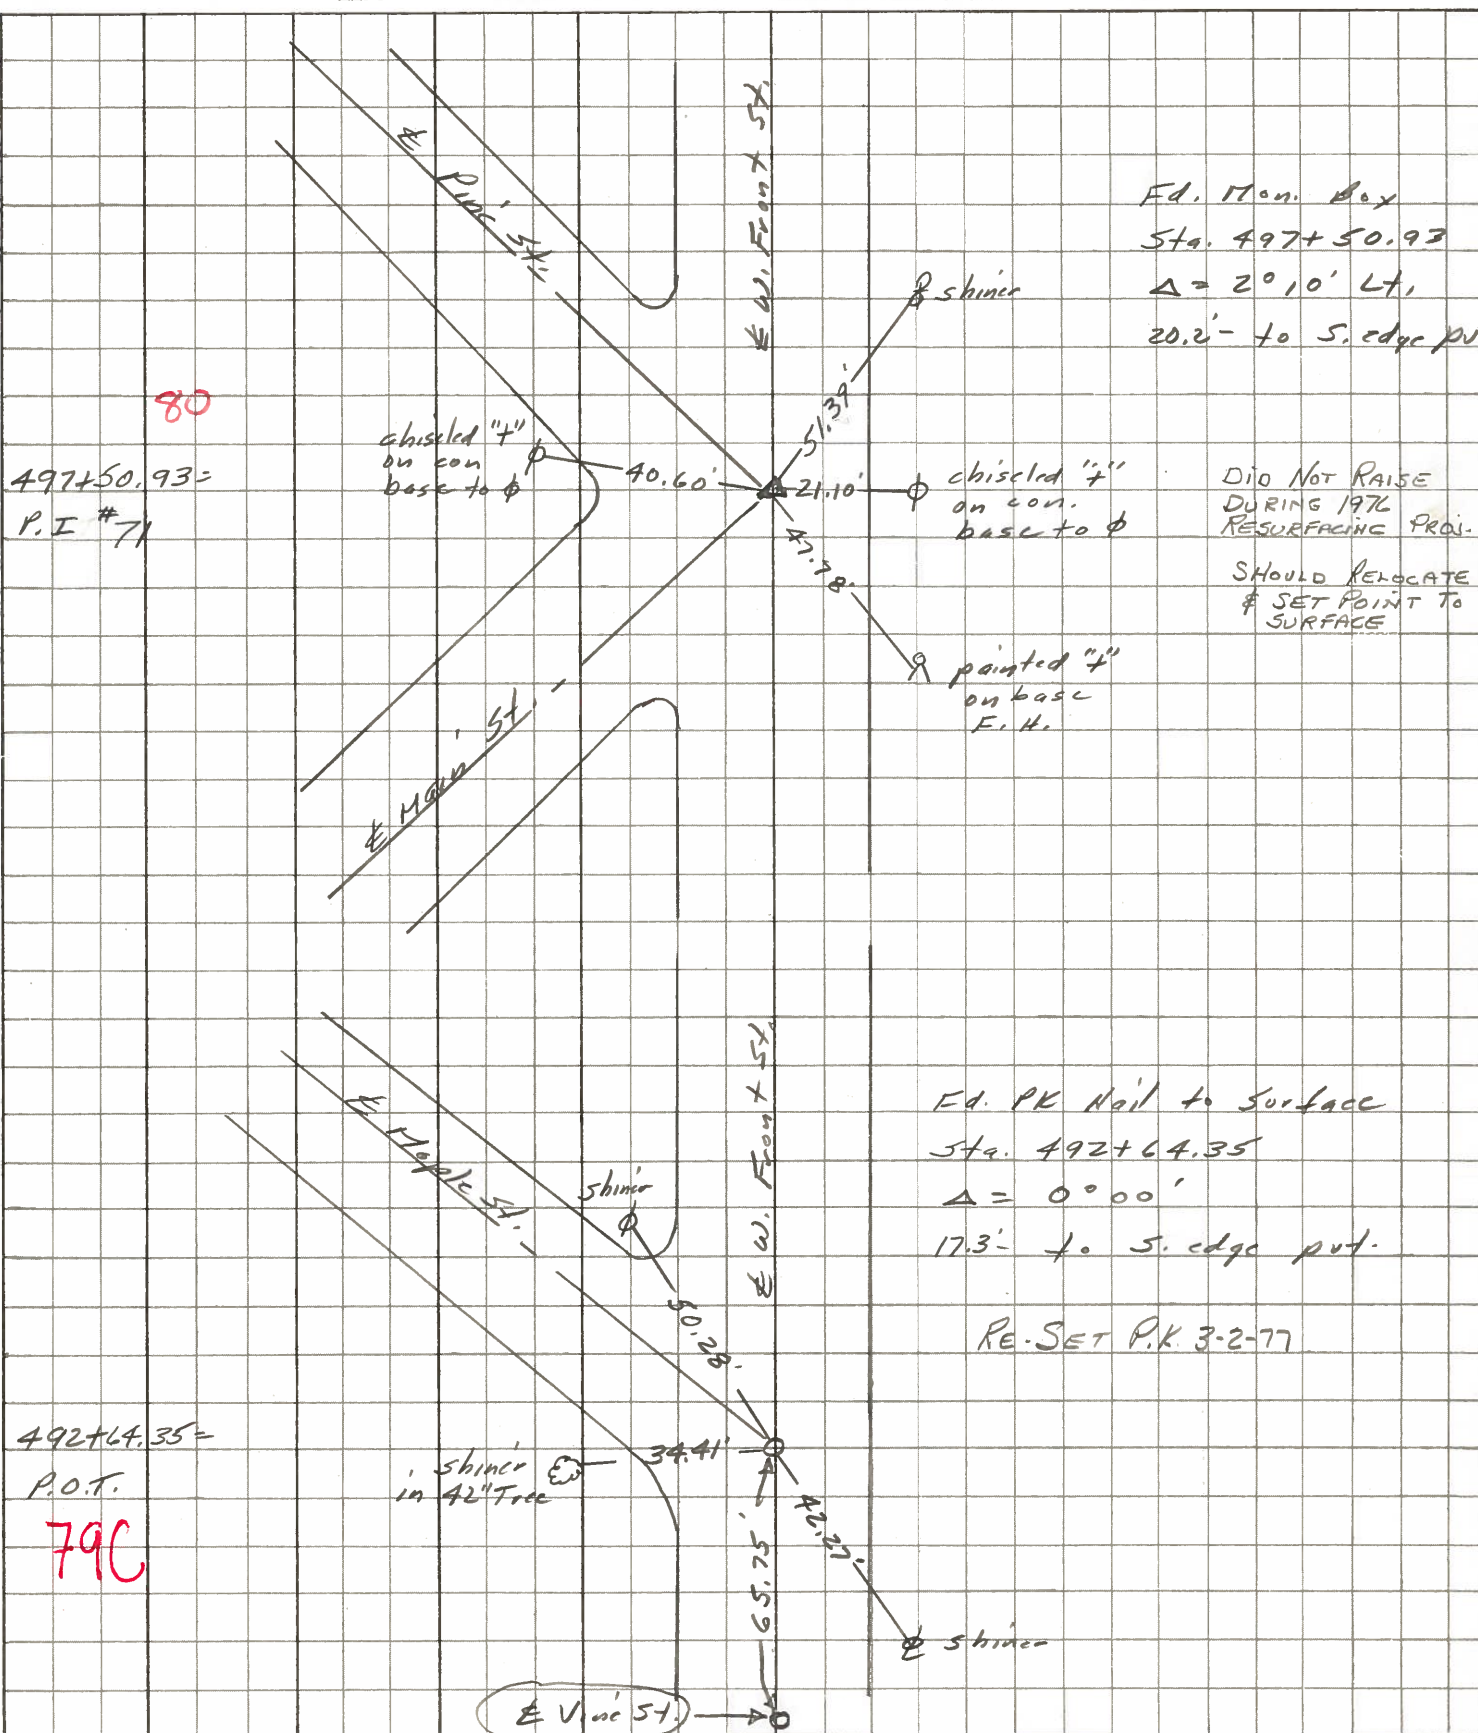

Ed. Mon. Box
Sta. 497+50.93
 $\Delta = 2^{\circ} 10' \text{ Lt.}$
20.2' to S. edge put

DID NOT RAISE
DURING 1976
RESURFACING PROJ.

SHOULD RELOCATE
& SET POINT TO
SURFACE

Ed. PK Nail to Surface
Sta. 492+64.35
 $\Delta = 0^{\circ} 00'$
17.3' to S. edge put.

RE-SET P.K. 3-2-77

80
497+50.93=
P.I. #71

492+64.35=
P.O.T.
79C


PERSONNEL TITLE PERSONNEL TITLE

COUNTY Wood DATE OK-9-16-70

S. R. #105 WEATHER

SEC. PEMBERVILLE TEMP.

DESCRIPTION LEFT CENTER LINE RIGHT JOB NO.

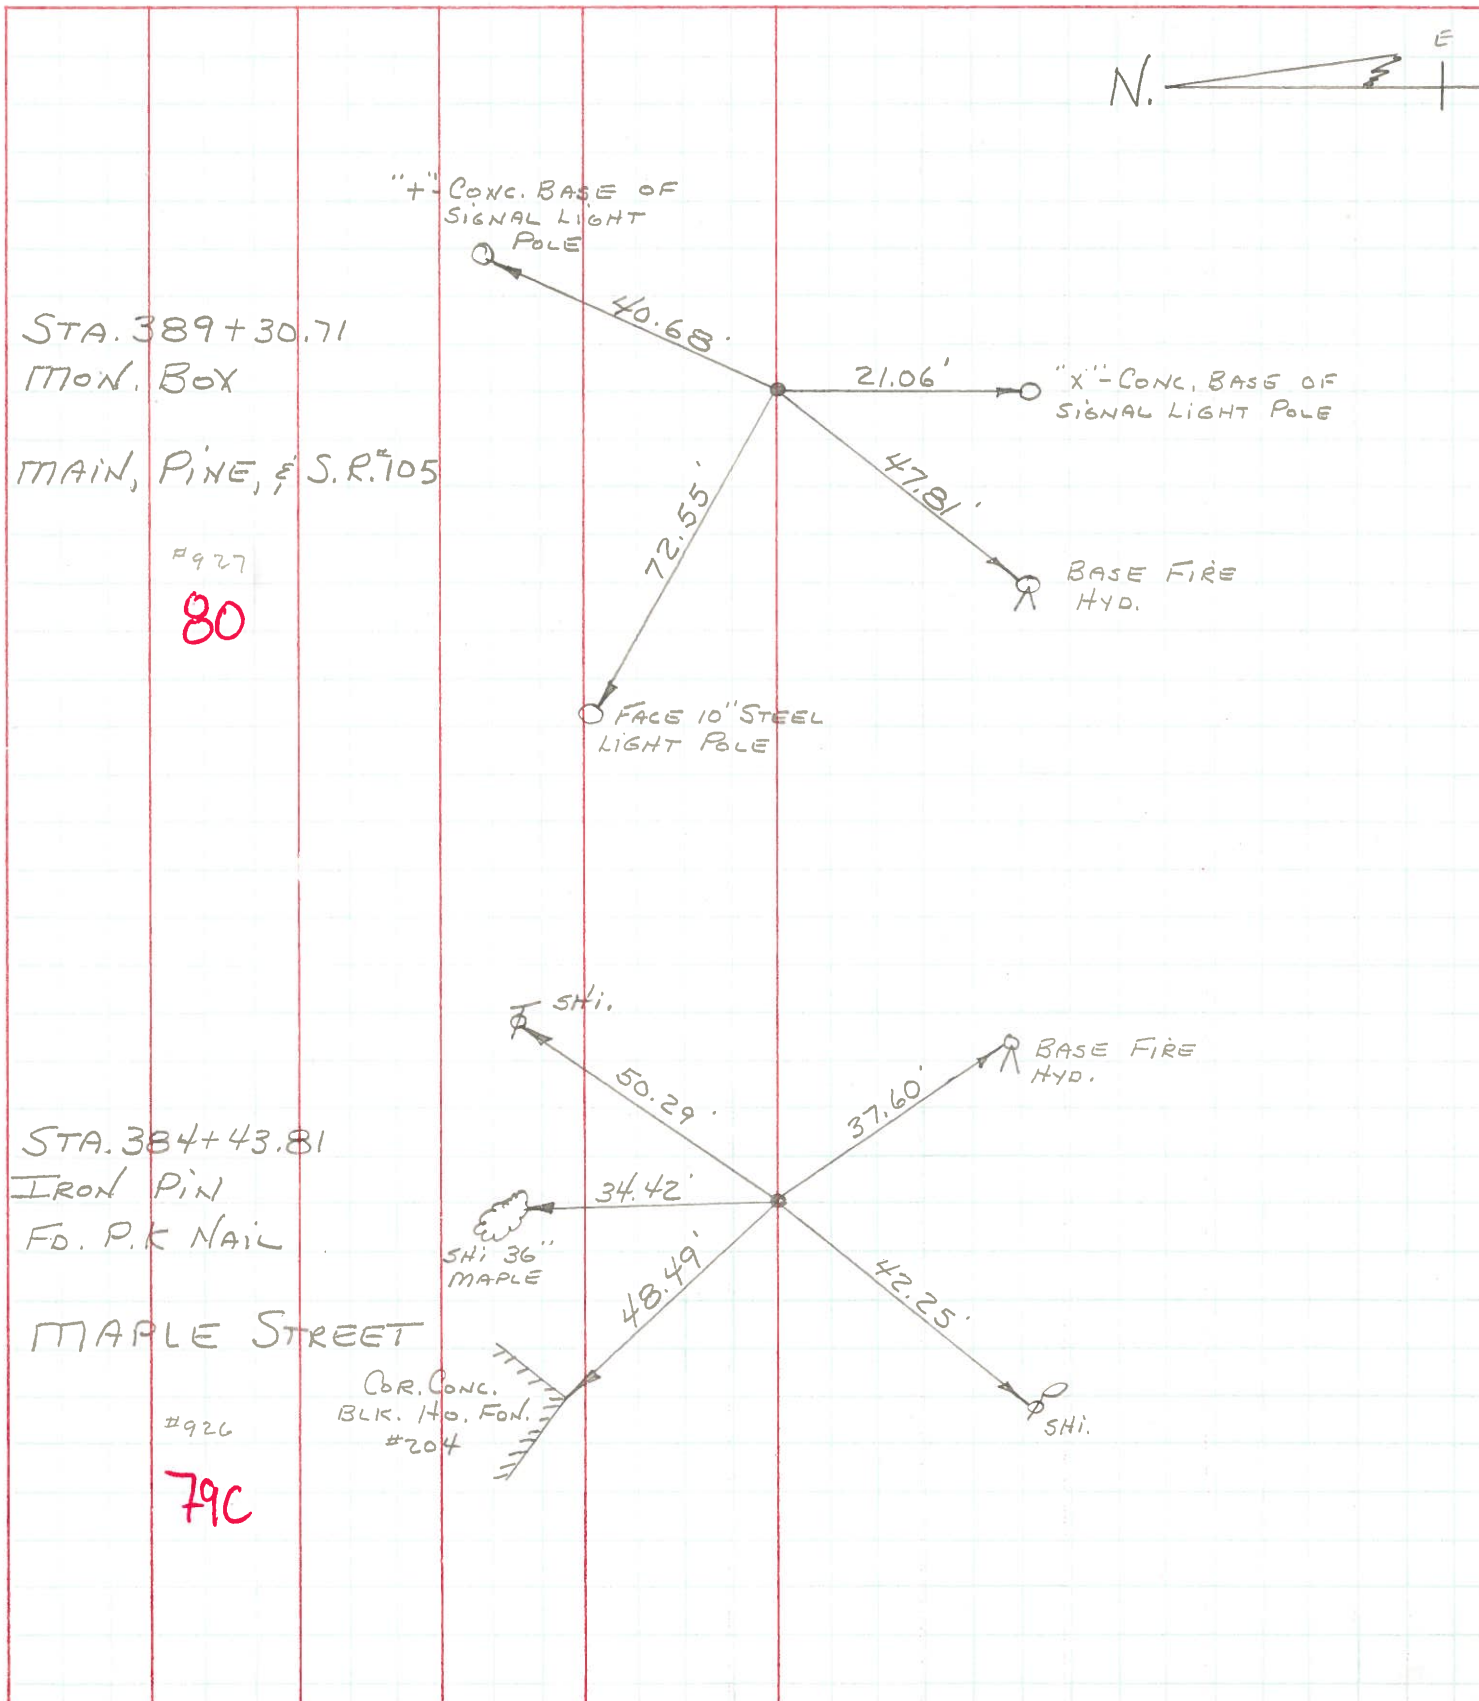

STA. 389+30.71
MON. BOX

MAIN, PINE, & S.R. #105

#927

80

STA. 384+43.81
IRON PIN
FD. P.K NAIL

MAPLE STREET

#926

79C

C&R CONC.
BLK. HO. FON.
#204

PERSONNEL TITLE PERSONNEL TITLE

COUNTY Wood

DATE OK 12-24-57
OK 9-16-70 RB

S. R. #105

WEATHER

SEC.

TEMP.

DESCRIPTION

LEFT

CENTER LINE

RIGHT

JOB NO.

