


O.D.O.T. DISTRICT 2 SURVEY OFFICE (USE ONLY)

PERSONNEL	REFERENCE NO.	80 A	SHEET	12	OF	17
NOTES	LEU	DATE	04-25-16	ROUTE	SR 105	
H.C.	HOMAN	WEATHER	PARTLY CLDY	COUNTY	WOOD	
R.C.	LEU	TEMP.	52°F	TOWNSHIP	FREEDOM	
				SECTION	10	
				T	5	N
				R	12	E

TYPE MONUMENT PK/WASHER
 ON SURFACE - ~~BELOW~~ ON
~~LEFT~~ - Q PAV'T - RIGHT 5.0'
20.3' TORT EDGE PAVEMENT
 S.L.M. 499+38

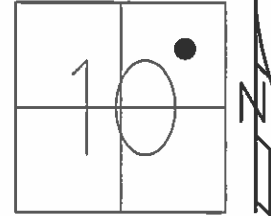


GRID: NORTHING: 636734.1195 EASTING: 1705296.173

RECORD:
 POT STA 500+98.99
 $\Delta=0^{\circ}00'00''$

SET PK/WASHER
 11-14-94, MRC

FD PK/WASHER
 GPS, REFA80
 04-25-16

SET MAG/WASHER
 GPS, NEWREFA80
 09-22-2016

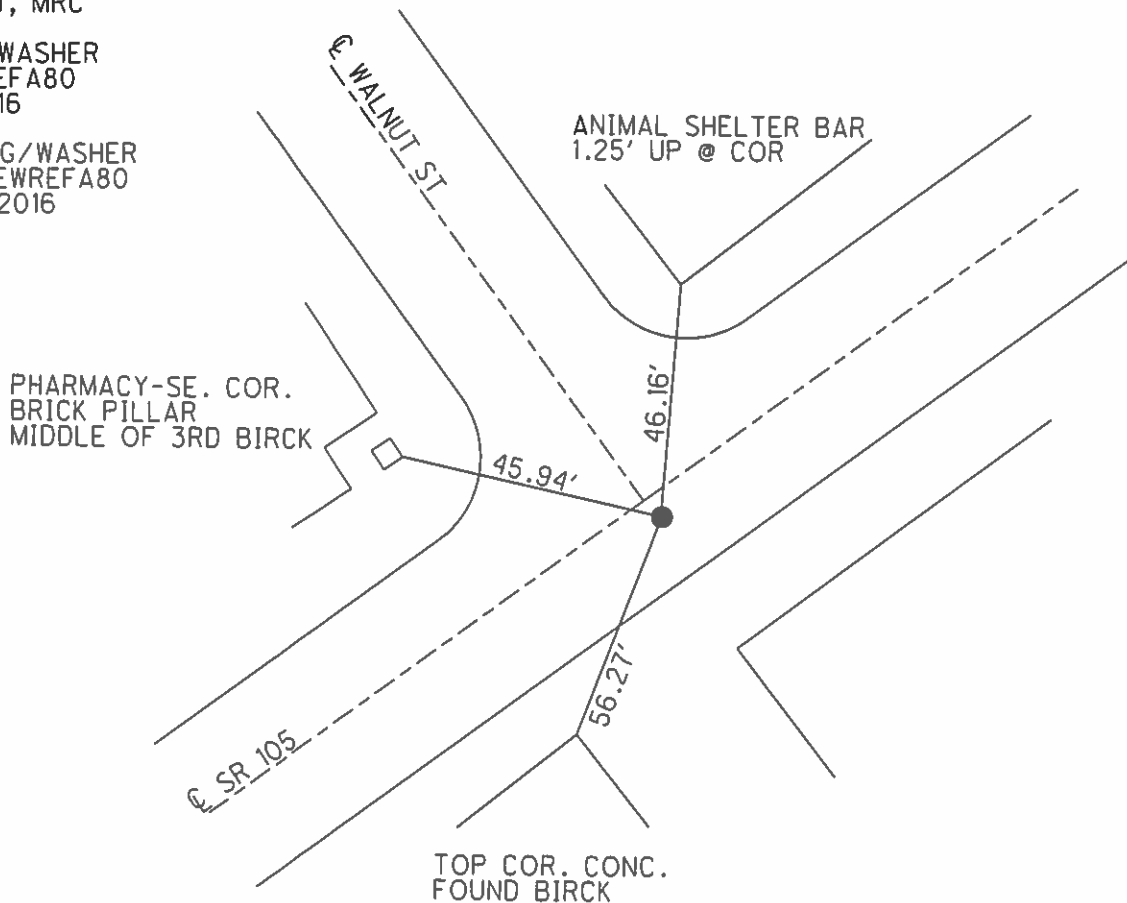

O.D.O.T. DISTRICT 2 SURVEY OFFICE

PERSONNEL _____

REFERENCE NO. 80A

SHEET 34 OF 49

NOTES CHANEY

H.C. RIPPLE

R.C. BARBOUR

DATE 8-5-94

WEATHER OVERCAST

TEMP. + 80°

ROUTE S.R. 105

COUNTY WOOD

TOWNSHIP FREEDOM

SECTION 10

T 5 N R 12 E


TYPE MONUMENT PK/WASHER

ON SURFACE - BELOW YES

~~LEFT - & PAVT.~~ - RIGHT YES 5.0' RT &

20.3 TO RT EDGE PAVEMENT

S.L.M. 499 + 38

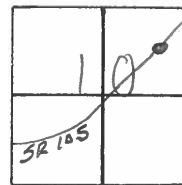

RECORD: P.O.T. 500 + 98.99

$\Delta = 0^\circ - 00' - 00''$

SET PK/WASHER
11-14-94 MRC.



County WOOD S.R. 105

Date 8-9-84

Township FREEDOM - PEMBERVILLE

Weather PT CLOUDY


Section 10

Temp. +85

T5N, R12E

Personnel	<u>BARNAISEZ</u>	<u>HC</u>
	<u>HOUSEHOLDER</u>	<u>RC</u>
	<u>LOEHMKE</u>	<u>TT</u>
	<u>HOFFMAN</u>	<u>P</u>


80A

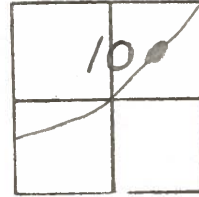

RECORDED
 P.O.T.
 500+98.99
 Δ = 0°-00'

SET PK+WASHER
 10-3-84
 C.L


PK 20.3 Lt of R+ CURB

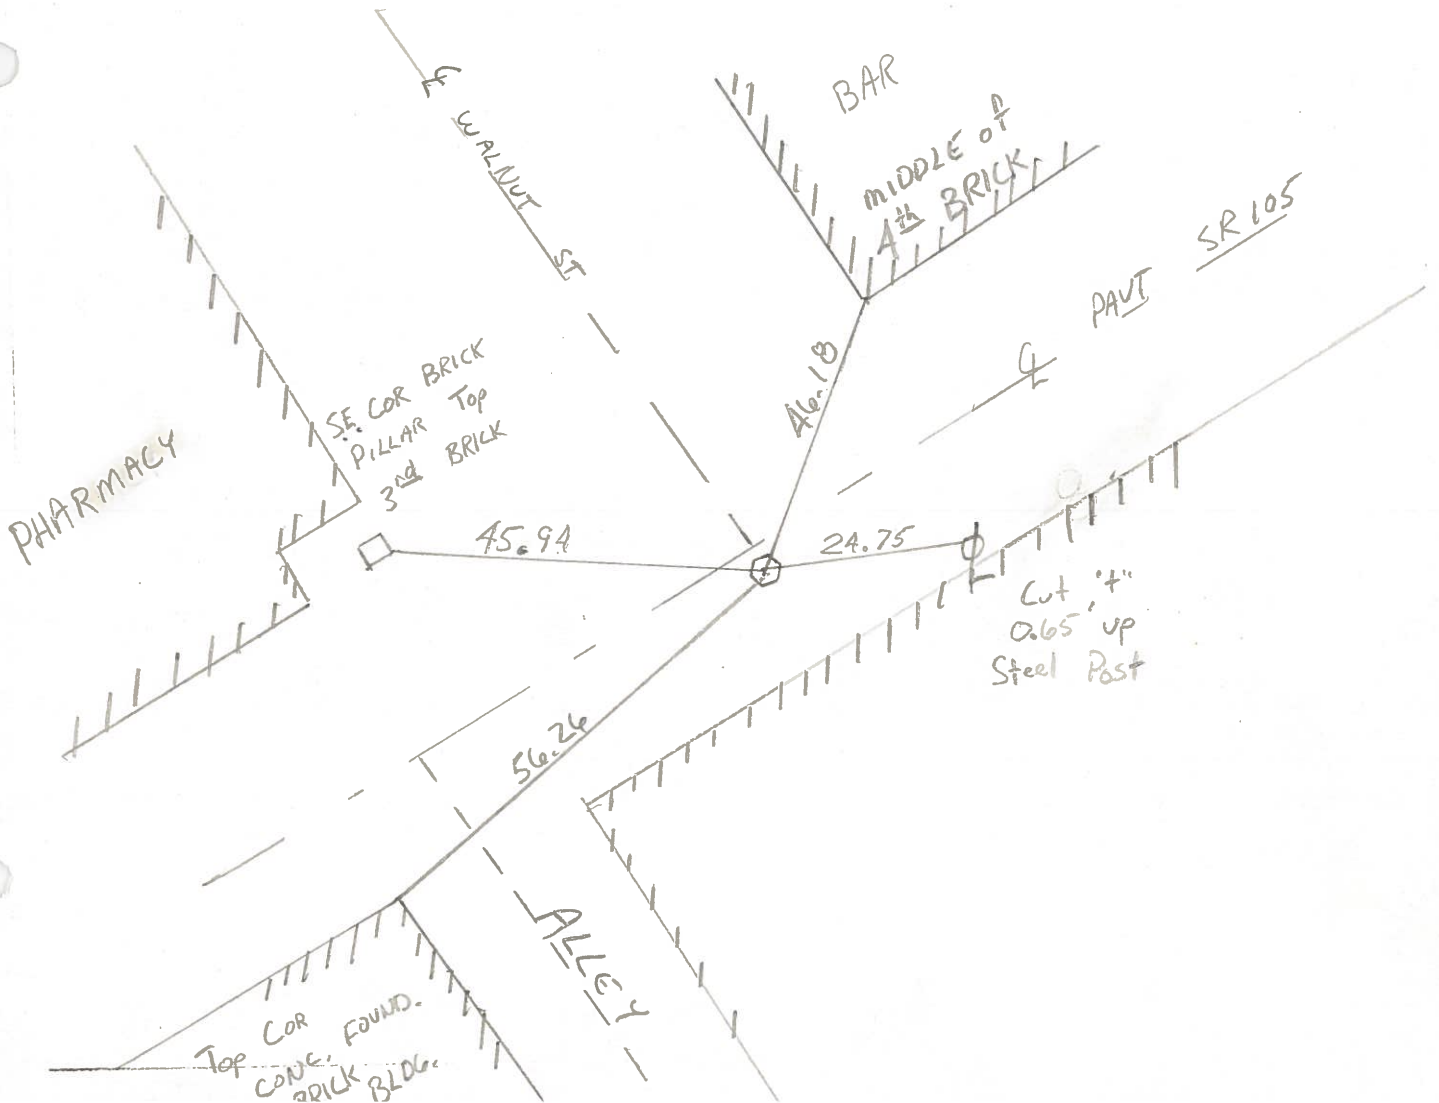

PERSONNEL	TITLE	PERSONNEL	TITLE
Stone			
Michalak			
Donne			
Quatis			

COUNTY Wood DATE 1 Nov. 73
 S. R. 105 WEATHER Cool
 SEC. Pemberville TEMP. 45°

DESCRIPTION References to Control Points JOB NO. _____
 LEFT CENTER LINE RIGHT

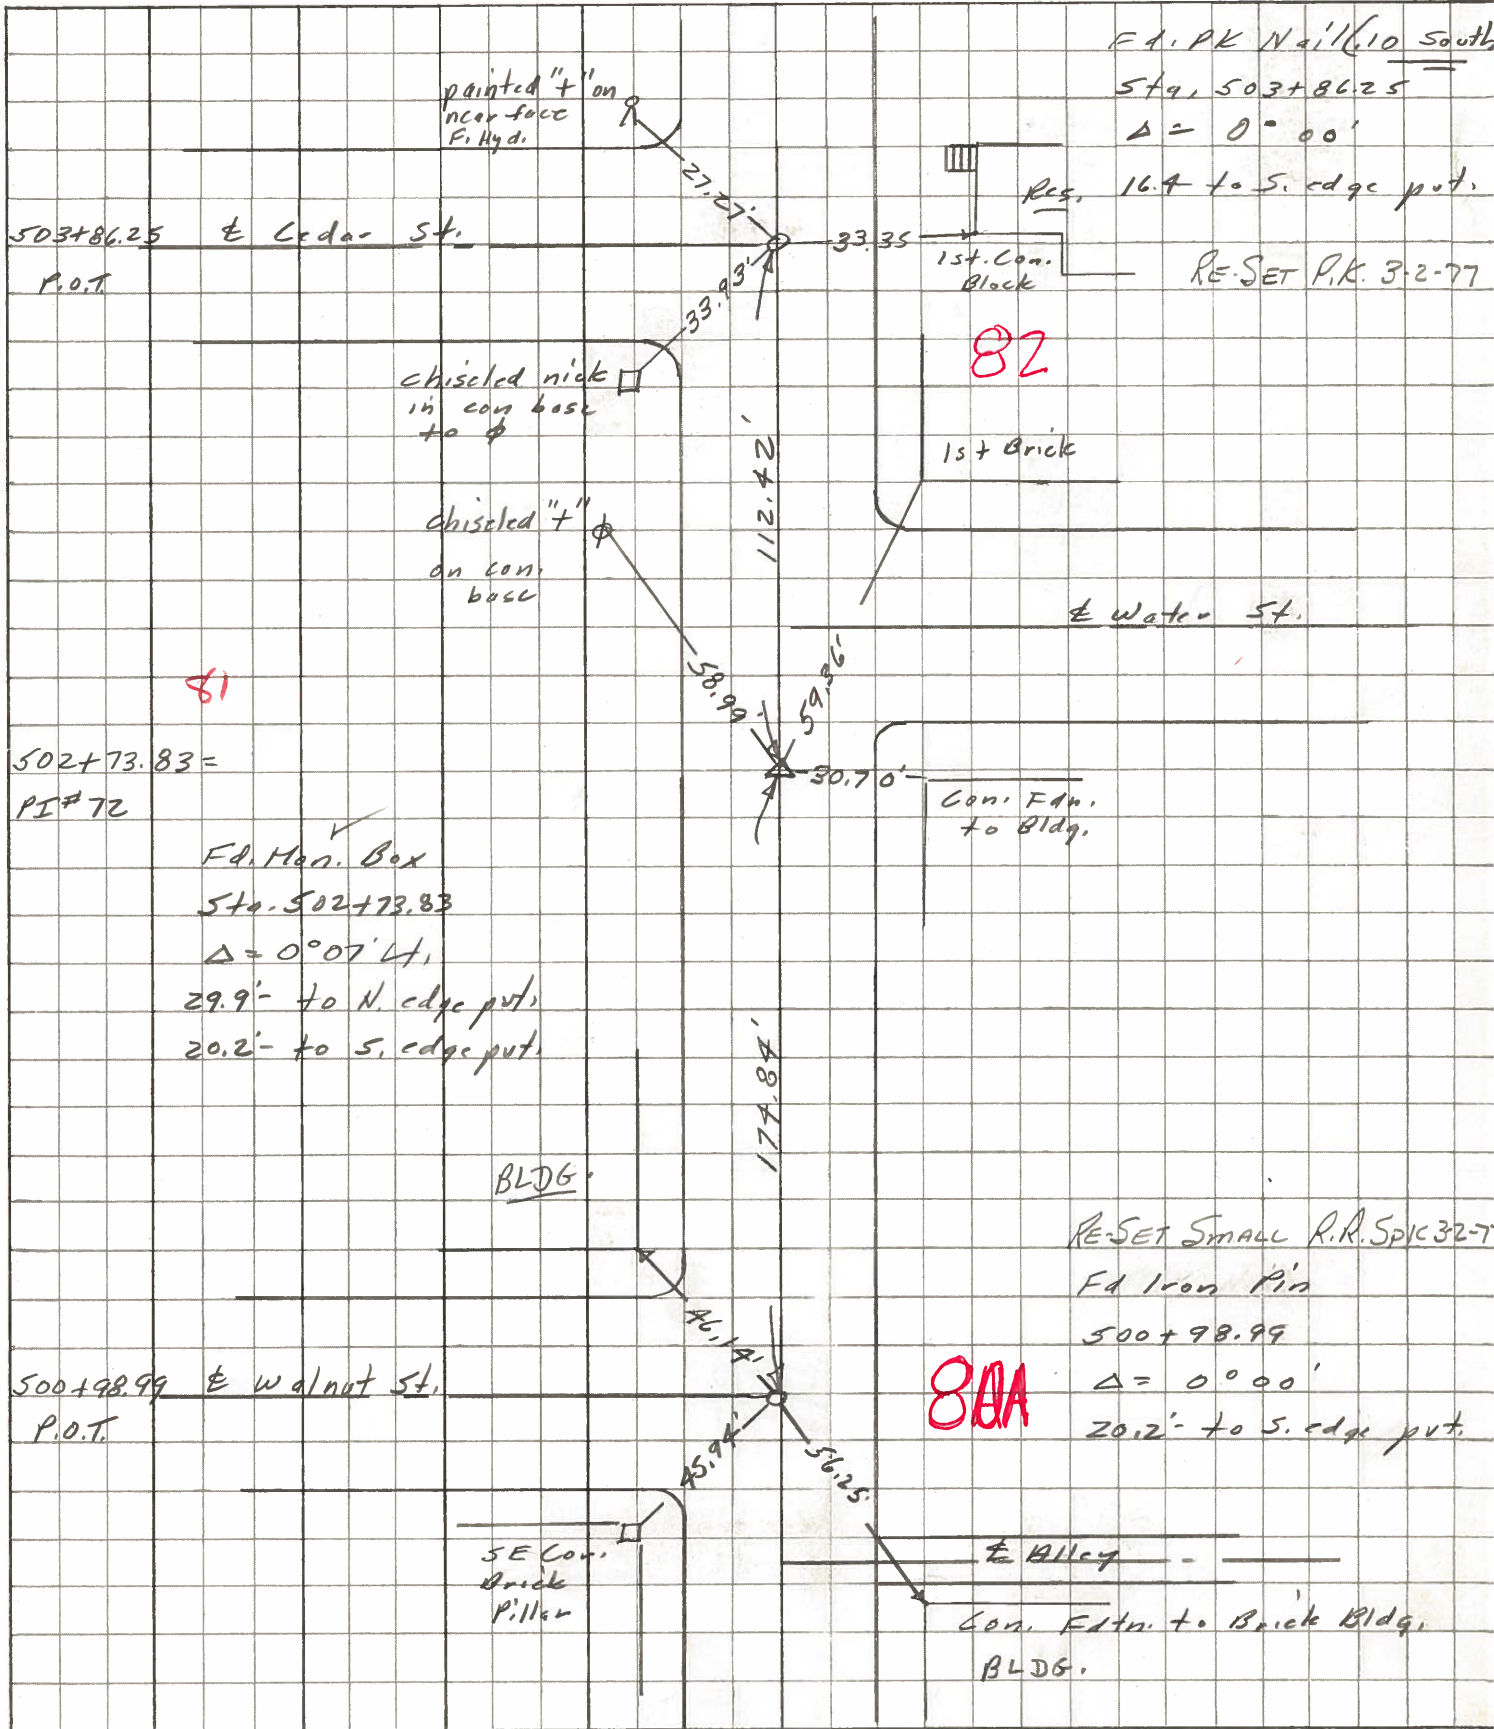

PERSONNEL TITLE PERSONNEL TITLE

COUNTY Wood DATE OK-9-16-70


S. R. #105 WEATHER _____

SEC. Pemberville TEMP. _____

DESCRIPTION LEFT CENTER LINE RIGHT JOB NO.

STA. 394+53.03
MON. BOX


#929
81

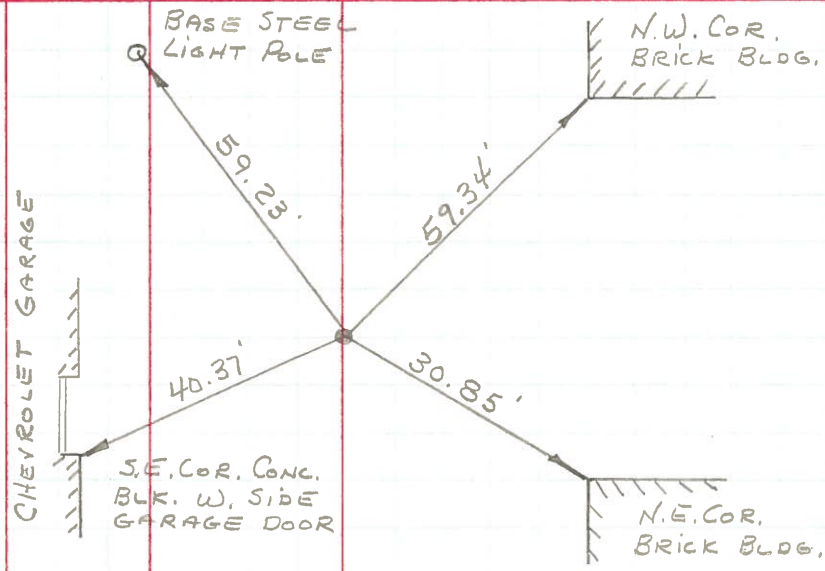

S.W. COR, BRICK BLDG.
"BUD'S CAFE"

STA. 392+78.13
"IRON PIN"
FO. P.K.

WALNUT ST.
80A

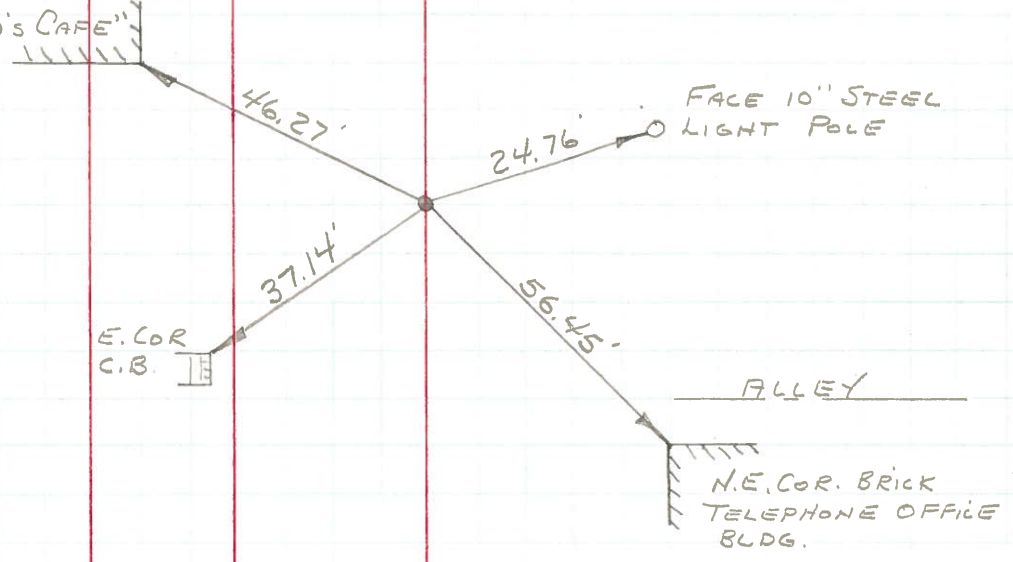

PERSONNEL	TITLE	PERSONNEL	TITLE	COUNTY	DATE	WEATHER	TEMP
				Wood	OK 12-24-57 OK-9-16-70		
				S. R. #105			
				SEC.			

DESCRIPTION	LEFT	CENTER LINE	RIGHT	JOB NO.
-------------	------	-------------	-------	---------

