


O.D.O.T. DISTRICT 2 SURVEY OFFICE (USE ONLY)

PERSONNEL _____ REFERENCE NO. 81 SHEET 13 OF 17
 NOTES LEU DATE 04-25-16 ROUTE SR 105
 H.C. HOMAN WEATHER PARTLY CLDY COUNTY WOOD
 R.C. LEU TEMP. 52°F TOWNSHIP FREEDOM
 _____ SECTION 10
 _____ T 5 N R 12 E

TYPE MONUMENT MON BOX W/STONE W/ DRILLHOLE
 ON SURFACE - ~~BELOW~~ ON
 LEFT - ℄ PAV'T - RIGHT ON
_____ TO _____ EDGE PAVEMENT
 S.L.M. 501+14

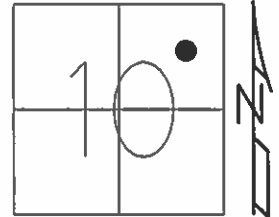


GRID: NORTHING: 636838.4713 EASTING: 1705436.306

RECORD:
 P.I.#72 STA 502+73.83
 $\Delta=0^{\circ}07'00''$ LT

RECORD DIST.81-81A =25.7'

FD MON BOX
 W/STONE
 W/ DRILL HOLE
 GPS, REF81
 04-25-16

FD MON BOX
 W/ STONE
 W/ DRILL HOLE
 GPS, CKREF81
 09-22-16, DCH
 GPS, NEWREF81

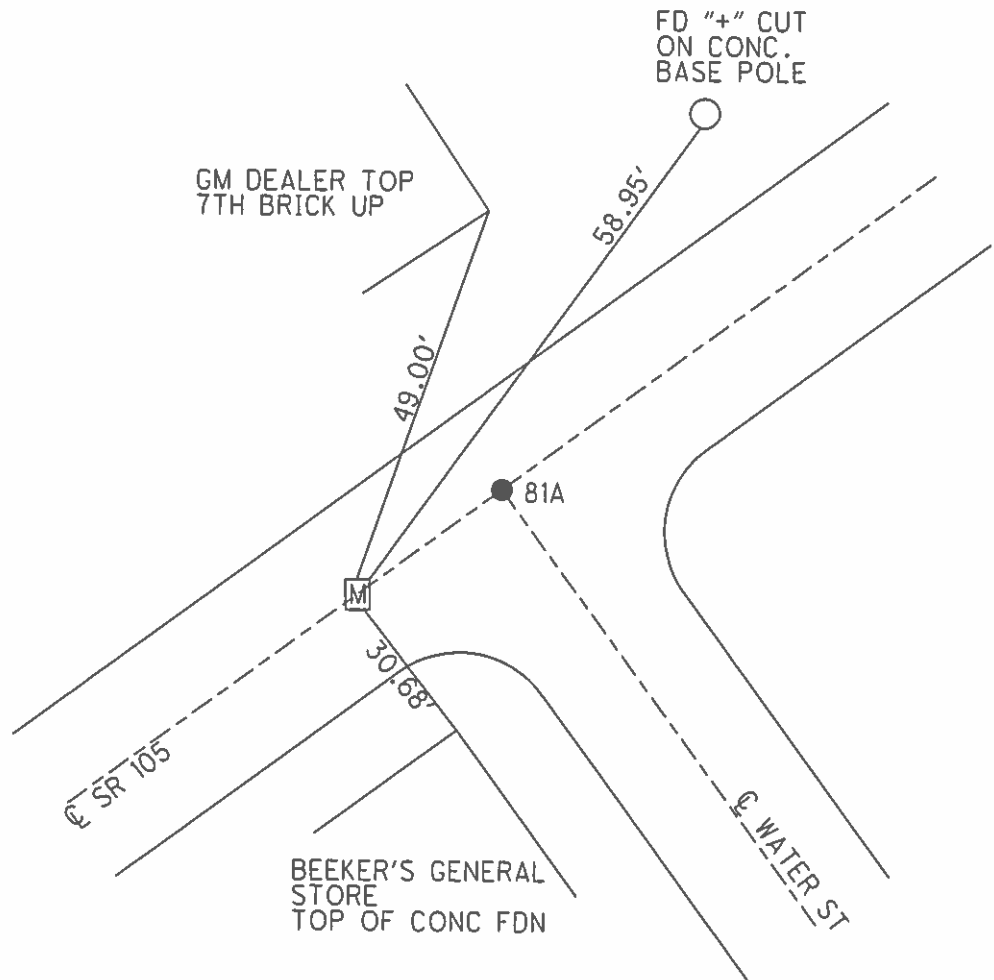

O.D.O.T. DISTRICT 2 SURVEY OFFICE

PERSONNEL

REFERENCE NO. 81

SHEET 35 OF 49

NOTES CHANEY

H.C. RIPPLE

R.C. BARBOUR

DATE 8-5-94

WEATHER OVERCAST

TEMP. +65°

ROUTE S.R. 105

COUNTY WOOD

TOWNSHIP FREEDOM

SECTION 10

T 5 N R 12 E


TYPE MONUMENT MON BOX

ON SURFACE - ~~BELOW~~ YES

~~LEFT - & PAV'T. - RIGHT~~ YES ON &

TO EDGE PAVEMENT

S.L.M. 501 + 14

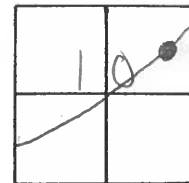

RECORD: P.I. #72 STA 502 + 73.83


$\Delta = 0^\circ - 07' - 00''$ LT.

PT "A" FD. PK AT SURFACE
 & OF BOTH PARTS.
 29.7' RT. E/P
 5' RT. &
 STA 501 + 39.7

G.M. DEALER
 TOP OF 7TH
 BRICK WP.

OB FD "F" CUT
 ON CONC. BASE POLE

SET PK/WASHER AT
 PT "A" 11/14/94 MRC.

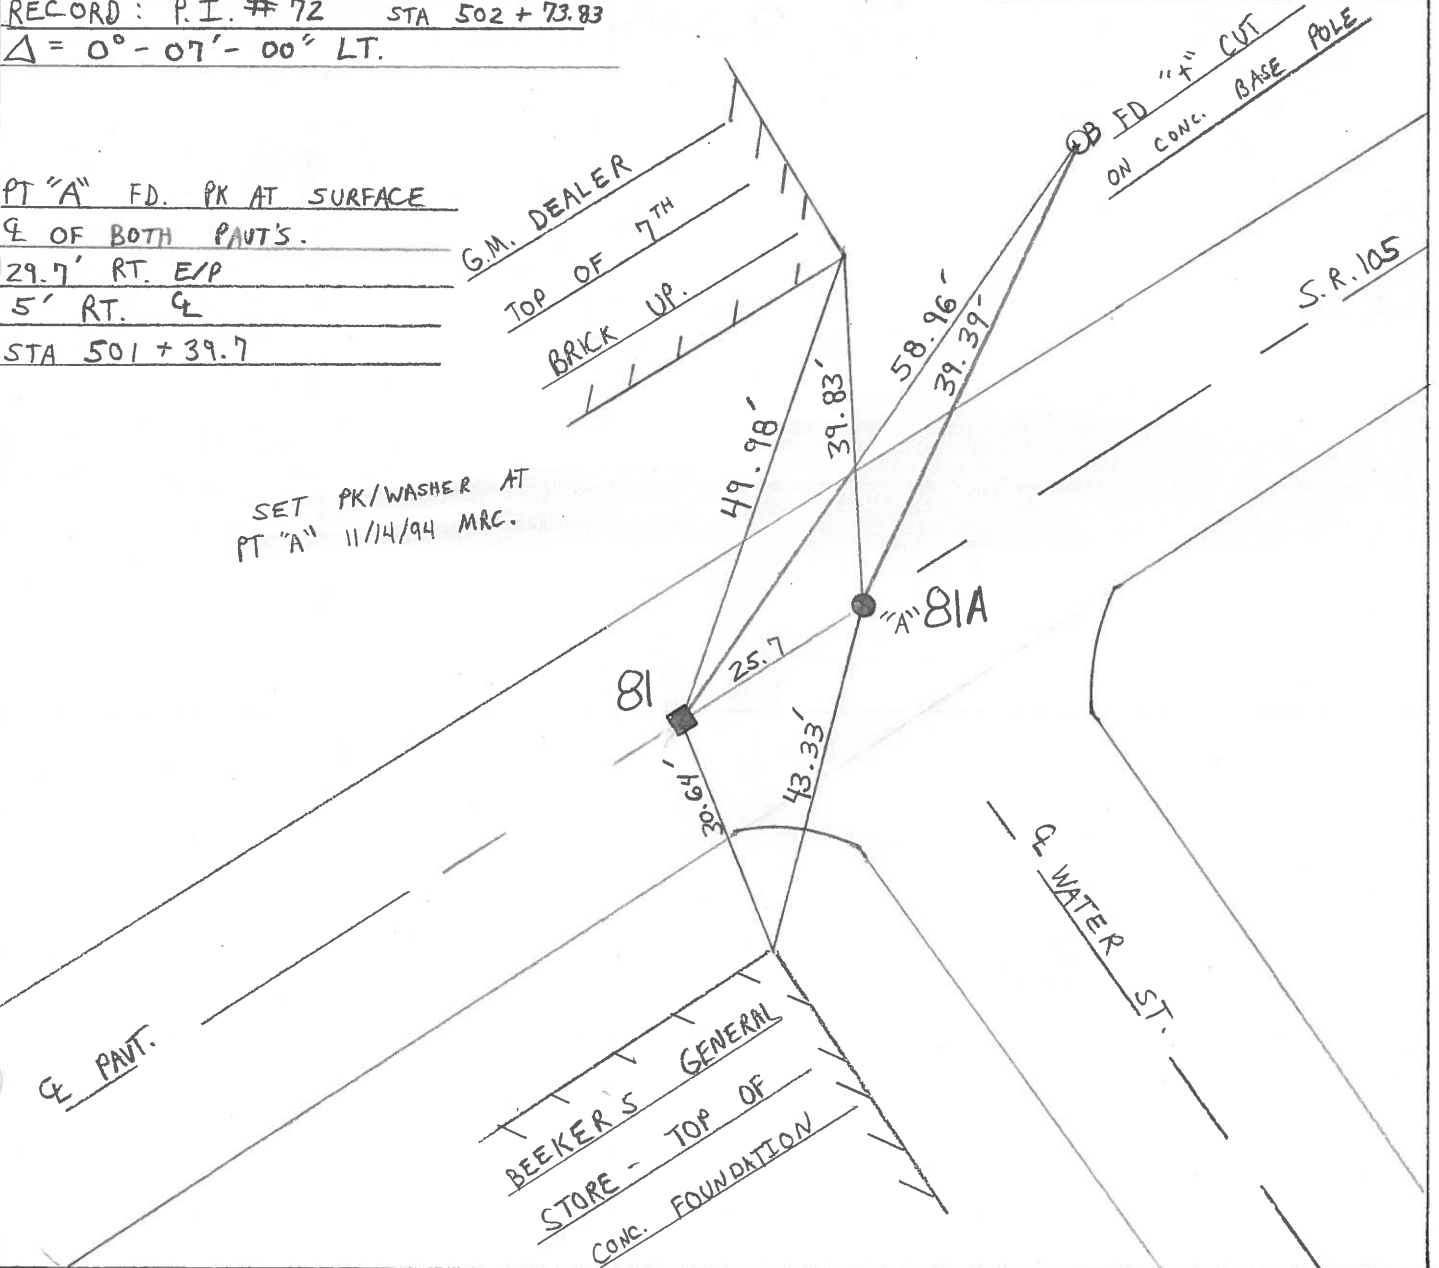

County WOOD S.R. 105

Township FREEDOM - PEMBERVILLE

Section 10

T5N, R12E

Personnel BARNHISEL HC

HOUSEHOLDER RC


LOEHRKE M

Hoffman P

Date 8-9-84

Weather PT CLOUDY

Temp. +85

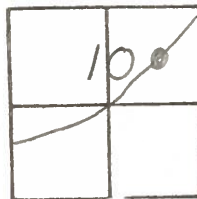

81

RECORDED

P.I. #72

502+73.83

$\Delta = 0^\circ - 07' - 00''$ Lt.

MON BOX DID NOT OPEN

Ref to top CNTR.

SLM 499+35

MON BOX RAISED

10-3-84

C.L.

4" CUT ROUND

CONC. BASE

4" Fd PK @ SURFACE

& Both PAUTS

SLM 499+61


SET PK + WASHER

10-3-84

C.L.

81 →


"A" 81A

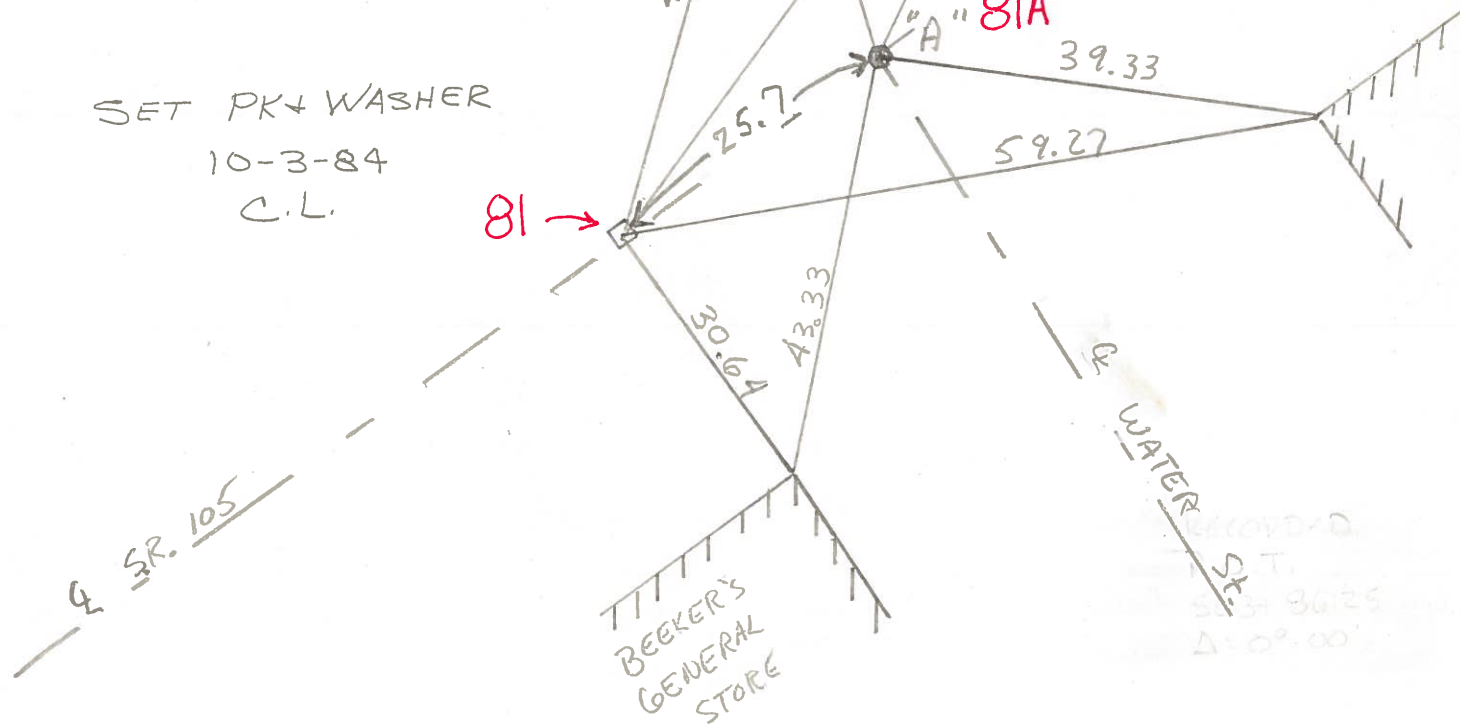

RECORDED
 T.
 S. 31 36 29
 $\Delta = 0^\circ - 00'$

PERSONNEL	TITLE	PERSONNEL	TITLE	COUNTY	DATE	WEATHER	TEMP.
Stone				Wood	1 Nov. 73	Cool	45°
Michalak				S. R. 105			
Dunn				SEC. Pemberville			
Curtis							

DESCRIPTION References to Control Points JOB NO. _____

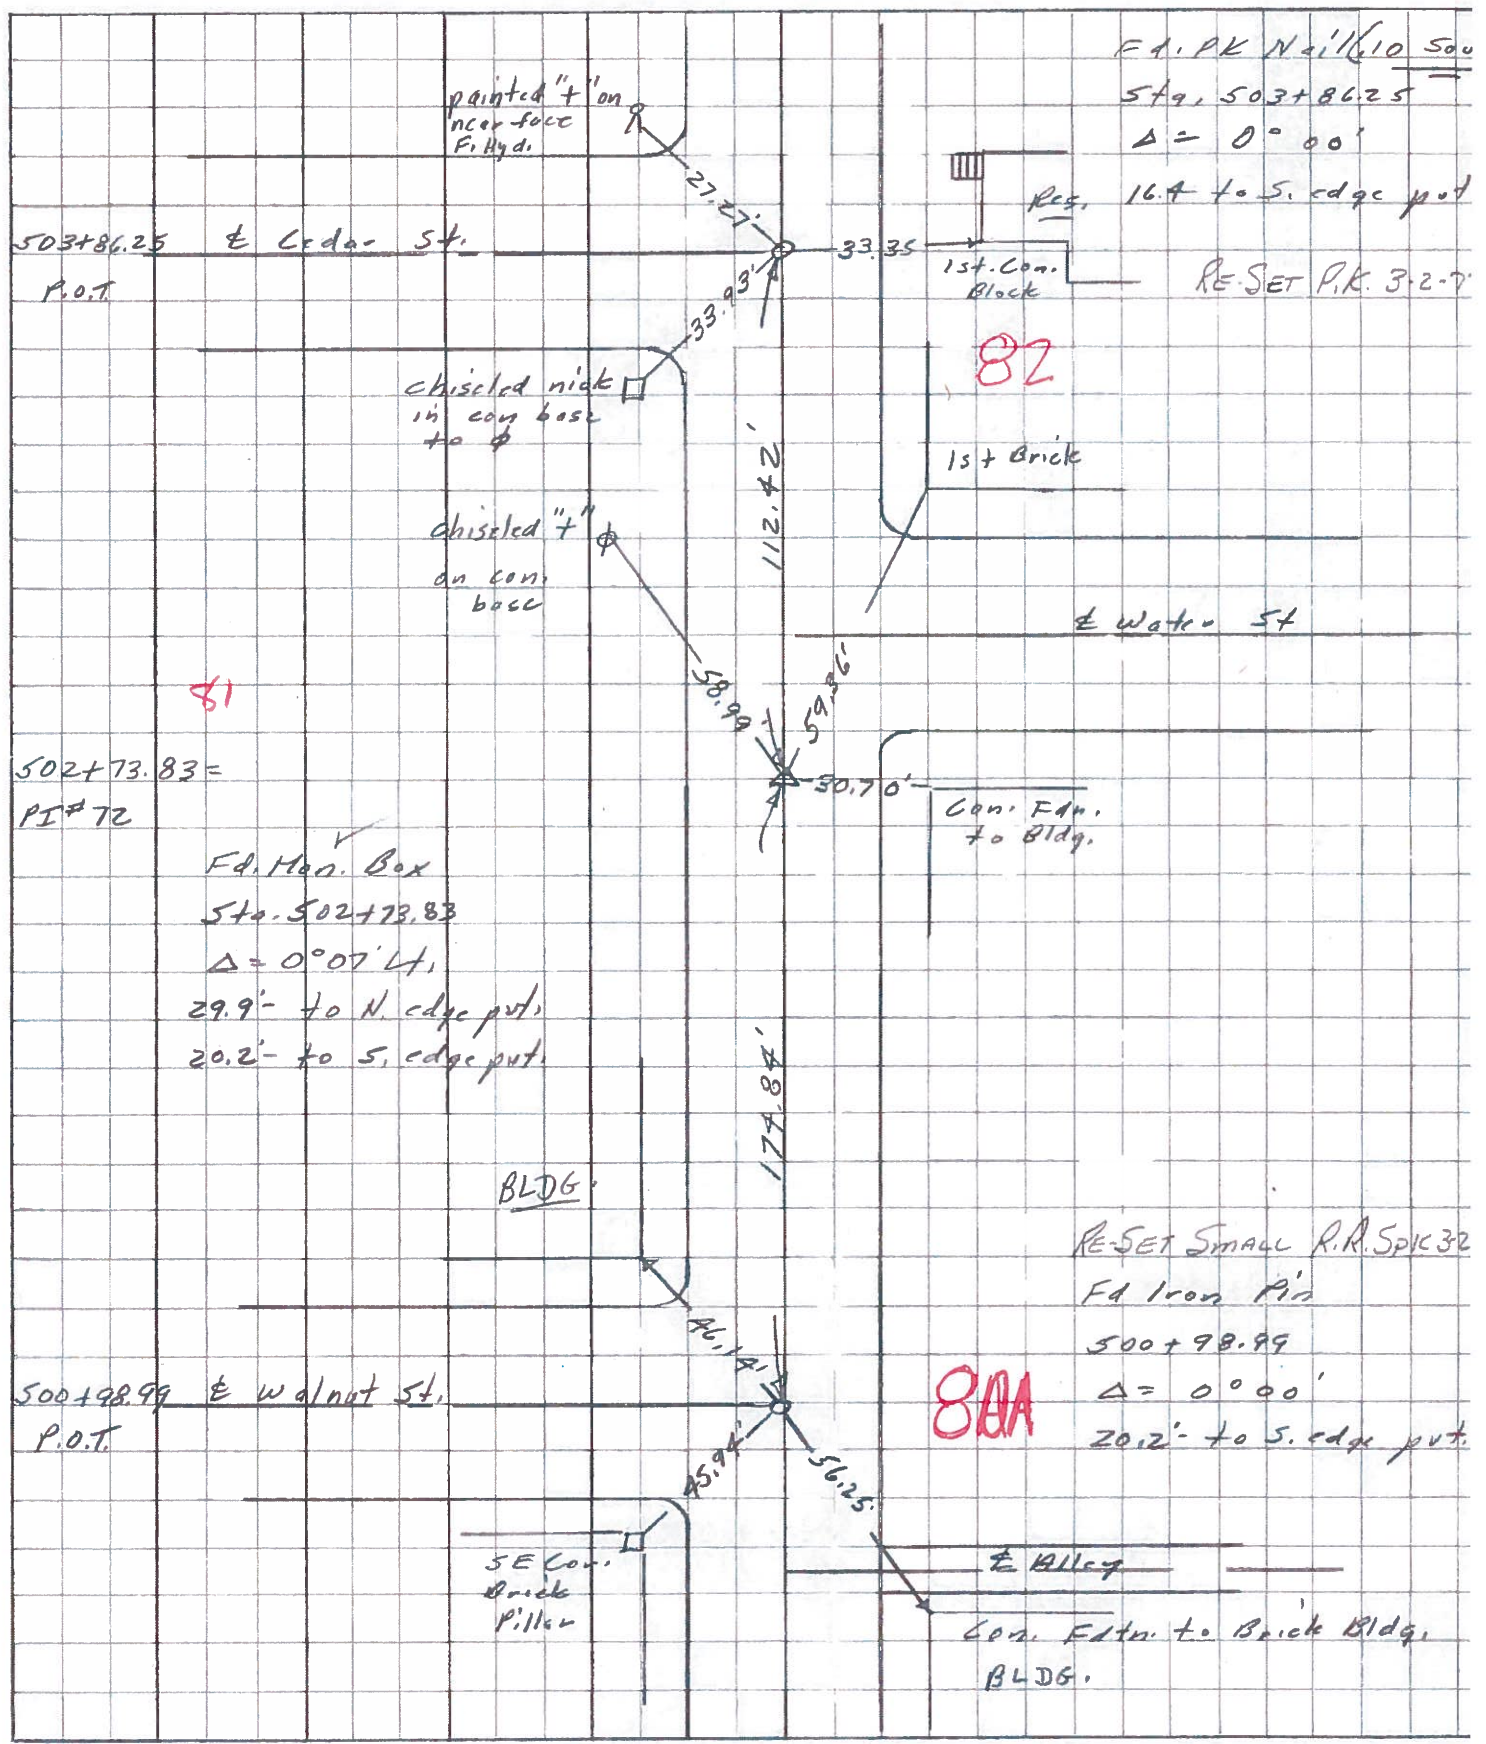

Fd. PK Nail 1/16" Dia
Sta. 503+86.25
Δ = 0° 00'

16.4' to S. edge put

RE-SET P.K. 3-2-7

82

81

8AA

RE-SET SMALL R.R. SPIC 32

Fd Iron Pin
500+98.99
Δ = 0° 00'
20.2' to S. edge put.

PERSONNEL TITLE PERSONNEL TITLE

COUNTY Wood DATE OK-9-16-70

S. R. #105 WEATHER _____

SEC. PEMBERVILLE TEMP _____

DESCRIPTION LEFT CENTER LINE RIGHT JOB NO. _____

STA. 394+53.03
MON. BOX

#929
81

CHEVROLET GARAGE

BASE STEEL LIGHT POLE

59.23'

40.37'

S.E. COR. CONC. BLK. W. SIDE GARAGE DOOR

59.34'

30.85'

N.W. COR. BRICK BLDG.

N.E. COR. BRICK BLDG.



S.W. COR. BRICK BLDG.

"BUD'S CAFE"

46.27'

24.76' FACE 10" STEEL LIGHT POLE

STA. 392+78.13
IRON PIN
FO. P.K.

37.14'

56.45'

E. COR. C.B.

ALLEY

WALNUT ST.

80A

N.E. COR. BRICK TELEPHONE OFFICE BLDG.