


O.D.O.T. DISTRICT 2 SURVEY OFFICE (USE ONLY)

PERSONNEL	REFERENCE NO.	81 A	SHEET	14	OF	17
NOTES	LEU	DATE	04-25-16	ROUTE	SR 105	
H.C.	HOMAN	WEATHER	OVERCAST	COUNTY	WOOD	
R.C.	LEU	TEMP.	52°F	TOWNSHIP	FREEDOM	
				SECTION	10	
				T	5	N
				R	12	E

TYPE MONUMENT PK/WASHER
 ON SURFACE - ~~BELOW~~ ON
 LEFT - CL PAV'T - RIGHT ON
- TO - EDGE PAVEMENT
 S.L.M. 501+39.7

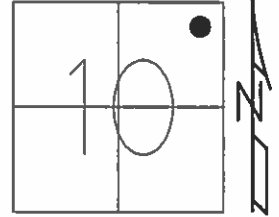


GRID: NORTHING: _____ EASTING: _____

RECORD:
 PK AT SURFACE
 C OF BOTH PAVT
 5' RT C
 STA 501+39.7

RECORD DIST. 81-81A = 25.7'

SET PK/WASHER
 11-14-94

DNF
 04-25-16

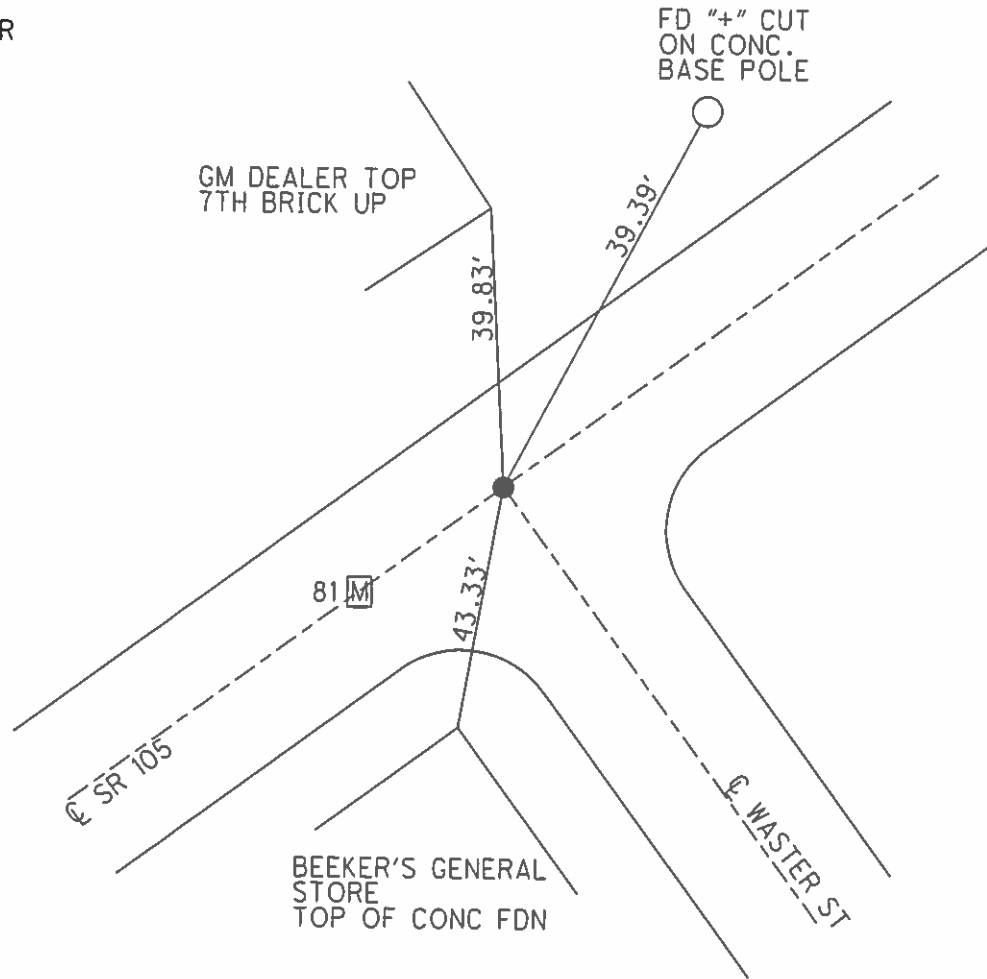

O.D.O.T. DISTRICT 2 SURVEY OFFICE

PERSONNEL

REFERENCE NO. 81

SHEET 35 OF 49

NOTES CHANEY

H.C. RI PPLE

R.C. BARBOUR

DATE 8-5-94

WEATHER OVERCAST

TEMP. +65°

ROUTE S.R. 105

COUNTY WOOD

TOWNSHIP FREEDOM

SECTION 10

T. 5 N R. 12 E


TYPE MONUMENT MON BOX

ON SURFACE - ~~BELOW~~ YES

~~LEFT - & PAVT.~~ RIGHT YES ON &

TO EDGE PAVEMENT

S.L.M. 501 + 14

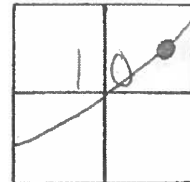

RECORD: P.I. #72 STA 502 + 73.83

$\Delta = 0^\circ - 07' - 00''$ LT.

PT "A" FD. PK AT SURFACE

& OF BOTH PAVT'S.

29.7' RT. E/P

5' RT. &

STA 501 + 39.7

G.M. DEALER
TOP OF 7TH
BRICK UP.

SET PK/WASHER AT
PT "A" 11/14/94 MRC.

81

"A" 81A

49.98'

39.83'

58.96'

39.39'

25.7'

43.33'

68 FD "4" CUT
ON CONC. BASE POLE

S.R. 105

& WATER ST.

& PAVT.

BEEKER'S GENERAL
STORE - TOP OF
CONC. FOUNDATION

County WOOD S.R. 105

Township FREEDOM - PEMBERVILLE

Section 10

T5N, R12E

Personnel BARWHEK HC

HOUSEHOLDER RC


LOENRKE M

Hoffman P

Date 8-9-84

Weather PT CLOUDY

Temp. +85

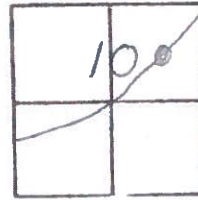

#81

RECORDED
P.I. #72
502+73.83
Δ=0°-07'-00" Lt.
NON BOX DID NOT OPEN
Ref to top CNTR.
SLM 499+35

MON BOX RAISED
10-3-84
C.L.

"+" CUT ROUND
CONC BASE

1" Fd PK @ SURFACE
& Both PAUTS
SLM 499+61

SET PK + WASHER
10-3-84
C.L.

