


O.D.O.T. DISTRICT 2 SURVEY OFFICE (USE ONLY)

PERSONNEL \_\_\_\_\_ REFERENCE NO. 84 SHEET 2 OF 13  
 NOTES RHOADES DATE 7-22-15 ROUTE SR 105  
 H.C. LEU WEATHER CLOUDY COUNTY WOOD  
 R.C. O'DONNELL TEMP. 77° TOWNSHIP FREEDOM  
 \_\_\_\_\_ SECTION 2  
 \_\_\_\_\_ T 5 N R 12 E


TYPE MONUMENT PK. NAIL  
 ON SURFACE - ~~BELOW~~ ON  
~~LEFT~~ - CL PAV'T - RIGHT 0.8'  
8.9' TO RT. EDGE PAVEMENT  
 S.L.M. 529+81.68  
 Grid: Northing: 638374.8865 Easting: 1708025.6102

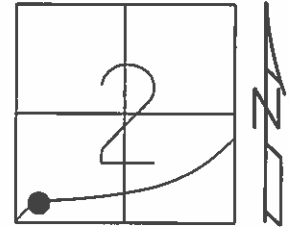

FD. PK/WASHER  
 GPS, REF84  
 10-11-11, RDY

GPS, REF84  
 7-22-15

SET MAG/WASHER  
 GPS, NEWREF84  
 8-22-16, JFO

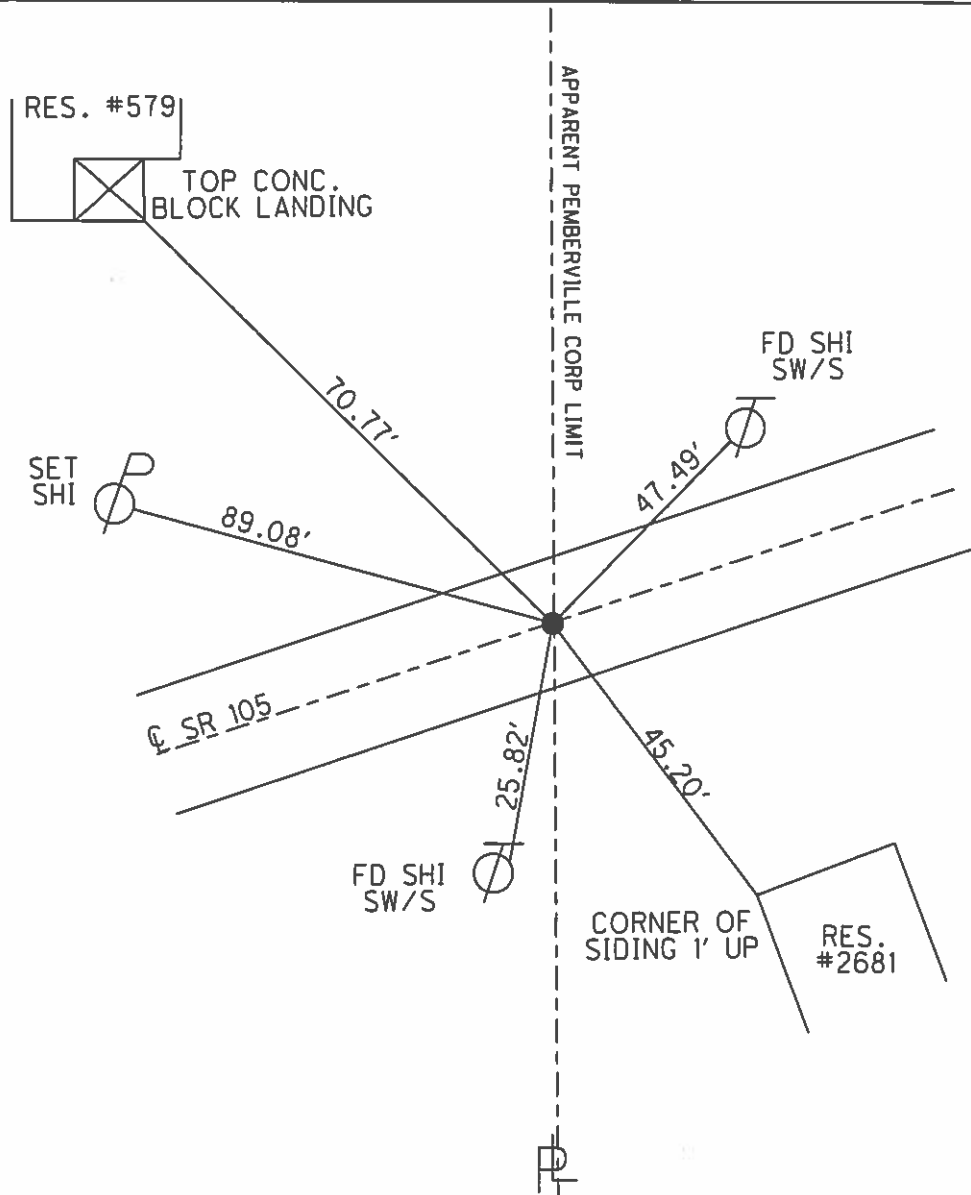

O.D.O.T. DISTRICT 2 SURVEY OFFICE

PERSONNEL

REFERENCE NO. 84

SHEET 39 OF 49

NOTES LOHRKE

H.C. BARNHISEL

R.C. HOUSEHOLDER

HOFFMAN

DATE 11-17-94

WEATHER PT CLOUDY

TEMP. +78

ROUTE 105

COUNTY WOOD

TOWNSHIP FREEDOM

SECTION 2

T 5 N R 12 E



TYPE MONUMENT PK + WASHER

ON SURFACE - BELOW YES

LEFT-(C) PAV T. RIGHT YES

8.9 TO R. EDGE PAVEMENT

S.L.M. 531+44

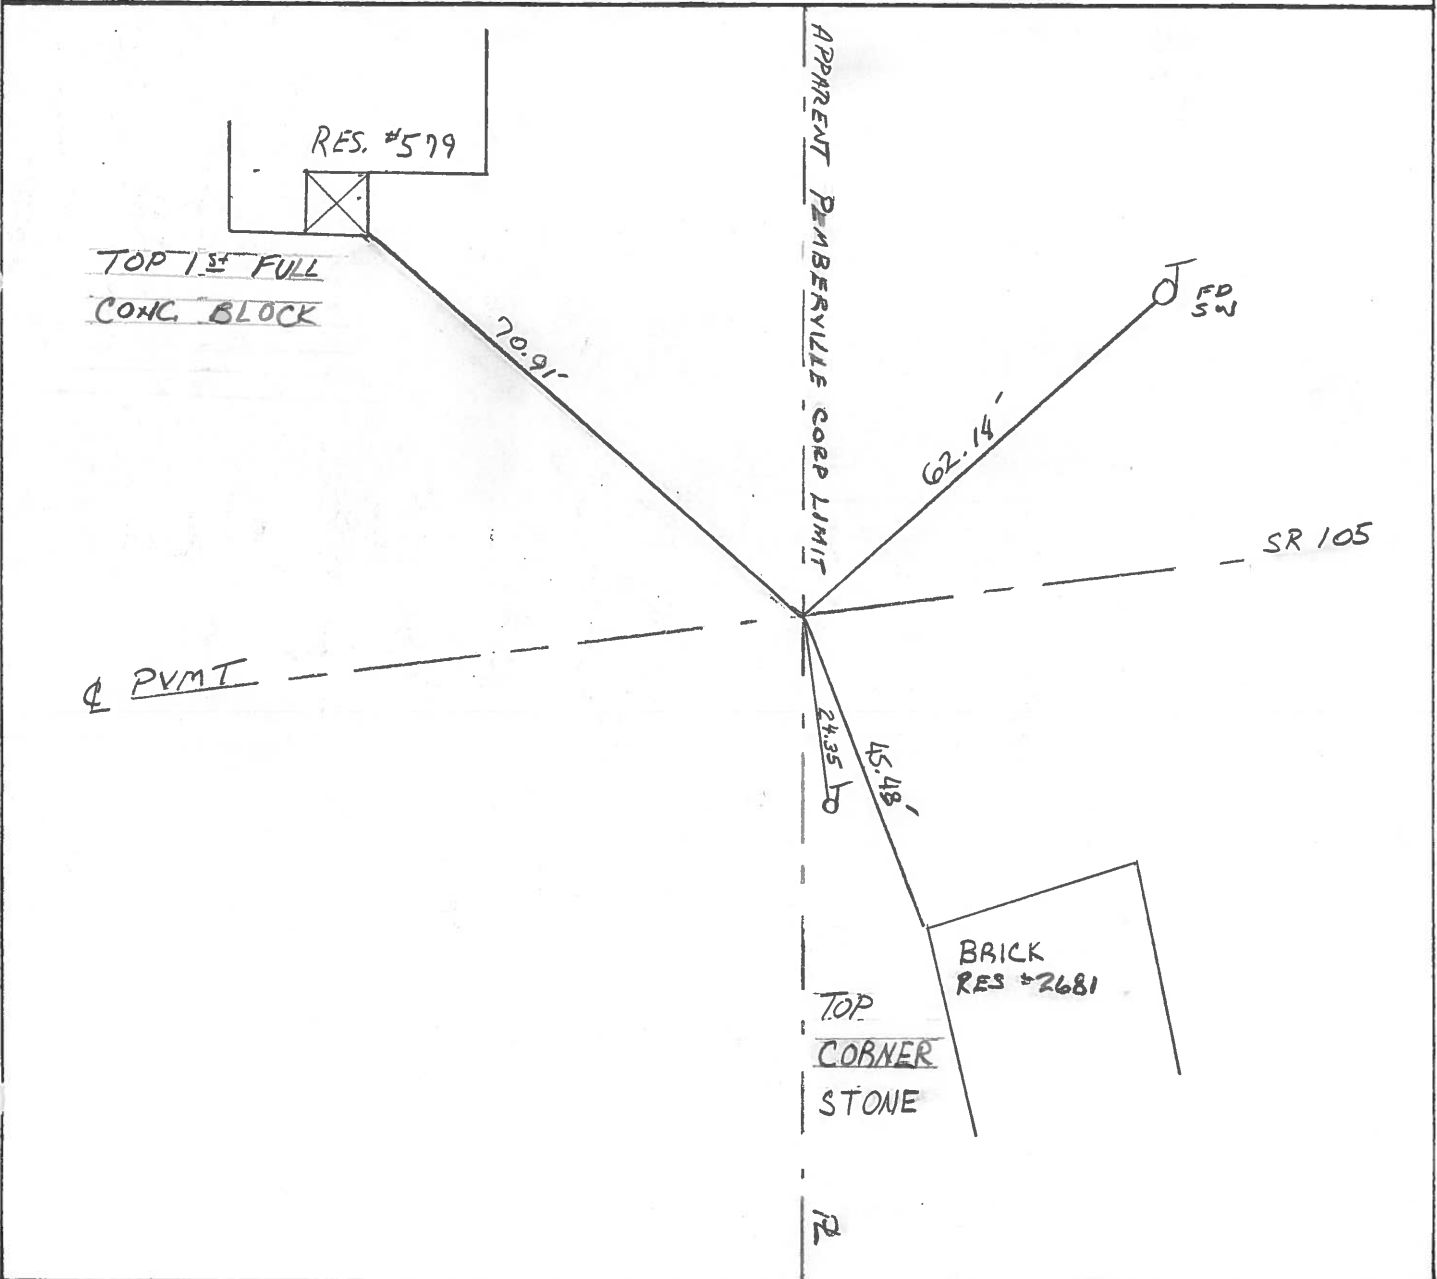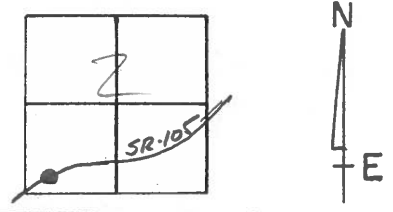

County Wood - S.R. 105

Township FREEDOM

Section 2

TSN, R12E

Personnel BARNHISEZ HC

HOUSEHOLDER RC

LOEHRKE TH


Hoffman P

Date 8-10-84

Weather PT CLOUDY


Temp. +78

84

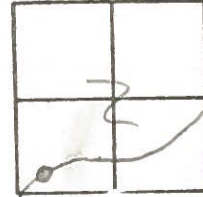

Fd: PK NAIL @ SURFACE  
ON & PAVT  
8.9 REP  
10.6 REP  
SLM 529+58

SET PK+WASHER  
10-3-84  
C.L.

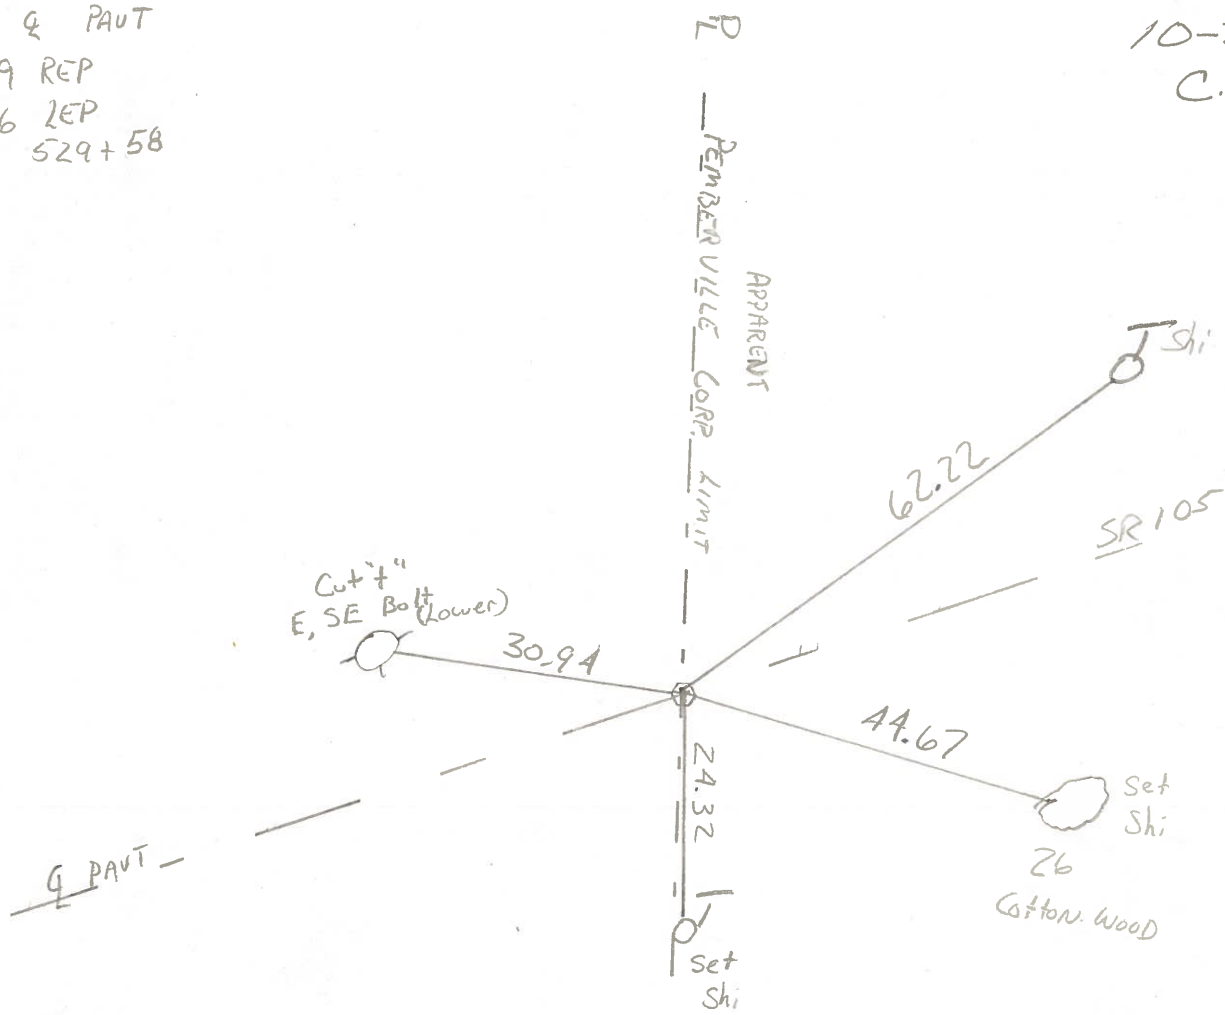

PERSONNEL	TITLE	PERSONNEL	TITLE
Denno			
Michalak			
Curtis			

COUNTY Wood DATE Mar. 7, 74

S. R. 105 WEATHER Mild

SEC. TEMP. 63°

DESCRIPTION References To Control Points LEFT CENTER LINE RIGHT JOB NO.

