

County WOOD S.R. 105

Township FREEDOM - PEMBERVILLE

Section 2

T5N, R12E

Personnel BARNHART HC

HOUSEHOLDER RC


LOEWERKE M

Hoffman P

Date 8-10-84

Weather PT Cloudy

Temp. +75

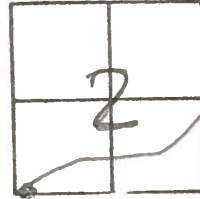

83

"A" RECORDED

P.I. #74

522+71.75

$\Delta = 0^{\circ} - 04' - 00''$ RT

Fd: Sm RR Spike on E/W Section Line

@ SURFACE ON Q PAVT SR 105

9.4 LEP

9.1 REP

SLM 519+31

SET PK + WASHER

FOR BOTH POINTS

10-3-84

C.L.

"B" Fd: Sm RR Spike

@ SURFACE ORIGIN UNKNOWN

9.4 REP

9.1 LEP


ON Q SR 105

SLM 519+03

RECORD STA 414+22.10

1970 STATIONING

28.54
BETWEEN PTS

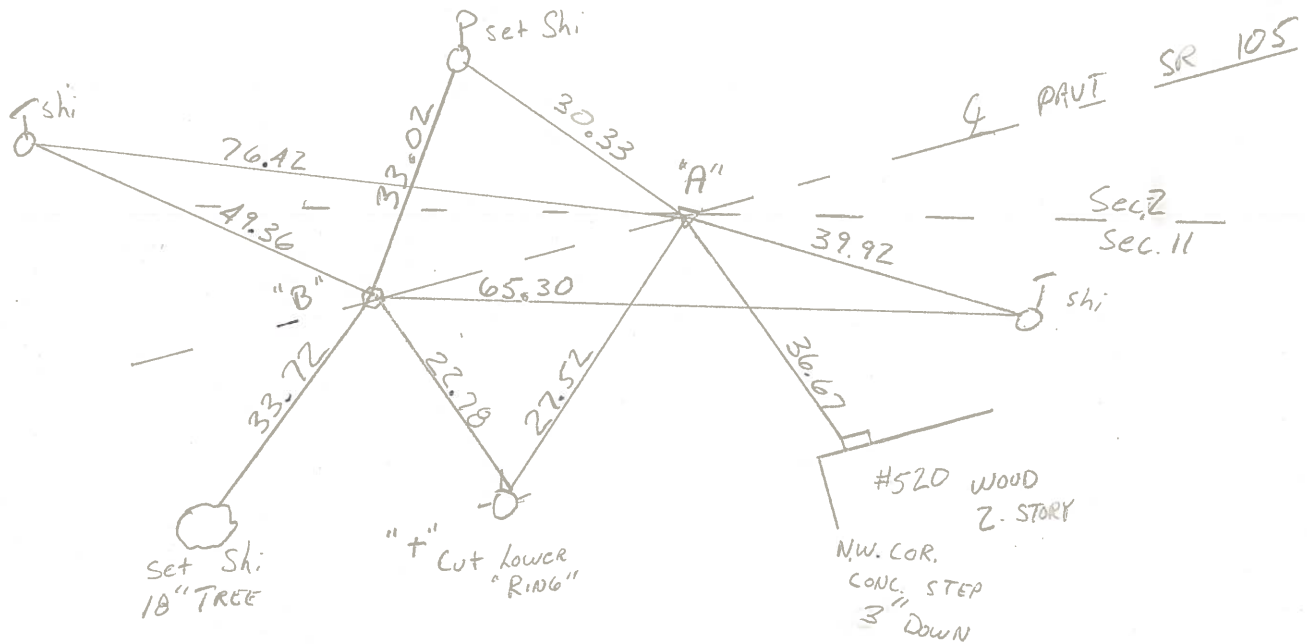

County Wood S.R. 105

Date 8-10-84

Township FREEDOM


Weather PT CLOUDY

Section 2

Temp. +76

T_SN, R_IZE

Personnel	<u>BARNHISEL</u>	<u>HC</u>
	<u>HOUSEHOLDER</u>	<u>RC</u>
	<u>LOETRKE</u>	<u>CL</u>
	<u>Hoffman</u>	<u>P</u>

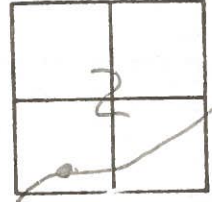

#84

RECORD

526 + 95.74

PI# 75

Δ = 1° 30' 00" Rt

SET PK + WASHER

10-3-84

C.L.

Fd: sm RR Spike @ SURFACE

0.9 LF of Q PAUT

10.0 REP

8.4 LEP

SLM 523 + 55

