


O.D.O.T. DISTRICT 2 SURVEY OFFICE (USE ONLY)

PERSONNEL \_\_\_\_\_ REFERENCE NO. 87 SHEET 5 OF 13  
 NOTES WESTFALL DATE 10-21-13 ROUTE SR 105  
 H.C. LEU WEATHER PTLY CLOUDY COUNTY WOOD  
 R.C. WESTFALL TEMP. 53°F TOWNSHIP FREEDOM  
 \_\_\_\_\_ SECTION 2  
 \_\_\_\_\_ T 5 N R 12 E

TYPE MONUMENT PK NAIL/WASHER  
~~ON SURFACE~~ - BELOW 1/2"  
 LEFT - ☉ PAV'T - RIGHT ON  
- TO - EDGE PAVEMENT  
 S.L.M. 575+86.68  
 Grid: Northing: 640019.2762 Easting: 1711975.0825

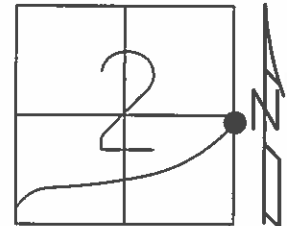

RECORD: P.I. #78  
 STA. 578+85.50


SET PK/WASHER  
 11-17-94, MRC

PREVENTIVE MAINTENANCE  
 CHIP & SEAL 2004  
 EXISTING POINT UNCOVERD  
 08-10-04, MC

GPS, REF87  
 10-21-13, RJL

GPS, REF87  
 7-22-15, JLL

SET MAG/WASHER  
 GPS, NEWREF87  
 9-7-16, JFO

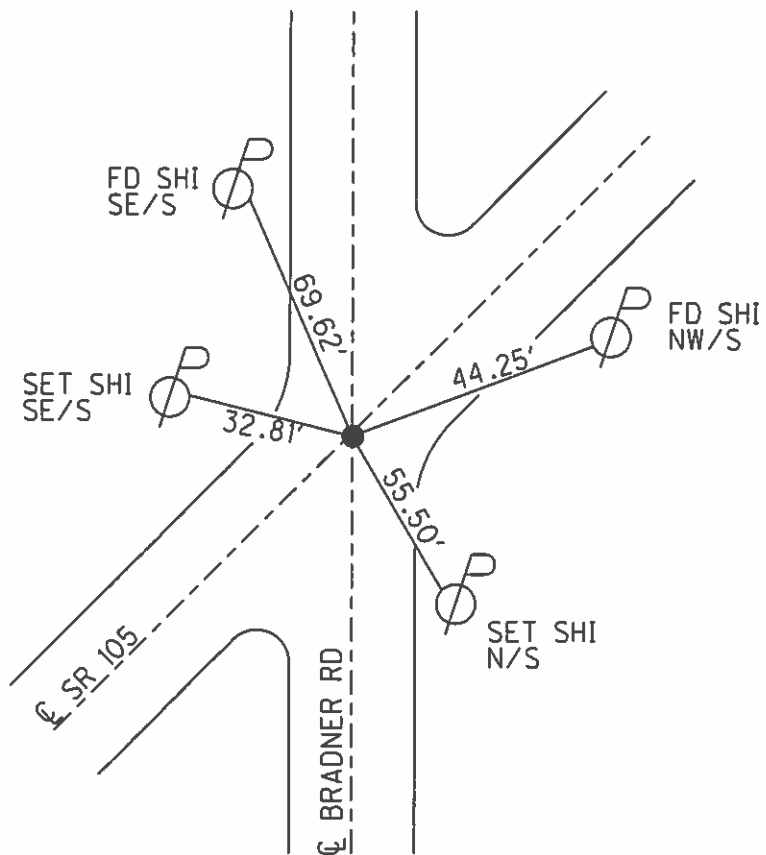

# O.D.O.T. DISTRICT 2 SURVEY OFFICE

PERSONNEL \_\_\_\_\_

REFERENCE NO. 87

SHEET 42 OF 49

NOTES CHANEY

H.C. RIPPLE

R.C. BARBOUR

DATE 8-5-94

WEATHER OVERCAST

TEMP. +65°

ROUTE S.R. 105

COUNTY WOOD

TOWNSHIP FREEDOM

SECTION 2

T 5 N R 12 E


TYPE MONUMENT PK NAIL/WASHER

ON SURFACE - BELOW YES

~~LEFT~~ - ~~Q~~ PAV'T. - ~~RIGHT~~ YES & BOTH

TO EDGE PAVEMENT

S.L.M. 577 + 34

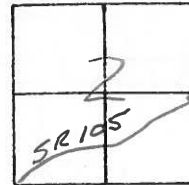

RECORD: P.I. #78

STA 578 + 85.50

Preventive Maintenance  
Chip & Seal 2004  
Existing Point Uncovered  
Date 08/10/04 MC

SET PK/WASHER  
11-17-94 MRC.

SET SHI. SE/S

32.75'

44.25'

54.59'

Fd. SHI. NW/S

Fd. SHI. N/S

S.R. 105

Q PAVT.

BRADNER RD.

Q PAVT.

County Wood S.R. 105

Township FREEDOM

Section 2


TEN, RIZE

Personnel	<u>BARNHISEZ</u>	<u>AC</u>
	<u>HOUSEHOLDER</u>	<u>RC</u>
	<u>LOSHRICE</u>	<u>□</u>
	<u>Hoffman</u>	<u>✓</u>

Date 8-10-84

Weather Pt Cloudy

Temp. +78

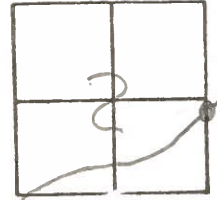

# 87


RECORD

578 +85.50

P.I. 78


Fd: RR. SPIKE @ SURFACE  
 ON & BOTH PAVS  
 SLM 575+39

SET PK + WASHER  
 10-4-84  
 S.W.H.

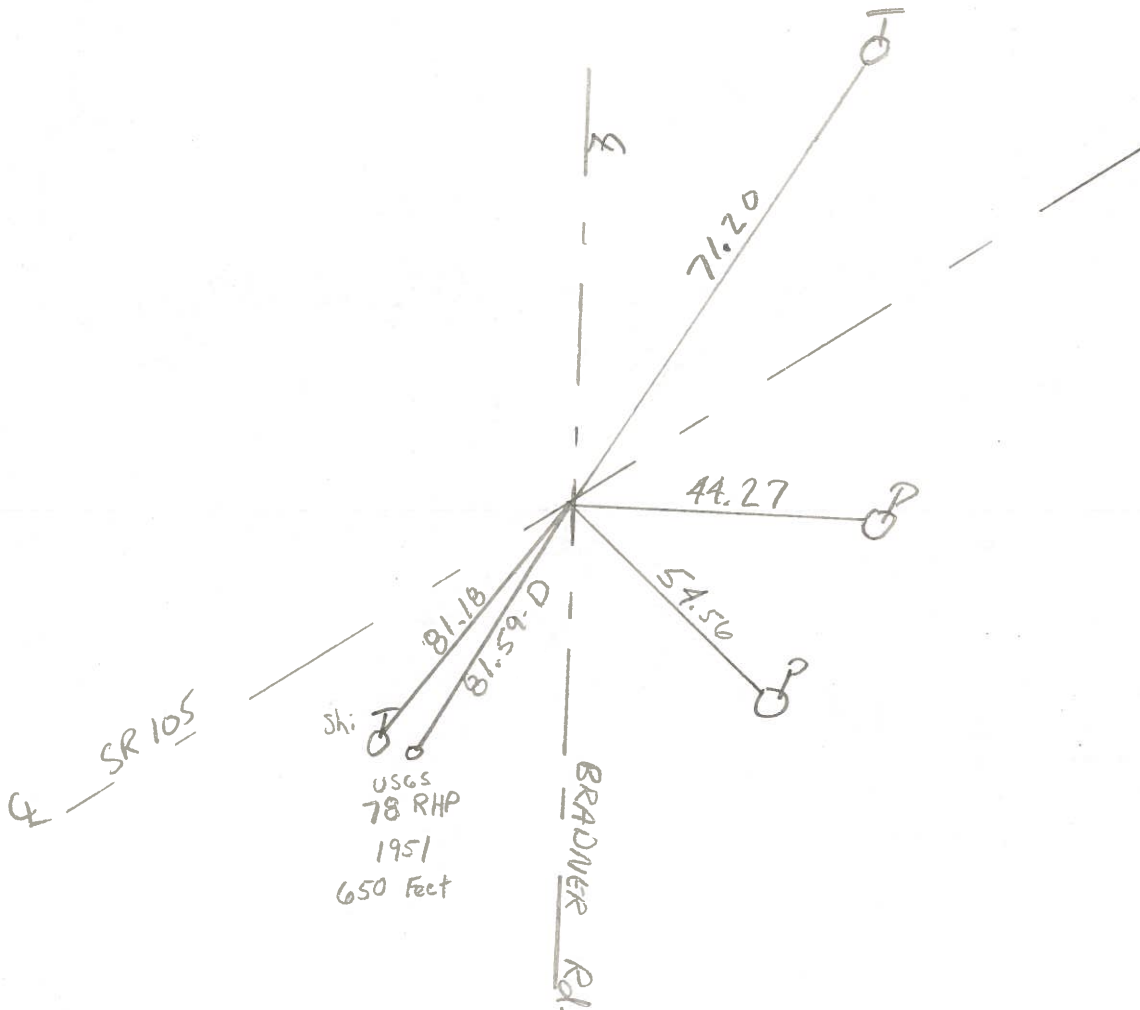

PERSONNEL	TITLE	PERSONNEL	TITLE	COUNTY	DATE
Stone				Wood	25 March 74
Michaelis				S. R. 105	WEATHER Cold
Dean				SEC. Freedom Twp.	TEMP. 33°
Curtis					

DESCRIPTION \_\_\_\_\_ *Alignment* \_\_\_\_\_ JOB NO. \_\_\_\_\_  
 LEFT \_\_\_\_\_ CENTER LINE \_\_\_\_\_ RIGHT \_\_\_\_\_

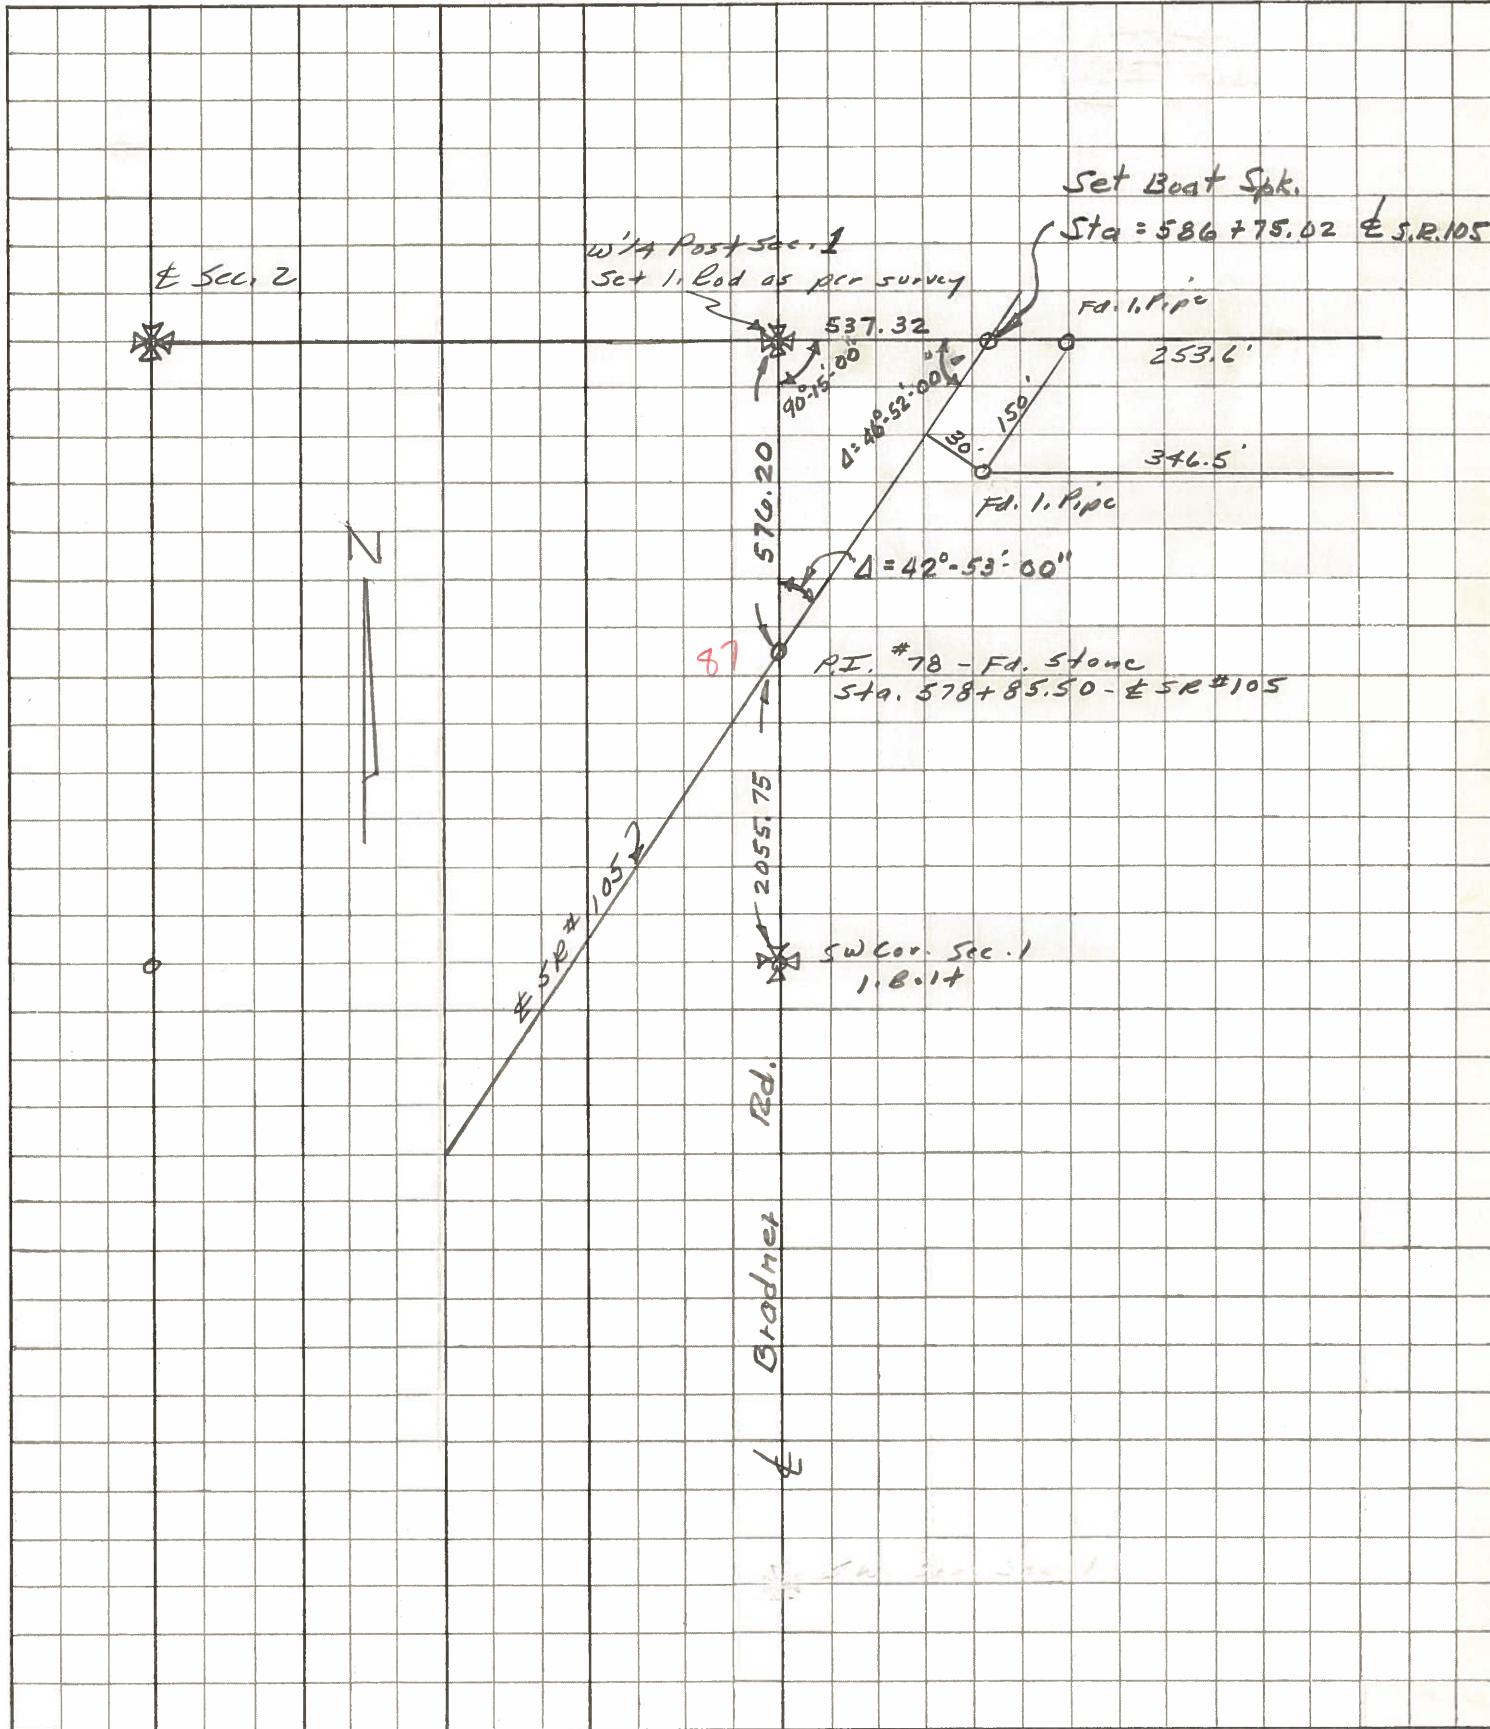

PERSONNEL	TITLE	PERSONNEL	TITLE
Stone			
Denna			
Curtis			

COUNTY Wood DATE Mar 7, 74

S. R. 105 WEATHER Mild

SEC. \_\_\_\_\_ TEMP. 63°

DESCRIPTION References To Control Points JOB NO. \_\_\_\_\_

