


O.D.O.T. DISTRICT 2 SURVEY OFFICE (USE ONLY)

PERSONNEL	REFERENCE NO.	<u>88</u>	SHEET	<u>7</u>	OF	<u>13</u>	
NOTES	<u>WESTFALL</u>	DATE	<u>10-21-13</u>	ROUTE	<u>SR 105</u>		
H.C.	<u>LEU</u>	WEATHER	<u>PTLY CLOUDY</u>	COUNTY	<u>WOOD</u>		
R.C.	<u>WESTFALL</u>	TEMP.	<u>53°F</u>	TOWNSHIP	<u>FREEDOM</u>		
				SECTION	<u>1</u>		
				T	<u>5</u>	R	<u>12</u>
				E			

TYPE MONUMENT PK NAIL/WASHER
 ON SURFACE - ~~BELOW~~ ON
~~LEFT~~ - CL PAV'T - RIGHT 3'
6.3' TO RT EDGE PAVEMENT
 S.L.M. 585+27.44

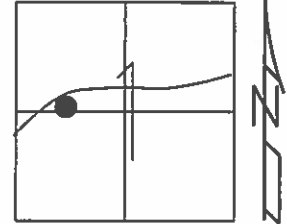

Grid: Northing: 640703.5096 Easting: 1712620.7462

RECORD: P.I. #79
 STA. 588+26.58
 $\Delta=4^{\circ}17'20''$ LT


SET PK/WASHER
 11-17-94, MRC

PREVENTIVE MAINTENANCE
 CHIP & SEAL 2004
 EXISTING POINT UNCOVERD
 08-10-04, MC

FD PK/WASHER
 GPS, REF88
 10-21-13, RJL

GPS, REF88
 7-27-15, JFO

SET MAG/WASHER
 GPS, NEWREF88
 9-7-16, JFO

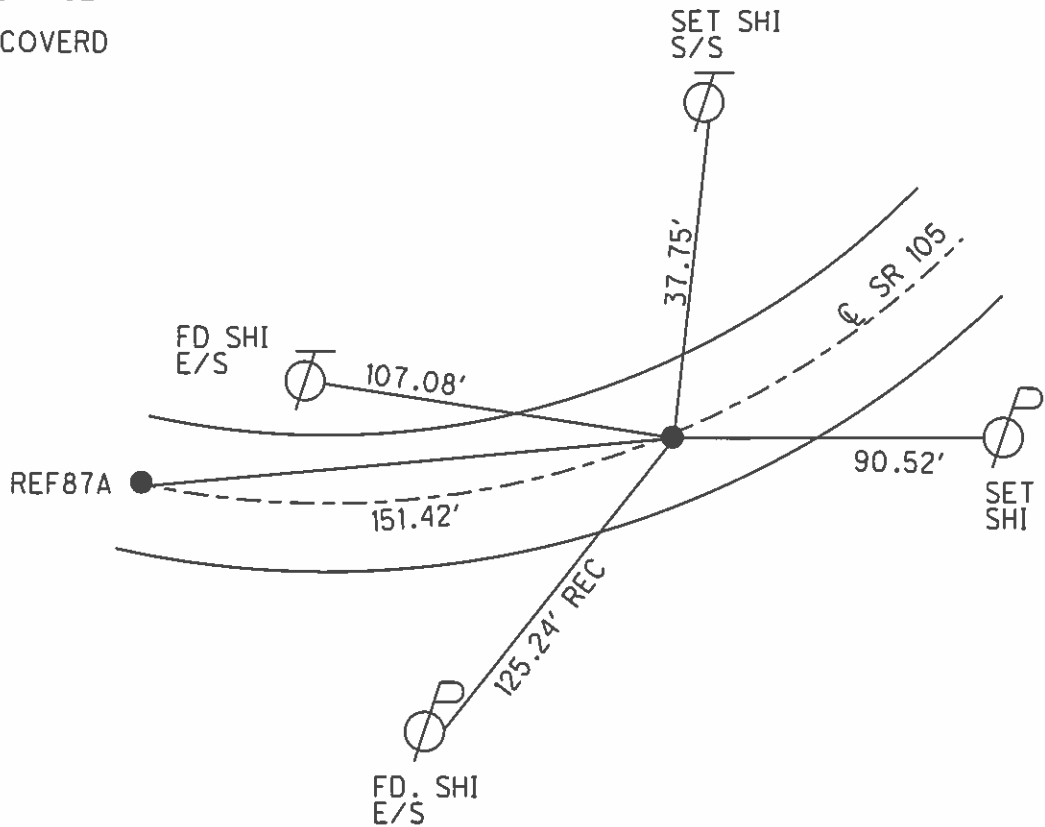

O.D.O.T. DISTRICT 2 SURVEY OFFICE

PERSONNEL _____

REFERENCE NO. 88

SHEET 44 OF 49

NOTES CHANEY

H.C. RIPPLE

R.C. BARBOUR

DATE 8-8-94

WEATHER FAIR

TEMP. +72°

ROUTE S.R. 105

COUNTY WOOD

TOWNSHIP FREEDOM

SECTION 2

T. 5 N R. 12 E


TYPE MONUMENT PK NAIL / WASHER

ON SURFACE - ~~BELOW~~ YES

LEFT - ~~C. PAV~~ T. - RIGHT YES 3.0' RT &

6.3' TO RT EDGE PAVEMENT


S.L.M. 586 + 79

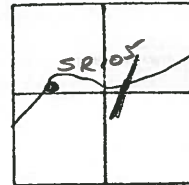

RECORD: P.I. #79
STA 588 + 26.58
Δ = 4° - 17' - 20" LT

Preventive Maintenance
 Chip & Seal 2004
 Existing Point Uncovered
 Date 08/10/04 MC

SET PK/WASHER
 11-17-94 MRC.

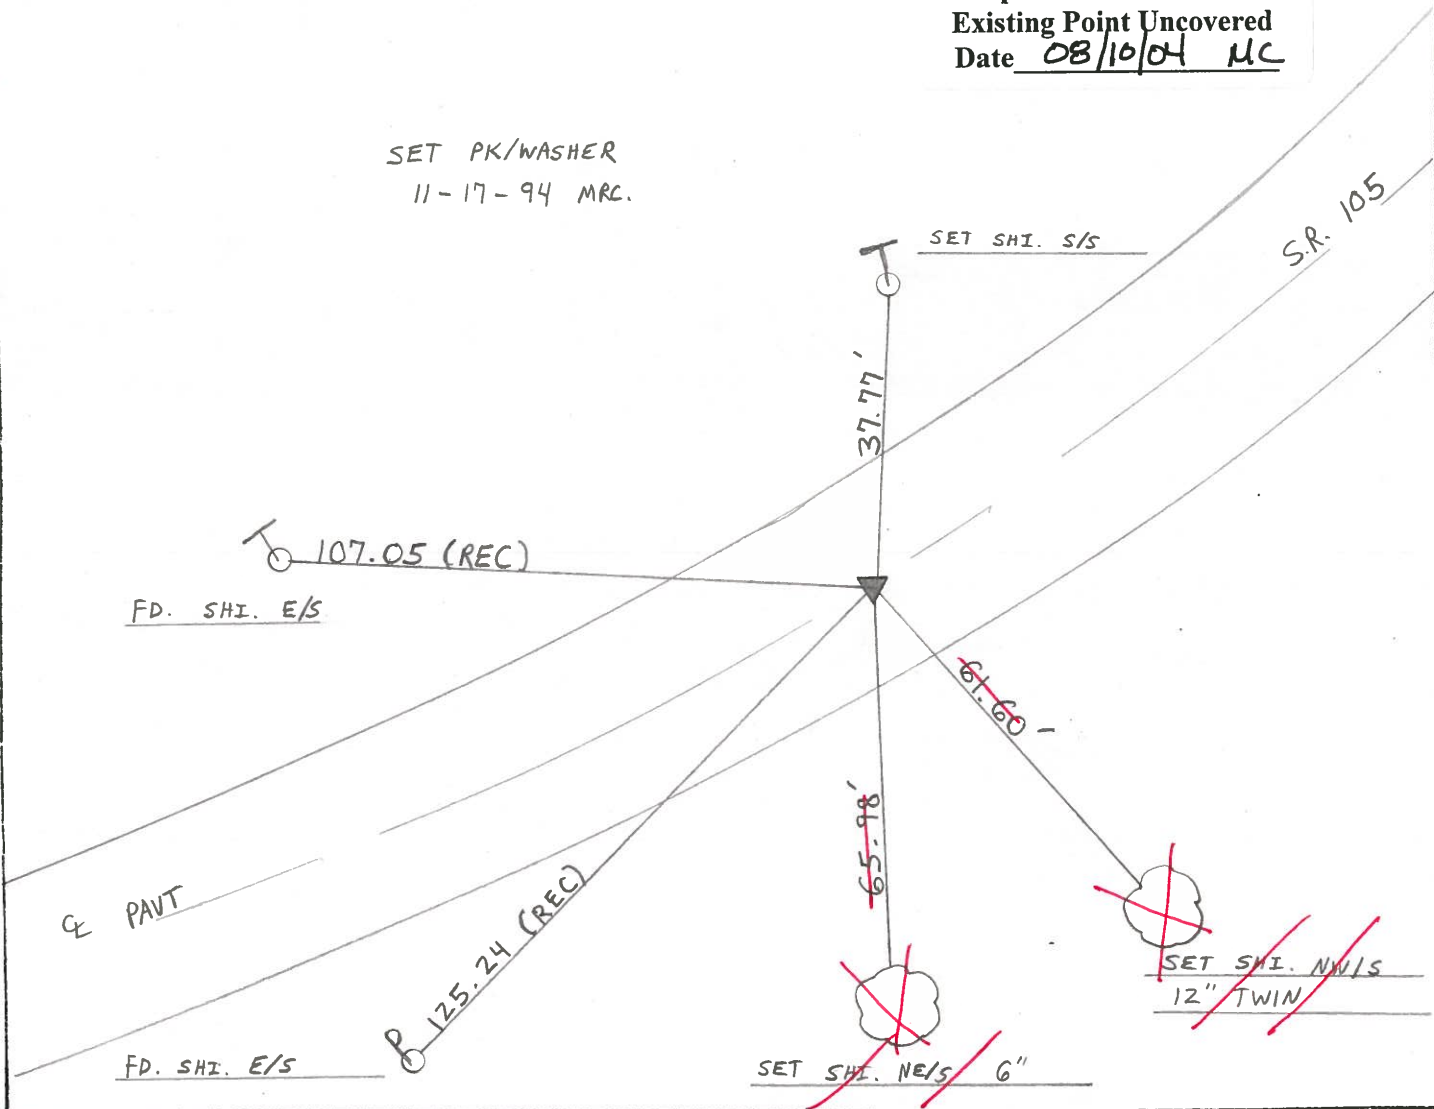

County WOOD S. R. 105

Township FREEDOM

Section 1

T&N, R1E

Personnel BARNHISEL HC

HOUSEHOLDER RC


LEHRKE TA

HOTTMAN P

Date 8-10-84

Weather CLEARING

Temp. +82

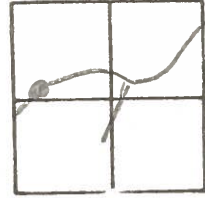

88

RECORD

588+26.58

PI # 79

$\Delta = 4^{\circ}-17'-20''$ Lt

Fd: Sm RR spike @ SURFACE

3.5 R to P & PAVT

6.1 to REP


14.1 LEP

SLM 584+80

SET P.K./WASHER

10-4-84

SW.H.

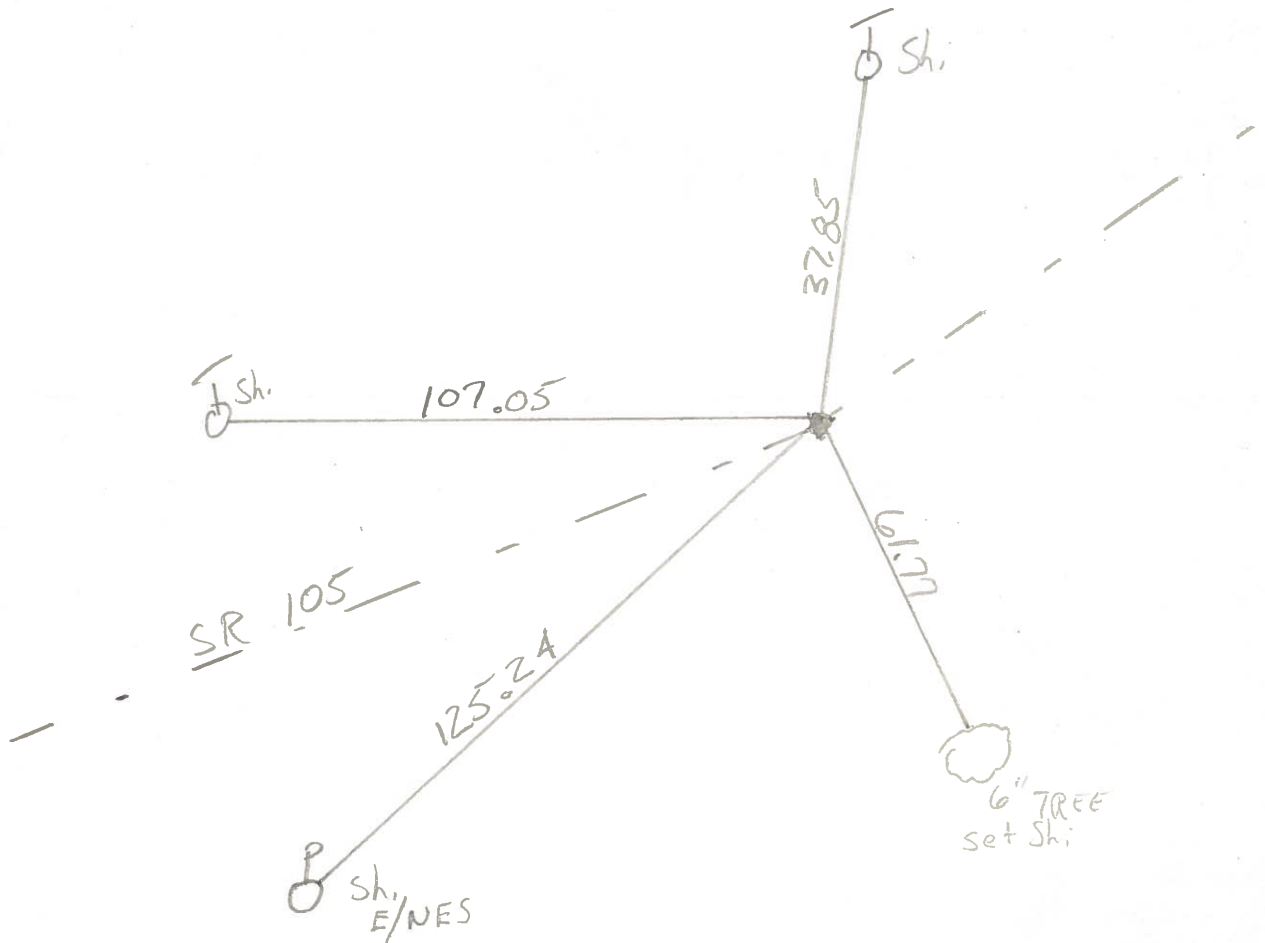

PERSONNEL TITLE PERSONNEL TITLE
Stone _____
Denno _____
Curtis _____

COUNTY Wood DATE Nov. 12, '74
 S. R. 105 WEATHER Cold
 SEC. _____ TEMP. 34°

DESCRIPTION References To Con + 1 Points JOB NO. _____

LEFT CENTER LINE RIGHT

