


O.D.O.T. DISTRICT 2 SURVEY OFFICE (USE ONLY)

PERSONNEL _____ REFERENCE NO. 92 SHEET 11 OF 13
 NOTES WESTFALL DATE 10-17-13 ROUTE SR 105
 H.C. LEU WEATHER CLOUDY COUNTY WOOD
 R.C. WESTFALL TEMP. 47°F TOWNSHIP FREEDOM
 _____ SECTION 1
 _____ T 5 N R 7 E

TYPE MONUMENT 5/8" IPIN
~~ON SURFACE~~ - BELOW 0.7'
~~LEFT~~ - CL PAV'T - RIGHT 56'
45' TO RT EDGE PAVEMENT
 S.L.M. 615+71.81
 Grid: Northing: 641194.5612 Easting: 1715332.6317

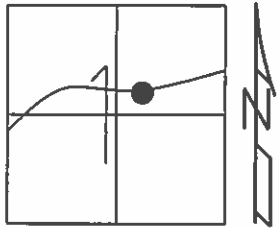


RECORD: STA 618+71.96
 P.I. #83
 $\Delta=46^{\circ}26'00''$ LT
 POINT LOCATED IN FIELD

FD IPIN
 11-17-94, MRC

GPS, REF92
 10-17-13, RJL

GPS, REF92
 7-27-15, JFO

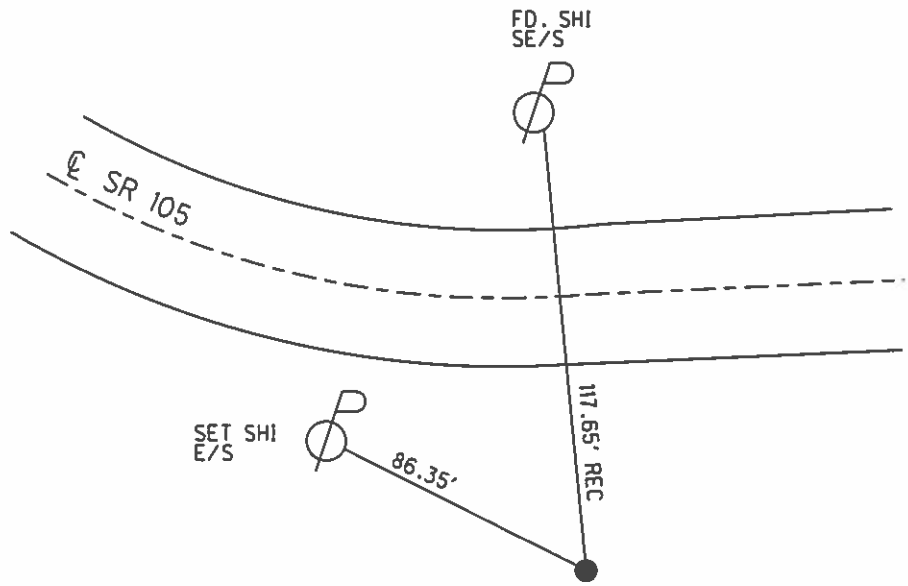

O.D.O.T. DISTRICT 2 SURVEY OFFICE

PERSONNEL

REFERENCE NO. 92

SHEET 48 OF 49

NOTES CHANEY

H.C. RIPPLE

R.C. BARBOUR

DATE 8-8-94

WEATHER FAIR

TEMP. +72°

ROUTE S.R. 105


COUNTY WOOD

TOWNSHIP FREEDOM

SECTION 1

T 5 N R 7 E

TYPE MONUMENT 5/8" IRON ROD
 ON SURFACE - BELOW 0.7' BENEATH GRADE
 LEFT - Q PAVT. - RIGHT 56' RT Q PAVT
45' TO RT EDGE PAVEMENT
 S.L.M. 617+00

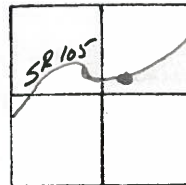


RECORD: STA 618+71.96 P.I. #83

$\Delta = 46^\circ - 26' - 00''$ LT.

POINT LOCATED IN FIELD.

ROD LOCATED W/ DETECTOR
 11-17-94. MRC.

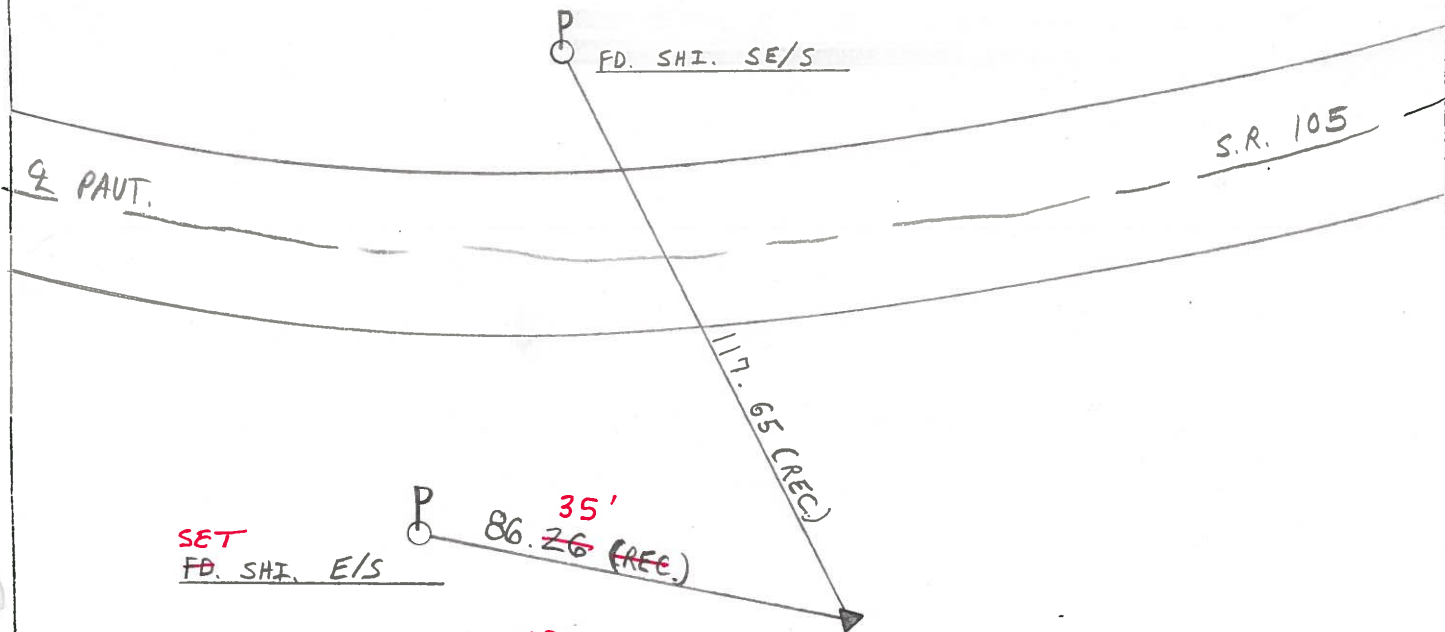

SET
 FD. SHI. E/S

REVISED
 06/01/04
 DH

County Wood S.R. 105

Date 8-10-84

Township FREEDOM


Weather RE CLOUDY

Section 1

Temp. + 83

T5N, R7E

Personnel	<u>BARNHISEZ</u>	<u>HC</u>
	<u>HOUSEHOLDER</u>	<u>RC</u>
	<u>LOEHRKE</u>	<u>CD</u>
	<u>HOFFMAN</u>	<u>P</u>

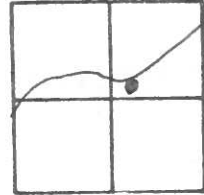

92


RECORD

W18+71.96

PI # 83

Δ = 46°-26' Lt

IRON Rod LOCATED w/ Detector
 47' RE of REP
 56' Rt of & PAUT
 SLM 614+92

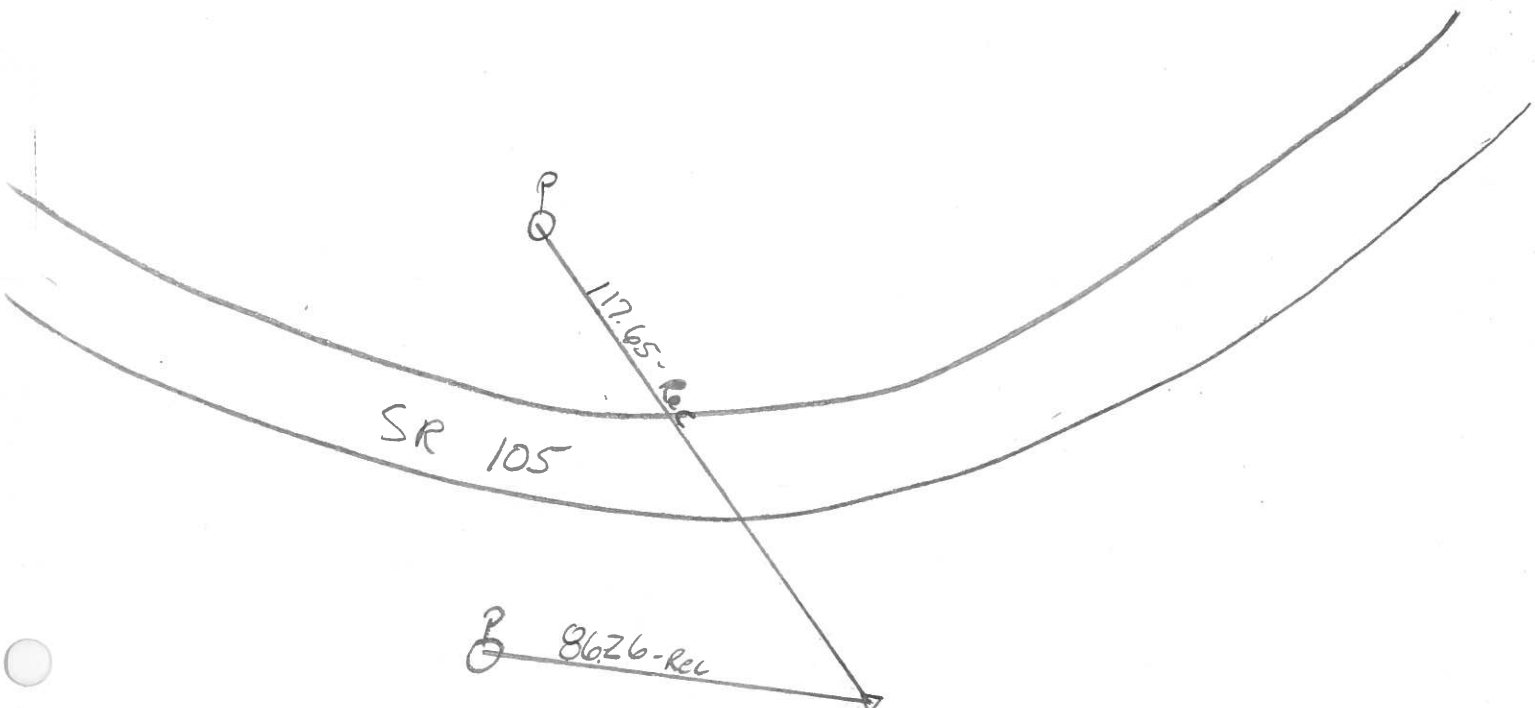

PERSONNEL	TITLE	PERSONNEL	TITLE	COUNTY	DATE
Stone				Wood	Mar 12, '74
Denno				S. R.	105
Curtis				WEATHER	cold
				SEC.	TEMP. 34°

DESCRIPTION References To Control Points JOB NO. _____

