


O.D.O.T. DISTRICT 2 SURVEY OFFICE (USE ONLY)

PERSONNEL	REFERENCE NO.	<u>94</u>	SHEET	<u>13</u>	OF	<u>13</u>
NOTES	<u>HUSS</u>	DATE	<u>4-20-12</u>	ROUTE	<u>SR 105</u>	
H.C.	<u>CANTERBURY</u>	WEATHER	<u>CLEAR</u>	COUNTY	<u>WOOD</u>	
R.C.	<u>HOMAN</u>	TEMP.	<u>62°F</u>	TOWNSHIP	<u>FREEDOM</u>	
				SECTION	<u>1</u>	
				T	<u>5</u>	R
					<u>N</u>	<u>12</u>
					<u>E</u>	

TYPE MONUMENT LG RR. SPIKE
~~ON SURFACE~~ - BELOW 0.3'
 LEFT - ☉ PAV'T - RIGHT ON
- TO - EDGE PAVEMENT
 S.L.M. 639+97.55

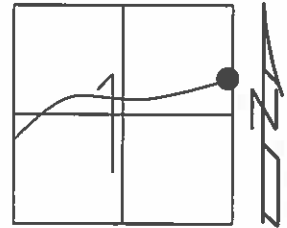

Grid: Northing: 642375.5228 Easting: 1717446.2929


SET SMALL R.R.SPIKE
6/15/90, DJC

NOTE: REF 49- US 23

FD SM.R.R.SPIKE
7/2/10
GPS, CP49
8/10/10, MC

SET MAG/WASHER
12/11/12, SAH
GPS, FIN49
3/13/13, MC

FD MAG/WASHER
REF 94
10/21/13, RJL

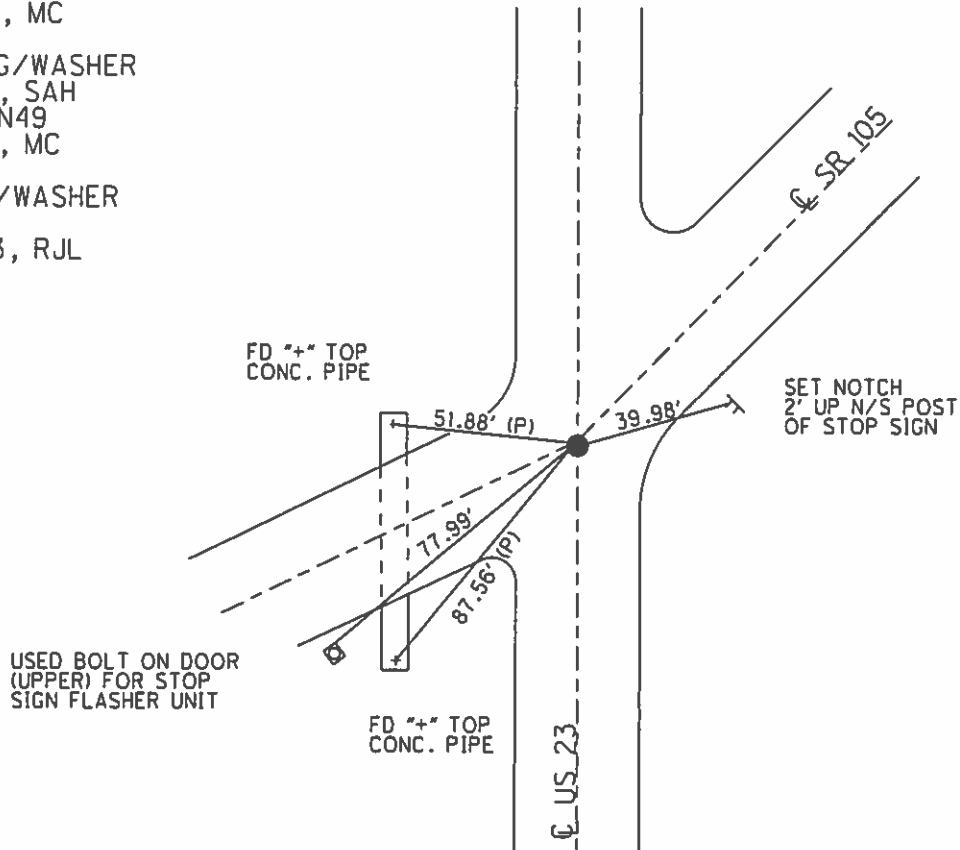

PERSONNEL	TITLE	PERSONNEL	TITLE	COUNTY	Wood	DATE	Nov. 12, '74
Stone				S. R.	105	WEATHER	Cold
Denno				SEC.		TEMP.	39°
Curtis				DESCRIPTION	References To Control	ts	JOB NO.
					LEFT	CENTER LINE	RIGHT

