

1988 TWO-LANE RESURFACING PROGRAM

PRIORITY NO. _____ PART _____ OF _____ SHEET _____ OF _____

COUNTY Wood ROUTE SR 163 SECTION 0.00

BEGIN LOG (SLM) 0.00 TERMINII US 20 0+65

END LOG (SLM) 4.85 TERMINII Ottawa Co. Line 25+91 / 255+62

TOTAL LENGTH 4.85 MILES See Back of sheet

MUNICIPALITY _____ BEGIN LOG (SLM) _____ END LOG (SLM) _____

MUNICIPALITY _____ BEGIN LOG (SLM) _____ END LOG (SLM) _____

PROPOSED WORK:
PAVEMENT 1 1/2" 404 SHOULDER 1 1/2" 404 & 617

OTHER Pavement Repair

EXISTING DATA:

SLM	<u>0.00</u>	TO	<u>2.29</u>	;	PAV'T	WIDTH	<u>19'</u>	(type	<u>404</u>	),	SHLD	WIDTH	<u>1 1/2'</u>	(type	<u>404</u>
SLM	<u>2.29</u>	TO	<u>2.82</u>	;	PAV'T	WIDTH	<u>20'</u>	(type	_____	),	SHLD	WIDTH	<u>1 1/2'</u>	(type	_____
SLM	<u>2.82</u>	TO	<u>3.56</u>	;	PAV'T	WIDTH	<u>19'</u>	(type	_____	),	SHLD	WIDTH	<u>1 1/2'</u>	(type	_____
SLM	<u>3.56</u>	TO	<u>4.25</u>	;	PAV'T	WIDTH	<u>21'</u>	(type	_____	),	SHLD	WIDTH	<u>2'</u>	(type	_____
SLM	<u>4.25</u>	TO	<u>4.85</u>	;	PAV'T	WIDTH	<u>19'</u>	(type	_____	),	SHLD	WIDTH	<u>2'</u>	(type	_____
SLM	_____	TO	_____	;	PAV'T	WIDTH	_____	(type	_____	),	SHLD	WIDTH	_____	(type	_____
SLM	_____	TO	_____	;	PAV'T	WIDTH	_____	(type	_____	),	SHLD	WIDTH	_____	(type	_____
STRUCTURES:

STR. NO.	<u>W00-163-0201</u>	Turnpike	WIDTH	_____	LENGTH	_____	PROP. WORK	_____
STR. NO.	<u>W00-163-0373</u>		WIDTH	_____	LENGTH	_____	PROP. WORK	_____
STR. NO.	<u>W00-163-0375</u>		WIDTH	_____	LENGTH	_____	PROP. WORK	_____
STR. NO.	<u>W00-163-0485</u>		WIDTH	_____	LENGTH	_____	PROP. WORK	_____
STR. NO.	_____		WIDTH	_____	LENGTH	_____	PROP. WORK	_____
STR. NO.	_____		WIDTH	_____	LENGTH	_____	PROP. WORK	_____

RAILROAD CROSSING:



NAME	<u>C&O</u>	STATION	<u>78+90</u>	NO. TRACKS	<u>2</u>	LENGTH ALONG C L	<u>23</u>	ft
NAME	<u>ConRail</u>	STATION	<u>233+12</u>	NO. TRACKS	<u>2</u>	LENGTH ALONG C L	<u>27</u>	ft
NAME	_____	STATION	_____	NO. TRACKS	_____	LENGTH ALONG C L	_____	ft

MISCELLANEOUS:



NO. RAISED PAVEMENT MARKERS; EDGE OF PAVEMENT 132, CENTERLINE 547

NO. MAILBOX APPROACHES _____, AVERAGE AREA _____

REMARKS:

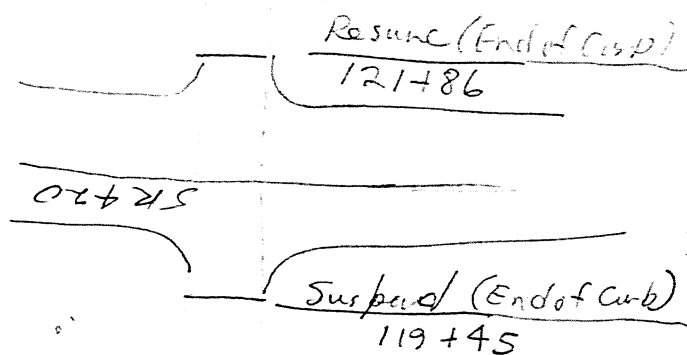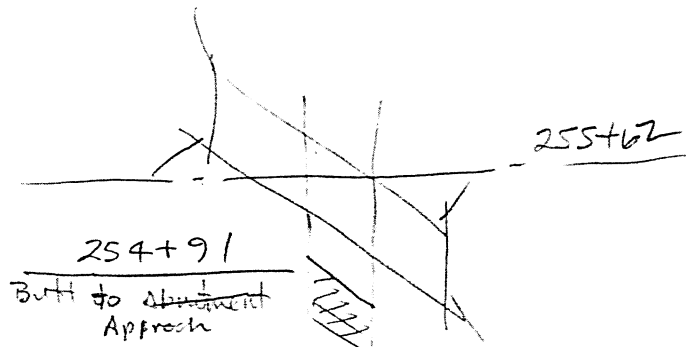

SR 420

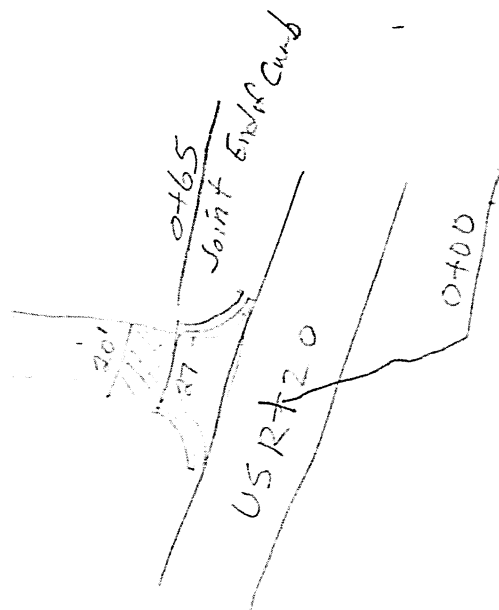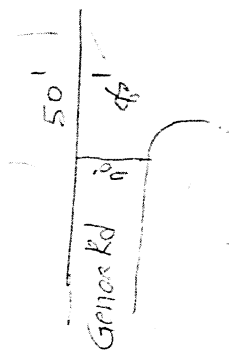

COUNTY _____ ROUTE _____ SECTION _____

[illegible]

Side	End	Begin	Width
Lt.	253+91	- 252+95	3'
Rt.	248+49	- 247+54	3'
Rt.	244+95	- 242+80	3'
Rt.	236+54	- 235+38	2'
Rt.	230+77	- 230+35	3'
Rt.	229+98	- 229+02	4'
Rt.	228+50	- 228+16	2'
Rt.	226+62	- 225+66	3'
Lt.	225+66	- 224+94	2'
Rt.	224+94	- 222+30	2'
Rt.	217+59	- 217+36	2'
Rt.	215+60	- 214+96	2'
Lt.	140+01	- 139+59	4'
Lt.	138+25	- 135+91	3'
Lt.	131+68	- 130+93	5'
Rt.	118+79	- 117+64	6'
Rt.	117+64	- 115+15	4'
Lt.	116+41	- 115+33	6'
Lt.	97+44	- 97+23	4'
Lt.	70+00	- 69+64	4'
Lt.	32+68	- 32+27	2'
Lt.	28+94	- 28+41	4'
Lt.	24+69	- 24+26	4'
Rt.	9+70	- 8+68	3'
Rt.			

Reinment Repair

W000 - 163 - 0.00