



O.D.O.T. DISTRICT 2 SURVEY OFFICE (USE ONLY)

PERSONNEL _____ REFERENCE NO. 1 C SHEET 6 OF 21
 NOTES ASTON DATE 10/12/23 ROUTE SR 163
 H.C. NIESE WEATHER CLOUDY COUNTY WOOD
 R.C. ASTON TEMP. 60° TOWNSHIP LAKE
 DWG BY ASTON PID CHIP SEAL SECTION 32
 T 7 N R 12 E

TYPE MONUMENT MAG/WASHER
 ON SURFACE - ~~BELOW~~ ON
 OFFSET Q PAVEMENT 8.8' LT : ~~RT~~
3.8' TO LT EDGE PAVEMENT
 STATION: 30+08

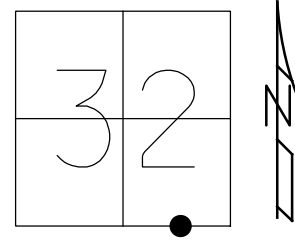

HORZ.DATUM: NAD83(2011) GEOID: NAVD88 2018
 GRID: NORTHING: 674862.114 EASTING: 1695624.792

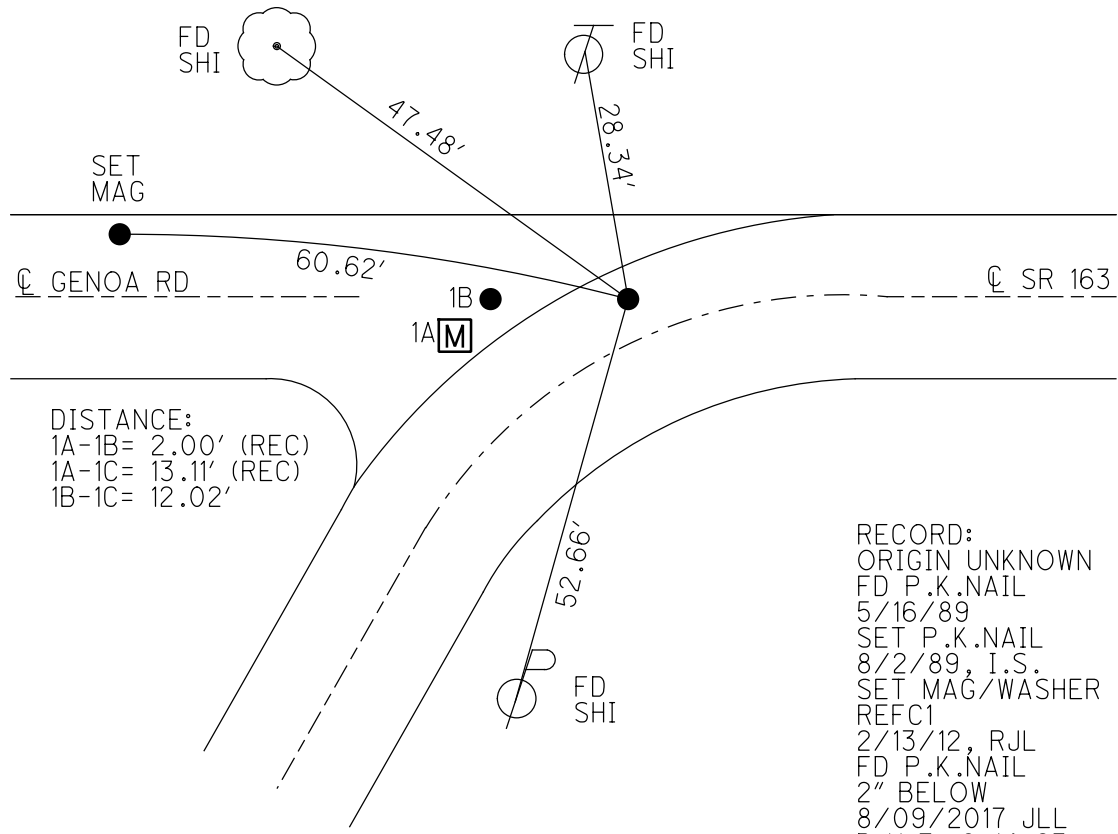


DISTANCE:
 1A-1B= 2.00' (REC)
 1A-1C= 13.11' (REC)
 1B-1C= 12.02'

RECORD:
 ORIGIN UNKNOWN
 FD P.K.NAIL
 5/16/89
 SET P.K.NAIL
 8/2/89, I.S.
 SET MAG/WASHER
 REFC1
 2/13/12, RJL
 FD P.K.NAIL
 2" BELOW
 8/09/2017 JLL
 D.N.F., 6-14-23
 SET MAG/ WASHER
 10-12-23, TDN

O.D.O.T. DISTRICT 2 SURVEY OFFICE (USE ONLY)


PERSONNEL _____ REFERENCE NO. 1C SHEET 2 OF 2
 NOTES O'DONNELL DATE 08/09/2017 ROUTE SR 163
 H.C. LEU WEATHER SUNNY COUNTY WOOD
 R.C. HOMAN TEMP. 73° TOWNSHIP LAKE
 _____ SECTION 32
 _____ T 7 N R 12 E

TYPE MONUMENT FD. P.K.NAIL
 ON SURFACE - ~~BELOW~~ 2" BELOW
 LEFT - ☐ PAV'T - ~~RIGHT~~ 8.8'
3.8' TO LT EDGE PAVEMENT
 S.L.M. 30+08

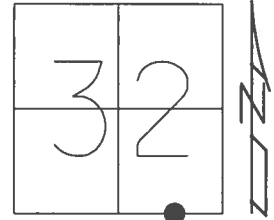

Grid: Northing: 674862.114 Easting: 1695624.792

DISTANCE:
 1A-1B= 2.00' (REC)
 1A-1C= 13.11' (REC)
 1B-1C= 12.02'

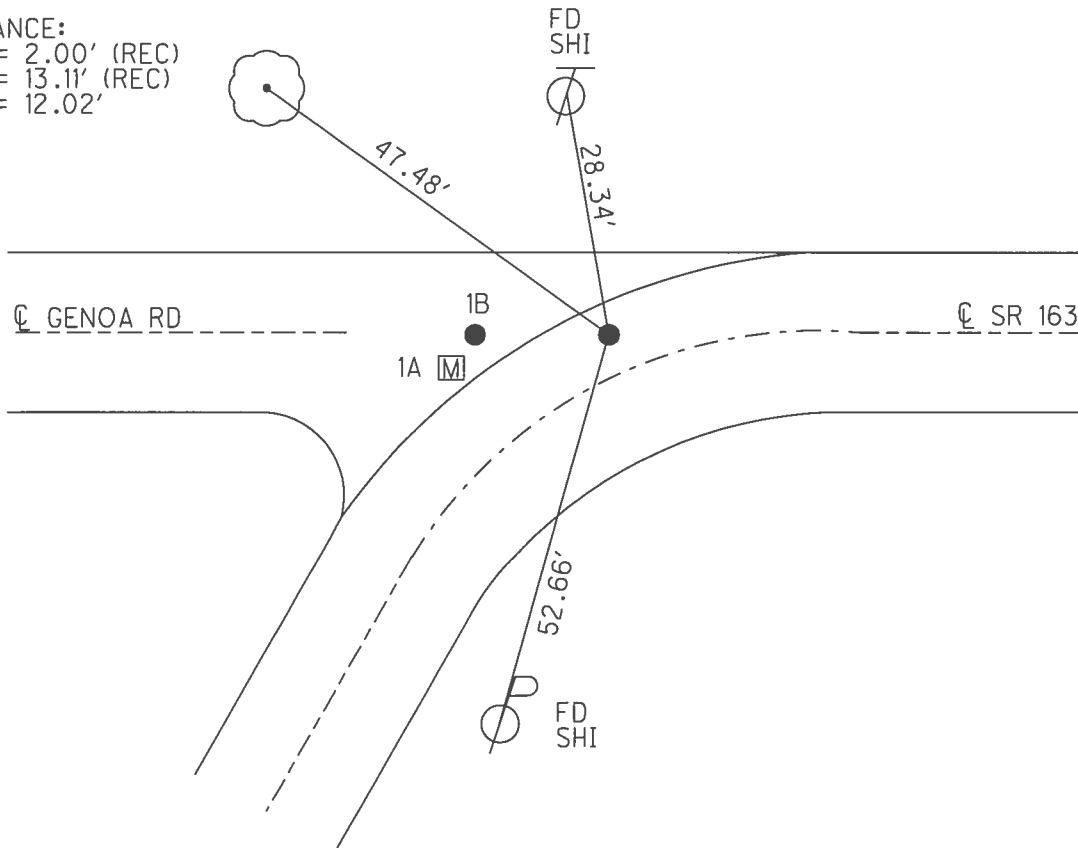


RECORD:
 ORIGIN UNKNOWN
 FD P.K.NAIL
 5/16/89
 SET P.K.NAIL
 8/2/89, I.S.
 RESET MAG/WASHER
 W/TIES. GPS, REFC1
 2/13/12, RJL

RECORD:
 FD. PK NAIL 2" BELOW
 DUG 4"
 NO EVIDENCE OF
 ANYTHING METAL BELOW
 08/09/2017 JLL


O.D.O.T. DISTRICT 2 SURVEY OFFICE (USE ONLY)

PERSONNEL _____ REFERENCE NO. 1 C SHEET 6 OF 21
 NOTES CODER _____ DATE 7/30/13 ROUTE SR 163
 H.C. ROUSOS WEATHER CLEAR COUNTY WOOD
 R.C. RHOADES TEMP. 78° TOWNSHIP LAKE
 _____ WESTFALL _____ SECTION 32
 _____ T 7 N R 12 E

TYPE MONUMENT P.K.NAIL
 ON SURFACE - ~~BELOW~~ ON _____
 LEFT - ☉ PAV'T - ~~RIGHT~~ 8.8'
3.8' TO LT EDGE PAVEMENT
 S.L.M. 30+08

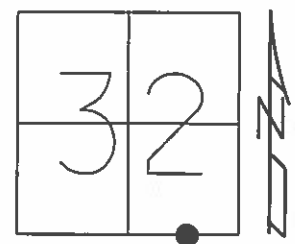

Grid: Northing: 674862.114 Easting: 1695624.792

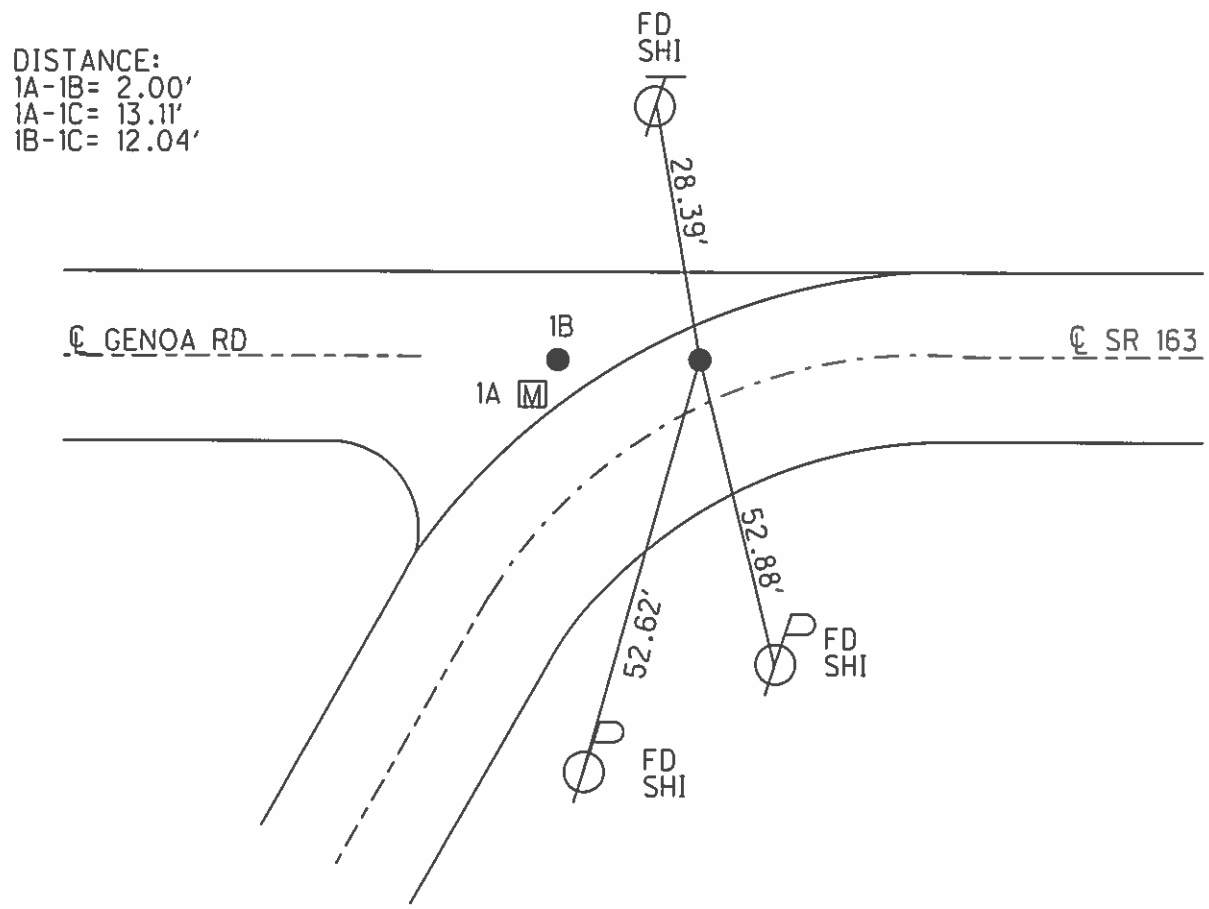

RECORD:
 ORIGIN UNKNOWN
 FD P.K.NAIL
 5/16/89
 SET P.K.NAIL
 8/2/89, I.S.
 RESET MAG/WASHER
 W/TIES. GPS, REFC1
 2/13/12, RJL

O.D.O.T. DISTRICT 2 SURVEY OFFICE

PERSONNEL _____

REFERENCE NO. 1

SHEET 3 OF 14

NOTES 1. Stone

H.C. D. Curtis

DATE 16 May 89

ROUTE SR#163

R.C. J. Householder

WEATHER Cloudy

COUNTY Wood

TEMP. 55°

TOWNSHIP Lake

SECTION 32

T _____ R _____


TYPE MONUMENT Ⓐ = Boat Spk.
Ⓑ = PK Nail
Ⓒ = PK Nail

ON SURFACE - BELOW Surface


LEFT- & PAV'T. - RIGHT _____

_____ TO _____ EDGE PAVEMENT

S.L.M. 30+03

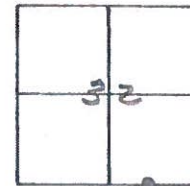

SET BOAT SPK. @ Ⓐ
SET P.K. NAILS AT Ⓑ & Ⓒ
8-2-89

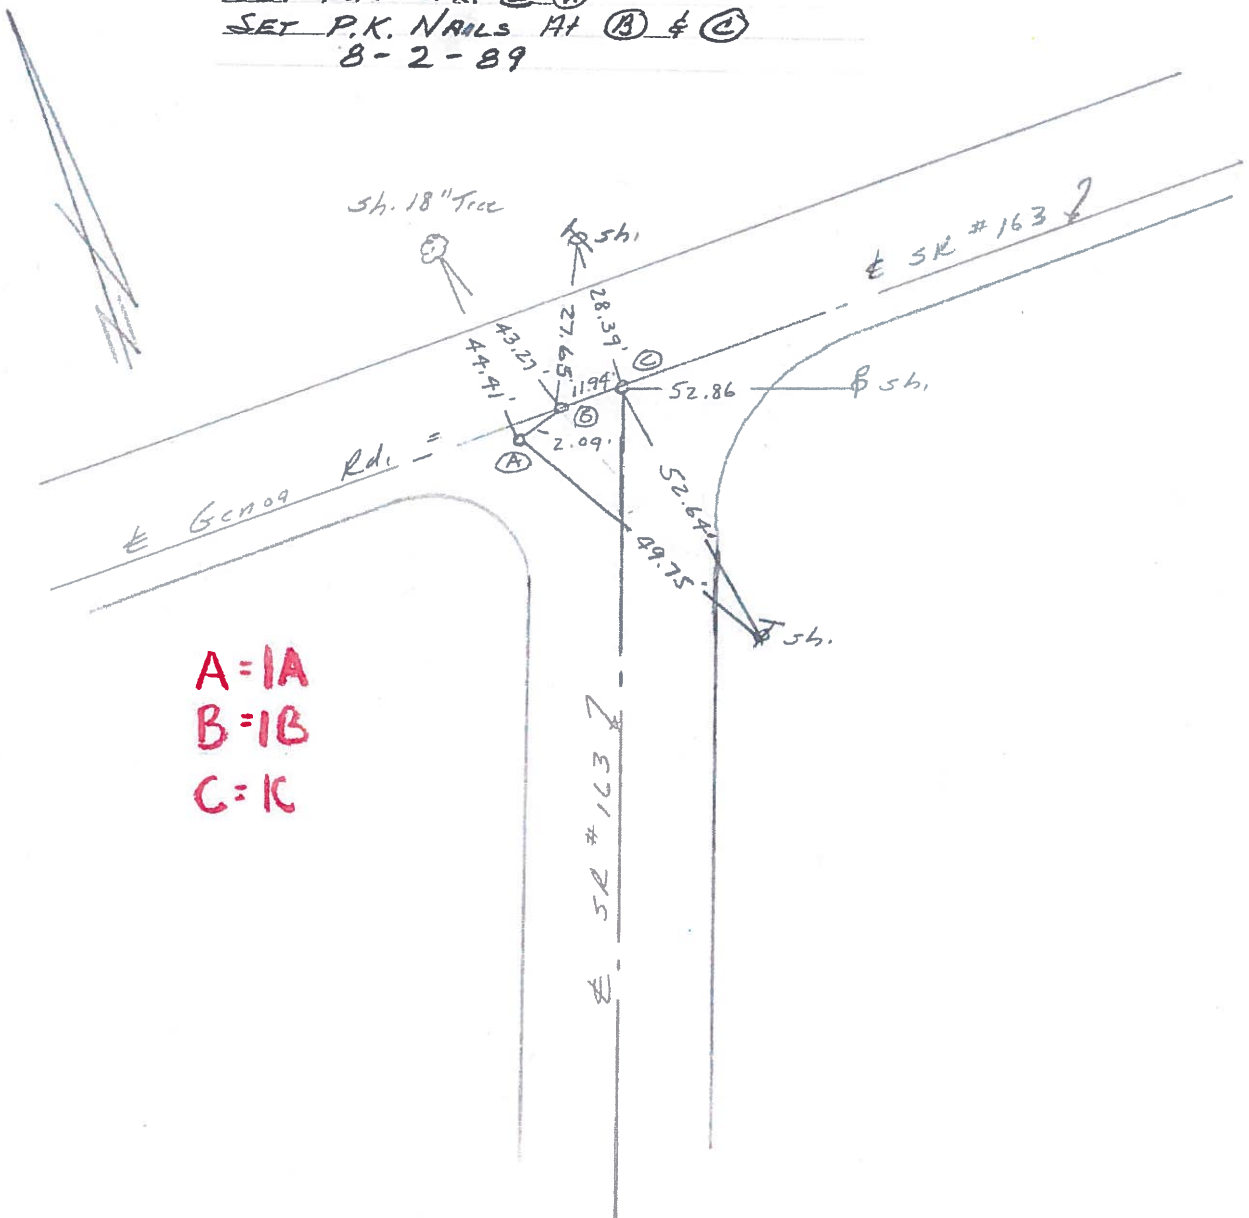

A = 1A
B = 1B
C = 1C