


O.D.O.T. DISTRICT 2 SURVEY OFFICE (USE ONLY)


PERSONNEL _____ REFERENCE NO. 2 A SHEET 2 OF 5
 NOTES LOEHRKE DATE 11/13/96 ROUTE SR 420
 H.C. ROUSOS WEATHER FAIR COUNTY WOOD
 R.C. CANTERBURY TEMP. 30° TOWNSHIP LAKE
 _____ SECTION 34
 _____ T 7 N R 12 E

TYPE MONUMENT MONBOX
 ON SURFACE - ~~BELOW~~ ON
 LEFT - ☉ PAV'T - RIGHT ON
- TO - EDGE PAVEMENT
 S.L.M. 122+25.59

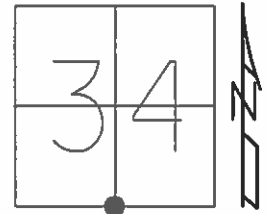

Grid: Northing: 674803.550 Easting: 1704684.270


FD MONBOX 2A
 1/10/12, RJL
 6/25/14, DCH
 SR 163 STA. 120+68.17
 GPS, REFB7, REFA2

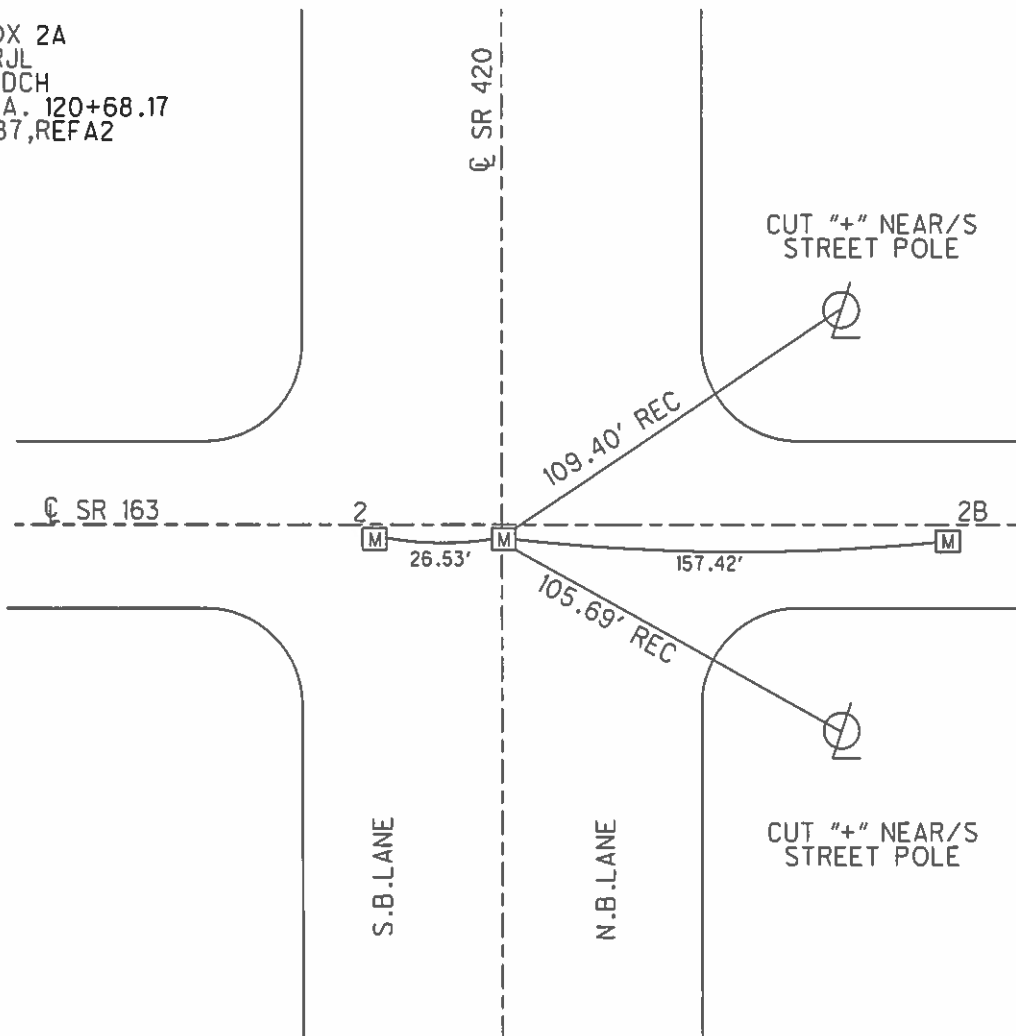


O.D.O.T. DISTRICT 2 SURVEY OFFICE (USE ONLY)

PERSONNEL _____ REFERENCE NO. 8 SHEET 15 OF 21
 NOTES RHOADES DATE 8/5/13 ROUTE SR 163
 H.C. CODER WEATHER FAIR COUNTY WOOD
 R.C. RHOADES TEMP. 74° TOWNSHIP LAKE
 _____ SECTION 34
 _____ T 7 N R 12 E

TYPE MONUMENT MONBOX
 ON SURFACE - ~~BELOW~~ ON
~~LEFT~~ - ℄ PAV'T - RIGHT 3.8'
TO EDGE PAVEMENT
 S.L.M. 122+25.59
 Grid: Northing: 674802.665 Easting: 1704841.555

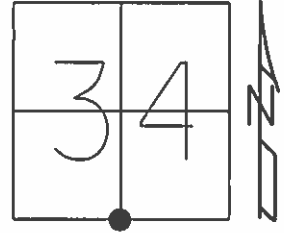

RECORD:
 FD MONBOX
 5/17/89
 MONBOX WAS
 NOT RAISED
 8/2/89, IS
 FD MONBOX
 W- 3/4" IPIN
 GPS, REF8
 1/10/12, RJL

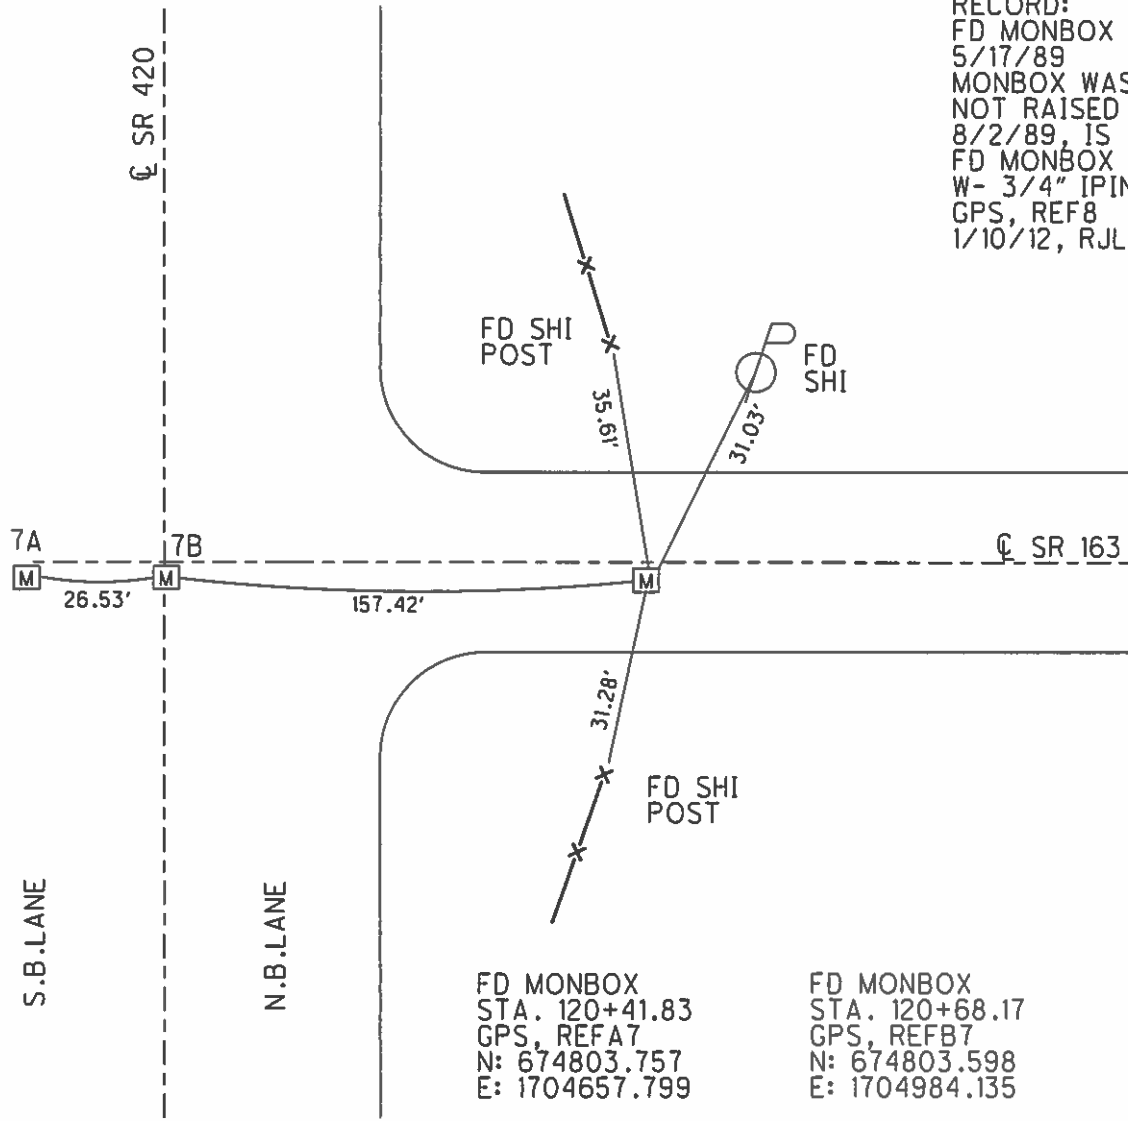

FD MONBOX
 STA. 120+41.83
 GPS, REF A7
 N: 674803.757
 E: 1704657.799

FD MONBOX
 STA. 120+68.17
 GPS, REF B7
 N: 674803.598
 E: 1704984.135