

WEBSTER TWP.  
SEC. 36 T.6N, R.11E.



TOTAL NUMBER OF  
 3 OWNERSHIPS  
 0 TOTAL TAKES  
 0 OWNERSHIPS WITH STRUCTURES INVOLVED  
 0 OWNERSHIPS WITH "P" ITEMS

PAR. NO.	OWNER	RECORDED		DEED AREA	TOTAL ACRES	GROSS TAKE	P.R.O. IN TAKE	NET TAKE		NET RES-IDUE	TYPE FUND	REMARKS	AS ACQUIRED	
		VOLUME	PAGE					ACRES	SQ. FT.				BLDG.	ACRES
1	JOSEPH F. BURKHOLDER	532	629	42.93	1.037	0.107	0.058	0.049	2125	No			614	915
1-T	ISABELLE M. BURKHOLDER							0.037	1600	No	to grade slopes & const. drive			
2	MARION H. and ETHEL D. HASEL	462	81	118.10	0.837	0.030	0.018	0.012	534	No			612	762
3	ARNOLD and ADELINA PIERCE	449	146	1.90	0.200	0.038	0.023	0.015	666	No			613	23




F.H.W.A. REGION	STATE	PROJECT
5	OHIO	02028(0)

15  
15  
1  
1

W00-199-21.31  
WOOD COUNTY  
RIGHT-OF-WAY PLAN

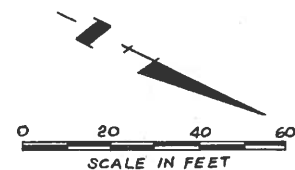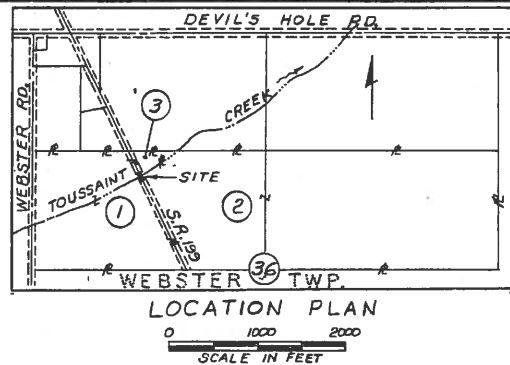

JOSEPH F. BURKHOLDER &  
ISABELLE M. BURKHOLDER  
42.93 Ac.

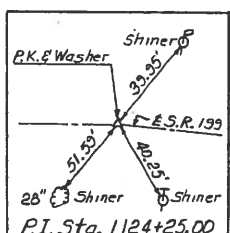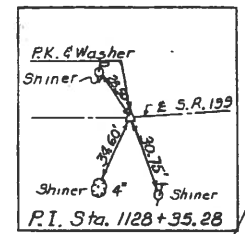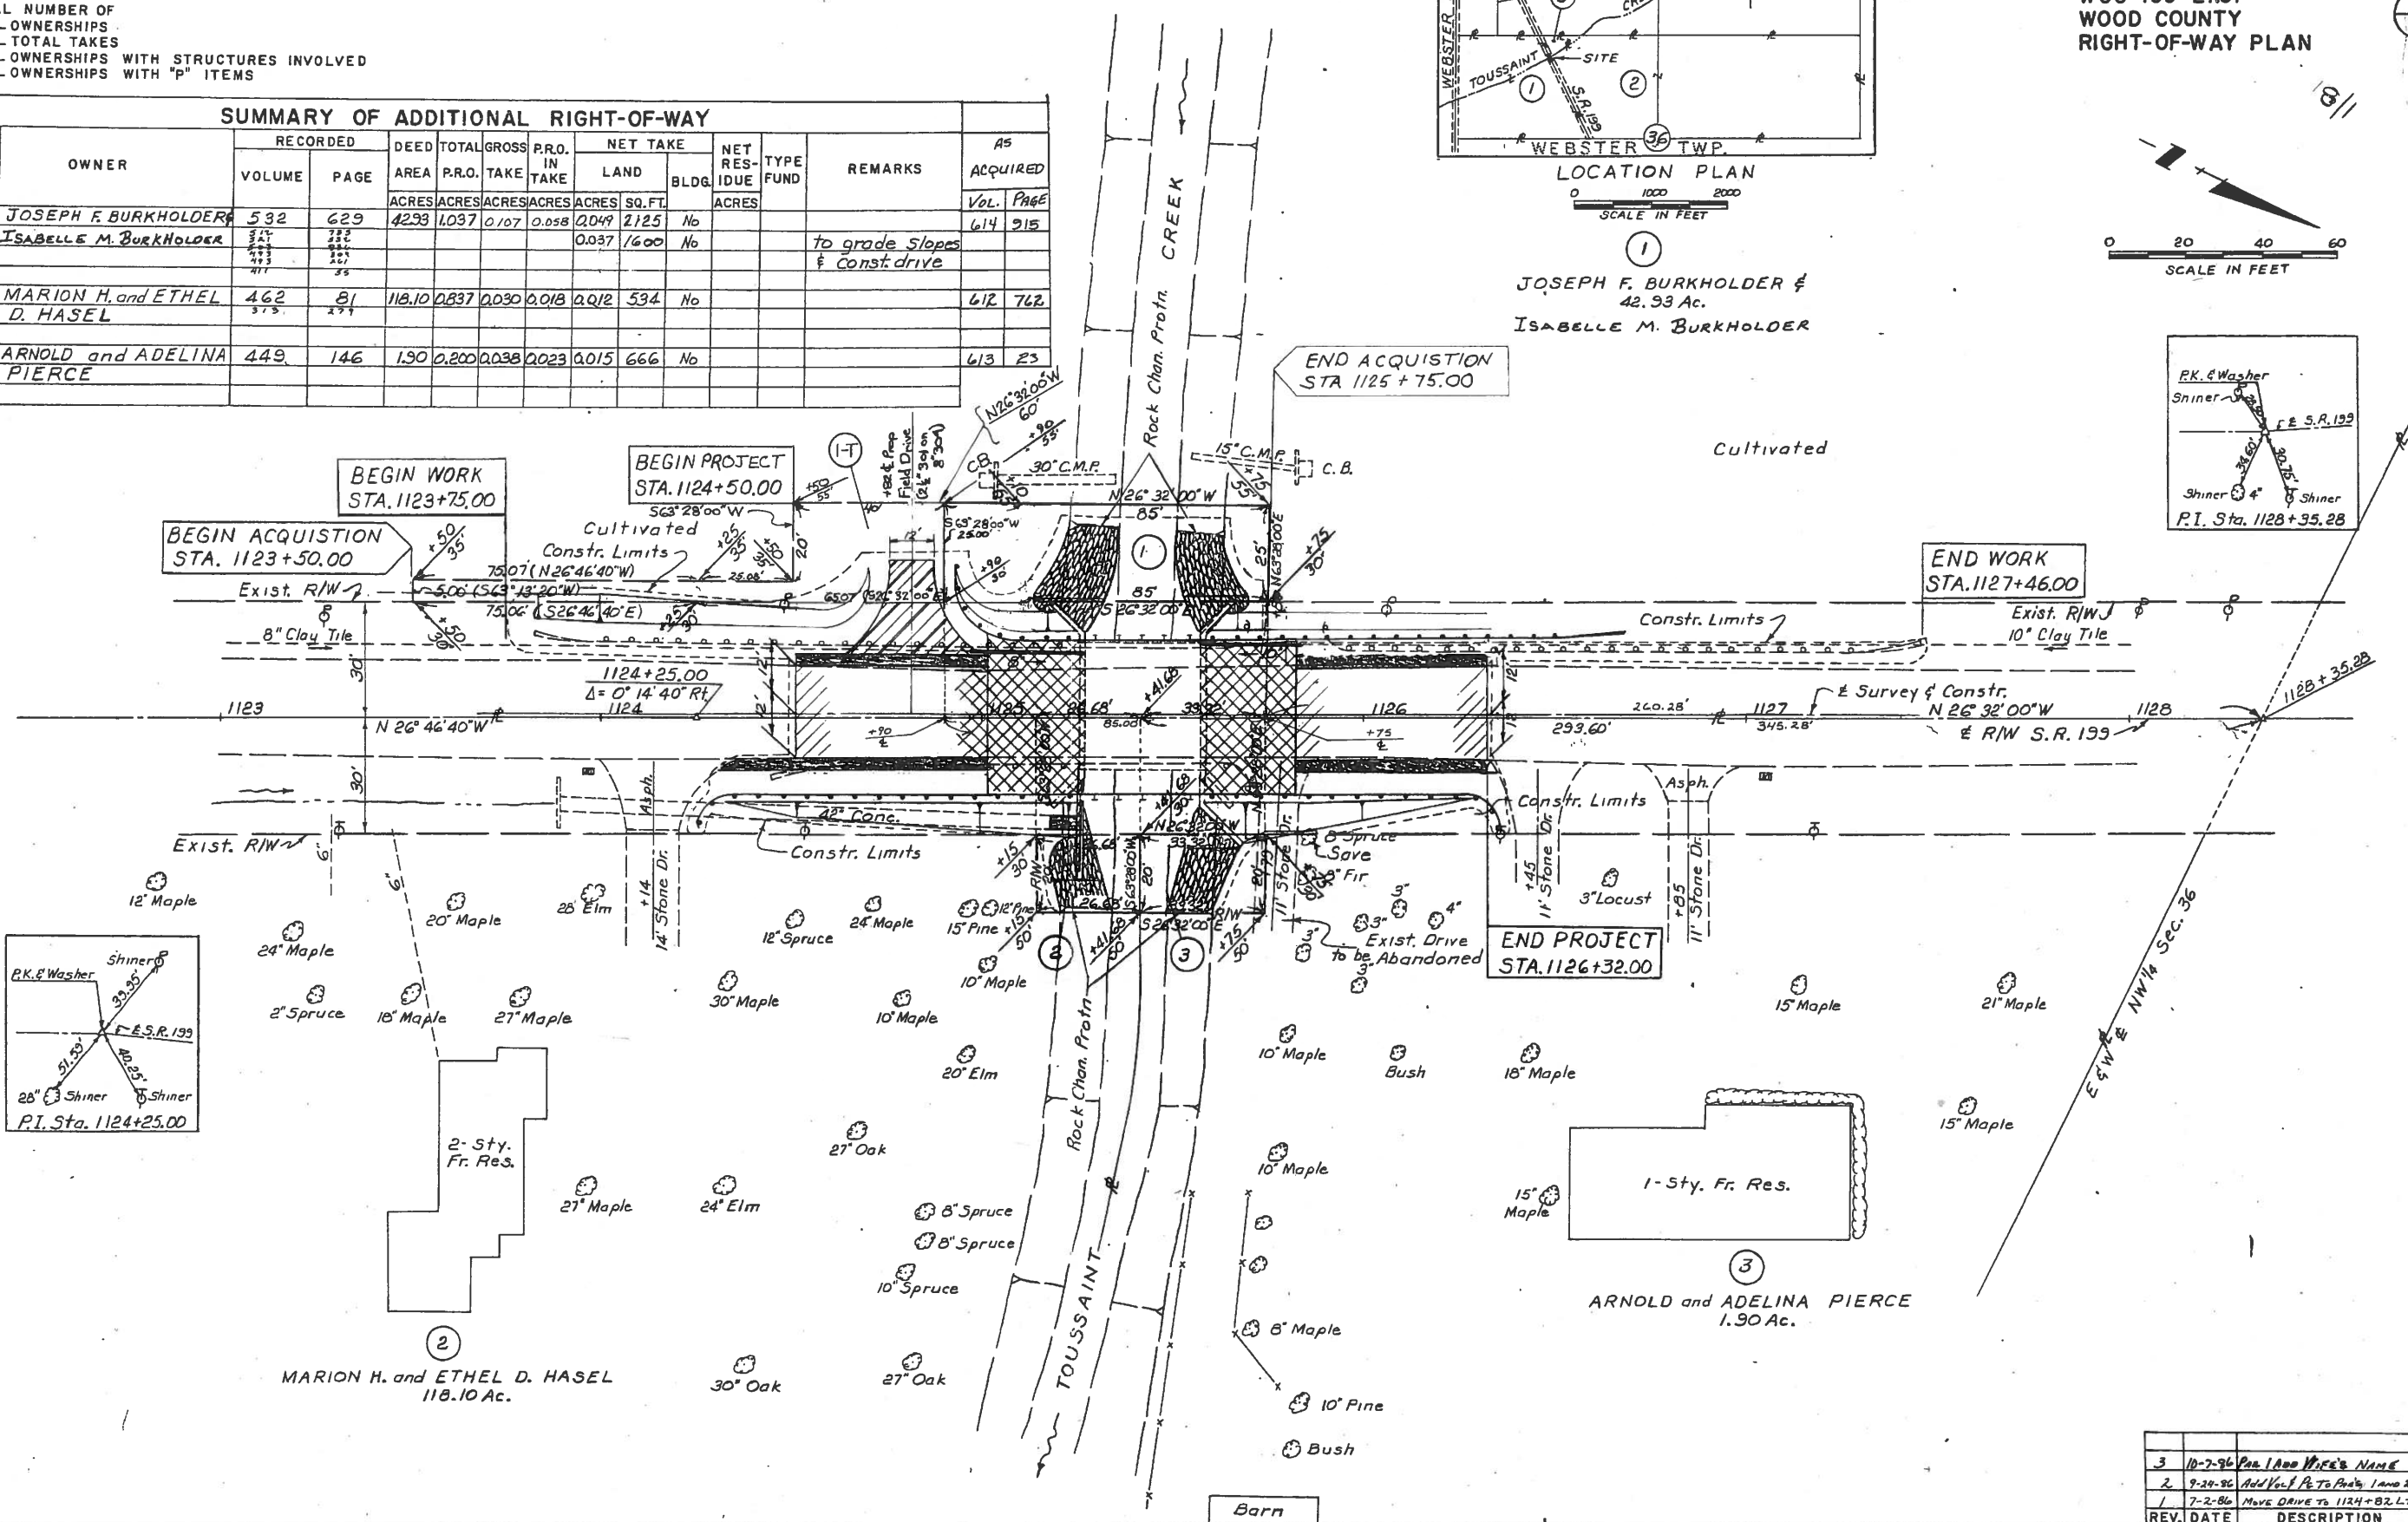

REV.	DATE	DESCRIPTION
3	10-7-96	Per 1 Add Wife's Name
2	9-28-86	Add Vol. P to Prop. Land 2
1	7-2-80	MOVE DRIVE TO 1124+82 LT.