

TO OPERATION 11-30-88
1990 TWO-LANE RESURFACING PROGRAM

PRIORITY NO. _____ PART 2 OF 2 SHEET _____ OF _____

COUNTY WOOD ROUTE SR 199 SECTION 29.55

BEGIN LOG (SLM) 29.55 TERMINII USR 20 ^{HES Project Limits} 1611 + 98.40 = (Calc) South Boundary

END LOG (SLM) 30.53 TERMINII USR 20 1611 + 88.0 = (Meas)

TOTAL LENGTH 0.98 MILES

MUNICIPALITY Perrysburg BEGIN LOG (SLM) 29.55 END LOG (SLM) 30.53

MUNICIPALITY _____ BEGIN LOG (SLM) _____ END LOG (SLM) _____

PROPOSED WORK:
PAVEMENT 1 1/2" 404 SHOULDER curb

OTHER Mill 1 1/2"

EXISTING DATA: SEE ADJACENT SHEET #1-P

SLM	TO	PAV'T	WIDTH	(type)	SHLD	WIDTH	(type)
SLM	TO	PAV'T	WIDTH	(type)	SHLD	WIDTH	(type)
STRUCTURES:

STR. NO.	WIDTH	LENGTH	PROP. WORK
STR. NO. <u>None</u>	WIDTH	LENGTH	PROP. WORK
STR. NO.	WIDTH	LENGTH	PROP. WORK
STR. NO.	WIDTH	LENGTH	PROP. WORK
RAILROAD CROSSING:

NAME	STATION	NO. TRACKS	LENGTH ALONG C L	(no work)
NAME <u>None</u>	STATION	NO. TRACKS	LENGTH ALONG C L	ft
NAME	STATION	NO. TRACKS	LENGTH ALONG C L	ft
NAME	STATION	NO. TRACKS	LENGTH ALONG C L	ft

MISCELLANEOUS:

NO. RAISED PAVEMENT MARKERS; EDGE OF PAVEMENT None, CENTERLINE None

NO. MAILBOX APPROACHES None, MAILBOX SUPPORTS None

REMARKS: According to S.L.M. Log, South Boundary = 29.65 1 cal-
culated Sta. 1565+52 for this point. Measured 1565+24.
Measurement from H.E.S. project limits for this point = 1565+31.6

PERSONNEL

TITLE

PERSONNEL

TITLE

COUNTY WoodDATE 28 Nov. 88S. R. #199

WEATHER

SEC. 29.65 - 30.53TEMP. 30°

DESCRIPTION


Pavement widths

JOB NO.

LEFT

CENTER LINE

RIGHT

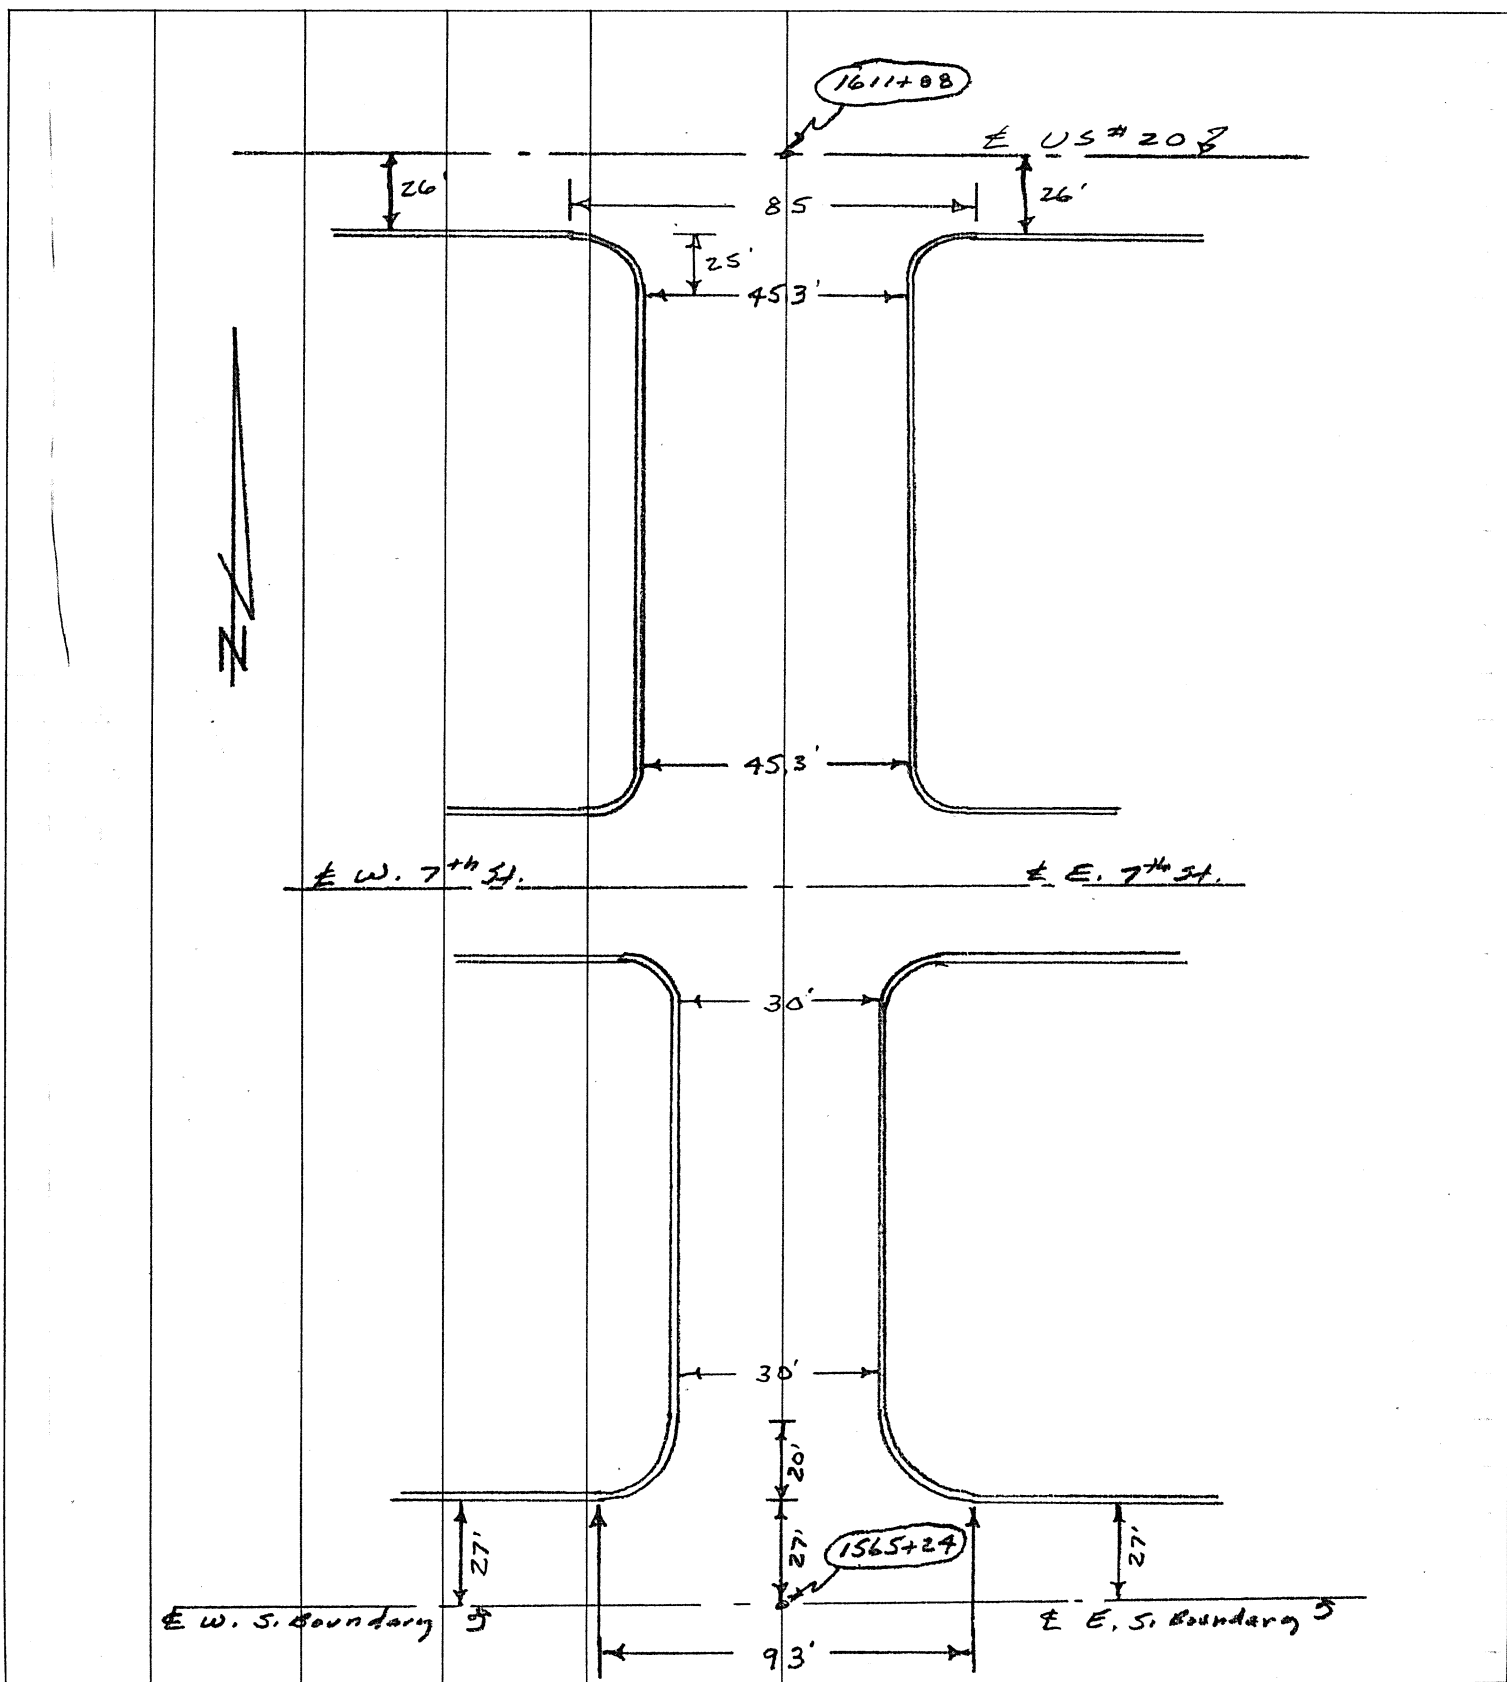

APPROACHES (INTERSECTIONS & DRIVES)

COUNTY Wood

ROUTE 507 199

SECTION 29.65-30.53

L = Prop Pav't Depth (in.) x 10; W = Width @ Mouth; W-1 = Width @ Throat

[illegible]

1990 TWO-LANE RESURFACING PROGRAM

SHEET OF

UTILITIES (Catch Basin, Manhole, Inlet, Watervalue Box and Monument Box)

COUNTY Wood

ROUTE 50th 199

SECTION 29,65-30.53

R = Raise F = Feather

[illegible]