


O.D.O.T. DISTRICT 2 SURVEY OFFICE (USE ONLY)

PERSONNEL _____ REFERENCE NO. 2 SHEET 2 OF 24
 NOTES RHOADES DATE 5-6-13 ROUTE SR 199
 H.C. CODER WEATHER CLOUDY COUNTY WOOD
 R.C. ROUSOS TEMP. 55° TOWNSHIP PERRY
 SECTION 36
 T 3 N R 12 E


TYPE MONUMENT P.K./WASHER
 ON SURFACE - ~~BELOW~~ ON
 LEFT - C PAV'T - ~~RIGHT~~ 2.8
10.3 TO LT EDGE PAVEMENT
 S.L.M. 30+81.57

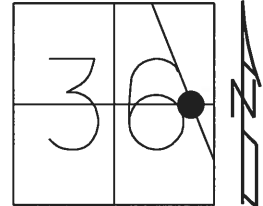

Grid: Northing: 550526.984 Easting: 1714261.482

RECORD: P.I.
 STA 29+0.16
 $\Delta = 0^{\circ} 00' 22.5''$ RT
 FD SM.R.R.SPIKE
 7/14/88, CL
 SET P.K./WASHER
 7/30/90, CL
 FD P.K./WASHER
 REF2
 10/12/11, MC
 SET MAG/WASHER
 FINREF2
 4/28/14, TMR

DIST 2-2A = 19.69'

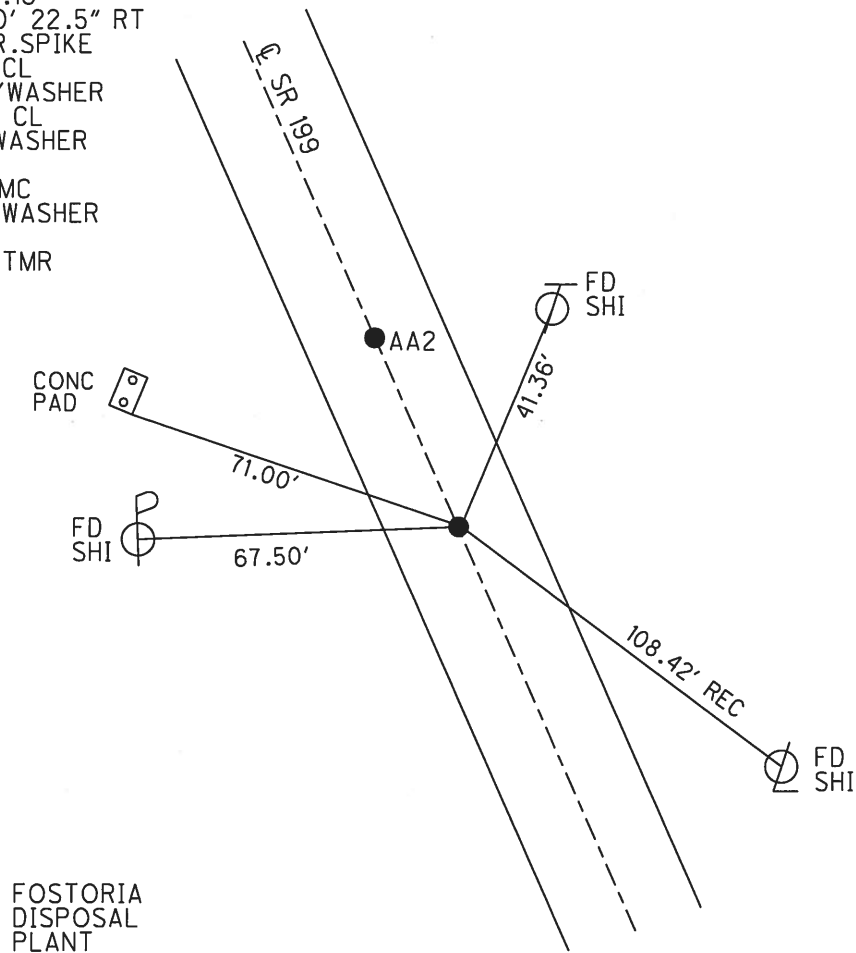

O.D.O.T. DISTRICT 2 SURVEY OFFICE

PERSONNEL _____

REFERENCE NO. 2

SHEET _____ OF _____

NOTES LOEHRKE

H.C. BARNHISEL

R.C. REED

DATE 7-14-88

WEATHER Pt Cloudy Hazy

TEMP. +85

ROUTE 199

COUNTY WOOD

TOWNSHIP PERRY

SECTION 36

T3 N R 12 E

TYPE MONUMENT Sm RR Spikes



ON SURFACE - BELOW

LEFT- ☉ PAV'T. - RIGHT 2.8

10.3 TO LT EDGE PAVEMENT

S.L.M. ZB+80 & ZB+99

Set P.K.'s/WASHERS
7-30-90
C.L.

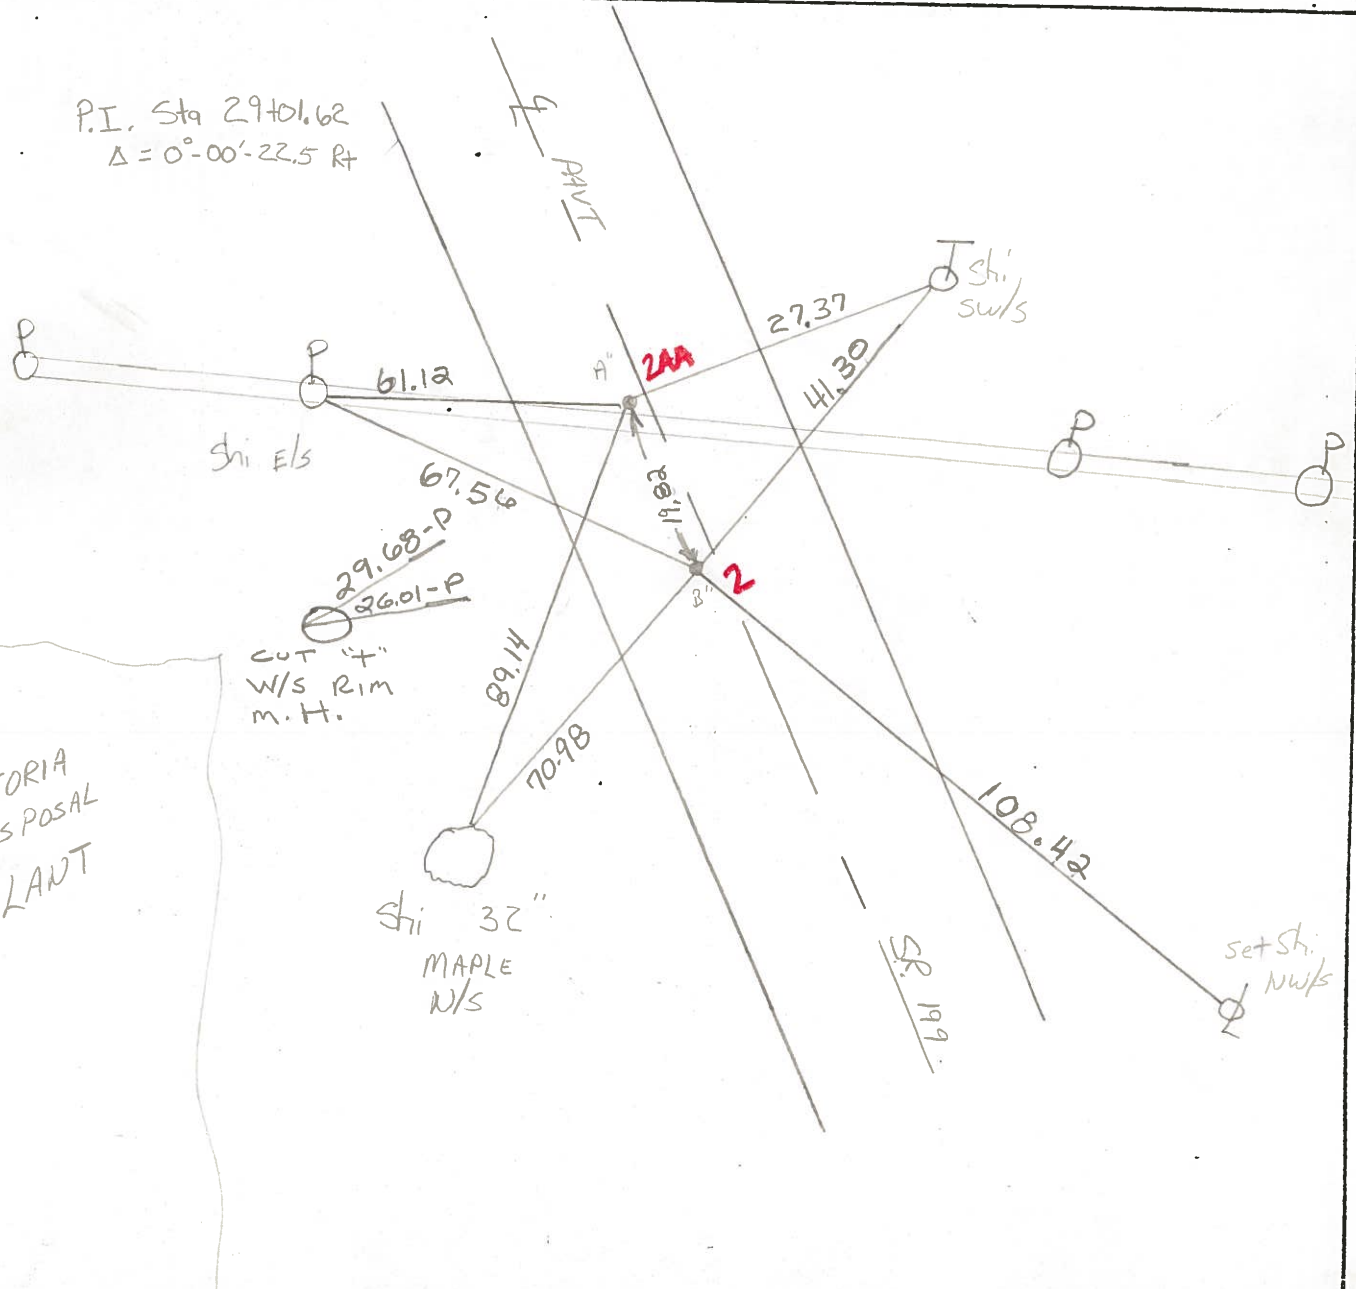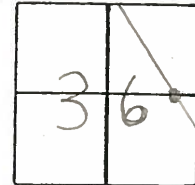

County Wood S.R. 199

Date 6-21-79

Township PERRY


Weather CLOUDY

Section 36


Temp. +72°

T 3 N, R 1/2 E

Personnel BURNSIDE
SMITH
BOWERS
KUAPE
MEAD

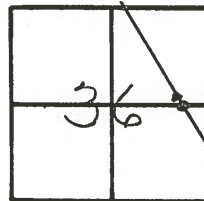

P.I. STA. 29+01.62
 $\Delta = 0^{\circ}00'22.5''$ Rt
 R.R. Spk. 5" DEEP &
 1.25' W. OF CTR. PAVE.
 S.R. 199. SET SMALL
 R.R. SPK. @ SURFACE

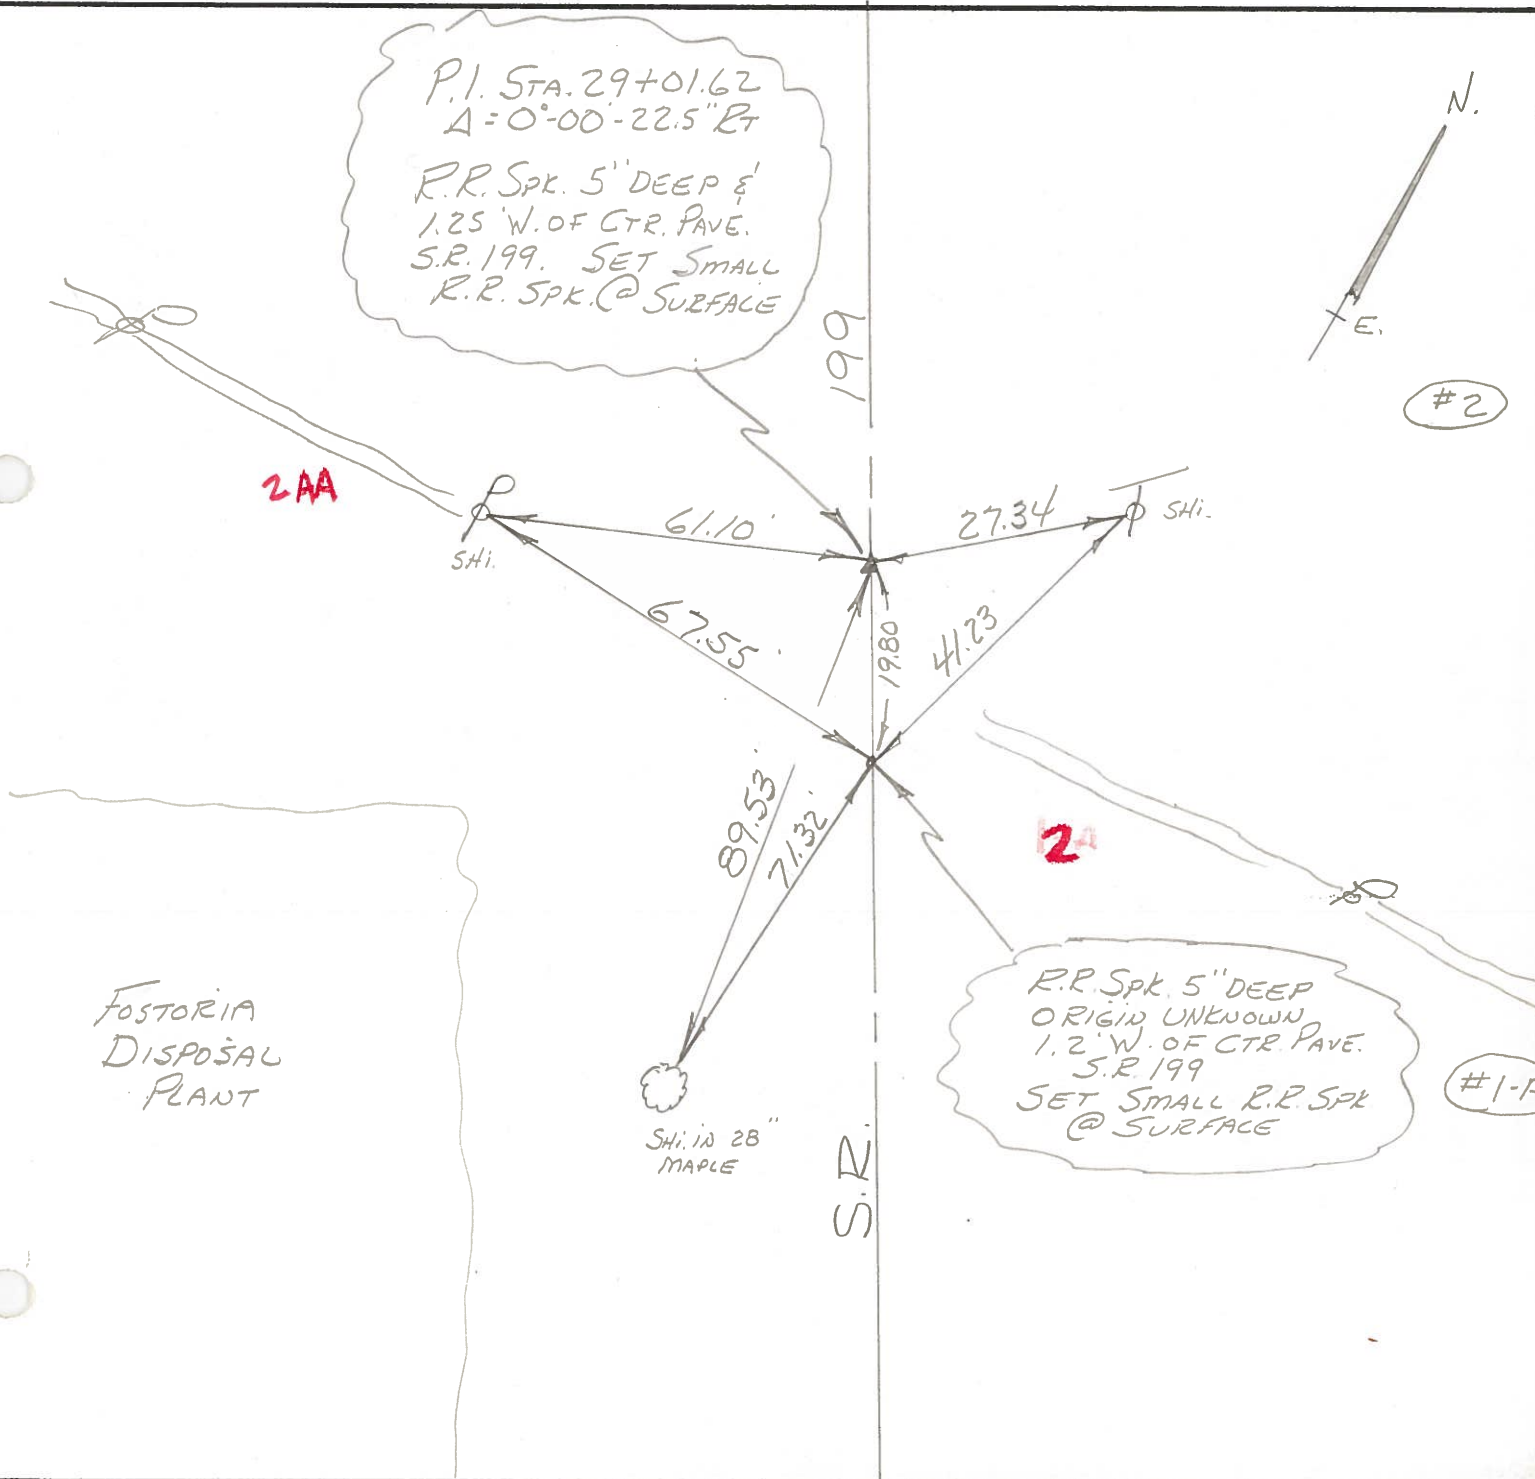

FOSTORIA DISPOSAL PLANT

R.R. Spk. 5" DEEP
 ORIGIN UNKNOWN
 1.2' W. OF CTR. PAVE.
 S.R. 199
 SET SMALL R.R. SPK
 @ SURFACE

#1-A

#2

PERSONNEL	TITLE	PERSONNEL	TITLE
BURNSIDE			
SMITH			
BOWERS			

COUNTY Wood DATE 1-10-72
 S. R. 199 WEATHER CLEAR
 SEC. _____ TEMP. +45

DESCRIPTION _____ LEFT _____ CENTER LINE _____ RIGHT _____ JOB NO. _____

