

O.D.O.T. DISTRICT 2 SURVEY OFFICE (USE ONLY)

PERSONNEL _____ REFERENCE NO. 2 AA SHEET 3 OF 24

NOTES	<u>RHOADES</u>	DATE	<u>5-6-13</u>	ROUTE	<u>SR 199</u>
H.C.	<u>CODER</u>	WEATHER	<u>CLOUDY</u>	COUNTY	<u>WOOD</u>
R.C.	<u>ROUSOS</u>	TEMP.	<u>55°</u>	TOWNSHIP	<u>PERRY</u>
				SECTION	<u>36</u>
				T	<u>3</u> N
				R	<u>12</u> E

TYPE MONUMENT P.K.SHANK


ON SURFACE - ~~BELOW~~ ON _____

LEFT - C PAV'T - ~~RIGHT~~ 2.8

10.3 TO LT EDGE PAVEMENT


S.L.M. 31+01.26

Grid: Northing: 550543.284 Easting: 1714250.418

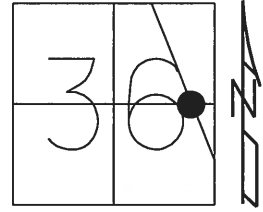

DIST 2-2A = 19.69'

RECORD:
 FD SM.R.R.SPIKE
 7/14/88, CL
 SET P.K./WASHER
 7/30/90, CL
 FD P.K.SHANK
 REFAA2
 10/12/11, MC
 SET MAG/WASHER
 FINREFAA2
 4/28/14, TMR

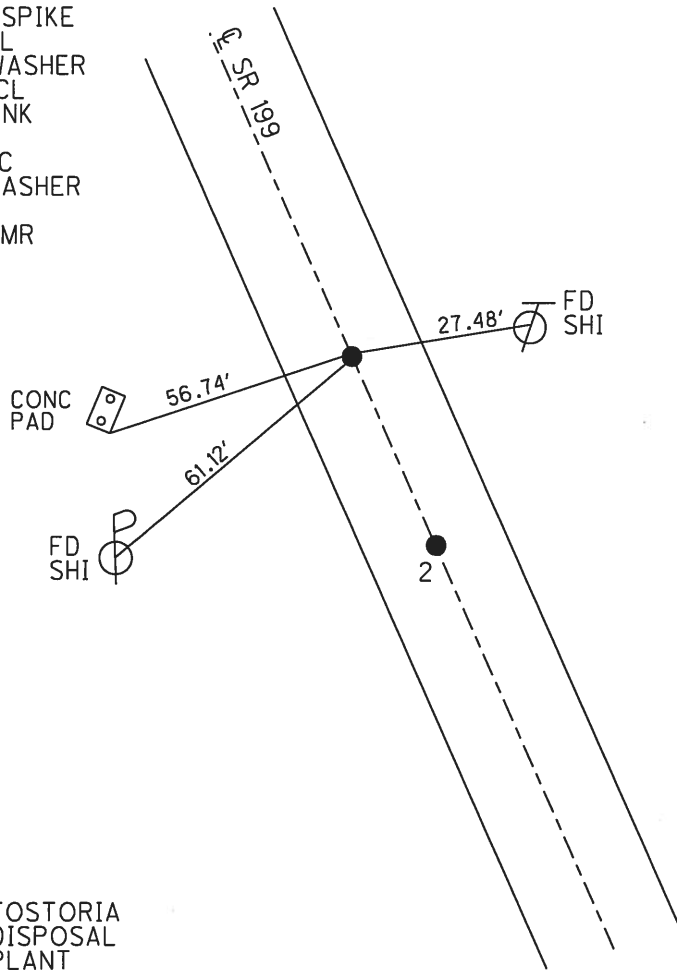

O.D.O.T. DISTRICT 2 SURVEY OFFICE

PERSONNEL _____

REFERENCE NO. 2

SHEET _____ OF _____

NOTES LOEHRKE

H.C. BARNHISEL

R.C. REED

DATE 7-14-88

WEATHER Pt Cloudy Hazy

TEMP. +85

ROUTE 199

COUNTY WOOD

TOWNSHIP PERRY

SECTION 36

T3 N R 12 E

TYPE MONUMENT Sm RR Spikes



ON SURFACE - BELOW

LEFT- ☉ PAV'T. - RIGHT 2.8

10.3 TO LT EDGE PAVEMENT

S.L.M. ZB+80 & ZB+99

Set P.K.'s/WASHERS
7-30-90
C.L.

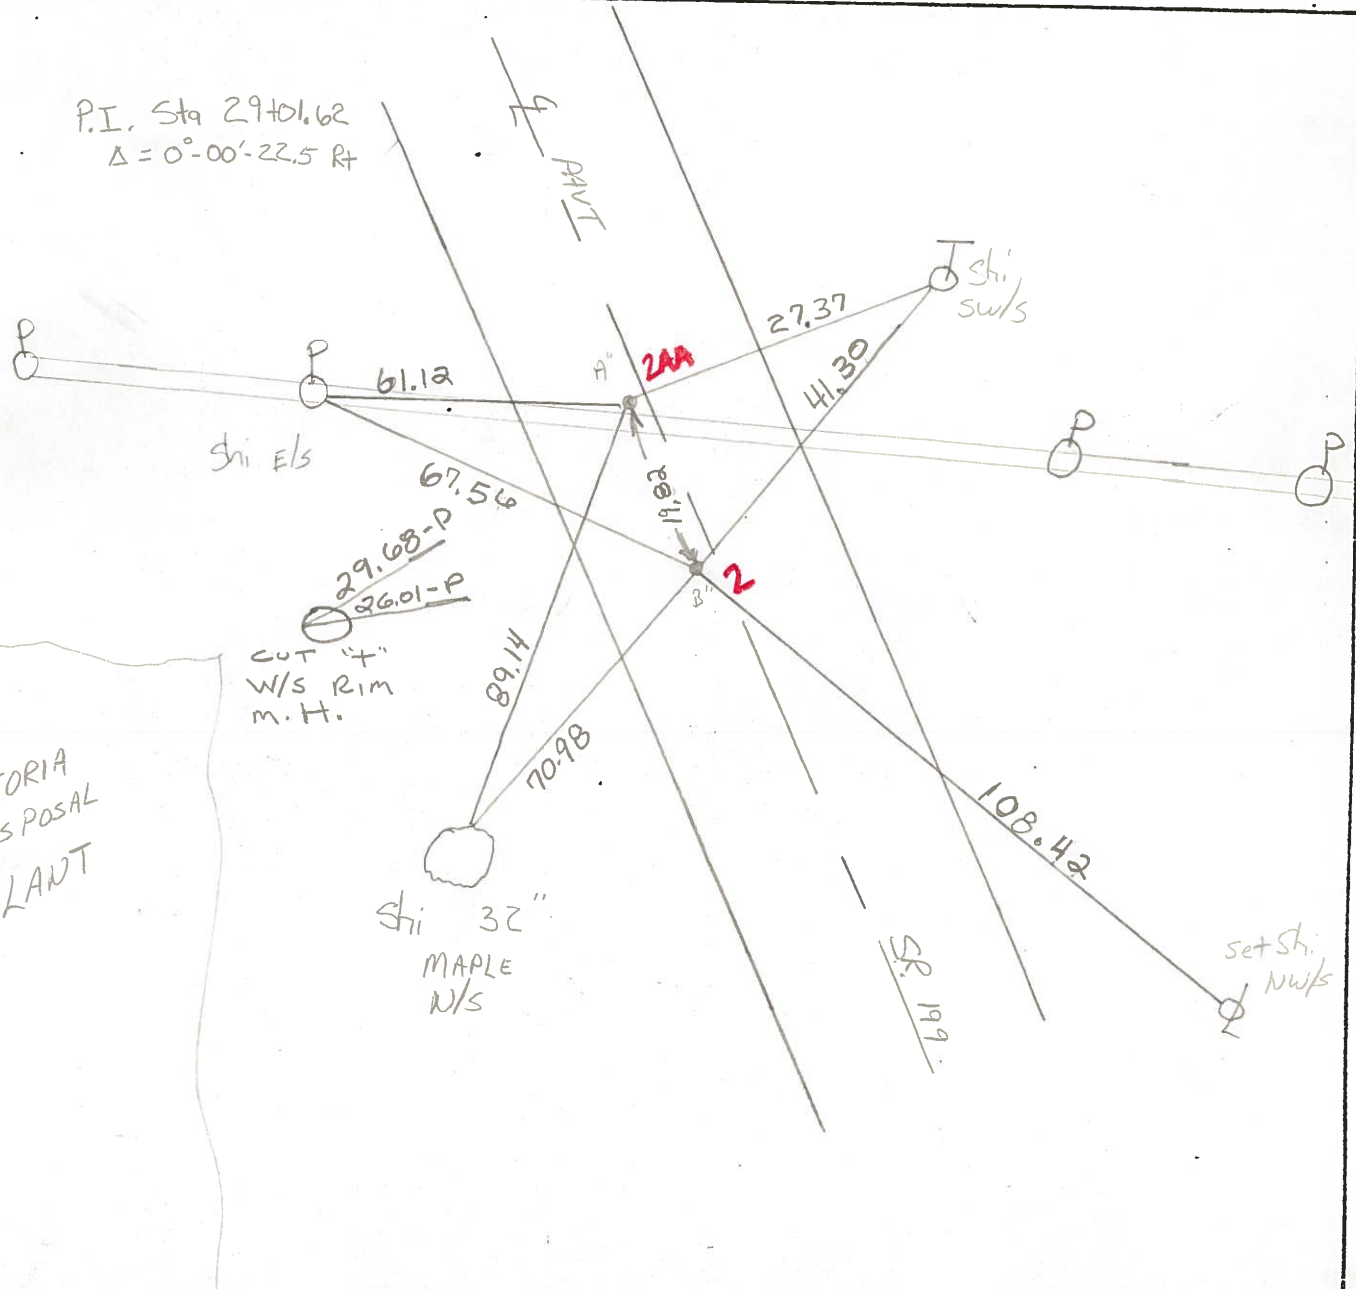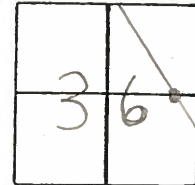

County Wood S.R. 199

Date 6-21-79

Township PERRY


Weather CLOUDY

Section 36


Temp. +72°

T3N, R2E

Personnel BURNSIDE
SMITH
BOWERS
KNAPE
MEAD

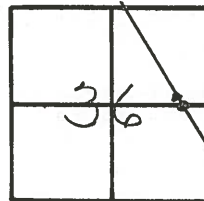

P.I. STA. 29+01.62
 $\Delta = 0^{\circ}00'22.5''$ Rt
 R.R. Spk. 5" DEEP &
 1.25' W. OF CTR. PAVE.
 S.R. 199. SET SMALL
 R.R. SPK. @ SURFACE

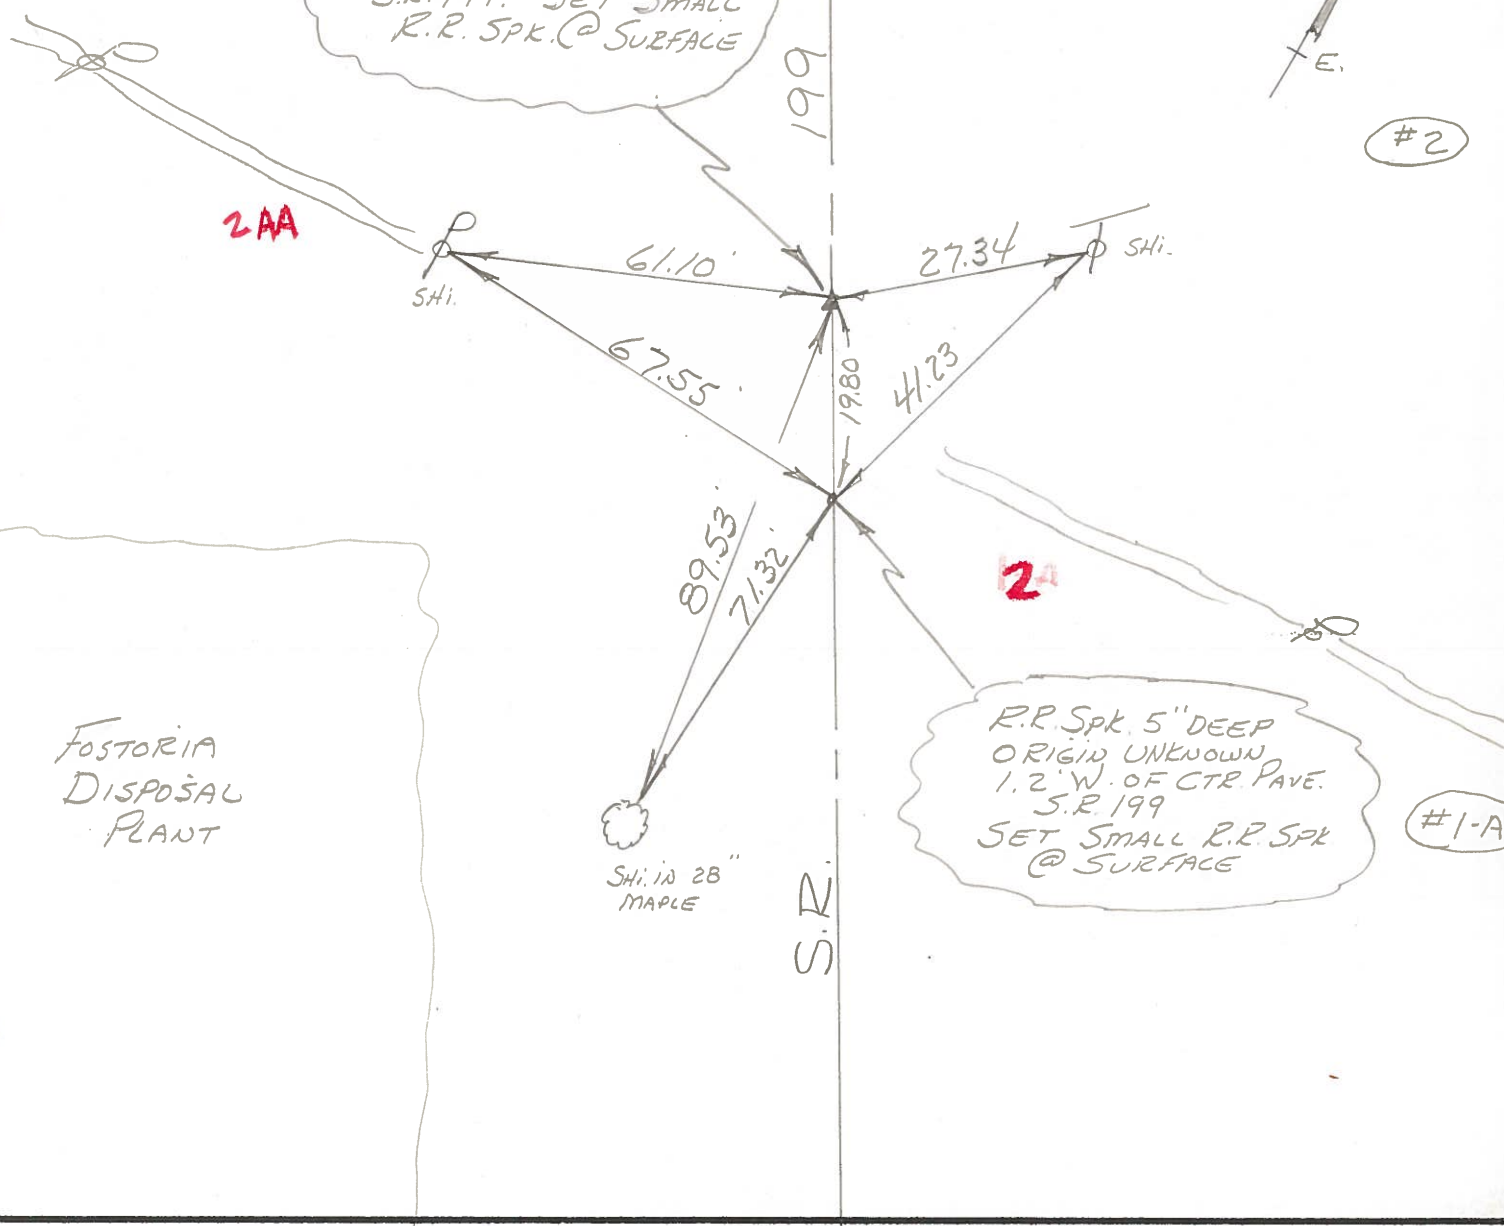

R.R. Spk. 5" DEEP
 ORIGIN UNKNOWN
 1.2' W. OF CTR. PAVE.
 S.R. 199
 SET SMALL R.R. SPK
 @ SURFACE

#1-A

FOSTORIA
DISPOSAL
PLANT

SHI. in 28"
MAPLE

S.R.

PERSONNEL	TITLE	PERSONNEL	TITLE
BURNSIDE			
SMITH			
BOWERS			

COUNTY Wood DATE 1-10-72
 S. R. 199 WEATHER CLEAR
 SEC. _____ TEMP. +45

DESCRIPTION _____ LEFT _____ CENTER LINE _____ RIGHT _____ JOB NO. _____

