


O.D.O.T. DISTRICT 2 SURVEY OFFICE (USE ONLY)


PERSONNEL	REFERENCE NO.	<u>3</u>	SHEET	<u>5</u>	OF	<u>24</u>
NOTES	RHOADES	DATE	<u>5-6-13</u>	ROUTE	<u>SR 199</u>	
H.C.	<u>CODER</u>	WEATHER	<u>CLOUDY</u>	COUNTY	<u>WOOD</u>	
R.C.	<u>ROUSOS</u>	TEMP.	<u>55°</u>	TOWNSHIP	<u>PERRY</u>	
				SECTION	<u>36</u>	
				T	<u>3</u>	N
				R	<u>12</u>	E

TYPE MONUMENT SM.R.R.SPIKE
 ON SURFACE - BELOW 2"
 LEFT - ☉ PAV'T - RIGHT 2'
_____ TO _____ EDGE PAVEMENT
 S.L.M. 62+87.90

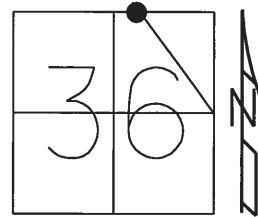

Grid: Northing: 553170.482 Easting: 1712446.911

RECORD:
 FD LG.R.R.SPIKE
 1" DOWN
 7/14/88, CL
 SET P.K./WASHER
 7/30/90, CL
 FD SM.R.R.SPIKE
 2" DOWN
 REF3
 10/12/11, MC
 SET MAG/WASHER
 FINREF3
 4/28/14, TMR

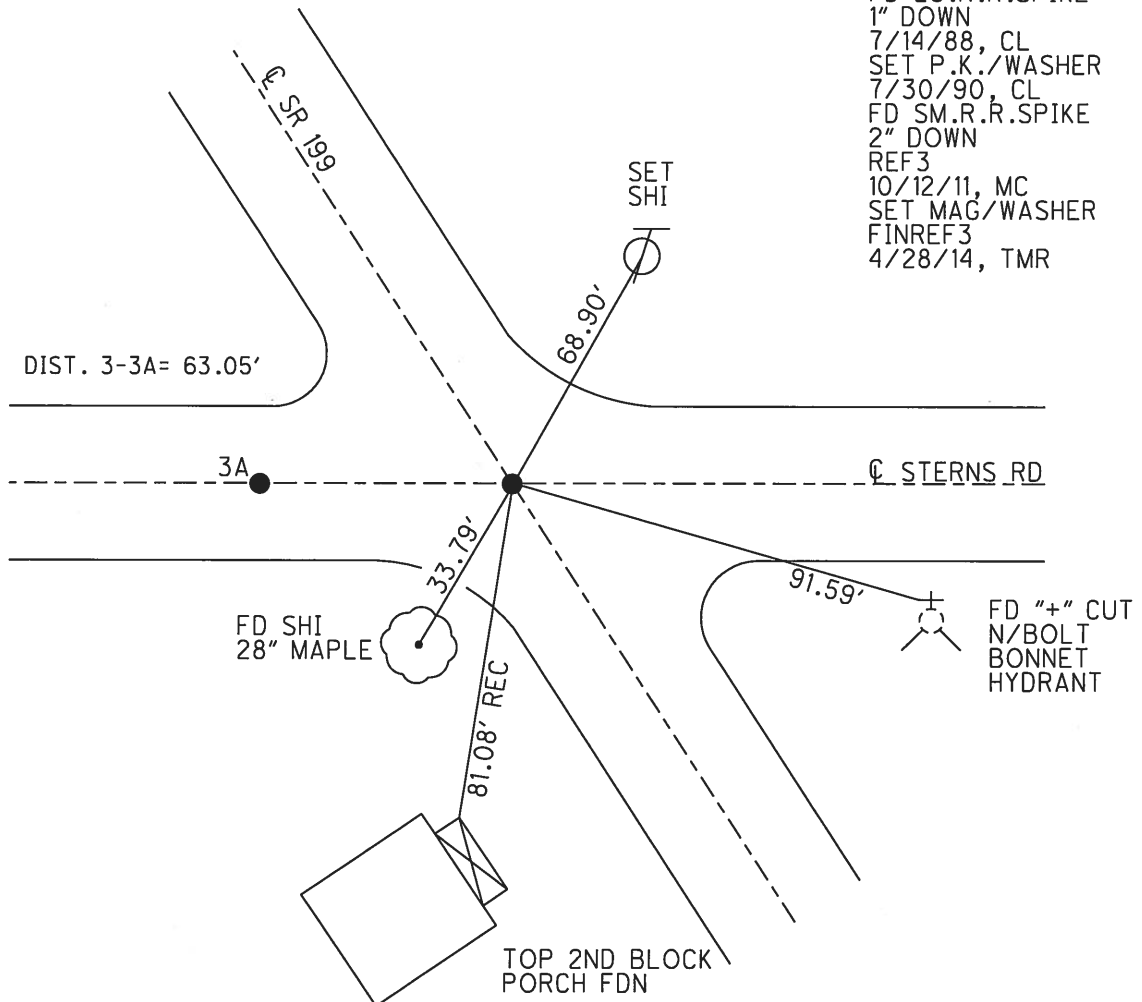

O.D.O.T. DISTRICT 2 SURVEY OFFICE

PERSONNEL _____

REFERENCE NO. 3

SHEET _____ OF _____

NOTES LOEHRKE

H.C. BARDHISEL

R.C. Reed

DATE 7-14-88

WEATHER CLoudy Hazy

TEMP. +86

ROUTE 199

COUNTY Woods

TOWNSHIP PERRY

SECTION 36

T. 3 N. R. 12 E.

Set P.K. / WASHER
7-30-90



TYPE MONUMENT Log RR Spike ^A Sm RR Spike ^B

ON SURFACE - BELOW 1" Behw

LEFT- & PAV'T. - RIGHT "A" 2' S. of Stearns, 1' W of 199

TO EDGE PAVEMENT

S.L.M. 60+88

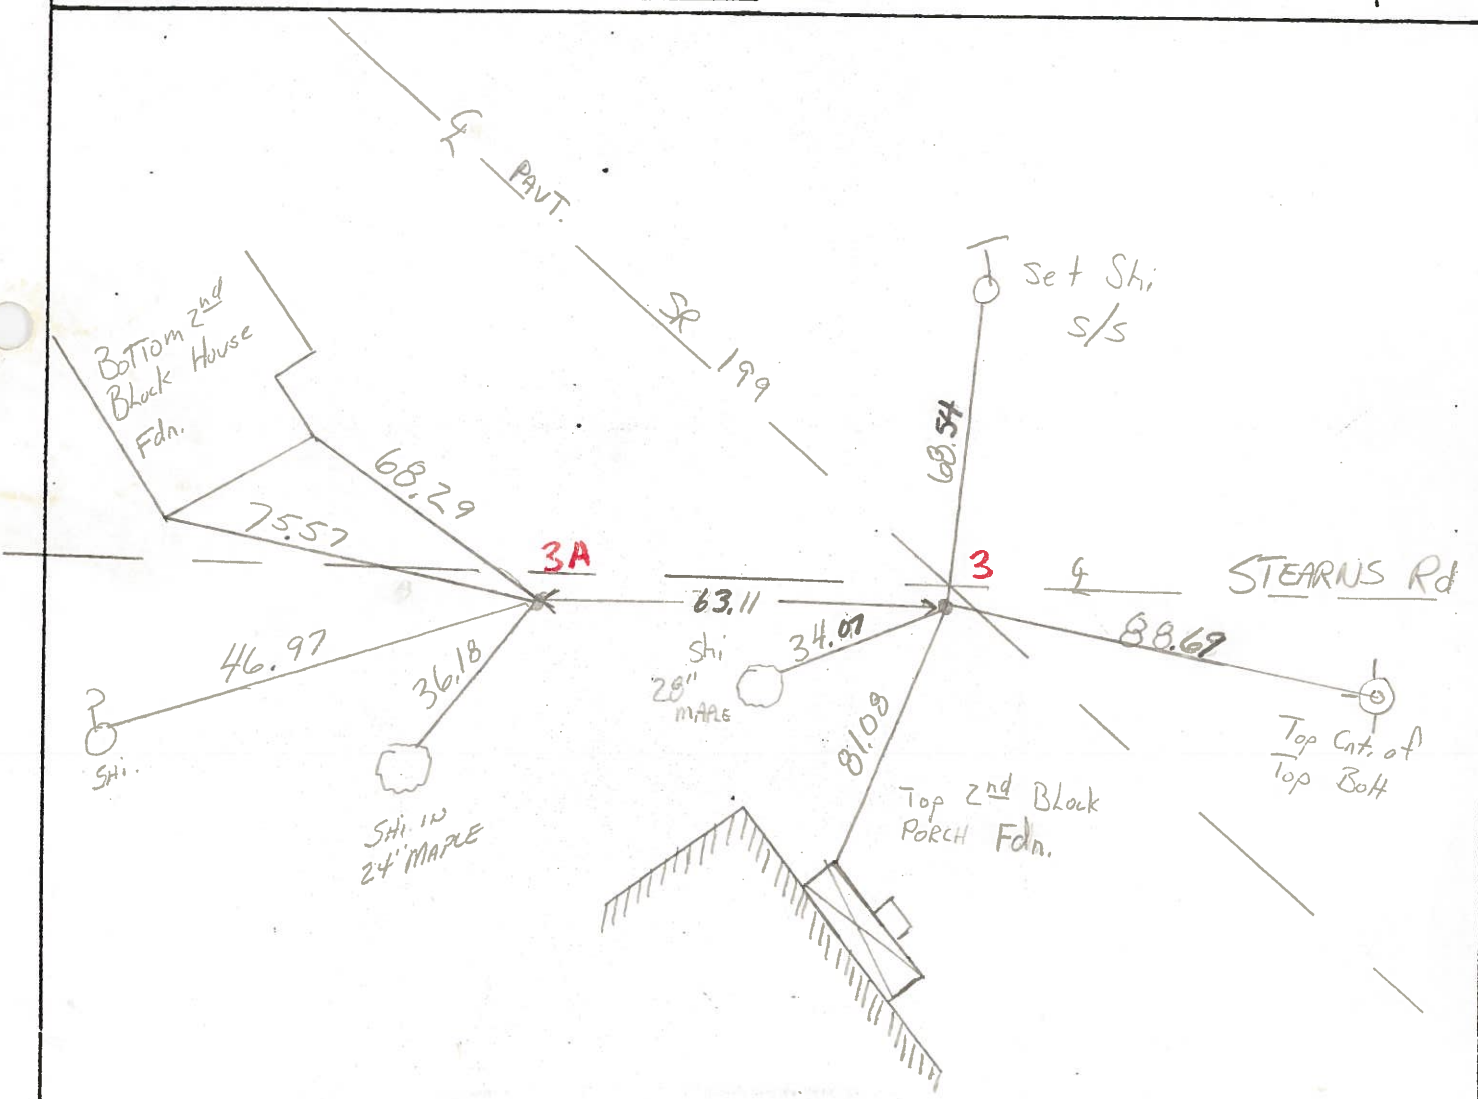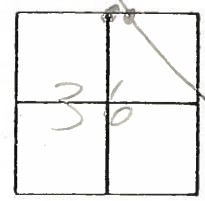

O.D.O.T. DISTRICT 2 SURVEY OFFICE

Sht. 4 of 4

S.R. 199

County WOOD

Date 7-21-78 (OK 5-9-80)

Township PERRY

Weather RAIN STARTING

Section 36

Temp. +90°


T3N, R12E

Personnel BURNSIDE

BOWERS


KNAPE

CURTIS

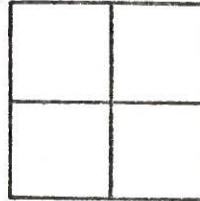

END POINT CHECK

#3

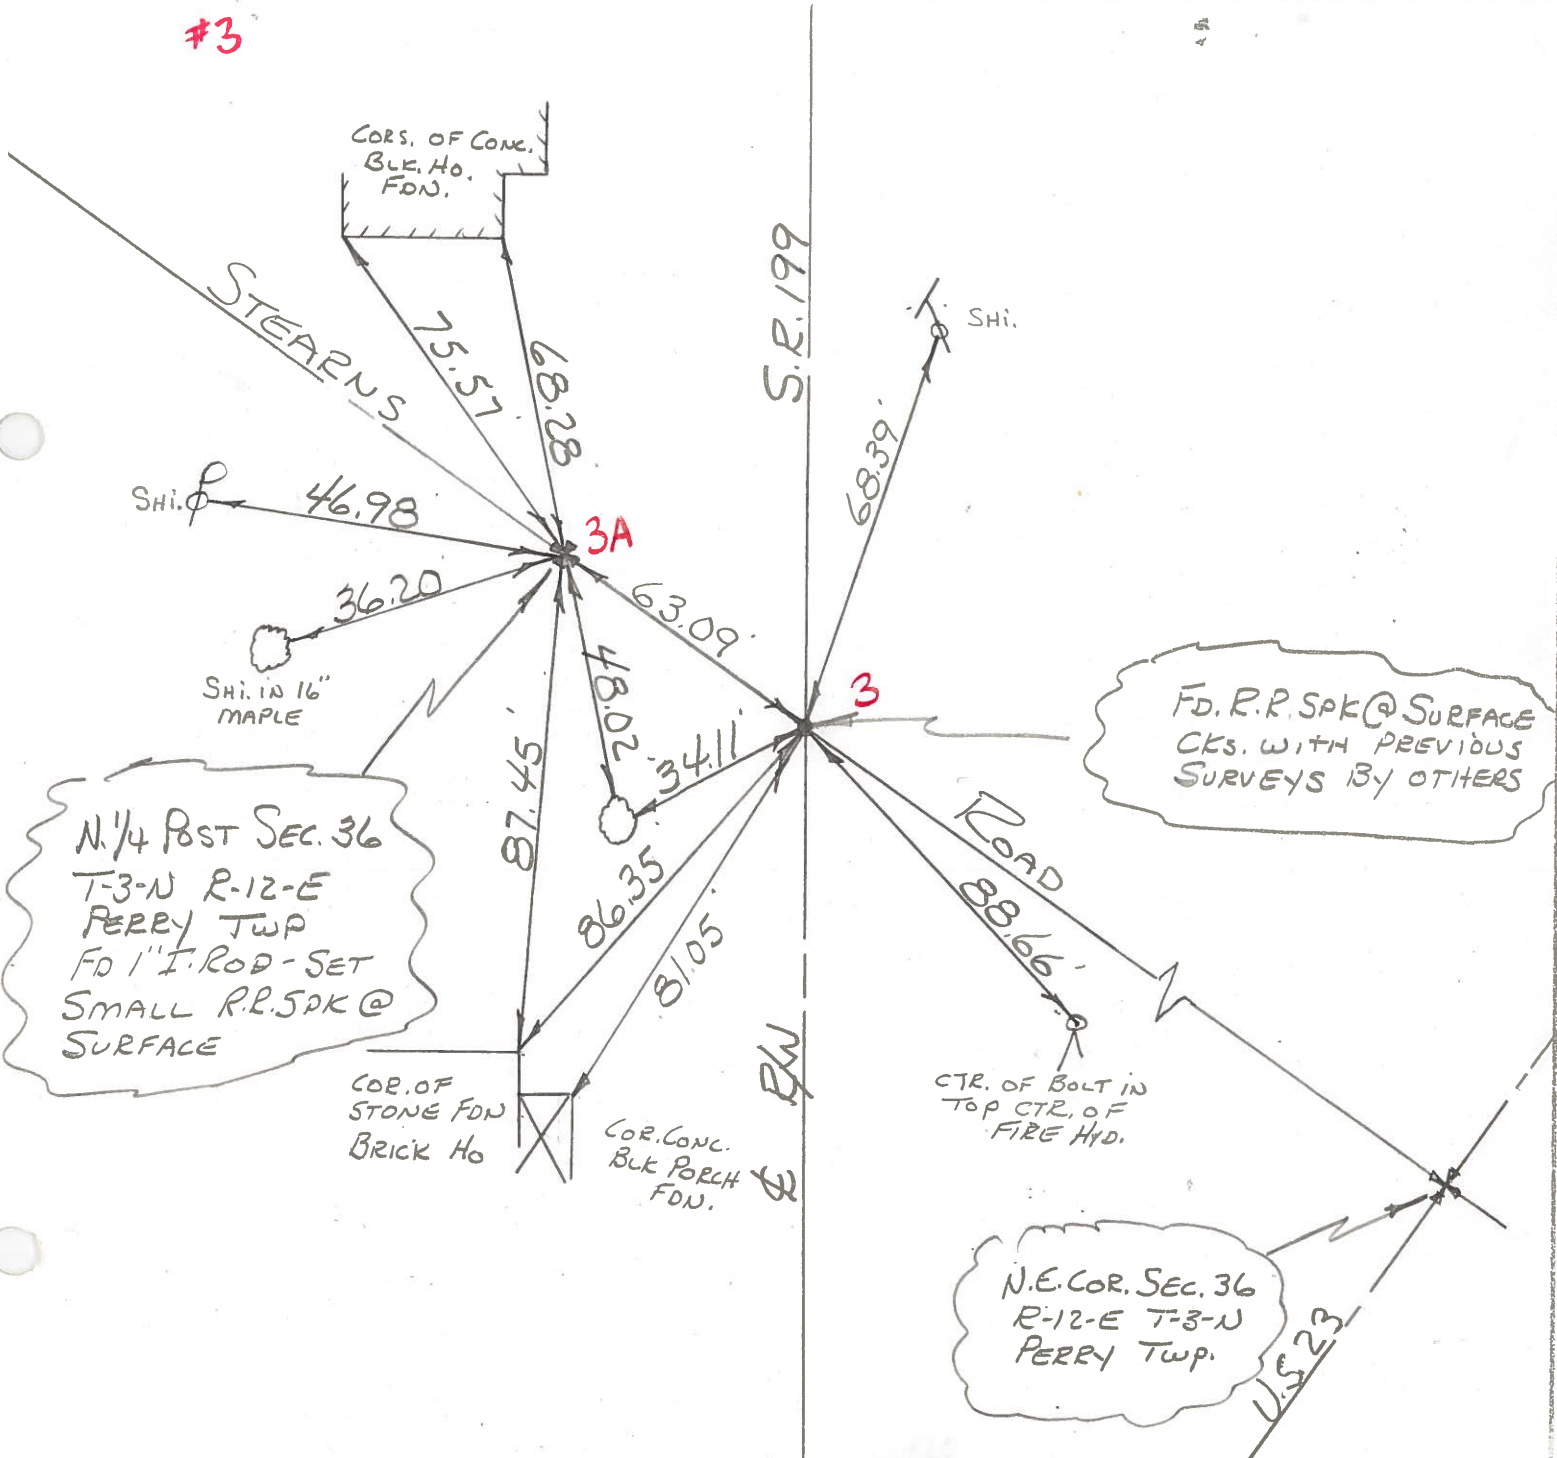

PERSONNEL TITLE PERSONNEL TITLE
BURNSIDE _____
SMITH _____
BOWERS _____

COUNTY Wood DATE 11-23-71

S. R. 199 WEATHER CLEAR

SEC. 36 PERRY TWP. TEMP. +20°

DESCRIPTION LEFT CENTER LINE RIGHT JOB NO.

