
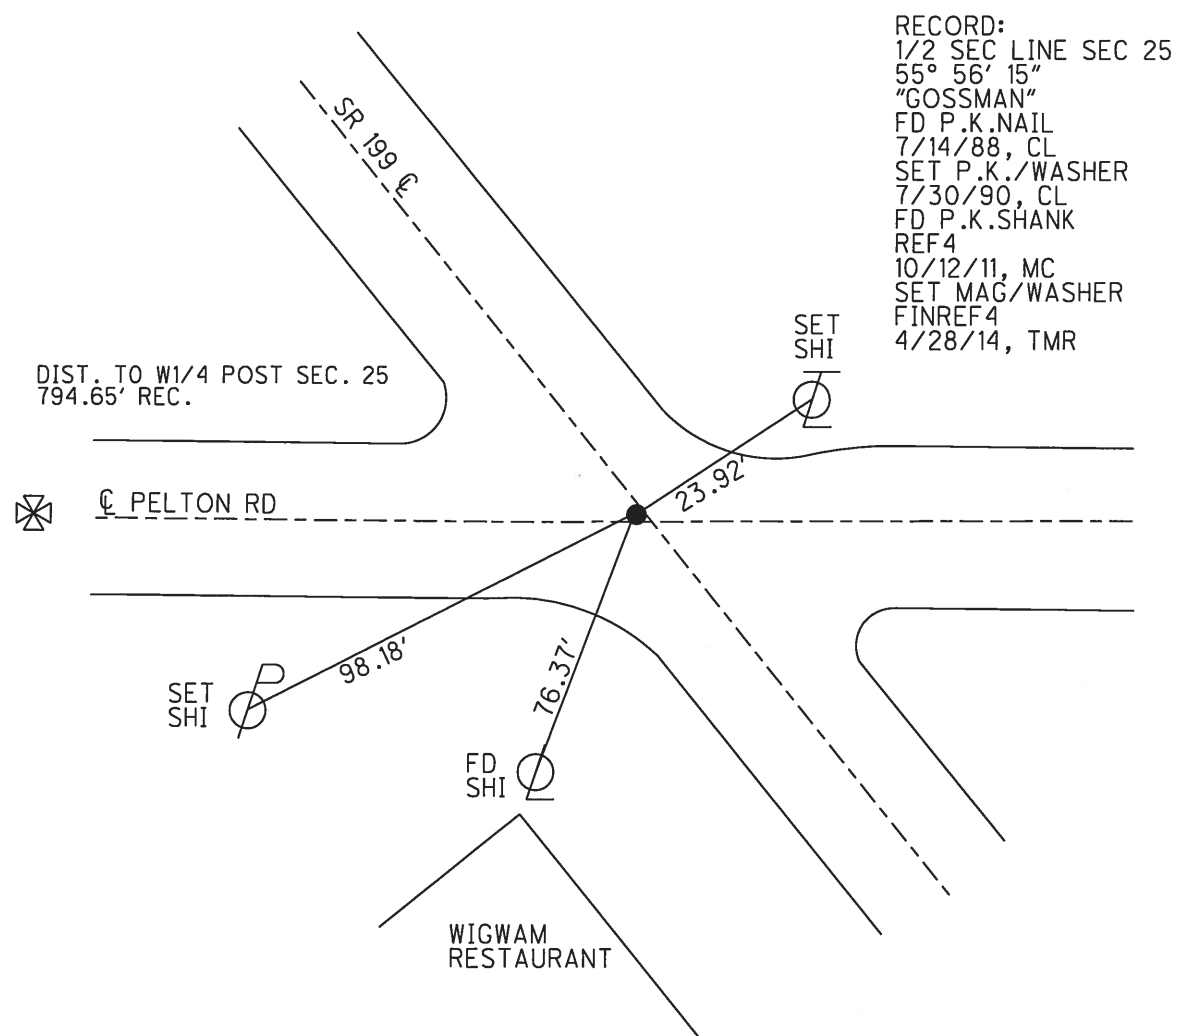


O.D.O.T. DISTRICT 2 SURVEY OFFICE (USE ONLY)

PERSONNEL _____ REFERENCE NO. 4 SHEET 7 OF 24
 NOTES RHOADES DATE 5-6-13 ROUTE SR 199
 H.C. CODER WEATHER CLOUDY COUNTY WOOD
 R.C. ROUSOS TEMP. 55° TOWNSHIP PERRY
 SECTION 25
 T 3 N R 12 E

TYPE MONUMENT P.K./WASHER
 ON SURFACE - ~~BELOW~~ ON _____
 LEFT - ☉ PAV'T - ~~RIGHT~~ 1.5', 1' N OF ☉ W
 - TO - EDGE PAVEMENT
 S.L.M. 94+85.31

Grid: Northing: 555822.929 Easting: 1710661.491

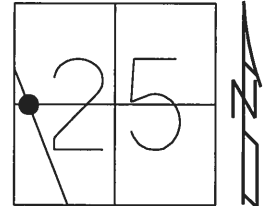

RECORD:
 1/2 SEC LINE SEC 25
 55° 56' 15"
 "GOSSMAN"
 FD P.K.NAIL
 7/14/88, CL
 SET P.K./WASHER
 7/30/90, CL
 FD P.K.SHANK
 REF4
 10/12/11, MC
 SET MAG/WASHER
 FINREF4
 4/28/14, TMR

County WOOD S.R. 199

Township PERRY

Section 25

T N, R E

Personnel BURNSIDE

SMITH

BOWERS


HOLCOMBE

Date 10-6-71 (5-9-80)^{CHKD.}

Weather CLEAR

Temp. +70°

23	24
26	25

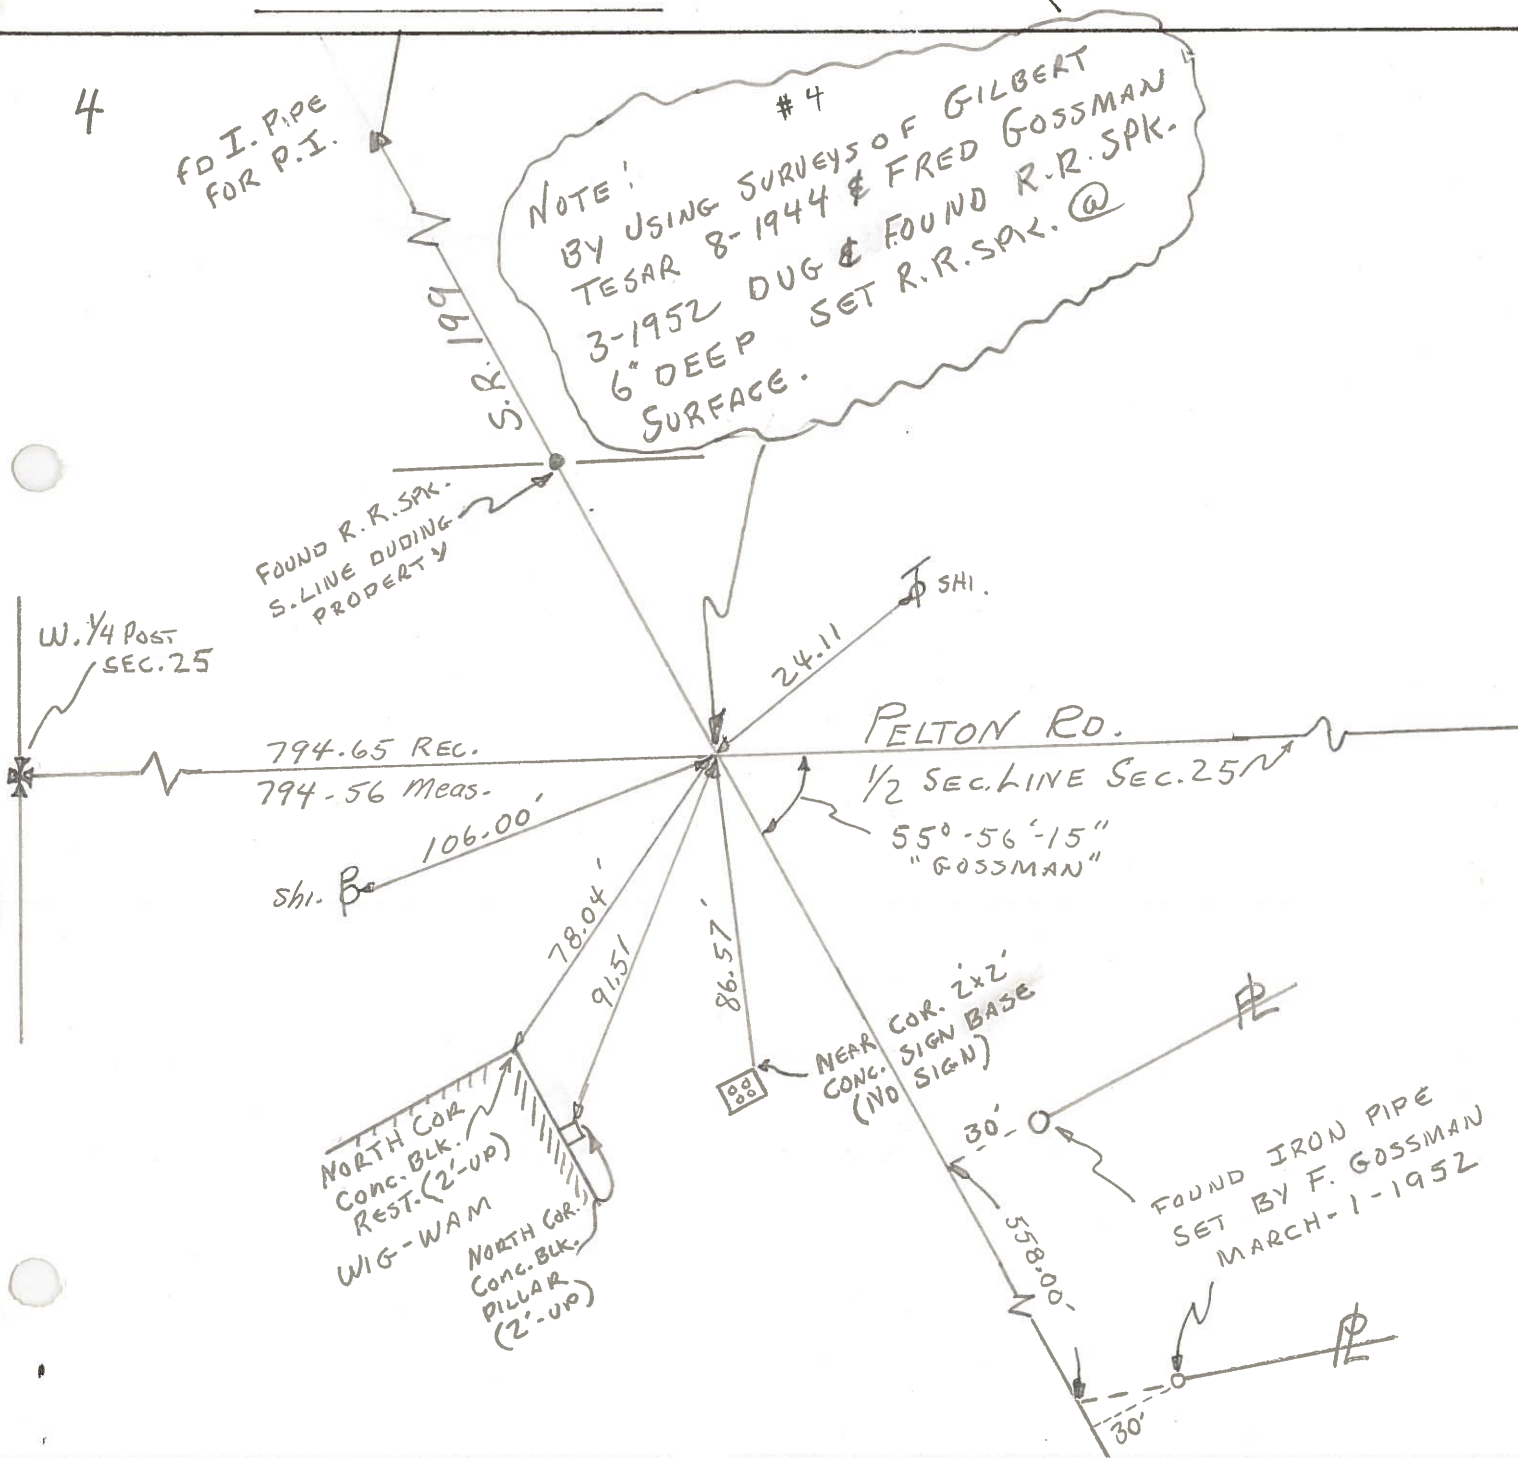

PERSONNEL	TITLE	PERSONNEL	TITLE
BURNSIDE			
SMITH			
BOWERS			
HOLCOMBE			

COUNTY Wood

S. R. 199

WEATHER CLEAR

SEC. PELTON RD.

TEMP. +70°

DESCRIPTION LEFT CENTER LINE RIGHT JOB NO.

