



O.D.O.T. DISTRICT 2 SURVEY OFFICE (USE ONLY)

PERSONNEL _____ REFERENCE NO. 11 SHEET 16 OF 24
 NOTES ROUSOS DATE 5-6-13 ROUTE SR 199
 H.C. HOMAN WEATHER CLOUDY COUNTY WOOD
 R.C. GABLE TEMP. 65° TOWNSHIP PERRY
 SECTION 14
 T 3 N R 12 E

TYPE MONUMENT P.K./WASHER
 ON SURFACE - ~~BELOW~~ ON _____
 LEFT - CL PAV'T - ~~RIGHT~~ 0.5'
10.6 TO LT EDGE PAVEMENT
 S.L.M. 208+94.11

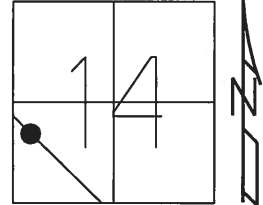

Grid: Northing: 565703.211 Easting: 1705322.954

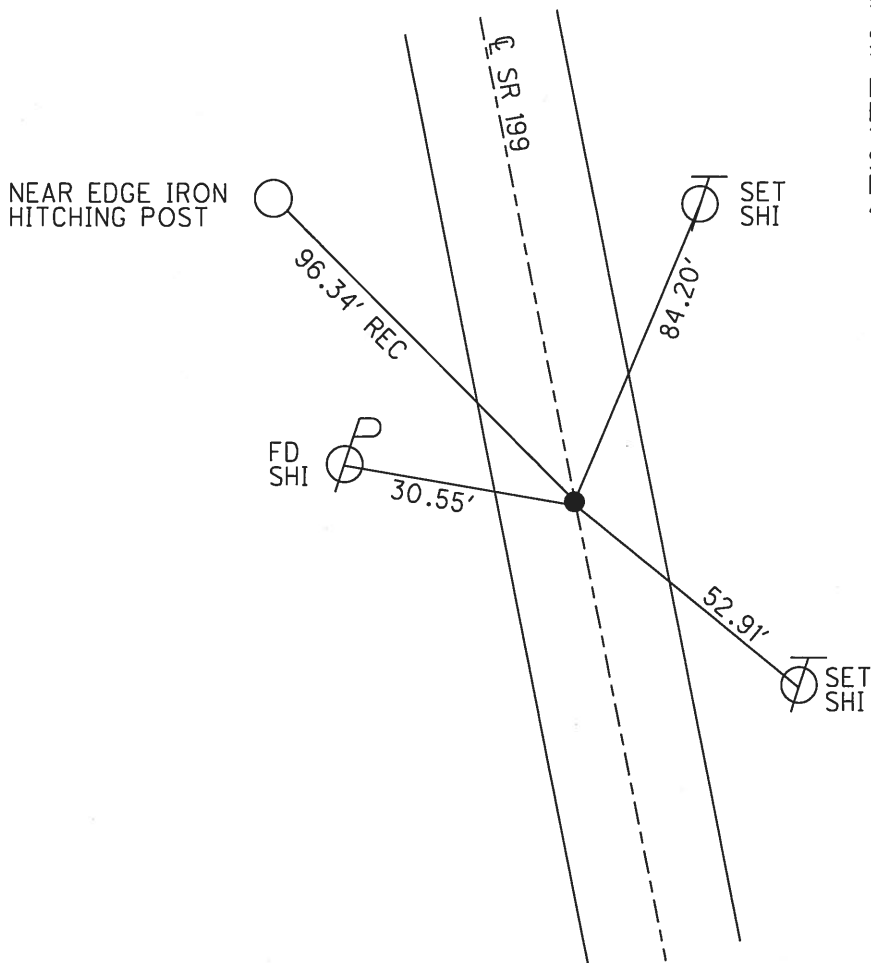

RECORD:
 FD P.K.NAIL
 7/11/88, CL
 SET P.K./WASHER
 7/30/90, CL
 FD P.K./WASHER
 REF11
 10/13/11, MC
 SET MAG/WASHER
 FINREF11
 4/29/14, TMR

O.D.O.T. DISTRICT 2 SURVEY OFFICE

PERSONNEL _____

REFERENCE NO. 11

SHEET _____ OF _____

NOTES LOGARKE

H.C. BARNHISEL

R.C. Reed

DATE 7-11-88

WEATHER At Charon

TEMP. 78.0

ROUTE SR 199

COUNTY WOOD

TOWNSHIP Perry

SECTION 14

T 3 N R 12 E

TYPE MONUMENT P.K. NAIL



ON SURFACE - BELOW _____

LEFT - CL PAV'T. - RIGHT 0.5'

10.6 TO Lt EDGE PAVEMENT

S.L.M. 207 + 03

Set P.K./WASHER
7-30-90
C.L.

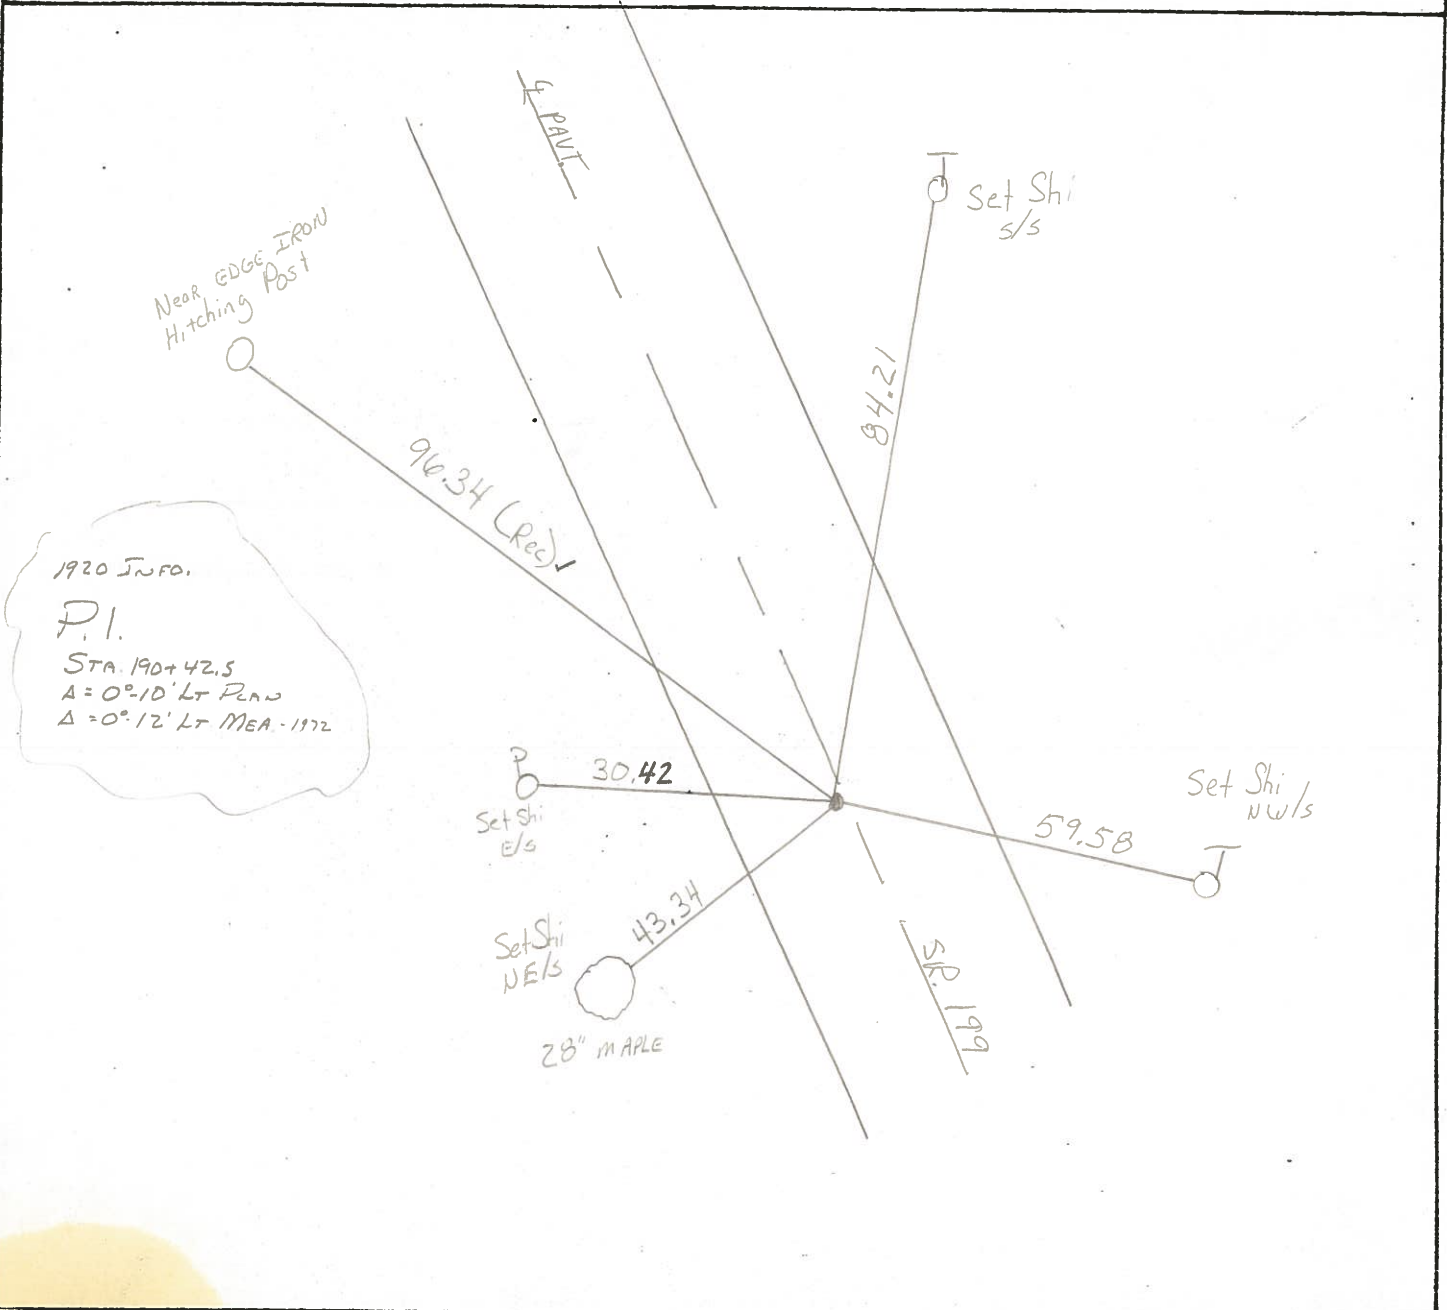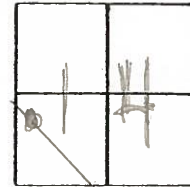

1920 INFO.
P.I.
STA. 190+42.5
Δ = 0° 10' Lt P.L.A.W
Δ = 0° 12' Lt M.E.A. - 1972

O.D.O.T. DISTRICT 2 SURVEY OFFICE

SHEET 12 OF

County _____ S.R. _____

Date 3-28-72 (5-9-80)^{CHKD}

Township PERRY

Weather _____

Section 14

Temp. _____


T_N, R_E

Personnel BURNSIDE

SMITH

BOWERS


MEAD

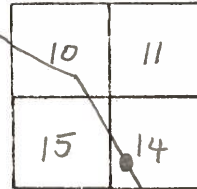

#11

P.I. STA. 190+42.5
 $\Delta = 0^\circ - 10' \text{ LT. (PLAN)}$
 $\Delta = 0^\circ 12' \text{ LT. (MEA.)}$
 DATED (1920)
 SET. P.K.

1st P.I. South of
 EAGLEVILLE ROAD.

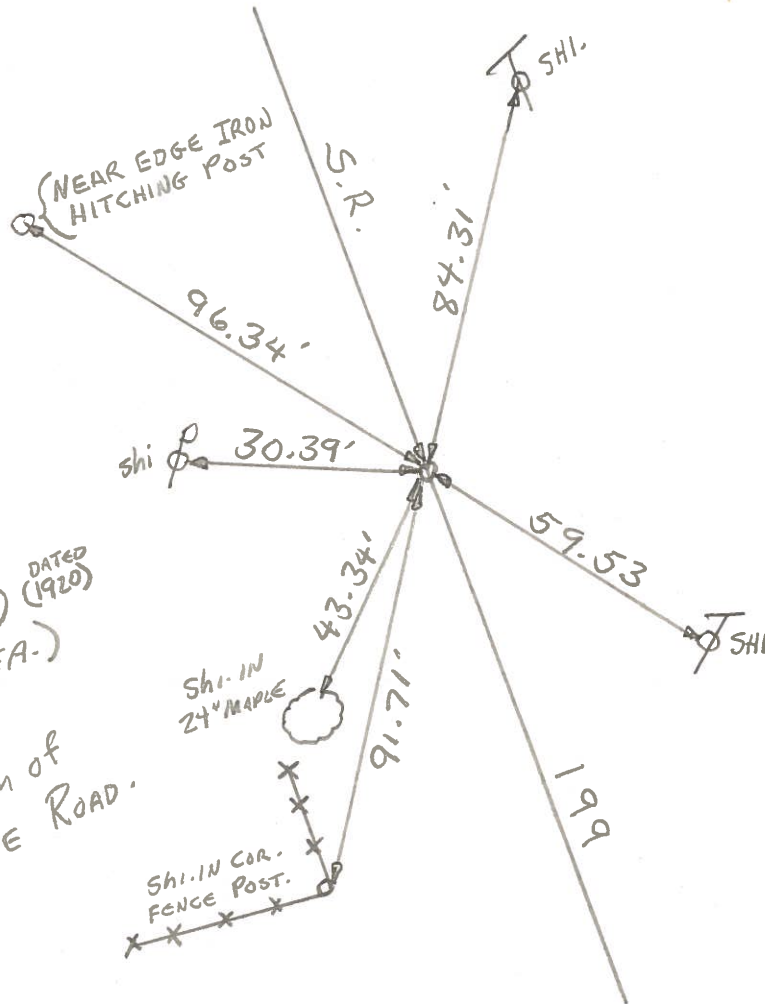

PERSONNEL	TITLE	PERSONNEL	TITLE
BURNSIDE			
SMITH			
BOWERS			


COUNTY Wood DATE OK-5-9-80
3-28-72

S. R. 199 WEATHER CLEAR

SEC. _____ TEMP. 40°

DESCRIPTION 1st P.I. SOUTH OF EAGLEVILLE ROAD JOB NO. _____

LEFT CENTER LINE RIGHT

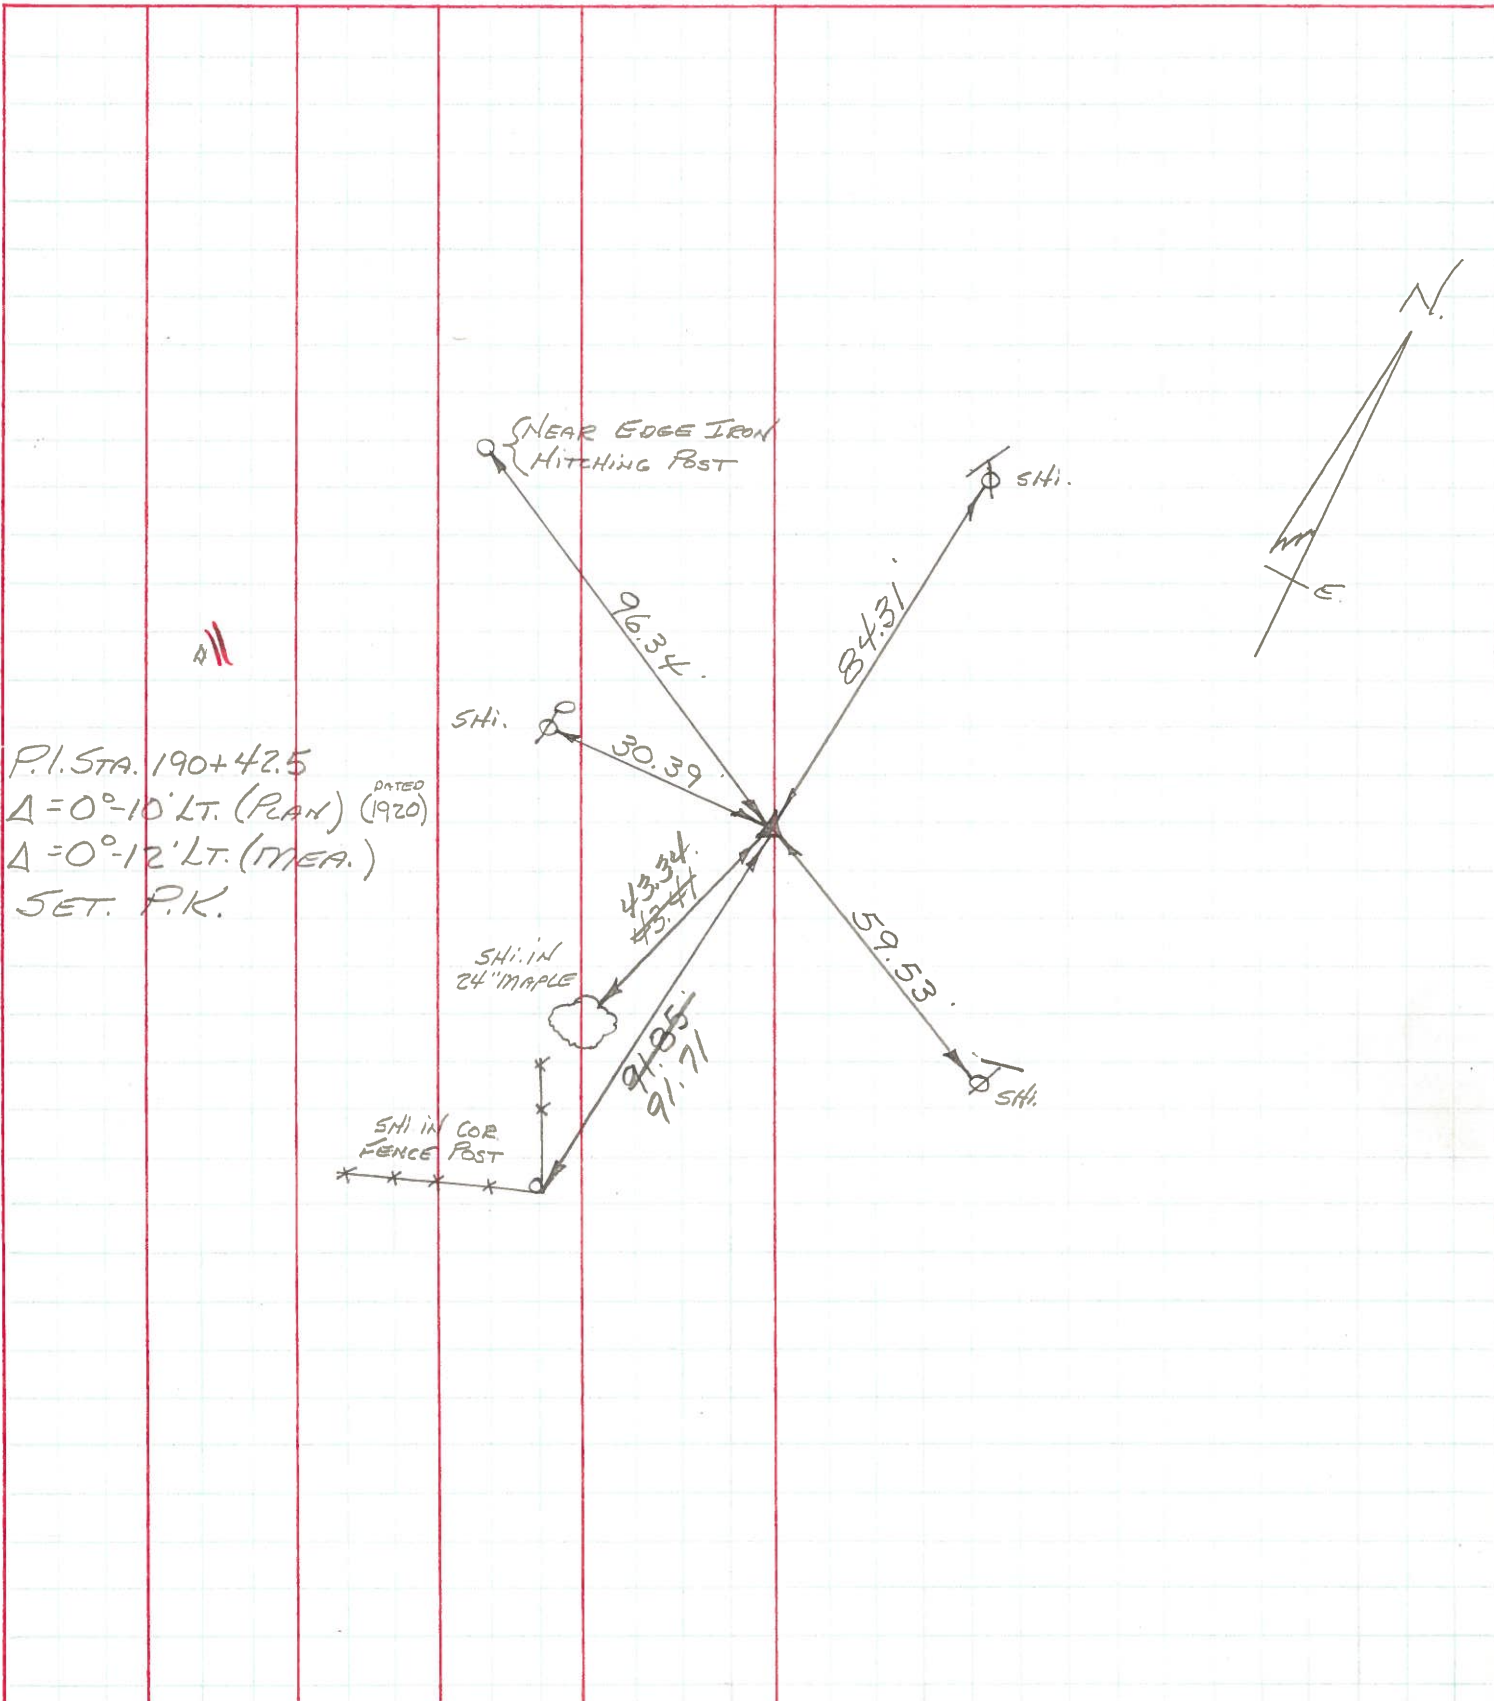

P.I. STA. 190+42.5
 $\Delta = 0^\circ - 10' \text{ LT. (PLAN) (DATED 1920)}$
 $\Delta = 0^\circ - 12' \text{ LT. (MEAS.)}$
 SET. P.K.

