
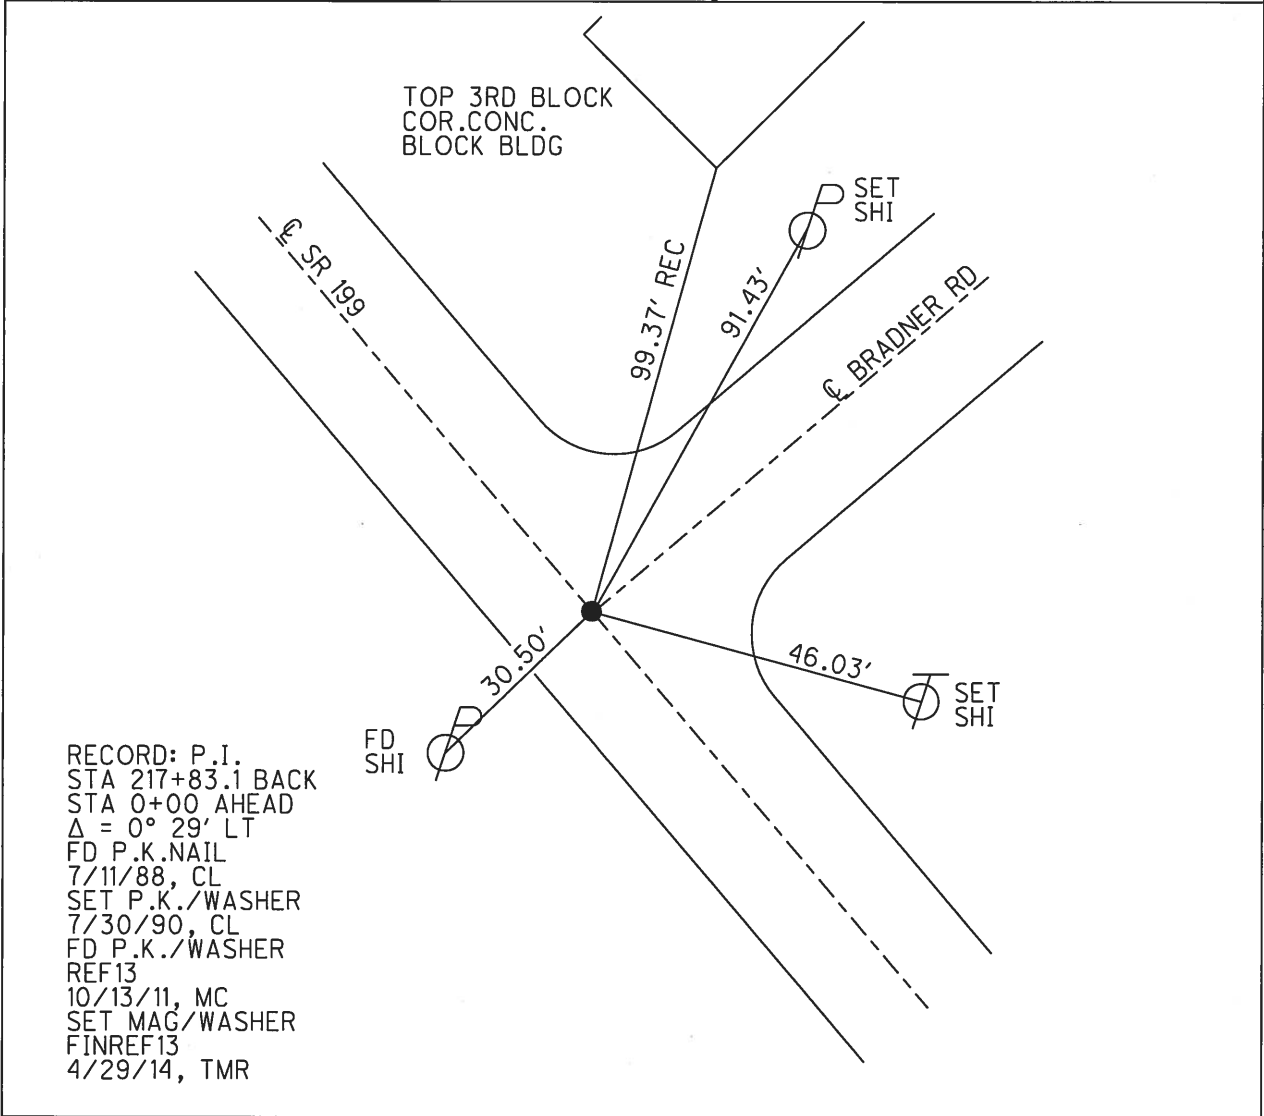


O.D.O.T. DISTRICT 2 SURVEY OFFICE (USE ONLY)

PERSONNEL	REFERENCE NO.	<u>13</u>	SHEET	<u>19</u>	OF	<u>24</u>
NOTES	ROUSOS	DATE	<u>5-6-13</u>	ROUTE	<u>SR 199</u>	
H.C.	<u>CODER</u>	WEATHER	<u>CLOUDY</u>	COUNTY	<u>WOOD</u>	
R.C.	<u>GABLE</u>	TEMP.	<u>65°</u>	TOWNSHIP	<u>PERRY</u>	
				SECTION	<u>15</u>	
				T	<u>3</u>	N
				R	<u>12</u>	E

TYPE MONUMENT P.K./WASHER  
 ON SURFACE - ~~BELOW~~ ON  
 LEFT - CL PAV'T - RIGHT ON  
10.7' TO LT EDGE PAVEMENT  
 S.L.M. 236+33.53  
 Grid: Northing: 567913.777 Easting: 1703704.871

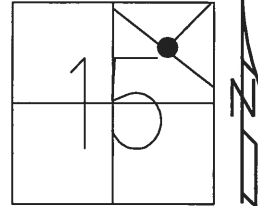

# O.D.O.T. DISTRICT 2 SURVEY OFFICE

PERSONNEL \_\_\_\_\_

REFERENCE NO. 13

SHEET \_\_\_\_\_ OF \_\_\_\_\_

NOTES LOHRKE

H.C. BARNHISEL

R.C. Reed

DATE 7-11-88

WEATHER Cloudy

TEMP. +80

ROUTE SR 199

COUNTY Wood

TOWNSHIP Perry

SECTION 15

T. 3 N. R. 12 E.

TYPE MONUMENT P.K. NAIL

ON SURFACE - BELOW Yes

LEFT- & PAV'T. - RIGHT Both ROAD



TO EDGE PAVEMENT

S.L.M. 234+44

Set P.K. / WASHER

7-30-90

C.L.

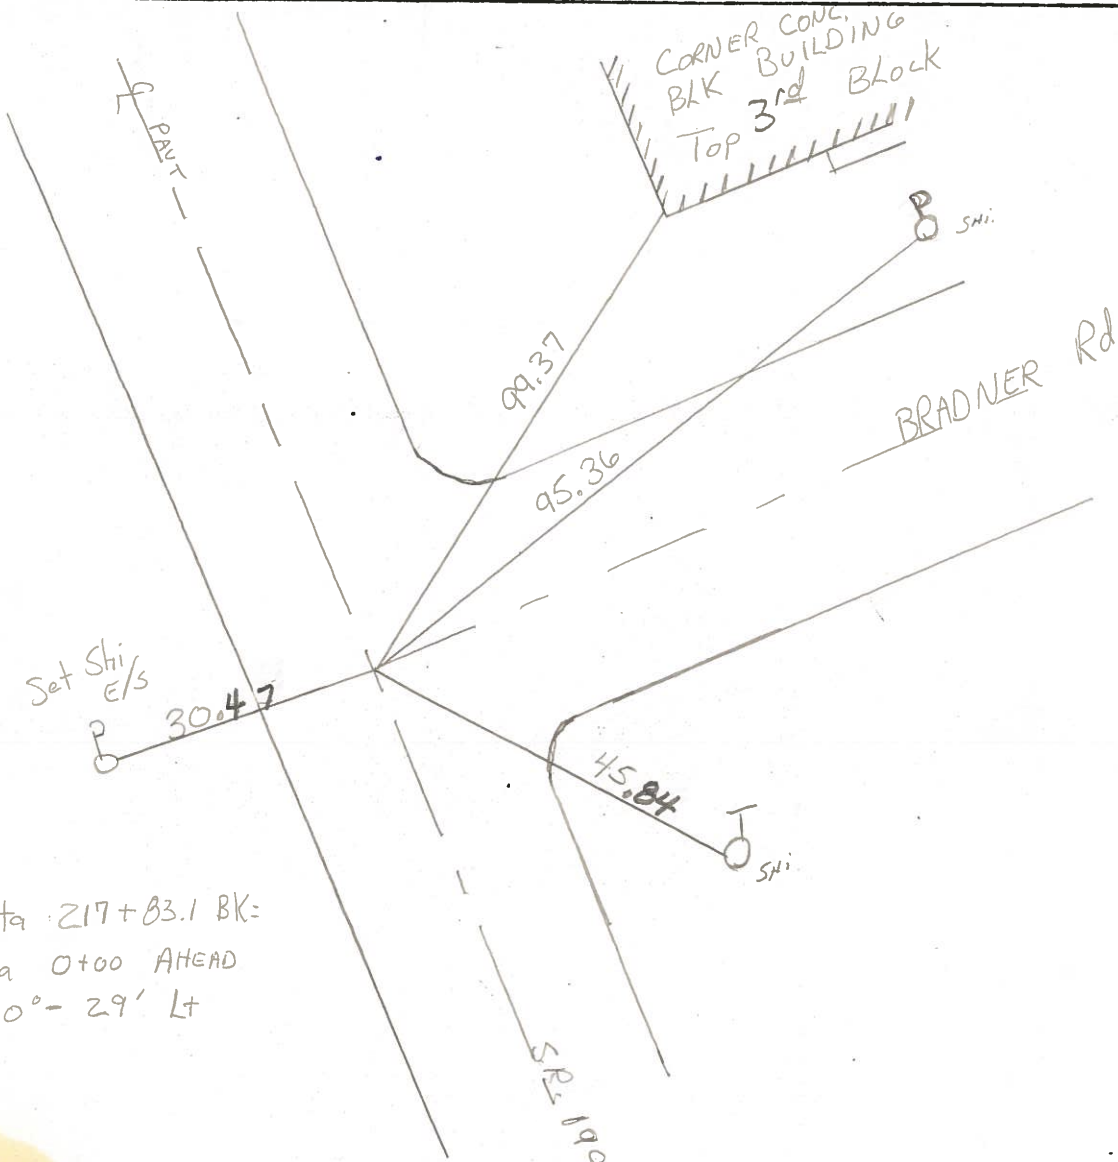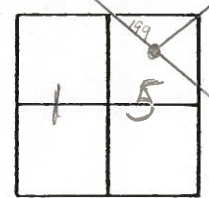

P.I. Sta 217+03.1 BK:  
 P.I. Sta 0+00 AHEAD  
 $\Delta = 0^\circ - 29' \text{ Lt}$

O.D.O.T. DISTRICT 2 SURVEY OFFICE

SHEET 14 OF

County WOOD S.R. 199

Township PERRY

Section 15

T N, R E

Personnel BURNSIDE

SMITH


BOWER

MEAD


Date 11-15-71 <sup>CHKD</sup> 5-9-80

Weather \_\_\_\_\_

Temp. \_\_\_\_\_

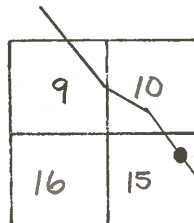

#14

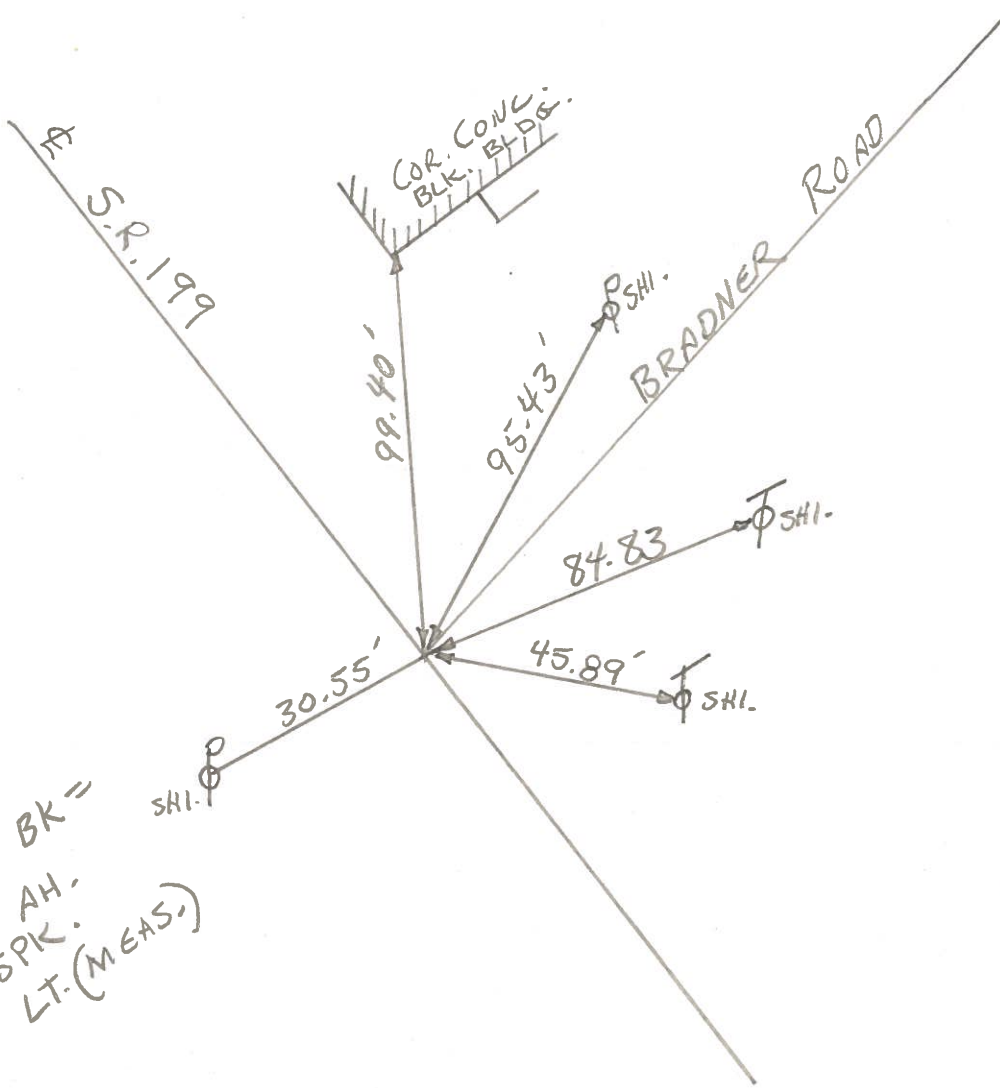

P.I. STA. 217+83.1 BK =  
 P.I. STA. 0+00 AH.  
 SET R.R. SPK.  
 Δ = 0°-29' LT. (MEAS.)

PERSONNEL TITLE PERSONNEL TITLE

BURNSIDE

COUNTY Wood

WEATHER CLEAR

SMITH

S. R. 199

TEMP. +60°

HOLCOMBE

SEC.

TEMP. +60°


DESCRIPTION

LEFT

CENTER LINE

RIGHT

JOB NO.

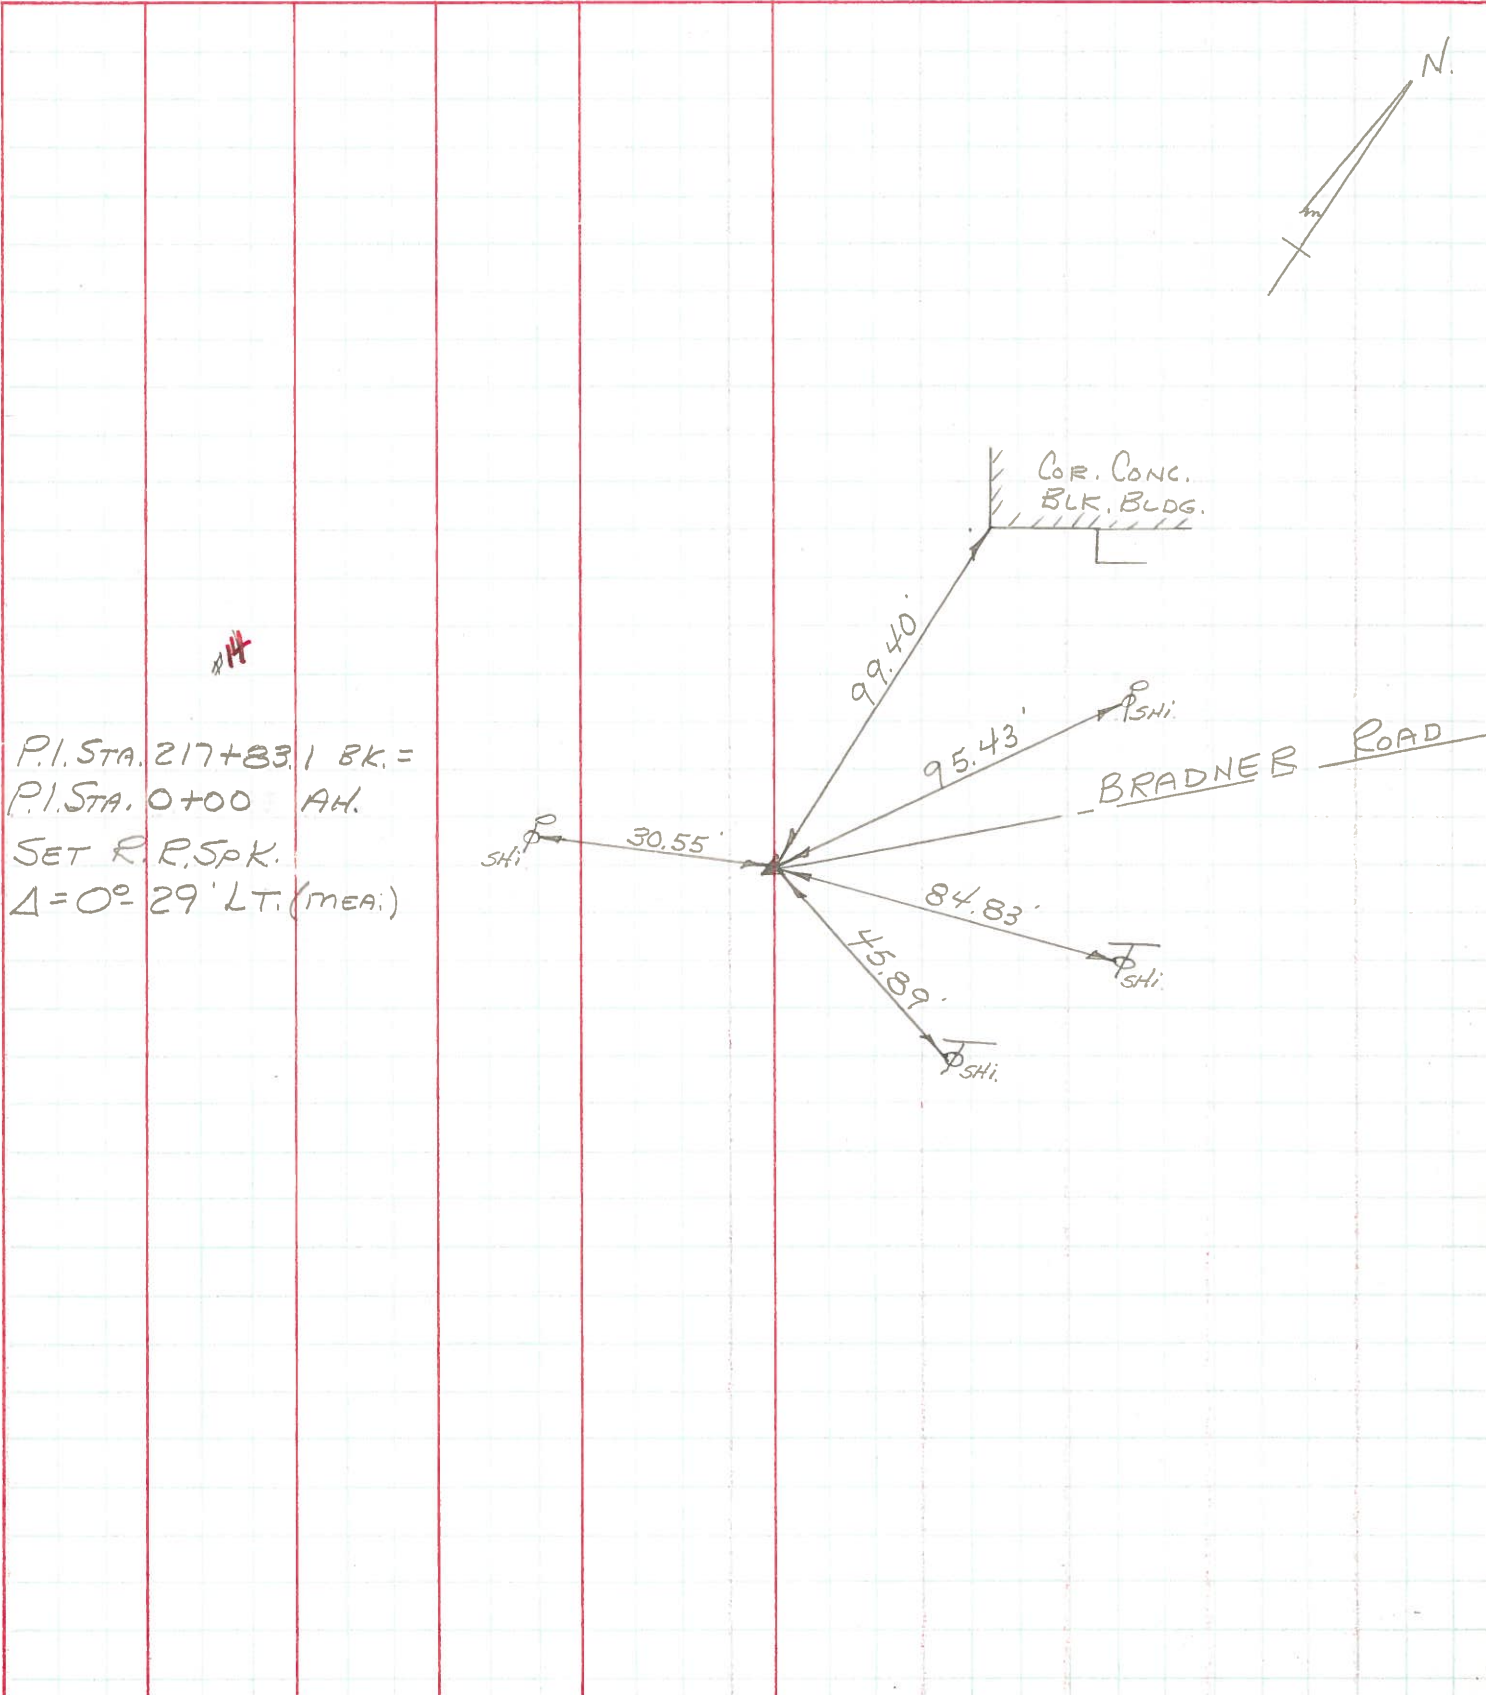

#14  
 P.I. STA. 217+83.1 BK. =  
 P.I. STA. 0+00 AH.  
 SET R. R. SPK.  
 $\Delta = 0^\circ 29' \text{ LT. (MEAN)}$