
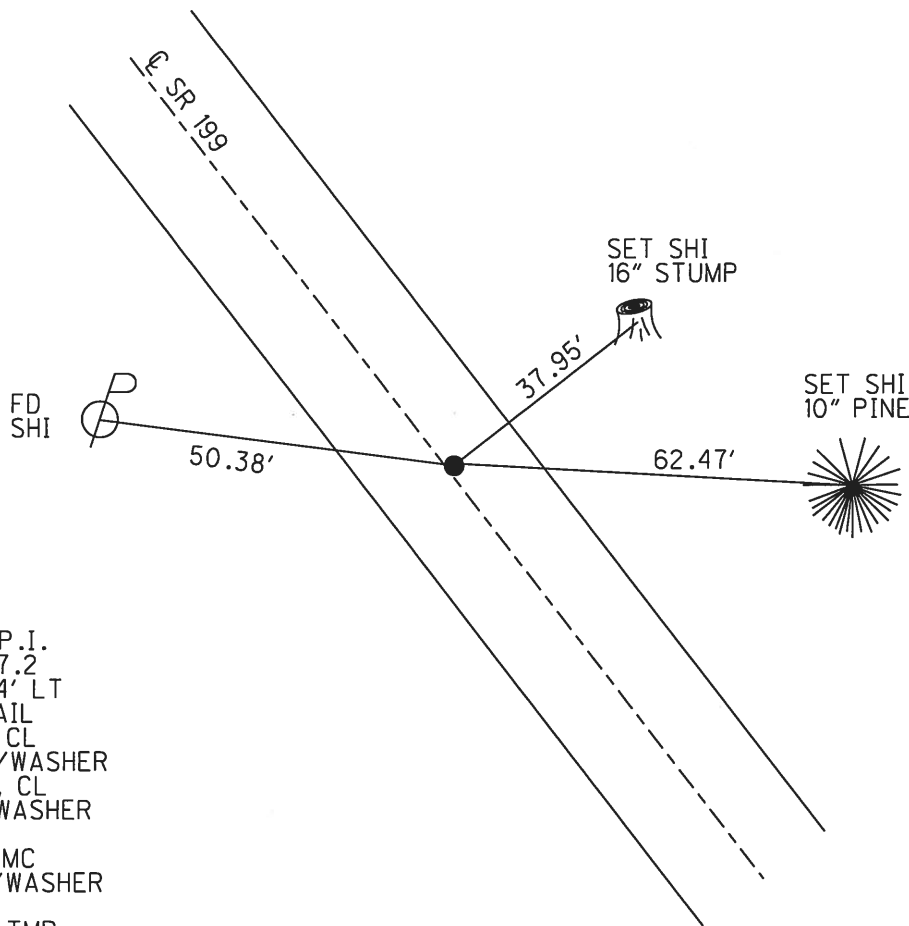


O.D.O.T. DISTRICT 2 SURVEY OFFICE (USE ONLY)

PERSONNEL _____ REFERENCE NO. 15 SHEET 20 OF 24
 NOTES ROUSOS DATE 5-6-13 ROUTE SR 199
 H.C. HOMAN WEATHER CLOUDY COUNTY WOOD
 R.C. GABLE TEMP. 65° TOWNSHIP PERRY
 SECTION 15
 T 3 N R 12 E

TYPE MONUMENT P.K./WASHER
 ON SURFACE - ~~BELOW~~ ON _____
~~LEFT~~ - Q PAV'T - RIGHT 1.5'
10.2' TO LT EDGE PAVEMENT
 S.L.M. 250+80.28
 Grid: Northing: 569076.746 Easting: 1702844.922

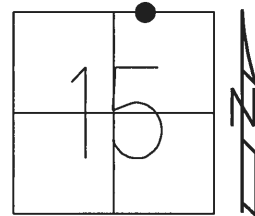

RECORD: P.I.
 STA 14+47.2
 $\Delta = 0^\circ 34' \text{ LT}$
 FD P.K.NAIL
 7/13/88, CL
 SET P.K./WASHER
 7/30/90, CL
 FD P.K./WASHER
 REF15
 10/13/11, MC
 SET MAG/WASHER
 FINREF15
 4/29/14, TMR

O.D.O.T. DISTRICT 2 SURVEY OFFICE

PERSONNEL _____

REFERENCE NO. 15

SHEET _____ OF _____

NOTES LOEHKE

H.C. BARNISEL

R.C. REED

DATE 7-13-88

WEATHER pt Cloudy Humid

TEMP. +88

ROUTE S.R. 199

COUNTY Wood

TOWNSHIP Perry

SECTION 15

T 3 N R 12 E

TYPE MONUMENT PK



ON SURFACE - BELOW

LEFT - 0 PAV'T. - RIGHT 0.3

10.0 TO EAST EDGE PAVEMENT

S.L.M. 248190

set P.K. / WASHER
7-30-90
C.L.

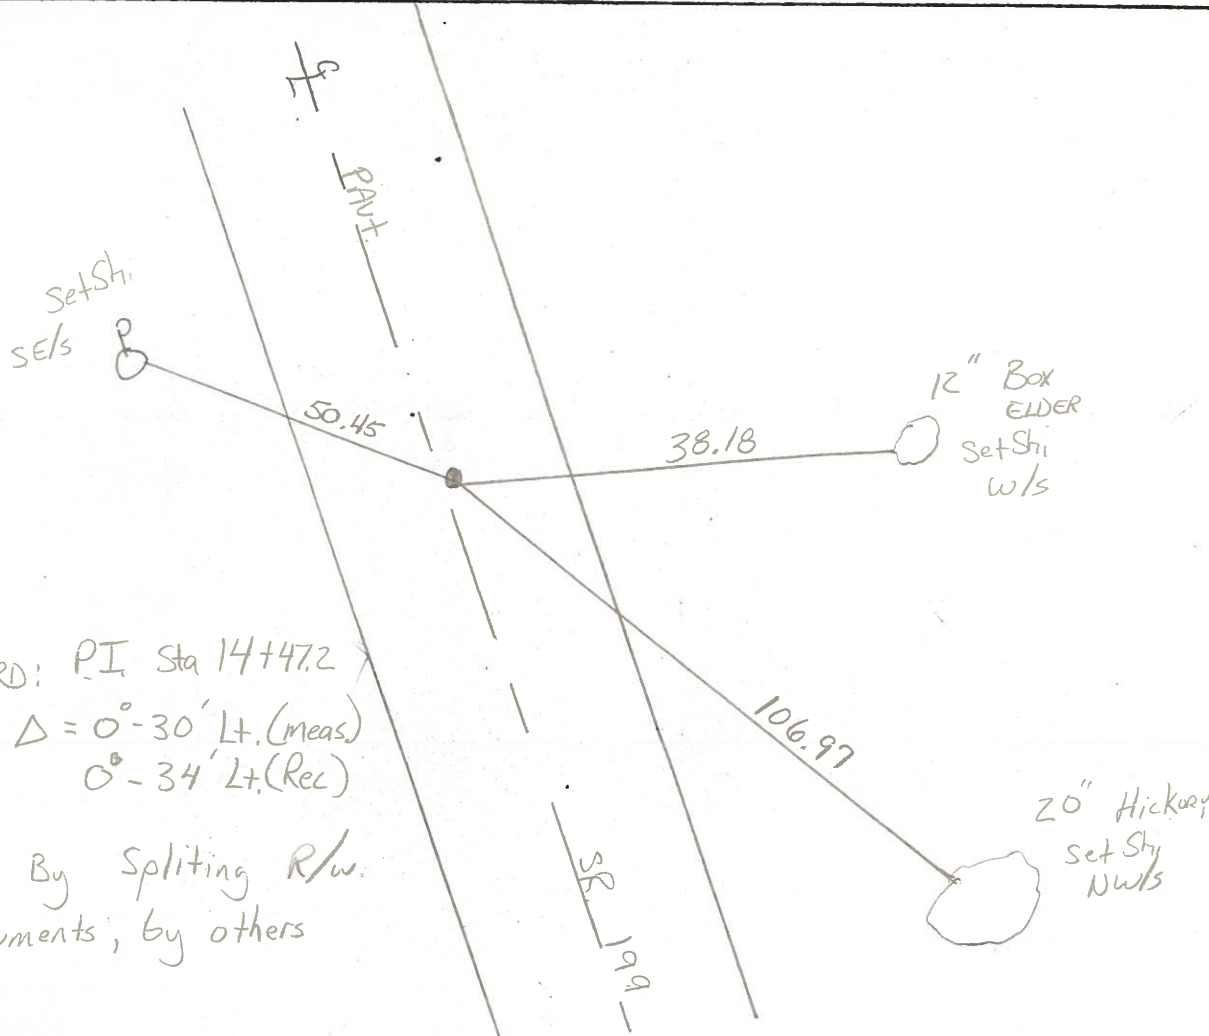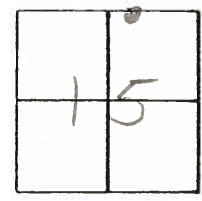

RECORD: P.I. Sta 14+47.2
 $\Delta = 0^{\circ}-30'$ Lt. (meas.)
 $0^{\circ}-34'$ Lt. (Rec)

Est. By Splitting R/w.
 Monuments, by others

County WOOD S.R. 199

Township PERRY

Section 15

T N, R E

Personnel BURNSIDE

SMITH


BOWER

MEAD


Date 11-15-71 (5-9-80)^{CHKD}

Weather CLEAR

Temp. +60°

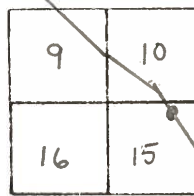

#15

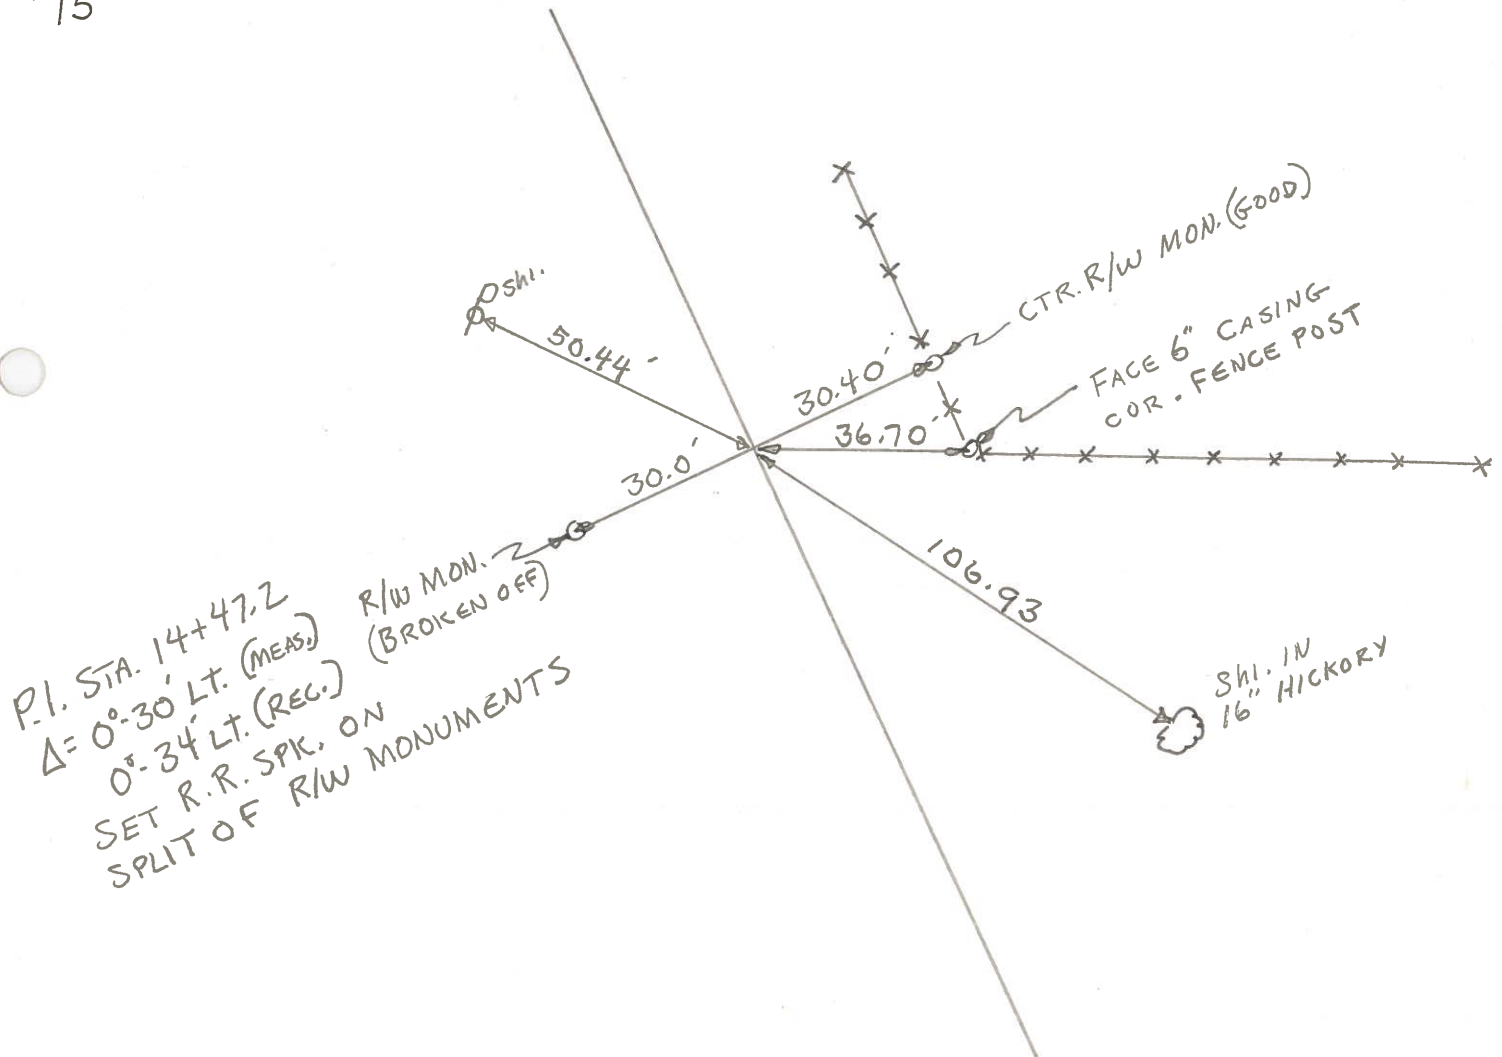

P.I. STA. 14+47.2
 $\Delta = 0^{\circ}30' \text{ LT. (MEAS.)}$
 $0^{\circ}34' \text{ LT. (REC.)}$
 SET R.R. SPK. ON
 SPLIT OF R/W MONUMENTS

R/W MON. 2
 (BROKEN OFF)

CTR. R/W MON. (GOOD)

FACE 6" CASING
 COR. FENCE POST

SHI. IN
 16" HICKORY

PERSONNEL	TITLE	PERSONNEL	TITLE
BURNSIDE			
SMITH			
HOLCOMBE			

COUNTY Wood DATE 11-15-71

S. R. 199 WEATHER CLEAR

SEC. _____ TEMP. +60°

DESCRIPTION _____ LEFT _____ CENTER LINE _____ RIGHT _____ JOB NO. _____

