


O.D.O.T. DISTRICT 2 SURVEY OFFICE (USE ONLY)


PERSONNEL _____ REFERENCE NO. 17 SHEET 22 OF 24
 NOTES ROUSOS DATE 5-6-13 ROUTE SR 199
 H.C. HOMAN WEATHER CLOUDY COUNTY WOOD
 R.C. GABLE TEMP. 73° TOWNSHIP PERRY
 SECTION 10
 T 3 N R 12 E

TYPE MONUMENT P.K.NAIL
 ON SURFACE - ~~BELOW~~ ON _____
 LEFT - C PAV'T - ~~RIGHT~~ 0.3'
10.8 TO LT EDGE PAVEMENT
 S.L.M. 275+77.04

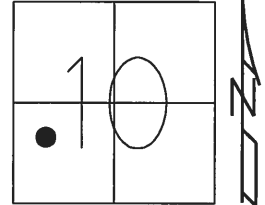

Grid: Northing: 570677.417 Easting: 1700989.326

RECORD: P.O.T.
 FD P.K.NAIL
 7/13/88, CL
 SET P.K./WASHER
 7/30/90, CL
 FD P.K.SHANK
 REF17
 10/13/11, MC
 SET MAG/WASHER
 FINREF17
 4/29/14, TMR

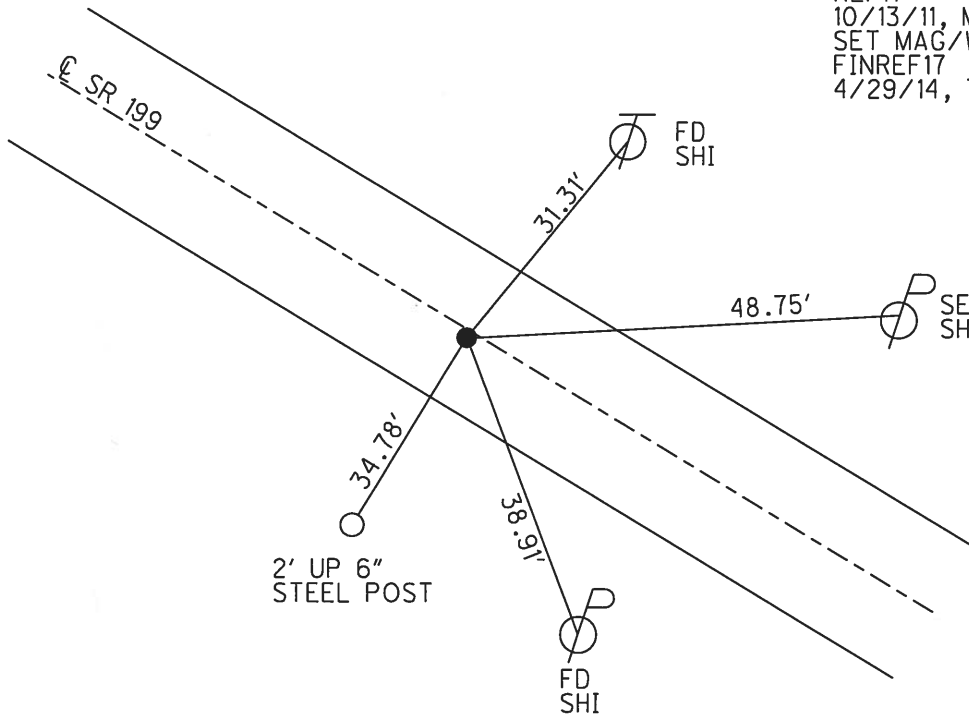

O.D.O.T. DISTRICT 2 SURVEY OFFICE

PERSONNEL _____

REFERENCE NO. 17

SHEET _____ OF _____

NOTES LOEHRKE

H.C. BARNHISEL

R.C. Reed

DATE 7-13-88

WEATHER pt Cloudy Humid

TEMP. 79.0

ROUTE 199

COUNTY WOOD

TOWNSHIP Perry

SECTION 10

T. 3 N. R. 12 E.

Set P.K. / WASHER
7-30-90


TYPE MONUMENT P.K.

ON SURFACE - BELOW _____


LEFT - & PAV'T. - RIGHT 0.3

10.8 TO Lt EDGE PAVEMENT

S.L.M. 273 + 87

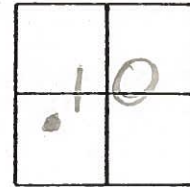


Record:
P.O.T.
Sta 39+45.5

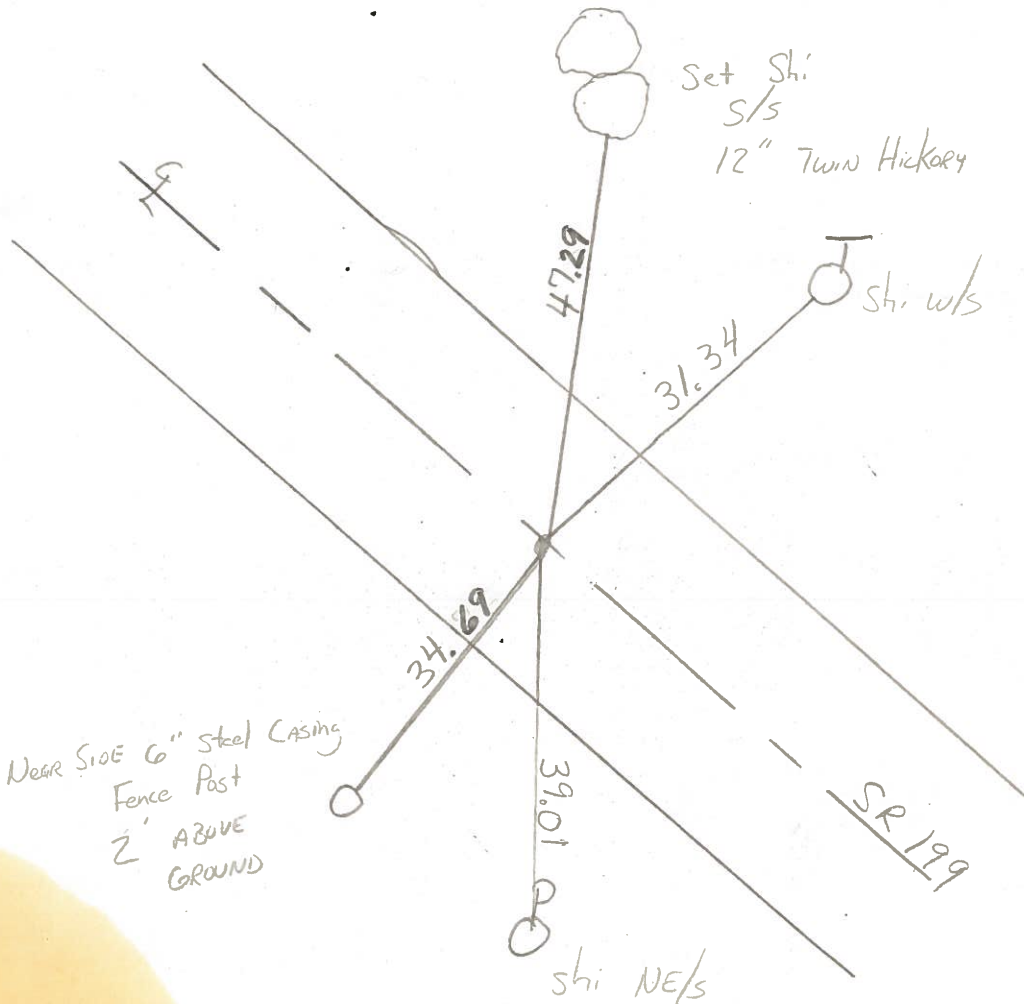

PERSONNEL TITLE PERSONNEL TITLE
 BURNSIDE
 BOWERS

COUNTY Wood DATE 11-26-71
 S. R. 199 WEATHER Cloudy
 SEC. TEMP. +33°

DESCRIPTION LEFT CENTER LINE RIGHT JOB NO.

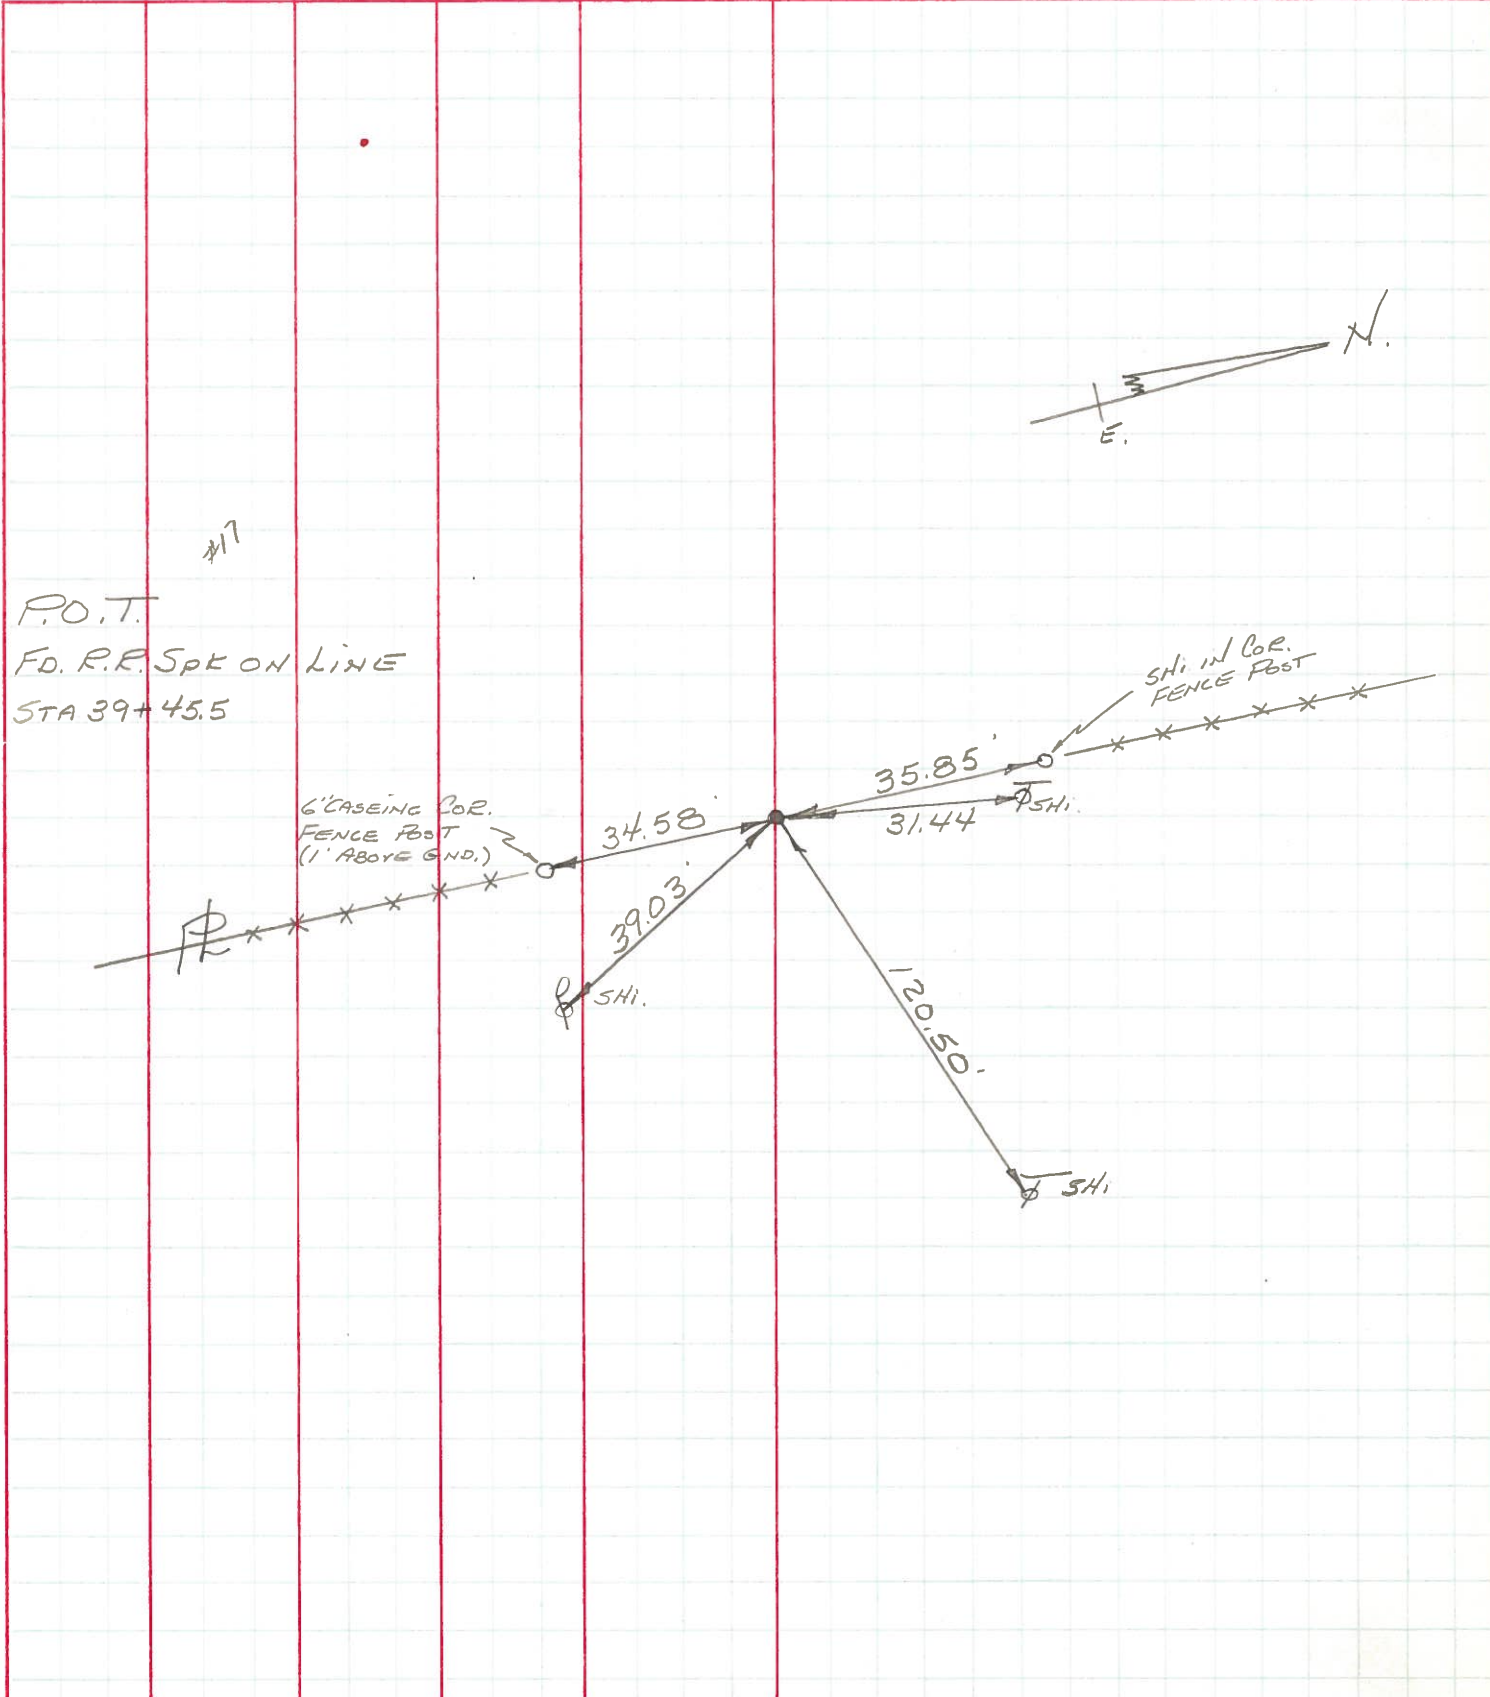

County WOOD S.R. 199

Date 11-15-71 (CKD 5-9-80)

Township PERRY


Weather _____

Section 10

Temp. _____

T N, R E

Personnel BURNSIDE

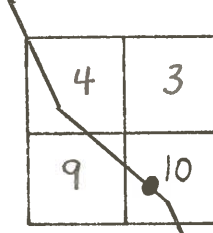

#17

P.O.T.
FD. R.R. SPK. ON LINE
STA 39+45.5

