


O.D.O.T. DISTRICT 2 SURVEY OFFICE (USE ONLY)

PERSONNEL	REFERENCE NO.	<u>20</u>	SHEET	<u>2</u>	OF	<u>45</u>
NOTES	LEU	DATE	<u>4-25-16</u>	ROUTE	<u>SR 199</u>	
H.C.	<u>HOMAN</u>	WEATHER	<u>PARTLY CLDY</u>	COUNTY	<u>WOOD</u>	
R.C.	<u>LEU</u>	TEMP.	<u>80°F</u>	TOWNSHIP	<u>PERRY</u>	
				SECTION	<u>4</u>	
				T	<u>3</u>	N
				R	<u>12</u>	E

TYPE MONUMENT SM.R.R.SPIKE
 ON SURFACE - ~~BELOW~~ ON
 LEFT - Q PAV'T - ~~RIGHT~~ 9.0'
17.0' TO LT EDGE PAVEMENT
 S.L.M. 341+51

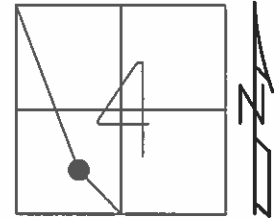


Grid: Northing: 575383.7211 Easting: 1696279.439

RECORD:
 FD ADJ BRASS MON
 1.5" BELOW
 $\Delta=19^{\circ}00'$ RT
 CURVE DATA OLD PLAN
 $\Delta=19^{\circ}00'$
 $D=12^{\circ}0'$
 $R=478.34$
 $T=80.05$
 $L=158.33$
 $E=6.64$

SET SM RR SPIKE
 8-25-87, MDB

FD SM RR SPK
 GPS, REF20
 04-25-16

SET MAG/WASHER
 GPS, NEWREF20
 09-26-16, DCH

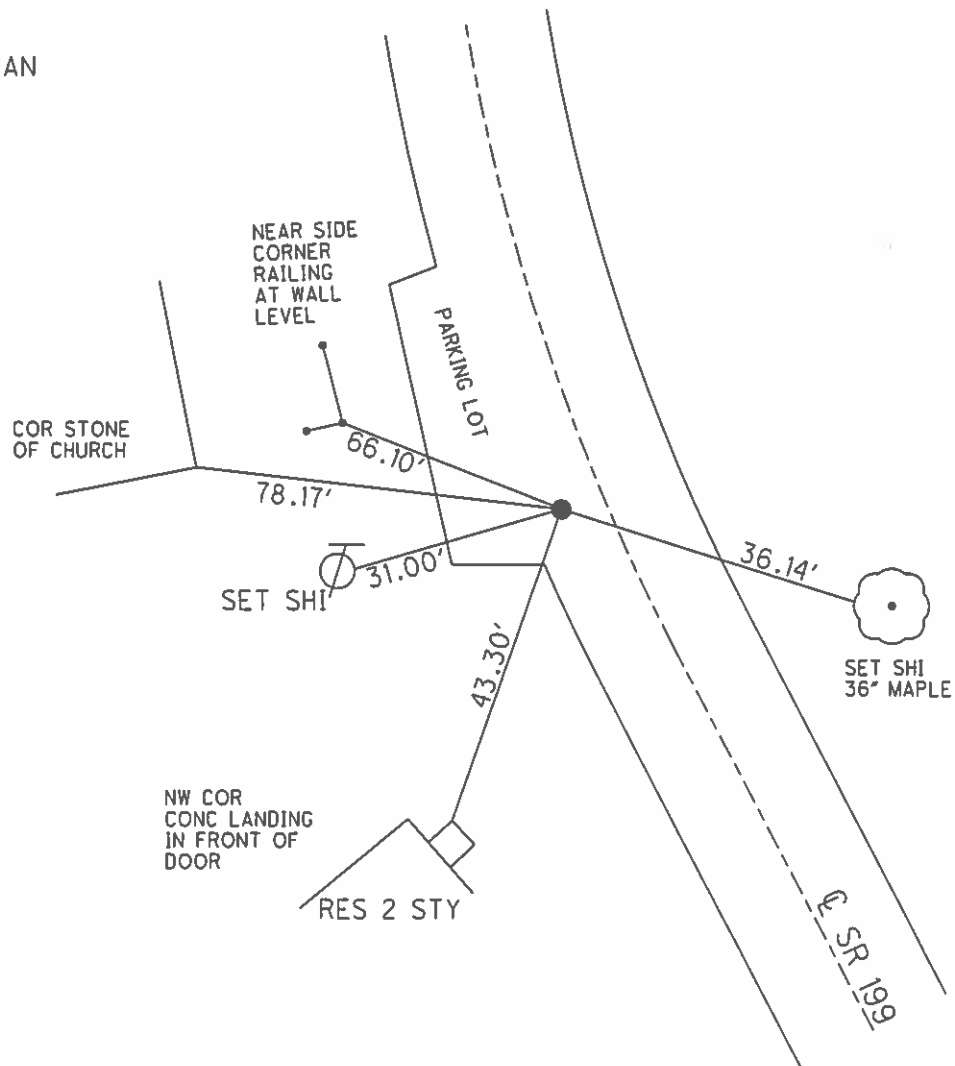

O.D.O.T. DISTRICT 2 SURVEY OFFICE

PERSONNEL

REFERENCE NO. 20

SHEET OF

NOTES BARNHISEL

H.C. Loehrke

R.C. Hoffmann

DATE 7-14-87

WEATHER Cloudy

TEMP. +70°

ROUTE 199

COUNTY WOOD

TOWNSHIP Perry

SECTION 4

T.3 N. R. 12 E


TYPE MONUMENT BRASS MON

ON SURFACE - BELOW 1 1/2"

LEFT - ℄ PAV'T. - RIGHT 9.0

17.0 TO Lt EDGE PAVEMENT

S.L.M. 341+51

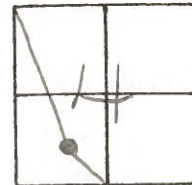


Set Sm R.R. Spk
8-25-87
M.D.B.

Record
Fd Ad; Brass Mon 1 1/2" deep
 $\Delta = 19^\circ - 00' \text{ Rt.}$

CURVE DATA
OLD PLAN
 $\Delta = 19^\circ - 0'$
 $D = 12^\circ - 0'$
 $R = 478.34$
 $T = 80.05$
 $L = 158.33$
 $E = 6.64$

COR. STONE
Fdn.
CHURCH

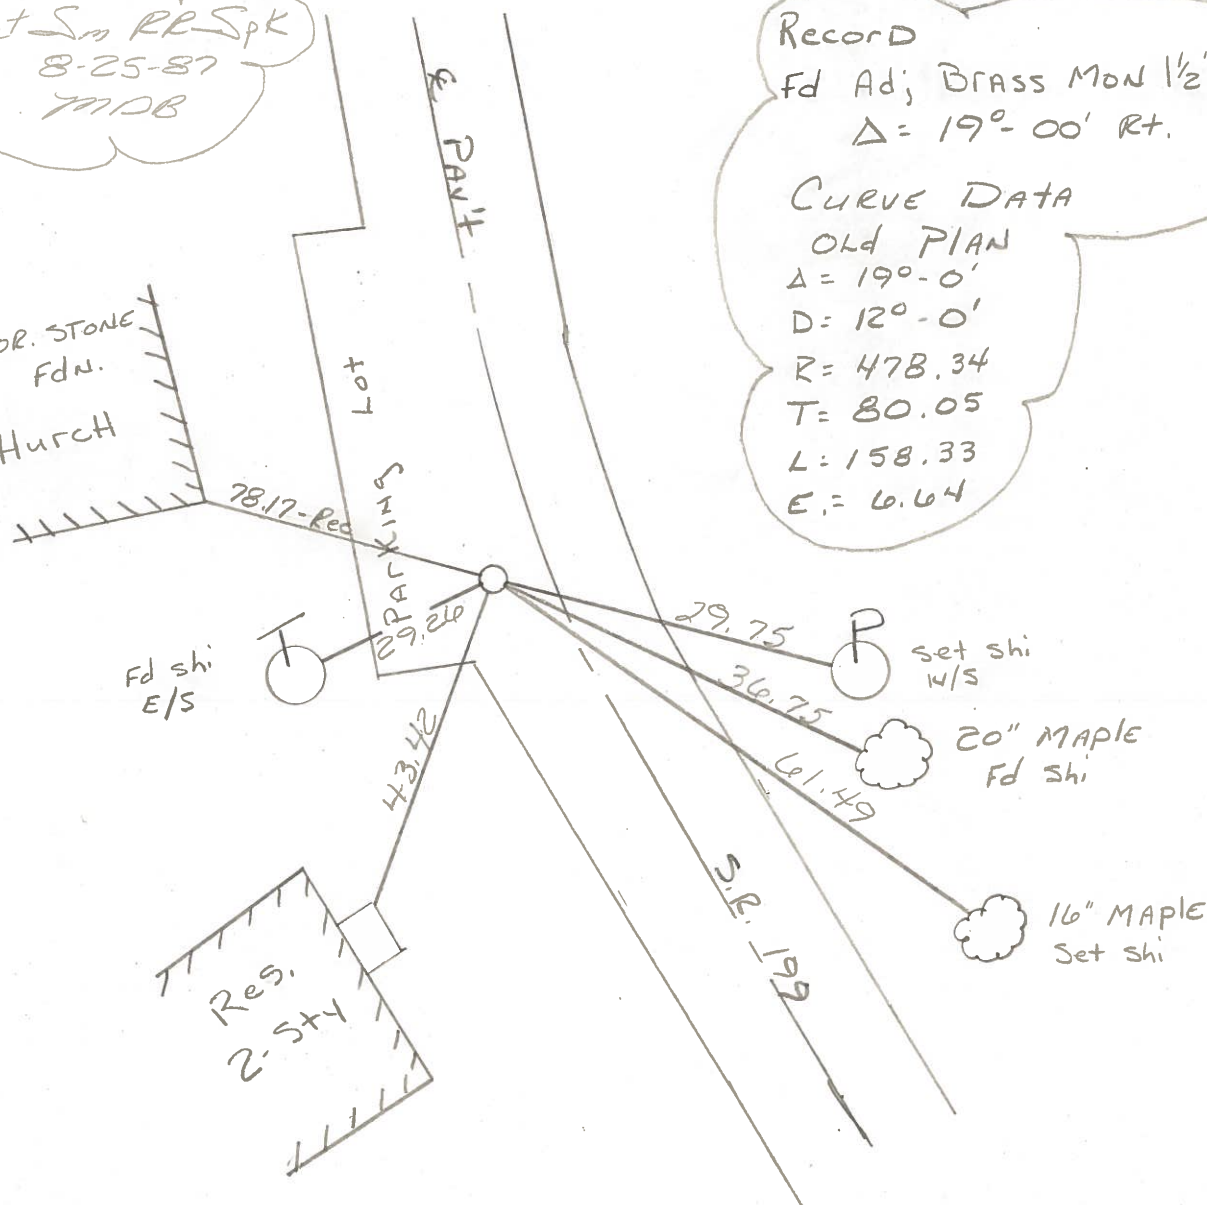

County WOOD S.R. 199

Township PERRY

Section 4


T N, R E

Personnel BURNSIDE
BOWERS


Date 11-26-71 ^{CHKD.} (5-22-78)

Weather CLOUDY

Temp. _____

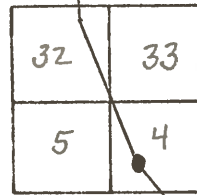

#20

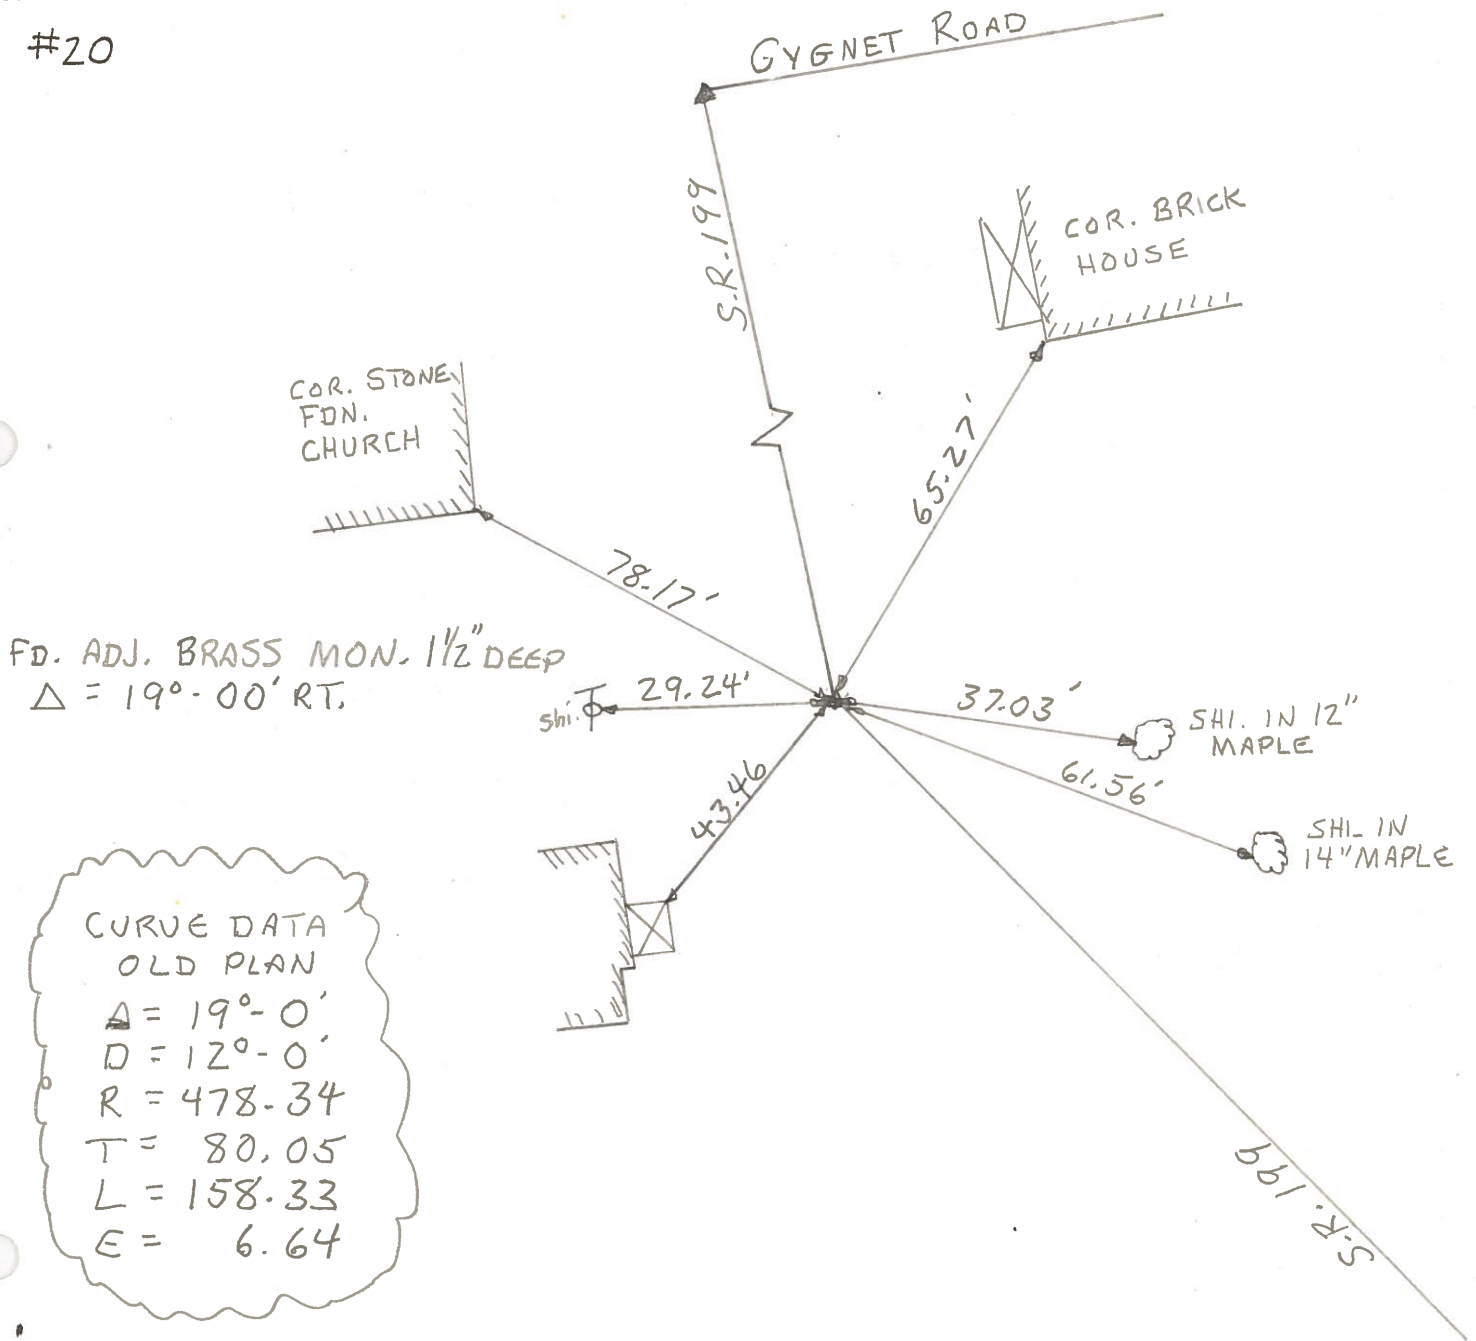

FD. ADJ. BRASS MON. 1 1/2" DEEP
 $\Delta = 19^{\circ}-00' RT.$

CURVE DATA
OLD PLAN
 $\Delta = 19^{\circ}-0'$
 $D = 12^{\circ}-0'$
 $R = 478.34$
 $T = 80.05$
 $L = 158.33$
 $E = 6.64$

PERSONNEL TITLE PERSONNEL TITLE
 BURNSIDE _____
 BOWERS _____

COUNTY WOOD DATE 11-26-71
 S. R. 199 WEATHER CLOUDY
 SEC. WEST MILLGROVE TEMP. + 32°

DESCRIPTION LEFT CENTER LINE RIGHT JOB NO.

