

O.D.O.T. DISTRICT 2 SURVEY OFFICE (USE ONLY)

PERSONNEL

REFERENCE NO. 23

SHEET 6 OF 45

NOTES HUSS
 H.C. CANTERBURY
 R.C. HUSS

DATE 8/18/09
 WEATHER CLOUDY
 TEMP. 80°

ROUTE SR 199
 COUNTY WOOD
 TOWNSHIP MONTGOMERY
 SECTION 4
 T 4 N R 12 E

DWG BY RHOADES PID 101286

TYPE MONUMENT SM.R.R.SPIKE


ON SURFACE - ~~BELOW~~ ON

OFFSET $\frac{1}{2}$ PAVEMENT ON _____ LT : RT
11.7' TO RT EDGE PAVEMENT


STATION: 388+01

HORZ.DATUM: NAD83(2011) GEOID: 2012A

GRID: NORTHING: 579695.251 EASTING: 1694533.440

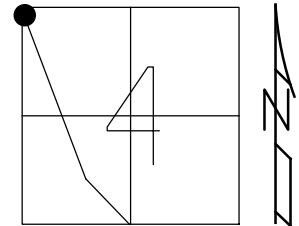


RECORD: P.I.
 STA: 153+16.55
 $\Delta = 0^\circ 07' RT$
 FD SM.R.R.SPIKE
 7/14/87, MDB
 SET SM.R.R.SPIKE
 8/17/87, MDB
 FD SM.R.R.SPIKE
 3/16/06, RGN
 8/18/09, MC
 SET MAG/WASHER
 11/12/09, SAH
 FD MAG/WASHER
 REF23
 9-16-21, DSA

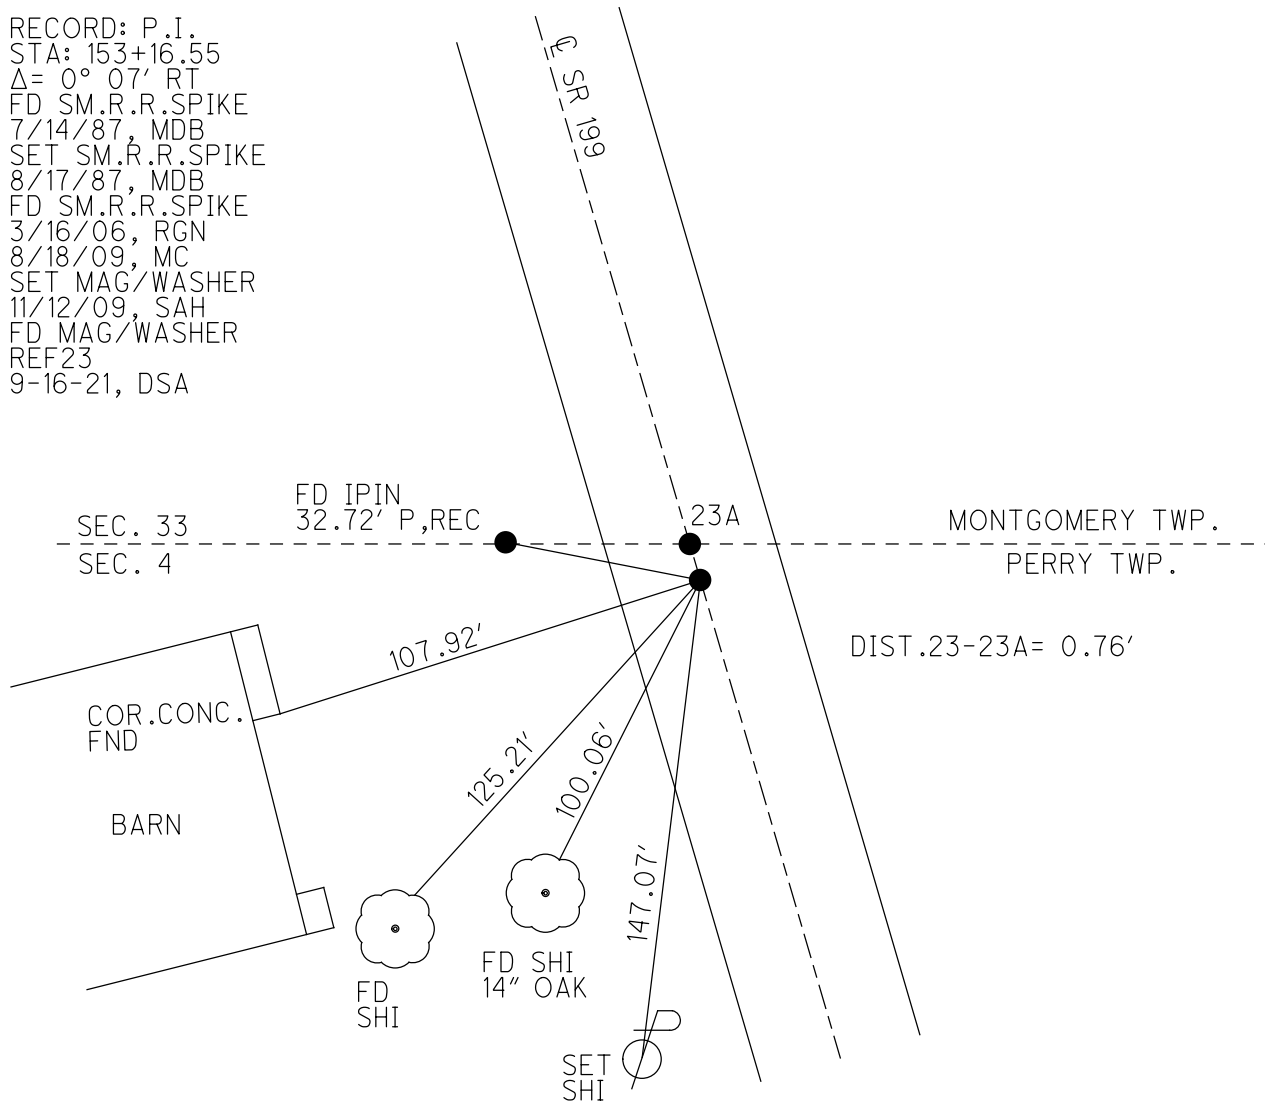

O.D.O.T. DISTRICT 2 SURVEY OFFICE (USE ONLY)

PERSONNEL	REFERENCE NO. <u>23</u>	SHEET <u>6</u> OF <u>45</u>
NOTES <u>HUSS</u>	DATE <u>08-18-09</u>	ROUTE <u>SR 199</u>
H.C. <u>CANTERBURY</u>	WEATHER <u>CLOUDY</u>	COUNTY <u>WOOD</u>
R.C. <u>HUSS</u>	TEMP. <u>80° F</u>	TOWNSHIP <u>MONTGOMERY</u>
		SECTION <u>32</u>
		T <u>4</u> N R <u>12</u> E

TYPE MONUMENT SM. RRSPK
 ON SURFACE - ~~BELOW~~ ON
~~LEFT~~ - C PAV'T - ~~RIGHT~~ ON
11.7' TO RT. EDGE PAVEMENT
 S.L.M. 388+01

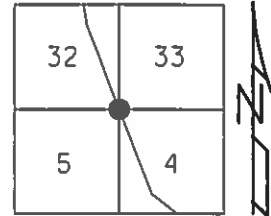


Grid: Northing: 597695.298 Easting: 1694533.376

RECORD

PI STA: 153+16.55
 $\Delta = 00^\circ-07'$ RT. (REC.)
 SET RRSPK

RECORD

07-14-87 MDB
 FD. SM. RRSPK
 08-17-87 MDB
 SET SM. RRSPK
 03-16-03 RGN
 FD.
 11-12-09 SAH
 RESET MAG/W

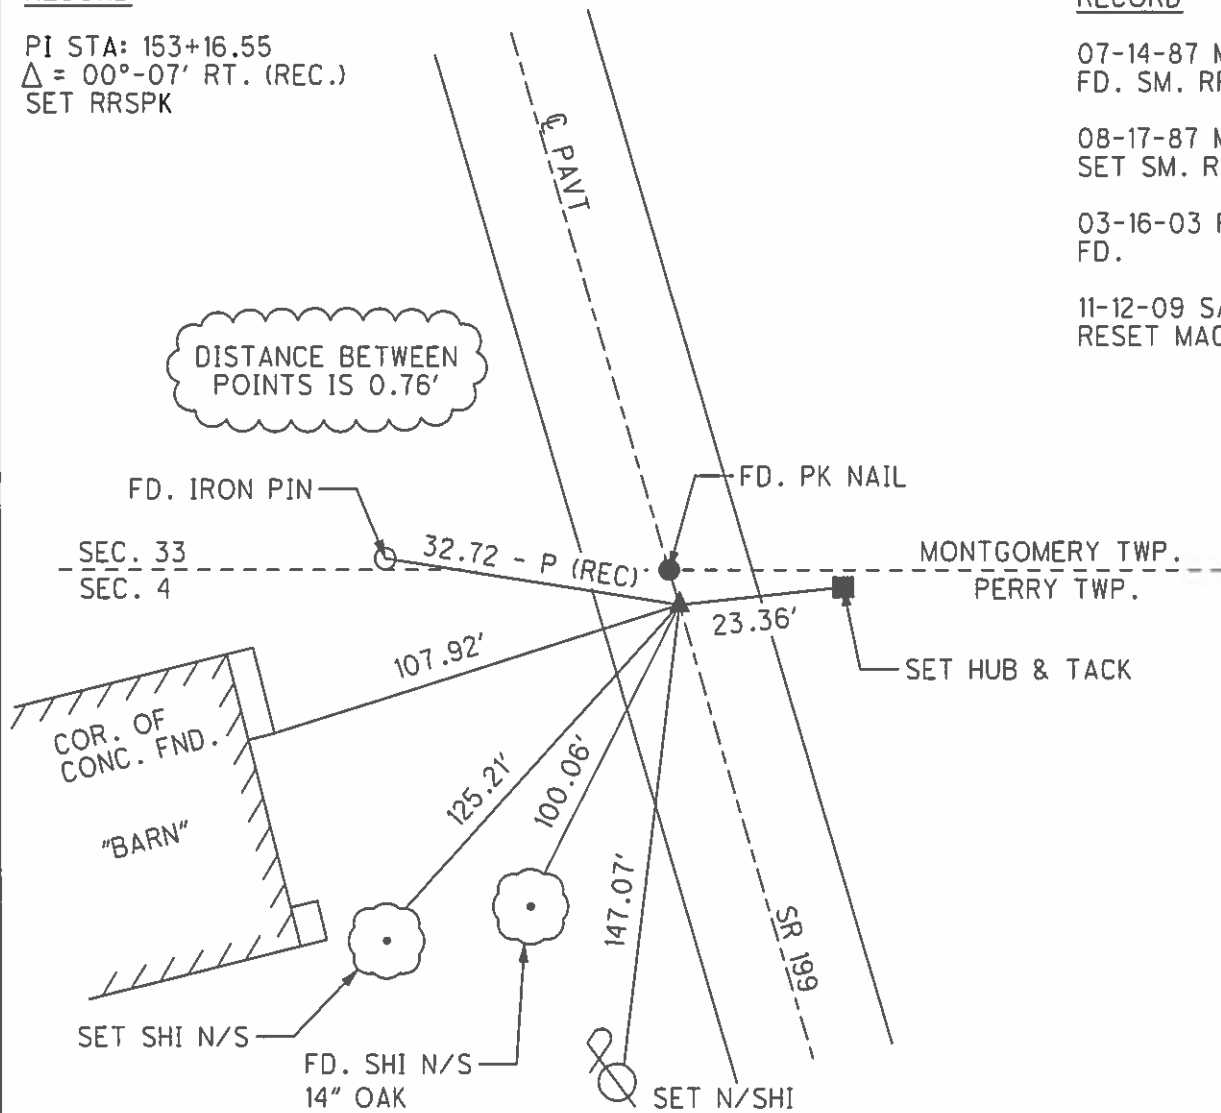

O.D.O.T. DISTRICT 2 SURVEY OFFICE

PERSONNEL

REFERENCE NO. 23

SHEET OF

NOTES BARNHISEL

H.C. Loehrke

R.C. Hoffman

DATE 7-14-87

WEATHER cloudy

TEMP. +70°

ROUTE 199

COUNTY WOOD

TOWNSHIP Montgomery

SECTION 32

T 4 N R 12 E


TYPE MONUMENT 5m RR Spk & P.K. Nail

ON SURFACE - BELOW yes

LEFT - & PAW'T. - RIGHT yes


10.6 TO RT EDGE PAVEMENT

S.L.M. 388+01 0.74 Between

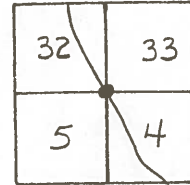

Record
 P.I. STA 153+16.55
 $\Delta = 0^\circ - 07' \text{ Rt (Rec. meas.)}$
 Set RR Spk

Set 5m RR Spk & P.K.
 8-17-87
 JLD/B

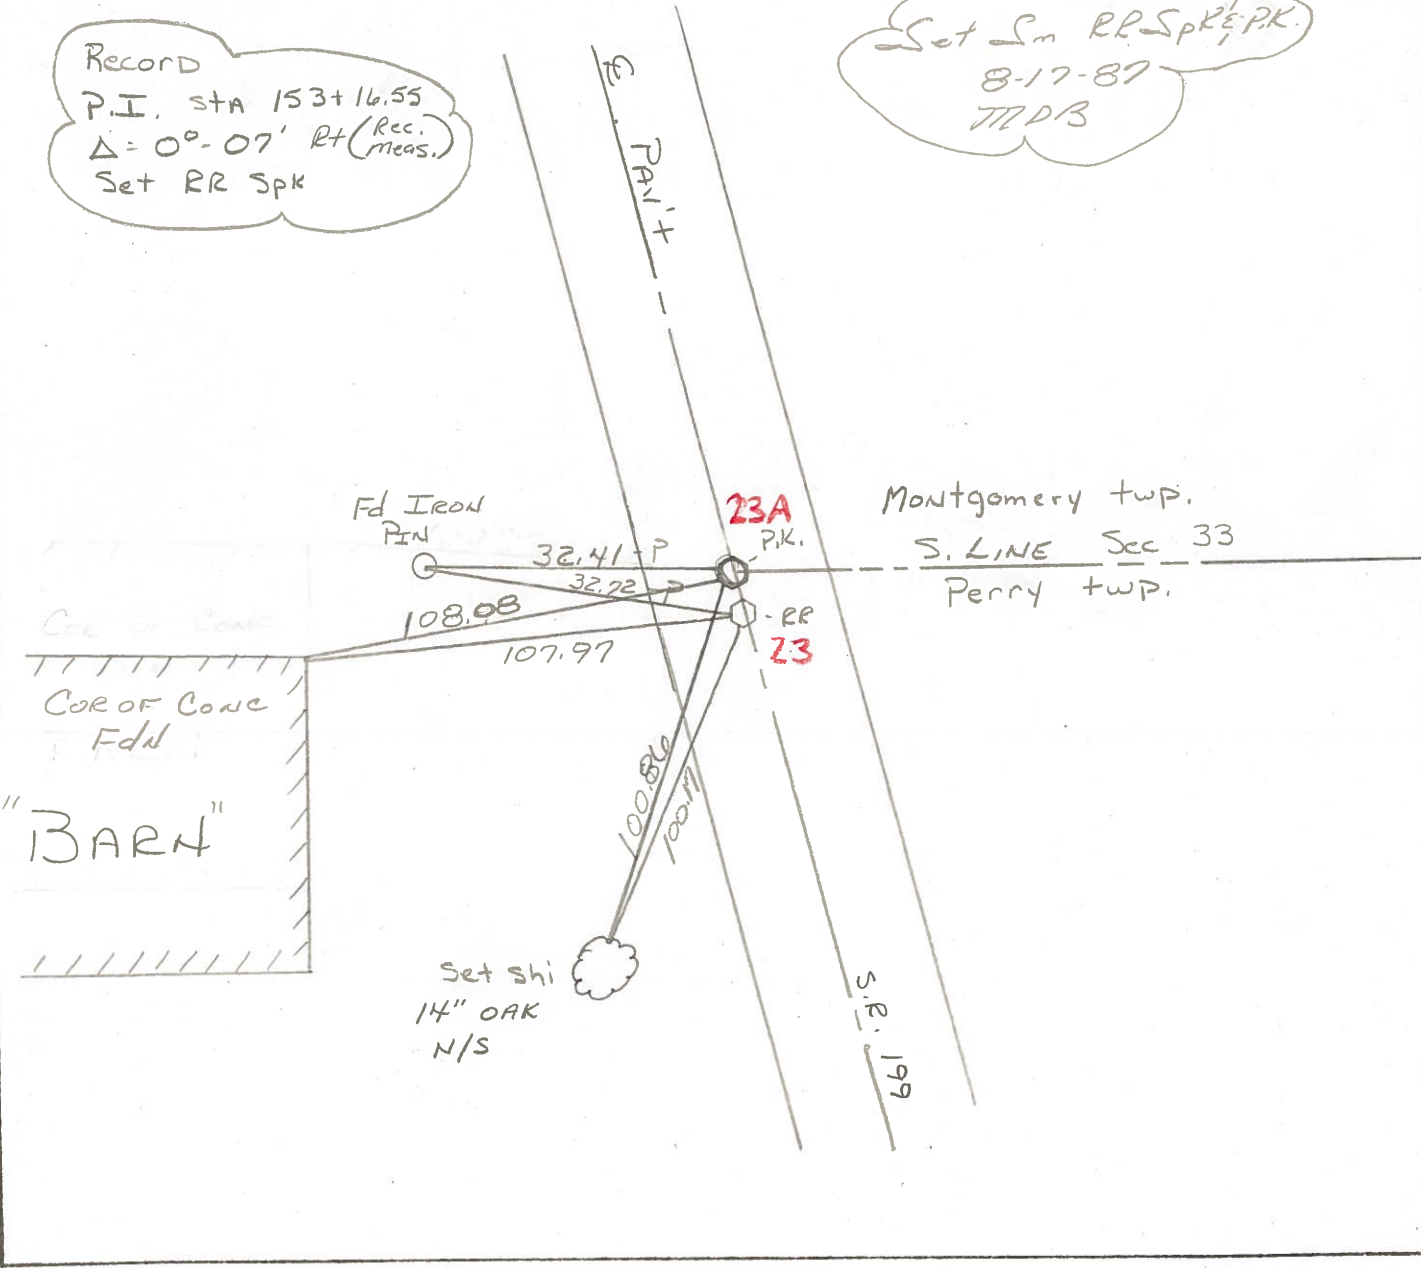

O.D.O.T. DISTRICT 2 SURVEY OFFICE

SHEET 23 OF

County _____ S.R. _____

Township MONTGOMERY

Section 32


T N, R E

Personnel BURNSIDE
BOWERS

Date 11-26-71 (5-22-78)^{CKD}

Weather CLOUDY


Temp. +36°

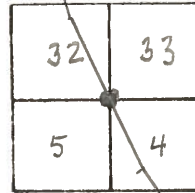

#23

P.I.

STA. 153+16.55
 $\Delta = 0^{\circ} 07' RT.$ REC. MEAS.
SET R.R. SPK.

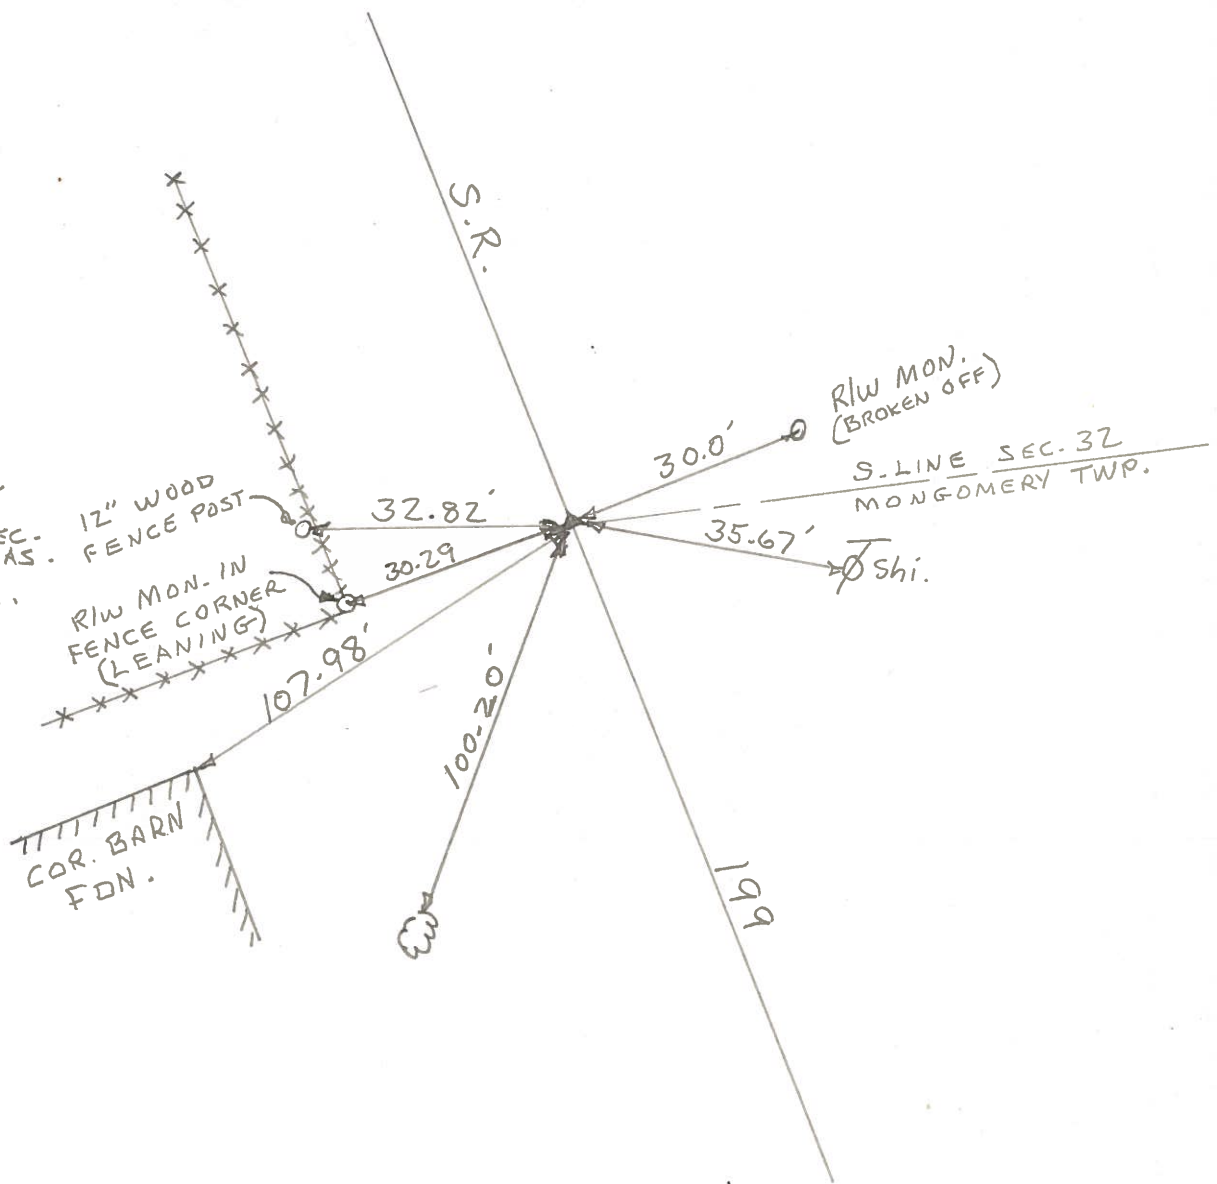

12" WOOD FENCE POST
R/W MON. IN FENCE CORNER (LEANING)

R/W MON. (BROKEN OFF)

S. LINE SEC. 32 MONTGOMERY TWP.


Shi.

PERSONNEL	TITLE	PERSONNEL	TITLE
BURNSIDE			
BOWERS			

COUNTY Wood DATE 11-26-71
 S. R. 199 WEATHER CLOUDY
MONT. TWP.
 SEC. 5-LINE SEC. 32 TEMP. +36°

DESCRIPTION _____ LEFT _____ CENTER LINE _____ RIGHT _____ JOB NO. _____

OK - 5-22-78
R.B.

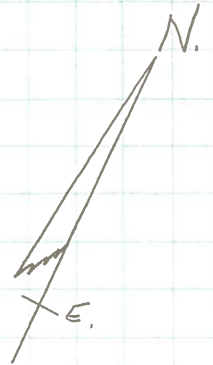

23


#23

P.I.

STA. 153+16.55

$\Delta = 0^{\circ}07'$ RT REC & MEA.

SET R.R. Spk.

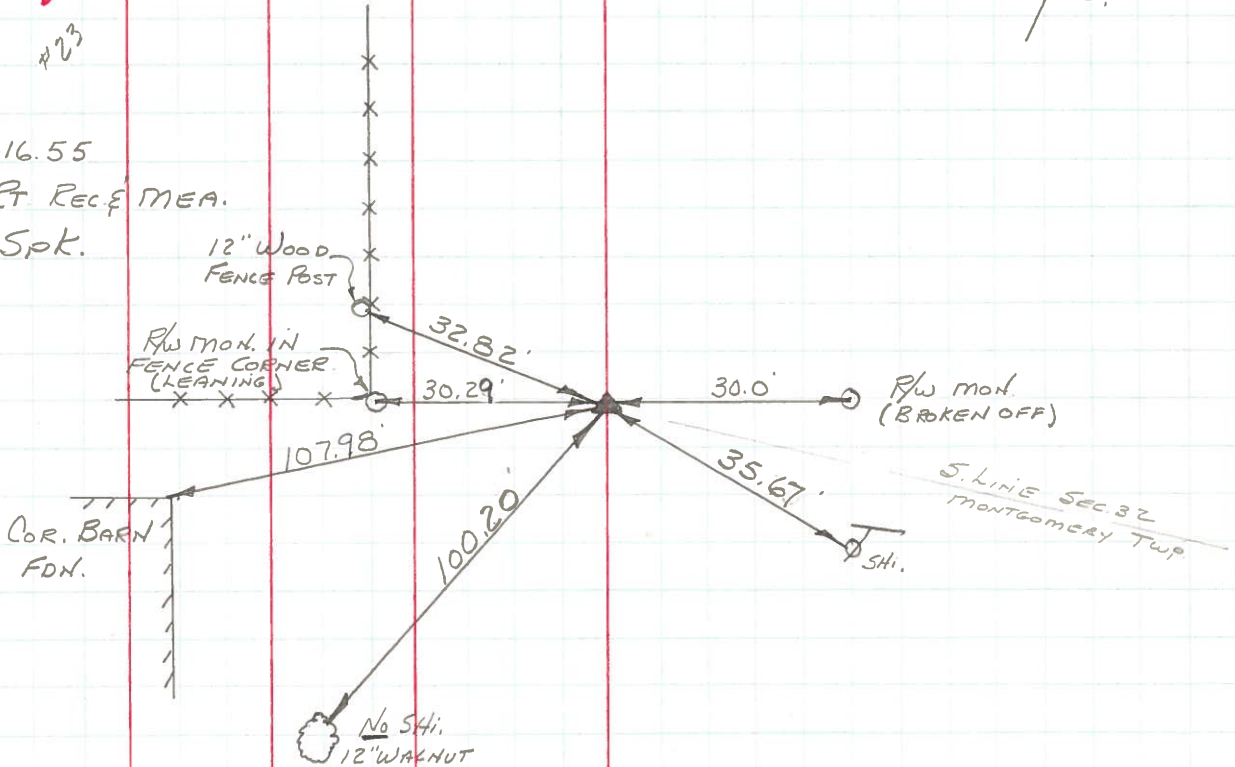

COR. BARN
FDN.

12" WOOD
FENCE POST

R/W MOD. IN
FENCE CORNER
(LEANING)

32.82'

30.29'

30.0'

R/W MOD.
(BROKEN OFF)

107.98'

100.20'

35.67'

Stk.

S. LINE SEC 32
MONTGOMERY TWP.

No Stk.
12' WALNUT