

O.D.O.T. DISTRICT 2 SURVEY OFFICE (USE ONLY)

PERSONNEL

REFERENCE NO. 25

SHEET 10 OF 45

NOTES HUSS

DATE 8/18/09

ROUTE SR 199

H.C. CANTERBURY

WEATHER CLOUDY

COUNTY WOOD

R.C. HUSS

TEMP. 80°

TOWNSHIP MONTGOMERY

SECTION 32

DWG BY RHOADES

PID 101286

T 4 N R 12 E

TYPE MONUMENT SM.R.R.SPIKE

ON SURFACE - ~~BELOW~~ ON

OFFSET Q PAVEMENT 2.0' ~~LT~~ : RT

9.7' TO RT EDGE PAVEMENT


STATION: 411+34

HORZ.DATUM: NAD83(2011)


GEOID: 2012A

GRID: NORTHING: 581858.792

EASTING: 1693661.211

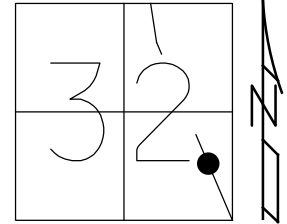


RECORD: P.I.
 STA. 176+50
 $\Delta = 01^\circ 22'$ LT REC
 $\Delta = 01^\circ 26'$ LT MEAS.
 FD SM.R.R.SPIKE
 7/14/87, MDB
 SET SM.R.R.SPIKE
 8/25/87, MDB
 FD SM.R.R.SPIKE
 3/16/06, RGN
 8/18/09, MC
 SET MAG/WASHER
 11/12/09, SAH
 FD MAG/WASHER
 REF25
 9/24/21, DSA

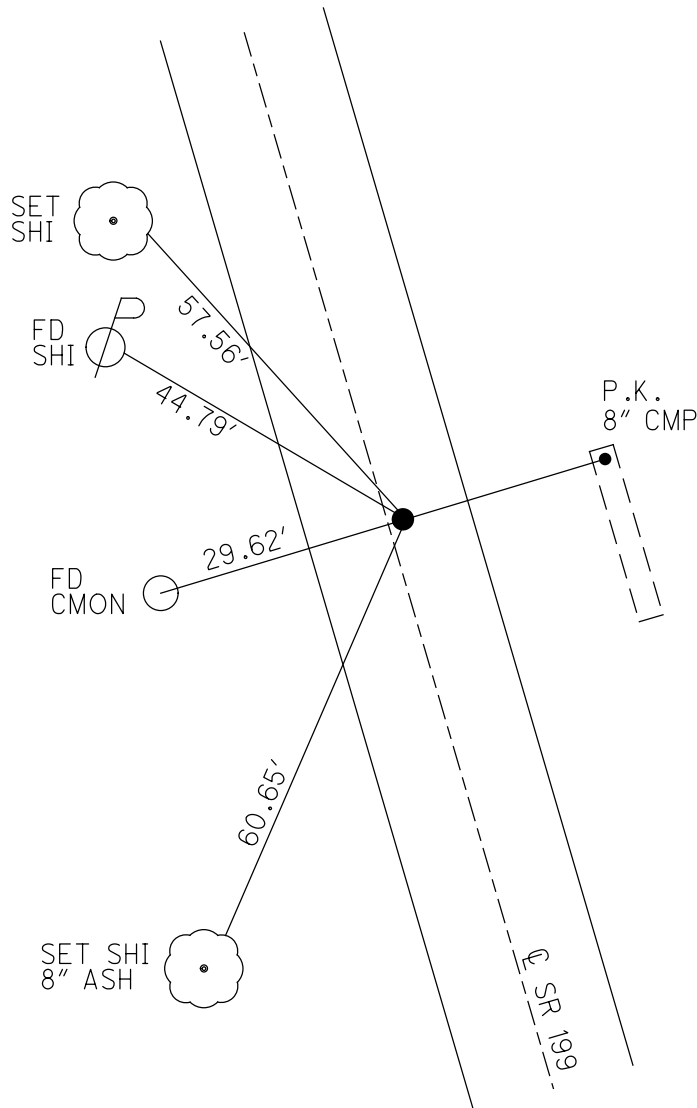

O.D.O.T. DISTRICT 2 SURVEY OFFICE (USE ONLY)


PERSONNEL _____ REFERENCE NO. 25 SHEET 10 OF 45
 NOTES HUSS DATE 08-18-09 ROUTE SR 199
 H.C. CANTERBURY WEATHER CLOUDY COUNTY WOOD
 R.C. HUSS TEMP. 80° F TOWNSHIP MONTGOMERY
 _____ SECTION 32
 _____ T 4 N R 12 E

TYPE MONUMENT _____ FD. SM. RRSPK
 ON SURFACE - ~~BELOW~~ _____ ON _____
~~LEFT~~ - Q PAV'T - RIGHT _____ 2.0'
9.7' TO RT. EDGE PAVEMENT
 S.L.M. _____ 411+34
 Grid: Northing: 581858.865 Easting: 1693661.160

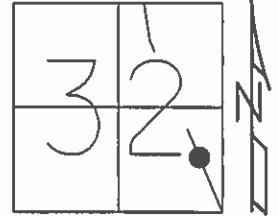

RECORD

PI STA: 176+50
 $\Delta = 01^\circ-22'$ LT. (REC.)
 $\Delta = 01^\circ-26'$ LT. (MEAS.)
 SET RRSPK

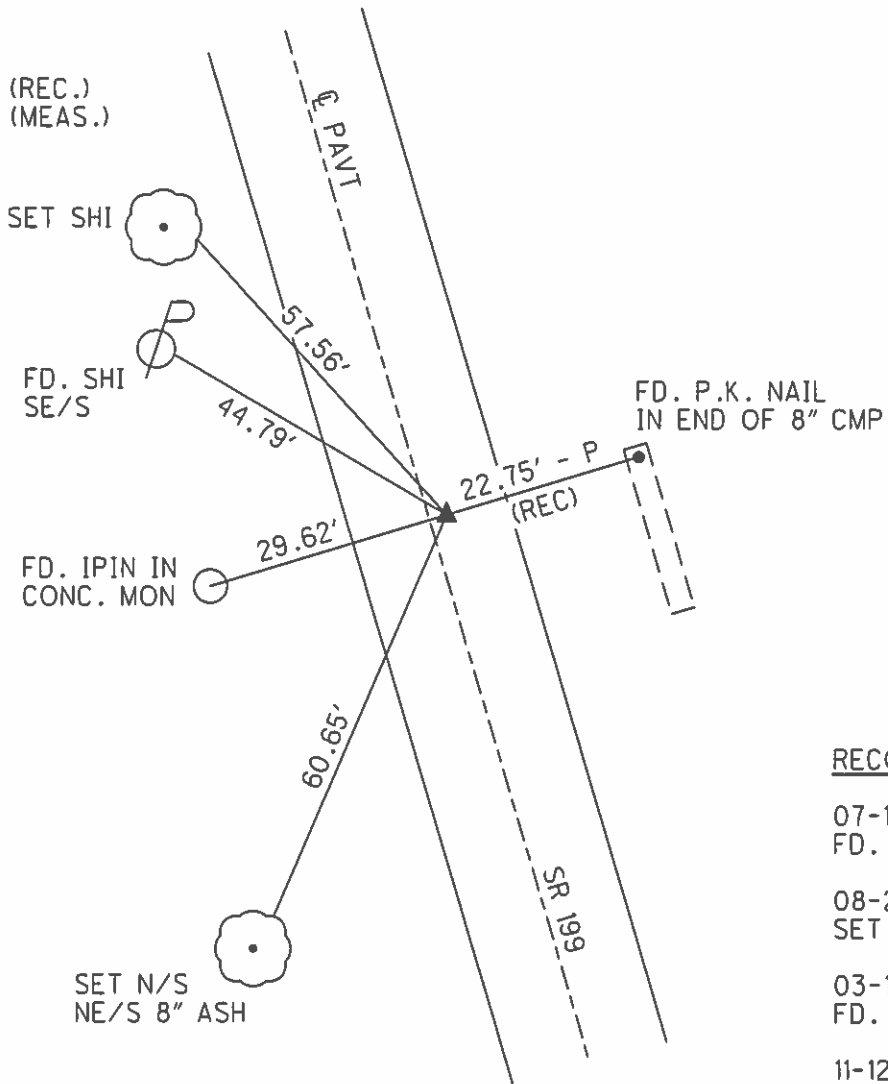

RECORD

- 07-14-87 MDB
FD. SM. RRSPK
- 08-25-87 MDB
SET SM. RRSPK
- 03-16-06 RGN
FD. SM. RRSPK
- 11-12-09 SAH
RESET MAG/W

O.D.O.T. DISTRICT 2 SURVEY OFFICE

PERSONNEL

REFERENCE NO. 25

SHEET OF

NOTES BARNHISEL

H.C. Loehrke

R.C. HOFFMAN

DATE 7-14-87

WEATHER SUNNY

TEMP. +75°

ROUTE 199

COUNTY WOOD

TOWNSHIP Montgomery

SECTION 32

T 4 N R 12 E


TYPE MONUMENT Sm RR Spk

ON SURFACE - BELOW yes

LEFT - C PAV'T. - RIGHT 2.3


9.0 TO R+ EDGE PAVEMENT

S.L.M. 411 + 34

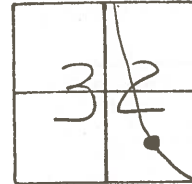

Set Sm RR Spk
 8-25-87
 JND/B

RECORD
 P.I.
 STA. 176+50
 Set RR Spk
 $\Delta = 1^{\circ} - 22' \text{ Lt (Rec)}$
 $\Delta = 1^{\circ} - 26' \text{ Lt (Meas)}$
 2' RT OR EAST OF E

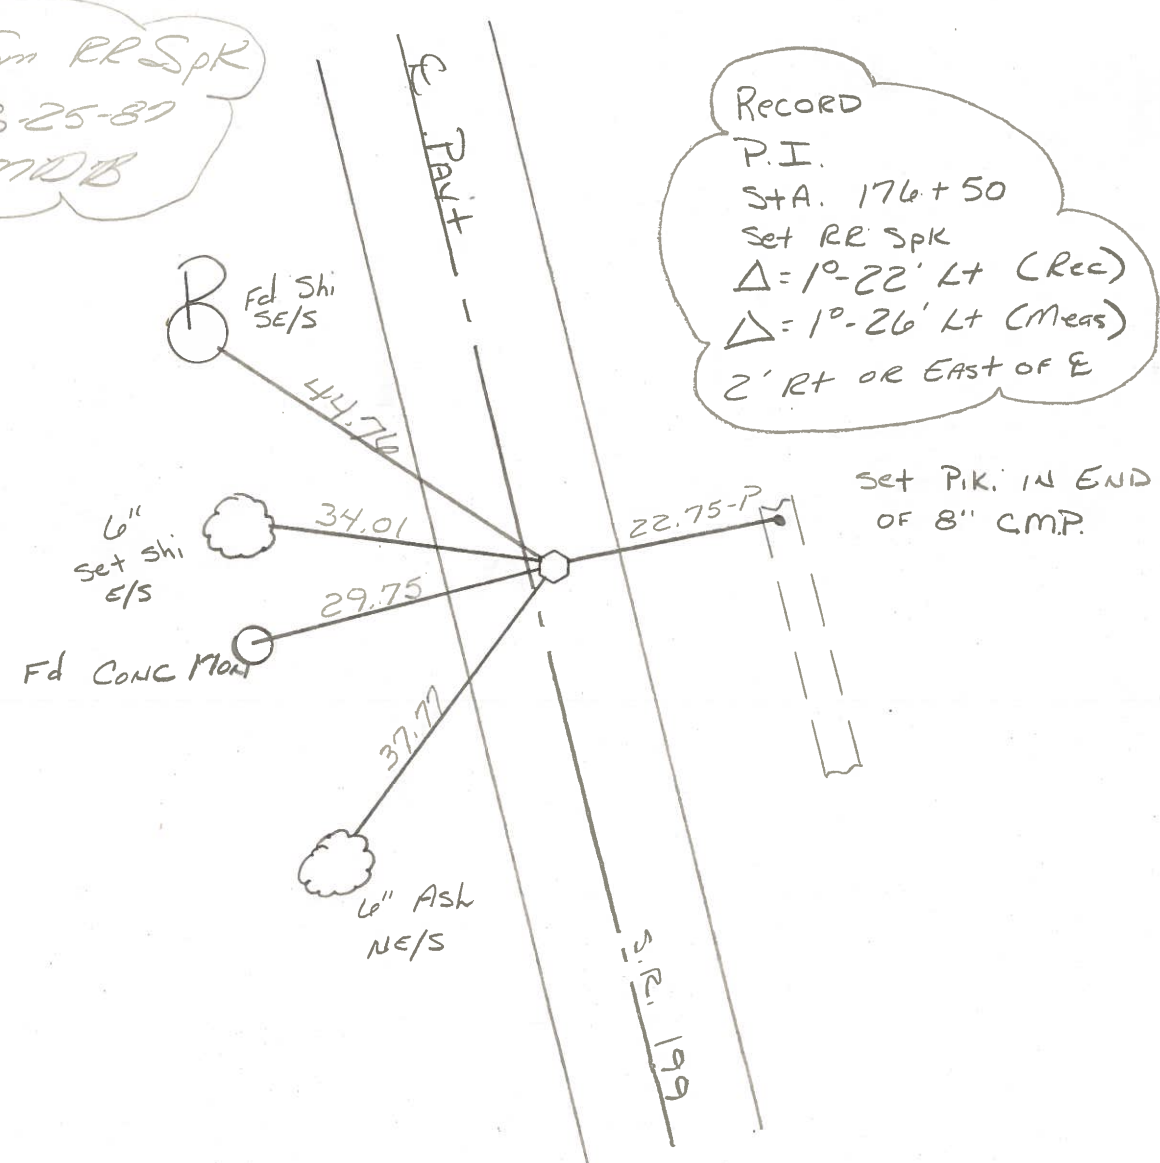

O.D.O.T. DISTRICT 2 SURVEY OFFICE

SHEET 25 OF

County WOOD S.R. 199

Date 12-29-71 (5-22-78) ^{CHKD}

Township MONTGOMERY

Weather CLEAR

Section 32

Temp. +33°

T N, R E

Personnel BURNSIDE
SMITH

30	29
31	32



#25

P.I. STA. 176+50


SET R.R. SPK.

Z' RT. OR EAST OF \perp
10-22' LT. (REC.)
10-26' LT. (MEAS.)

CTR. R/W
MON.
(LEANING)

CTR. R/W.
MON.
(LEANING)

6" CASING FOR
GATE POST
(FENCE)

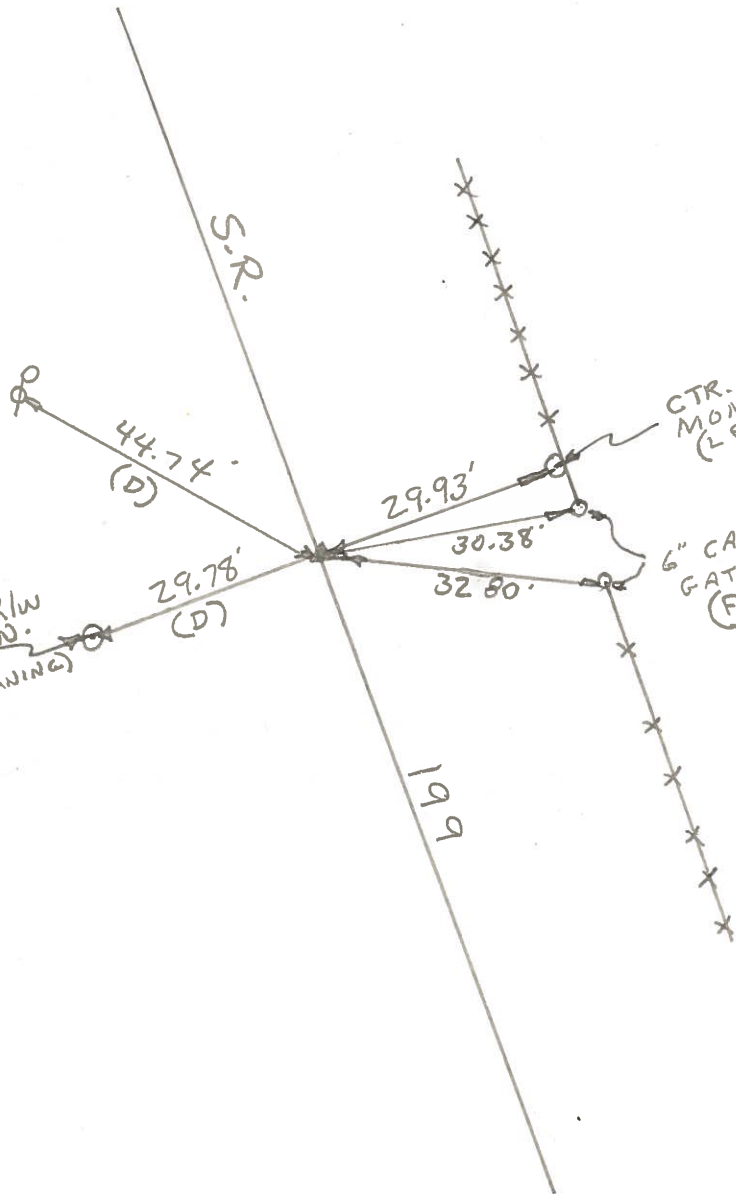

PERSONNEL	TITLE	PERSONNEL	TITLE	COUNTY	DATE
BURNSIDE				Wood	12-29-71
SMITH				S. R. 199	WEATHER CLEAR
				SEC. 32 MONTGOMERY TWP.	TEMP. +33°
DESCRIPTION 1 st P.I. NORTH OF JERRY CITY RD.				JOB NO.	

