

O.D.O.T. DISTRICT 2 SURVEY OFFICE (USE ONLY)

PERSONNEL

REFERENCE NO. 29 B

SHEET 15 OF 45

NOTES HUSS

DATE 8/18/09

ROUTE SR 199

H.C. CANTERBURY

WEATHER SUNNY

COUNTY WOOD

R.C. HUSS

TEMP. 84°

TOWNSHIP MONTGOMERY

DWG BY RHOADES

PID 101286

SECTION 29

T 4 N R 12 E

TYPE MONUMENT P.K.NAIL

ON SURFACE - ~~BELOW~~ ON

OFFSET Q PAVEMENT ON LT : RT

- TO - EDGE PAVEMENT



STATION: 484+37

HORZ.DATUM: NAD83(2011)

GEOID: 2012A

GRID: NORTHING: 588842.461

EASTING: 1691621.354

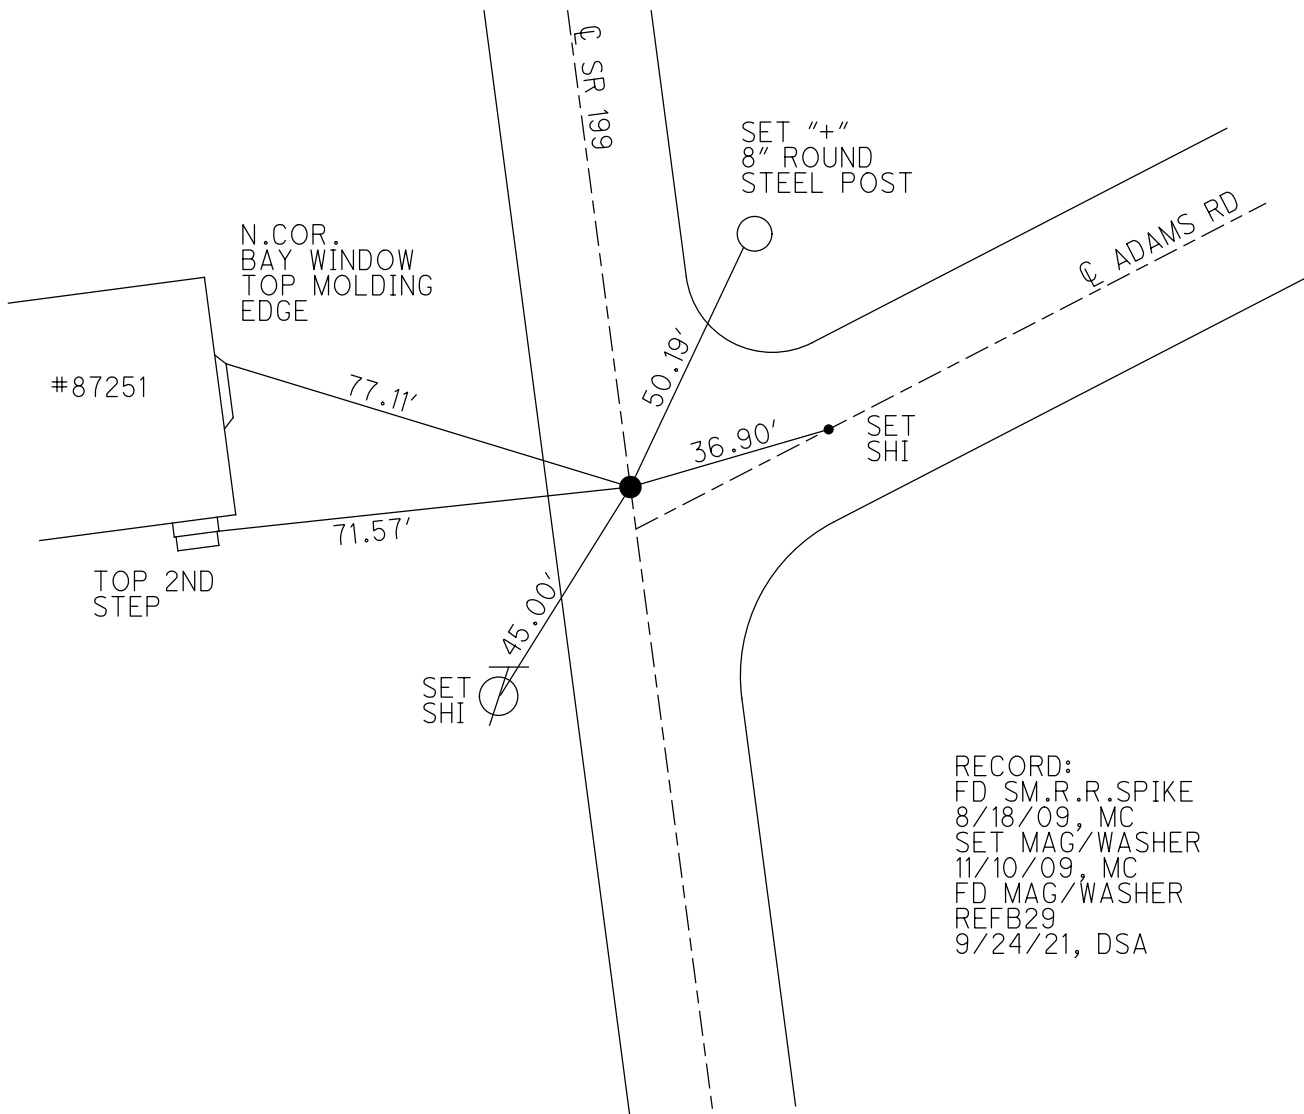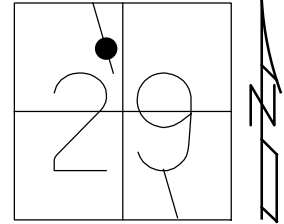


RECORD:  
FD SM.R.R.SPIKE  
8/18/09, MC  
SET MAG/WASHER  
11/10/09, MC  
FD MAG/WASHER  
REFB29  
9/24/21, DSA

O.D.O.T. DISTRICT 2 SURVEY OFFICE (USE ONLY)

PERSONNEL	REFERENCE NO. <u>29B</u>	SHEET <u>15</u> OF <u>45</u>
NOTES <u>HUSS</u>	DATE <u>08-18-09</u>	ROUTE <u>SR 199</u>
H.C. <u>CANTERBURY</u>	WEATHER <u>SUNNY</u>	COUNTY <u>WOOD</u>
R.C. <u>HUSS</u>	TEMP. <u>84° F</u>	TOWNSHIP <u>MONTGOMERY</u>
		SECTION <u>29</u>
		T <u>4</u> N R <u>12</u> E

TYPE MONUMENT PK NAIL  
 ON SURFACE - ~~BELOW~~ ON \_\_\_\_\_  
 LEFT - Q PAV'T - ~~RIGHT~~ - \_\_\_\_\_  
 - TO - EDGE PAVEMENT \_\_\_\_\_  
 S.L.M. 484+37

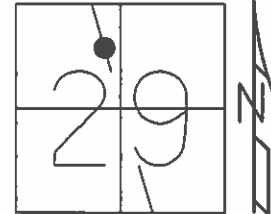

Grid: Northing: 588842.495 Easting: 1691621.282

RECORD

11-10-09 MC  
 RESET MAG/W

