

O.D.O.T. DISTRICT 2 SURVEY OFFICE (USE ONLY)

PERSONNEL

REFERENCE NO. 30

SHEET 16 OF 45

NOTES HUSS

DATE 8/18/09

ROUTE SR 199

H.C. CANTERBURY

WEATHER SUNNY

COUNTY WOOD

R.C. HUSS

TEMP. 86°

TOWNSHIP MONTGOMERY

DWG BY RHOADES

PID 101286

SECTION 20

T 4 N R 12 E

TYPE MONUMENT SM.R.R.SPIKE

ON SURFACE - ~~BELOW~~ ON

OFFSET \bar{C} PAVEMENT 0.5' LT : ~~RT~~

- TO - EDGE PAVEMENT


STATION: 499+34

HORZ.DATUM: NAD83(2011)


GEOID: 2012A

GRID: NORTHING: 590308.089

EASTING: 1691280.338

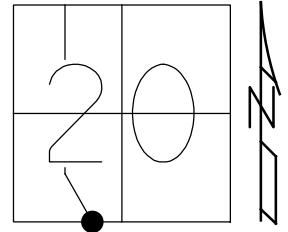


RECORD:
 $\Delta = 01^{\circ}05' RT$
 FD SM.R.R.SPIKE
 7/14/87, MDB
 SET SM.R.R.SPIKE
 8/25/87, MDB
 FD SM.R.R.SPIKE
 3/16/06, RGN
 8/18/09, MC
 SET MAG/WASHER
 11/10/09, MC
 FD MAG SHANK
 9/10/21, DSA

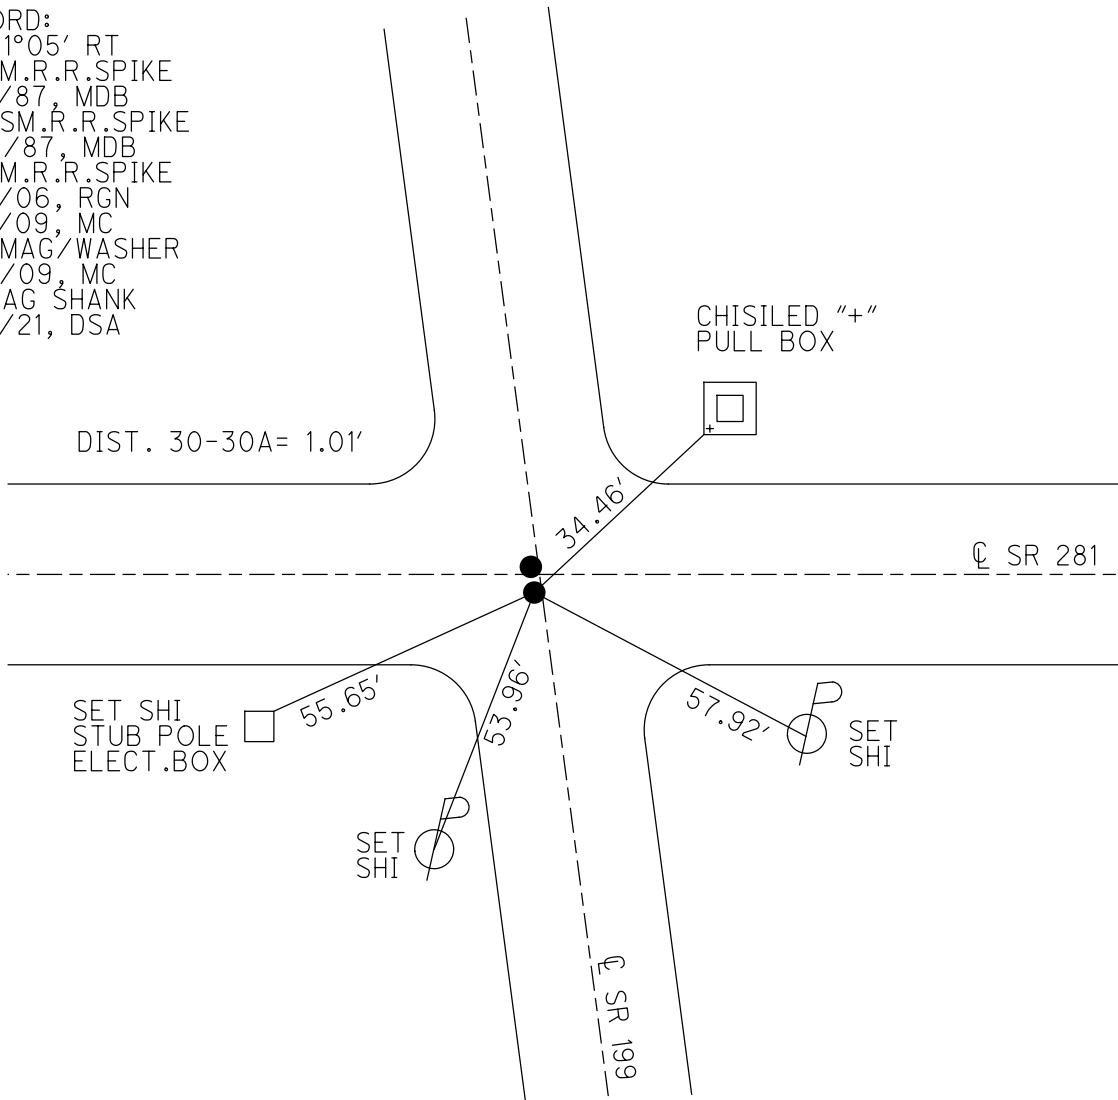

O.D.O.T. DISTRICT 2 SURVEY OFFICE (USE ONLY)

PERSONNEL _____ REFERENCE NO. 30 SHEET 16 OF 45
 NOTES HUSS DATE 08-18-09 ROUTE SR 199
 H.C. CANTERBURY WEATHER SUNNY COUNTY WOOD
 R.C. HUSS TEMP. 86° F TOWNSHIP MONTGOMERY
 _____ SECTION 20
 _____ T 4 N R 12 E

TYPE MONUMENT _____ SM. RRSPK
 ON SURFACE - ~~BELOW~~ _____ ON _____
 LEFT - ☉ PAV'T - ~~RIGHT~~ 0.5', 1' S. OF ☉ SR 281
 _____ TO _____ EDGE PAVEMENT
 S.L.M. 499+34
 Grid: Northing: 590308.089 Easting: 1691280.338

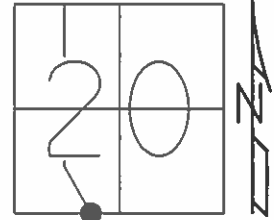


RECORD

$\Delta = 01^{\circ}-05'$ RT. (MEAS.)
 FD. PK
 SET RRSPK

RECORD

07-14-87 MDB
 FD. SM. RRSPK
 08-25-87 MDB
 SET SM. RRSPK
 03-16-06 RGN
 FD. SM. RRSPK
 11-10-09 MC
 RESET MAG/W

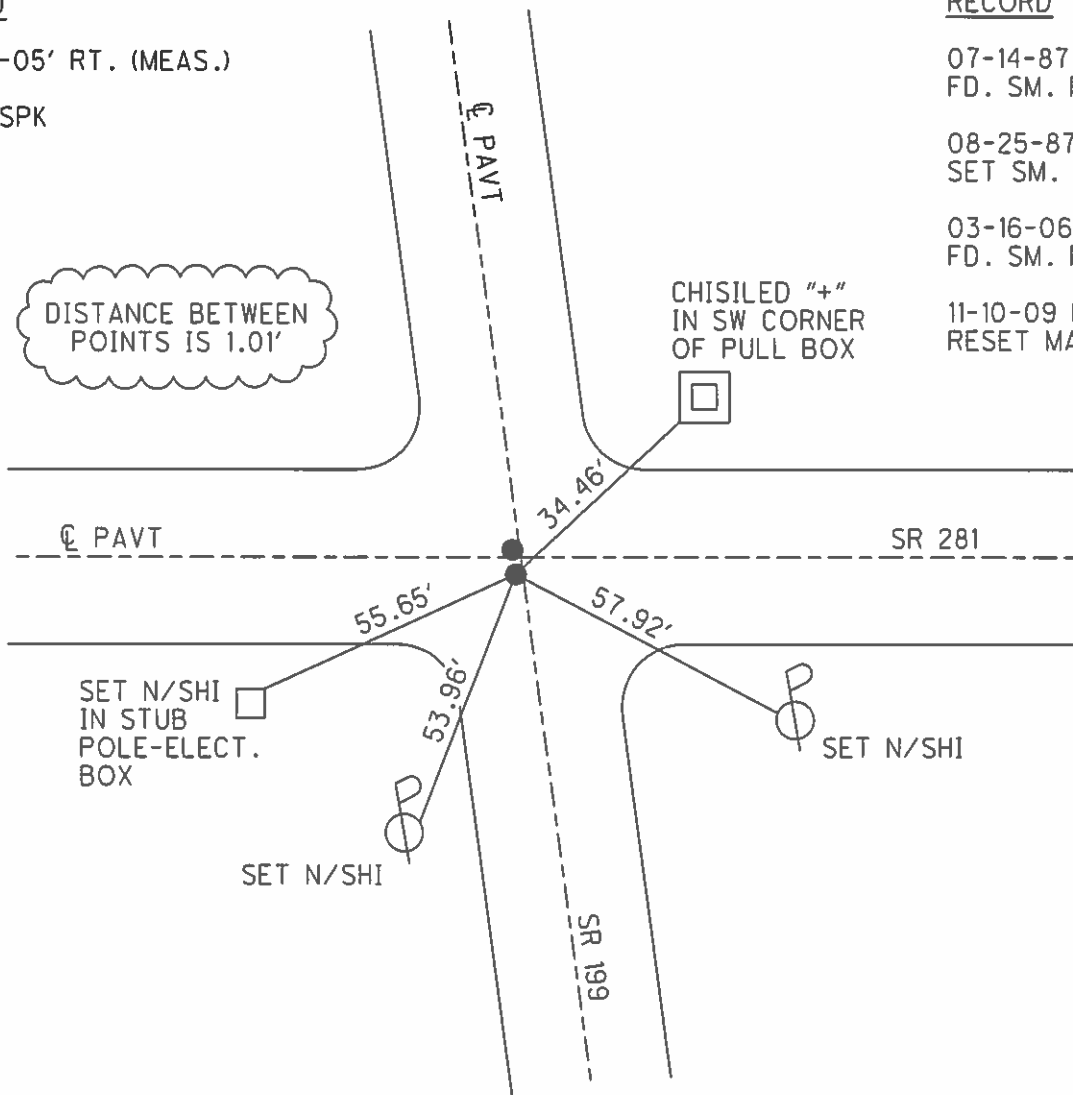

O.D.O.T. DISTRICT 2 SURVEY OFFICE (USE ONLY)

PERSONNEL _____

REFERENCE NO. 30A

SHEET 14 OF 42

NOTES HUSS

DATE 08-18-09

ROUTE SR 199

H.C. CANTERBURY

WEATHER SUNNY

COUNTY WOOD

R.C. HUSS

TEMP. 86° F

TOWNSHIP MONTGOMERY

SECTION 20

T 4 N R 12 E

TYPE MONUMENT _____ PK NAIL _____


ON SURFACE - ~~BELOW~~ ON _____

LEFT - ☉ PAV'T - ~~RIGHT~~ 0.3', ON ☉ SR 281

_____ TO _____ EDGE PAVEMENT


S.L.M. 499+35

Grid: Northing: 590309.092 Easting: 1691280.411

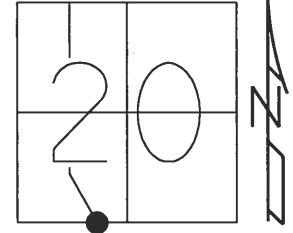

RECORD

11-10-09 MC
RESET MAG/W

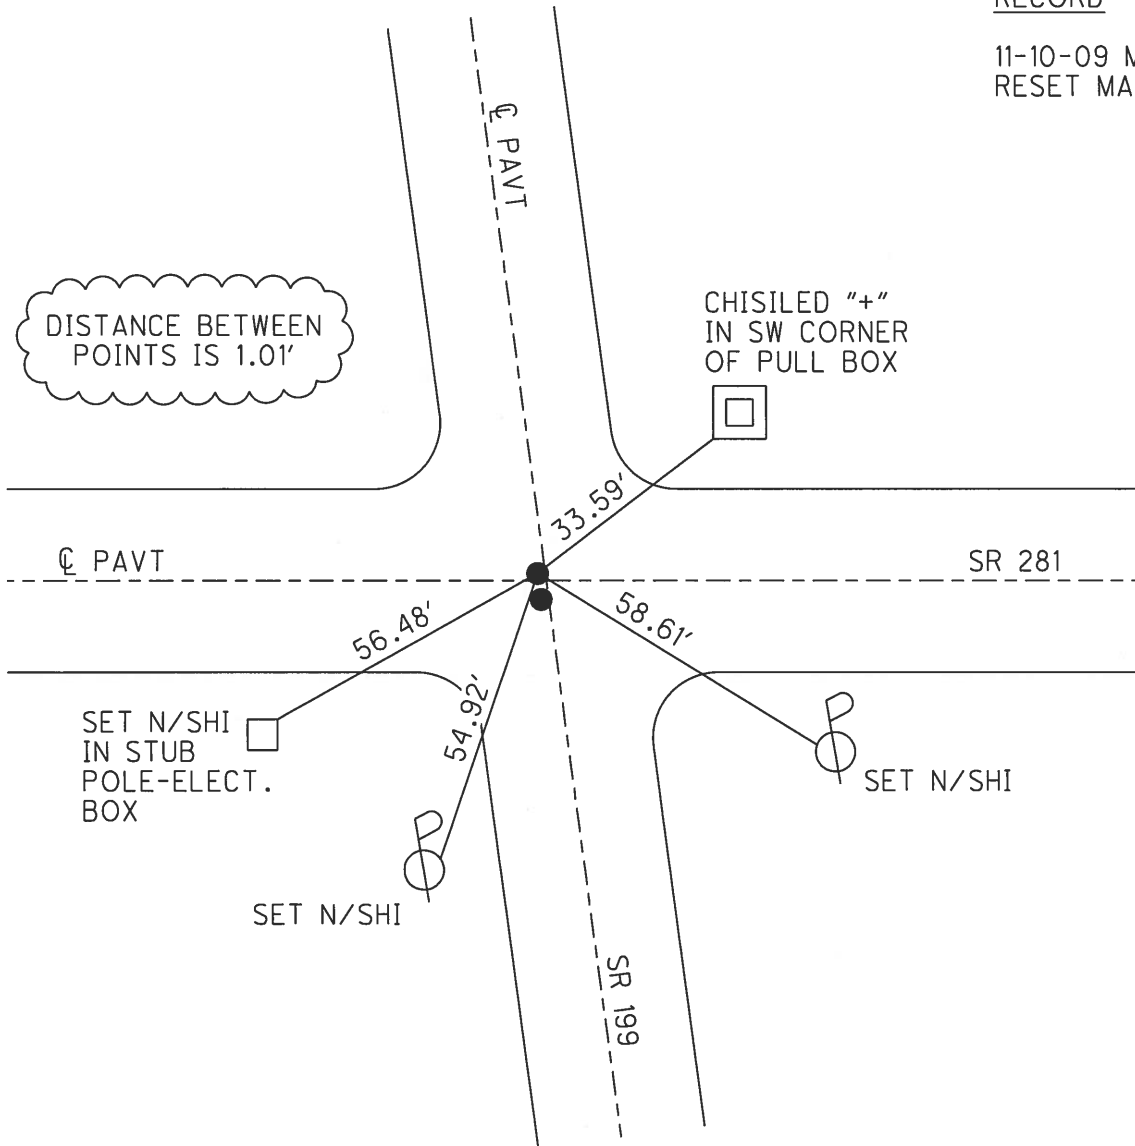

O.D.O.T. DISTRICT 2 SURVEY OFFICE

PERSONNEL

REFERENCE NO. 30

SHEET OF

NOTES BARNHISEL

H.C. Loehrke

R.C. HOFFMAN

DATE 7-14-87

WEATHER Sunny

TEMP. +75°

ROUTE 199

COUNTY WOOD

TOWNSHIP Montgomery

SECTION 20

T4 N R 12 E


TYPE MONUMENT Sm RR Spk

ON SURFACE - BELOW YES

LEFT - & PAV'T. - RIGHT 1.5 (1.0 SOF & SR 281)


- TO - EDGE PAVEMENT

S.L.M. 499+34 (199 SLM) 1029+41 (281 SLM)

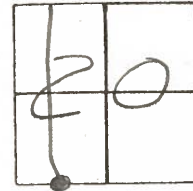

Record
Fd PK - O.K.
Set R.R. Spk
 $\Delta = 1^{\circ} 05' R +$ (meas)

Set Sm RR Spk
8-25-87
77AB

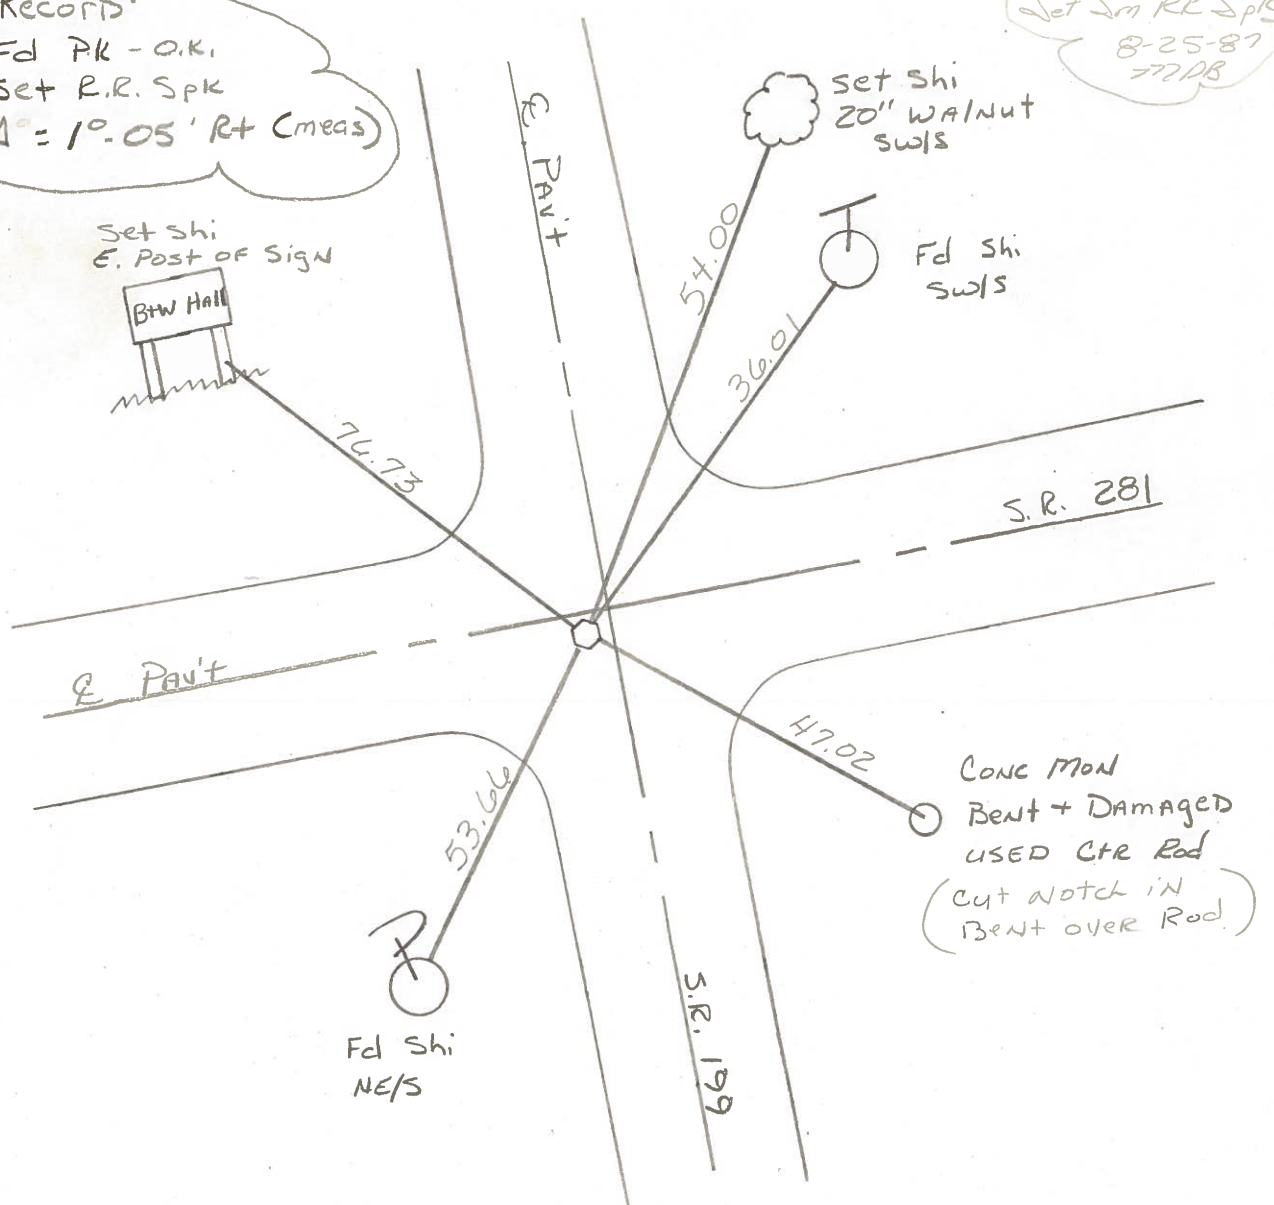

County WOOD S.R. 199

Township MONTGOMERY

Section 20

T4N, R12E

Personnel BURNSIDE

SMITH

BOWERS

Date 11-18-71 (CHKD 5-22-78)


Weather CLOUDY

Temp. +65°

17	16
20	21



#30

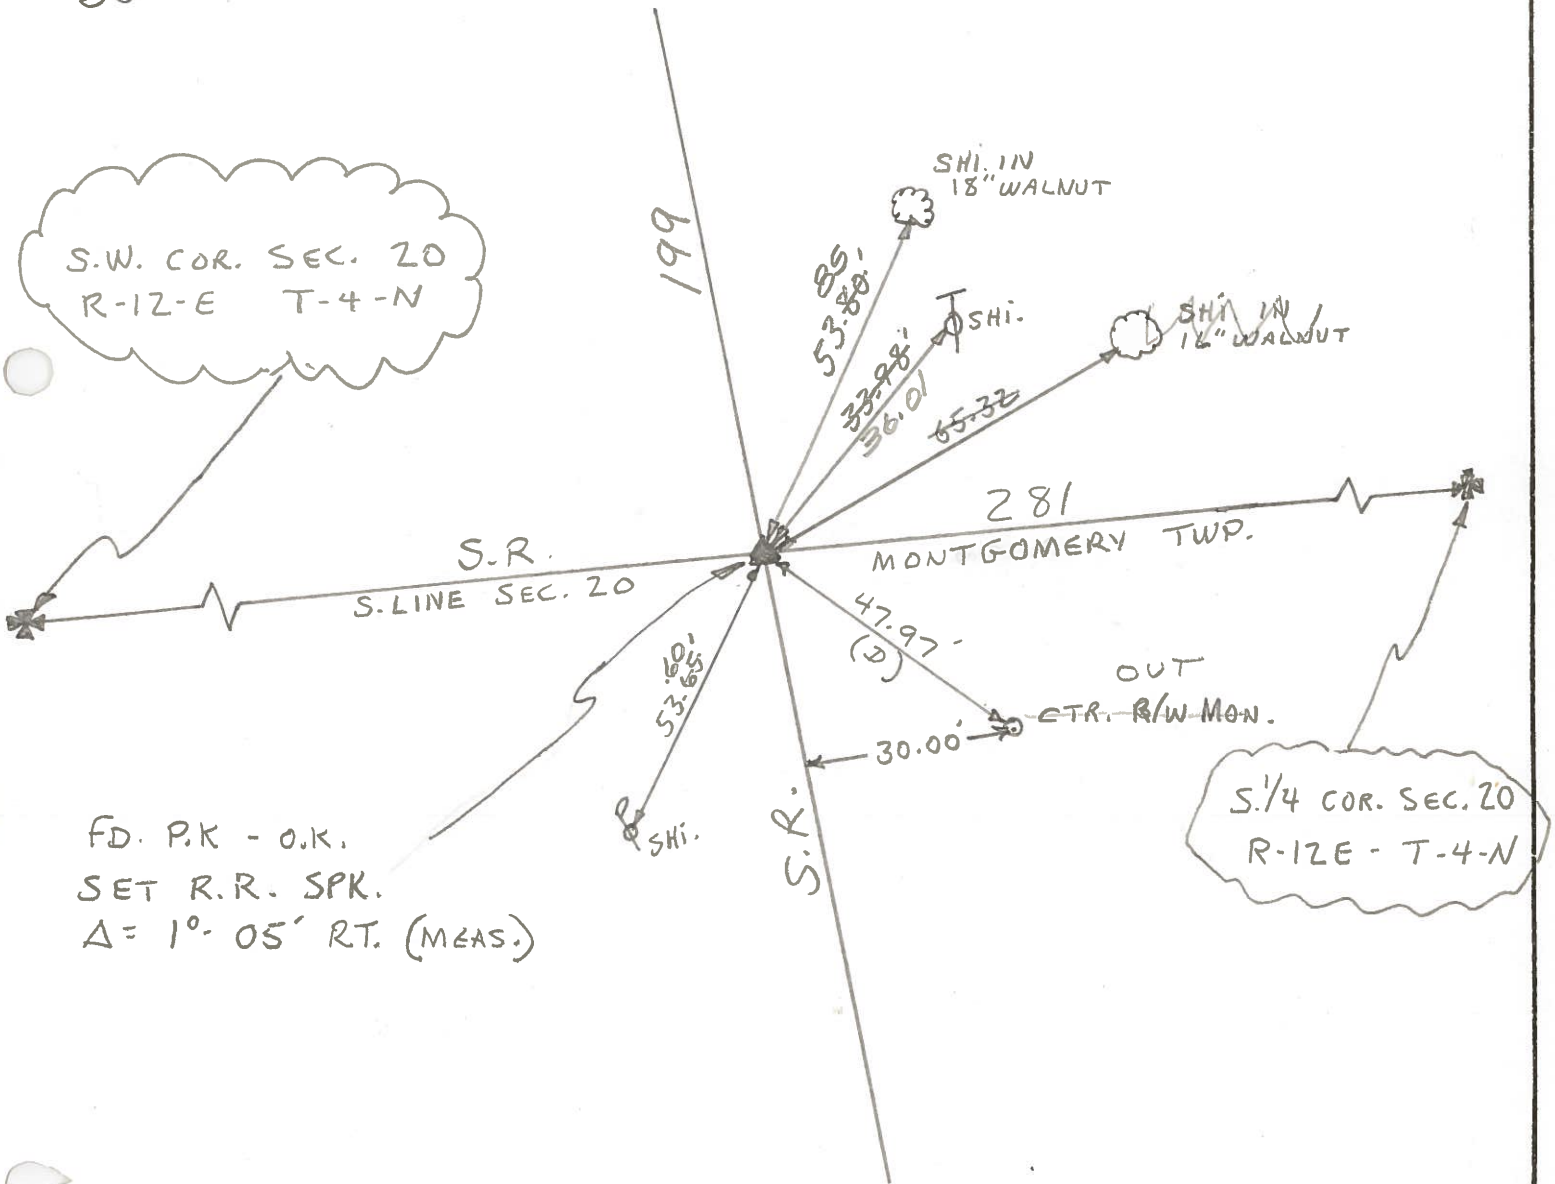

S.W. COR. SEC. 20
R-12-E T-4-N

S. 1/4 COR. SEC. 20
R-12-E - T-4-N

FD. P.K. - O.K.
SET R.R. SPK.
Δ = 1° 05' RT. (MEAS.)

PERSONNEL	TITLE	PERSONNEL	TITLE	COUNTY	DATE
BURNSIDE				WOOD	11-18-71
SMITH				S. R. 199 & 281	WEATHER CLOUDY
BOWERS				SEC. 5. LINE SEC. 20	TEMP. +65°

DESCRIPTION	LEFT	CENTER LINE	RIGHT	JOB NO.
-------------	------	-------------	-------	---------

