



O.D.O.T. DISTRICT 2 SURVEY OFFICE (USE ONLY)

PERSONNEL _____ REFERENCE NO. 31 SHEET 18 OF 45
 NOTES HUSS DATE 8/18/09 ROUTE SR 199
 H.C. CANTERBURY WEATHER SUNNY COUNTY WOOD
 R.C. HUSS TEMP. 85° TOWNSHIP MONTGOMERY
 DWG BY RHOADES PID 101286 SECTION 20
 T 4 N R 12 E

TYPE MONUMENT SM.R.R.SPIKE
 ON SURFACE - ~~BELOW~~ ON
 OFFSET \odot PAVEMENT 11' LT : ~~RT~~
1.8' TO LT EDGE PAVEMENT
 STATION: 512+86

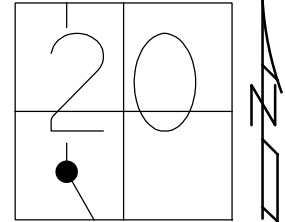

HORIZ.DATUM: NAD83(2011) GEOID: 2012A
 GRID: NORTHING: 591624.733 EASTING: 1690999.862


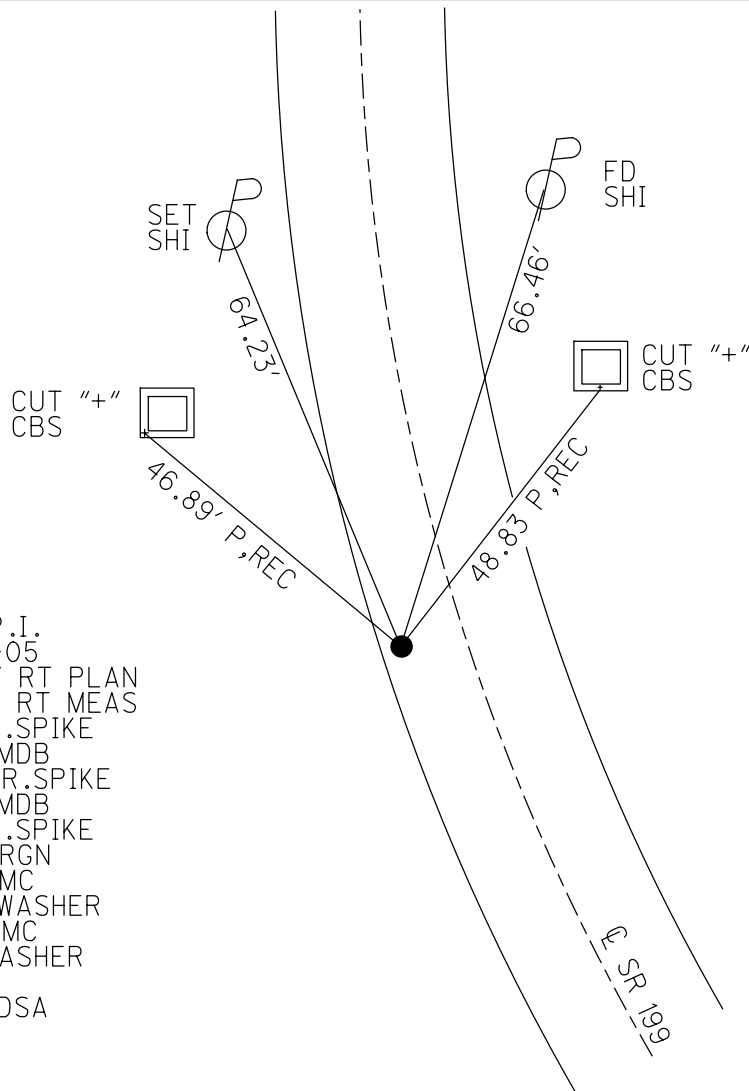


RECORD: P.I.
 STA. 278+05
 $\Delta = 12^\circ 50'$ RT PLAN
 $\Delta = 12^\circ 48'$ RT MEAS
 FD SM.R.R.SPIKE
 7/14/87, MDB
 SET SM.R.R.SPIKE
 8/17/87, MDB
 FD SM.R.R.SPIKE
 3/16/06, RGN
 8/18/09, MC
 SET MAG/WASHER
 11/10/09, MC
 FD MAG/WASHER
 REF31
 9/24/21, DSA

O.D.O.T. DISTRICT 2 SURVEY OFFICE (USE ONLY)

PERSONNEL	REFERENCE NO. <u>31</u>	SHEET <u>18</u> OF <u>45</u>
NOTES <u>HUSS</u>	DATE <u>08-18-09</u>	ROUTE <u>SR 199</u>
H.C. <u>CANTERBURY</u>	WEATHER <u>SUNNY</u>	COUNTY <u>WOOD</u>
R.C. <u>HUSS</u>	TEMP. <u>85° F</u>	TOWNSHIP <u>MONTGOMERY</u>
		SECTION <u>20</u>
		T <u>4</u> N R <u>12</u> E

TYPE MONUMENT SM. RRSPK
 ON SURFACE - ~~BELOW~~ ON
 LEFT - Q PAV'T - ~~RIGHT~~ 11.0'
1.8' TO LT. EDGE PAVEMENT
 S.L.M. 512+86
 Grid: Northing: 591624.743 Easting: 1690999.847

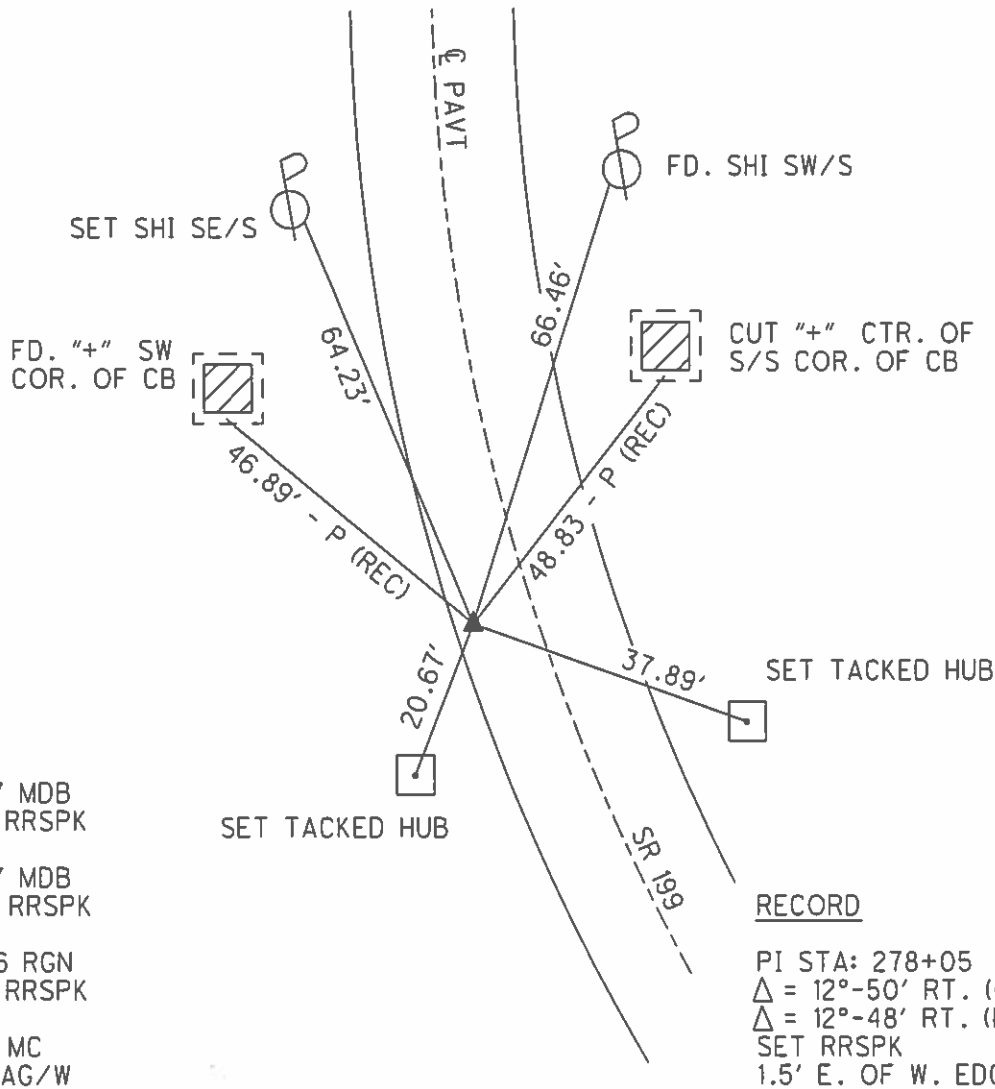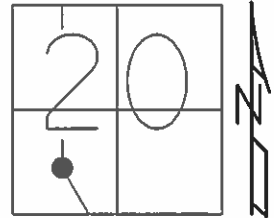

O.D.O.T. DISTRICT 2 SURVEY OFFICE

PERSONNEL

REFERENCE NO. 31

SHEET OF

NOTES BARNHISEL

H.C. Loehreke

R.C. HOFFMAN

DATE 7-14-87

WEATHER SUNNY

TEMP. +750

ROUTE 199

COUNTY WOOD

TOWNSHIP Montgomery

SECTION 20

T 4 N R 12 E


TYPE MONUMENT Sm RR Spk

ON SURFACE - BELOW yes


LEFT - ℄ PAV'T. - RIGHT 10.9

.8 TO Lt EDGE PAVEMENT

S.L.M. 512 + 80

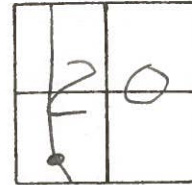

Set Sm RR Spk
 8-17-87
 M D B

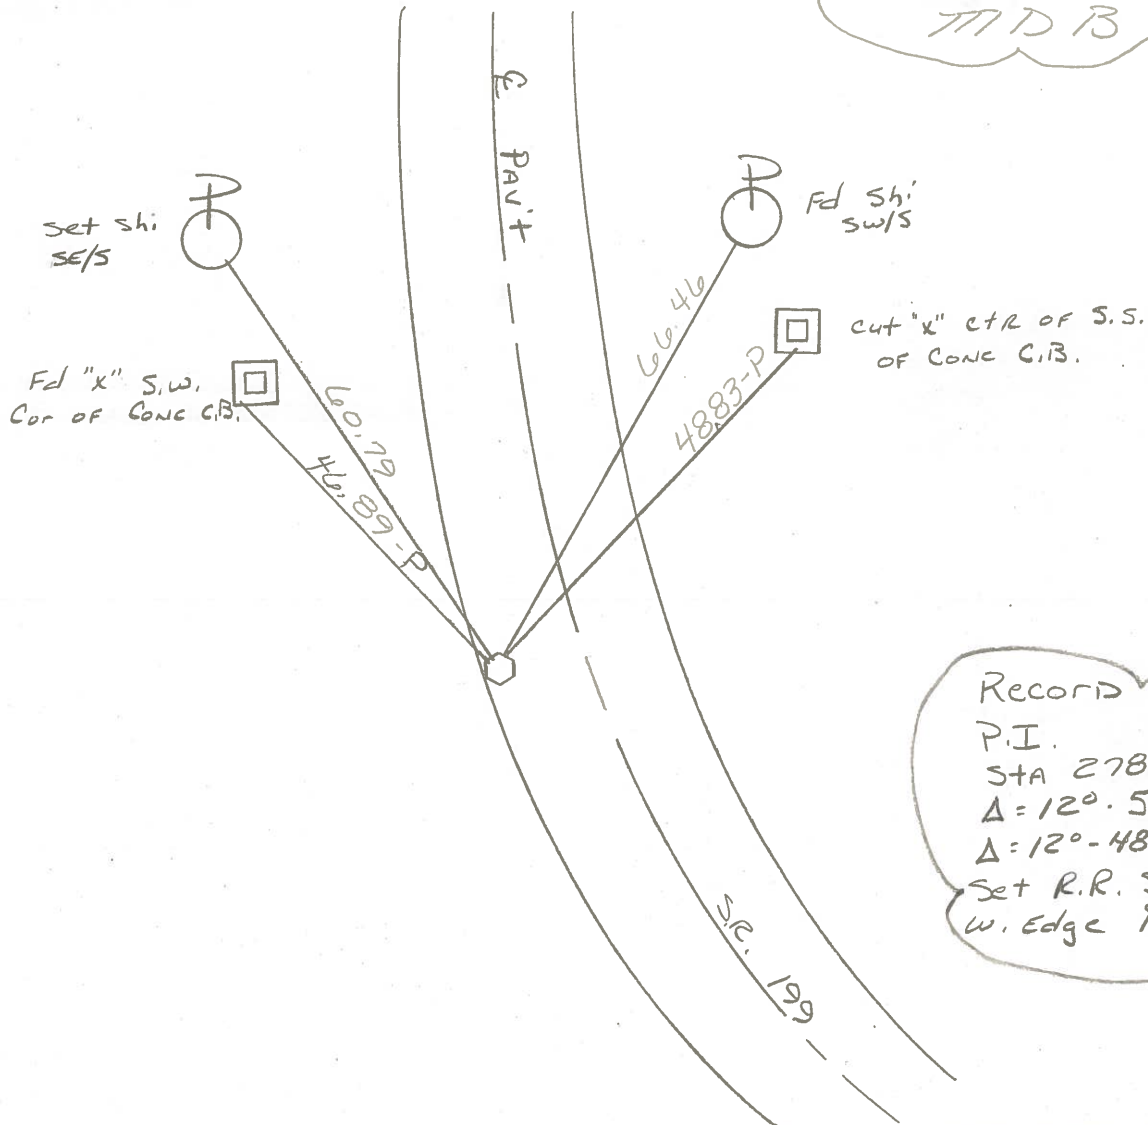

Record
 P.I.
 STA 278+05
 $\Delta = 120.50'$ RT (Old PLAN)
 $\Delta = 120.48'$ RT (MEAS)
 Set R.R. Spk 1.5' E. of
 W. Edge PAV'T

County WOOD S.R. 199

Township MONTGOMERY

Section 20

T N, R E

Personnel BURNSIDE


SMITH

BOWERS


Date 1-3-72 ^{CHKD}
(5-22-78)

Weather CLEAR

Temp. +45°

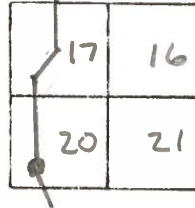

#31

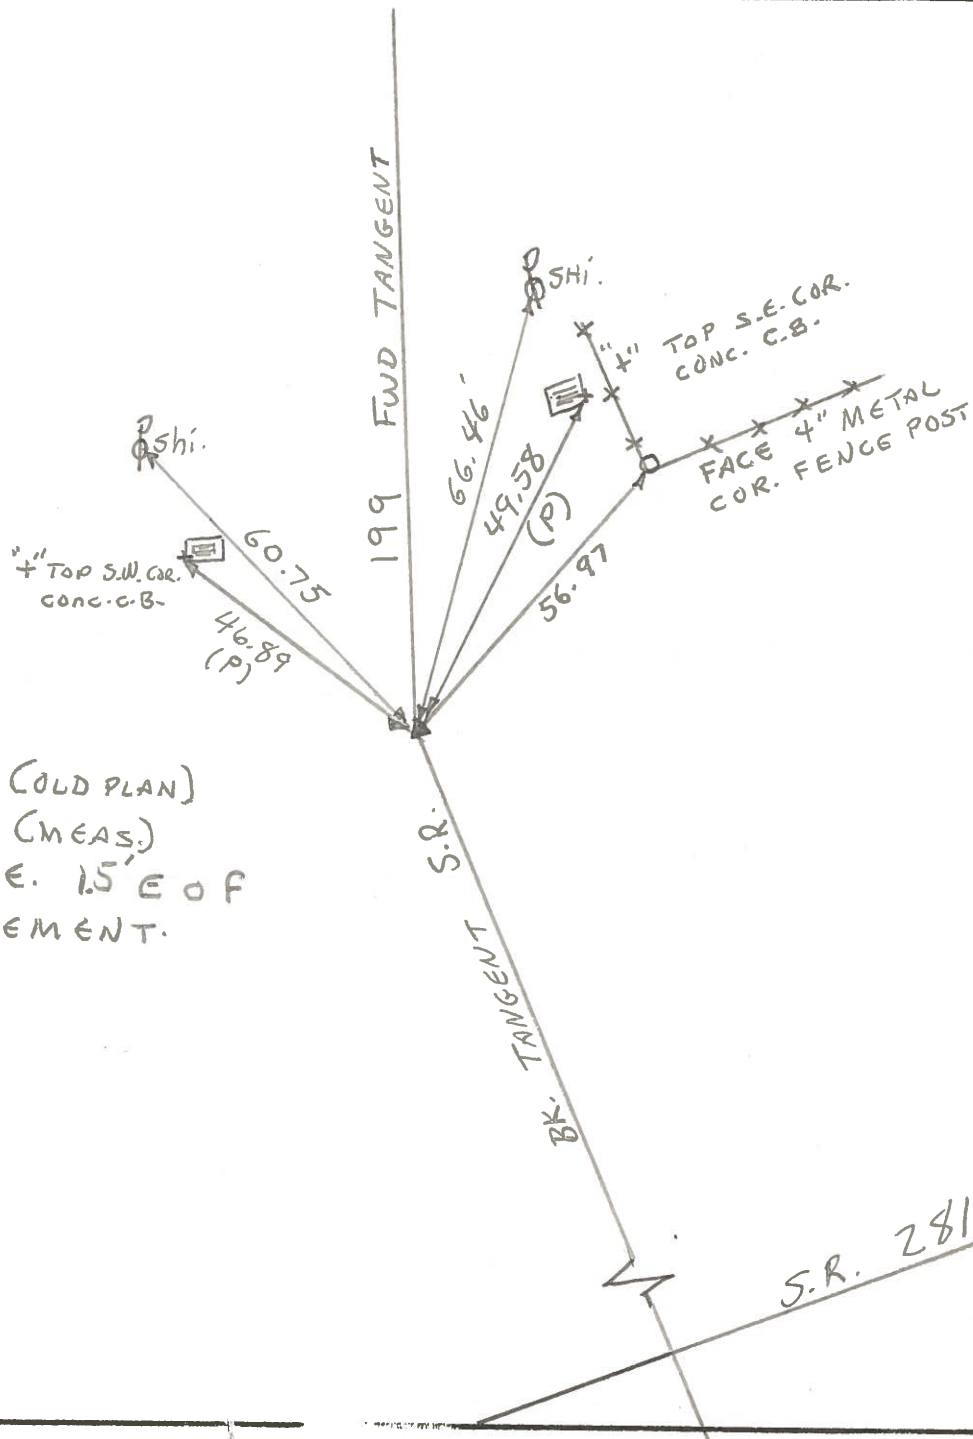

P. I.
 STA. 278+05
 $\Delta = 12^\circ - 50' \text{ RT. (OLD PLAN)}$
 $\Delta = 12^\circ - 48' \text{ RT. (MEAS.)}$
 SET R.R. SPKE. 15' E OF
 W. EDGE PAVEMENT.

PERSONNEL	TITLE	PERSONNEL	TITLE	COUNTY	DATE
BURNSIDE				Wood	1-3-72
SMITH				S. R. 199	WEATHER CLEAR
BOWERS				SEC. 20	TEMP. +45°

DESCRIPTION 1ST CURVE NORTH OF S.R. 281 JOB NO. _____

