



O.D.O.T. DISTRICT 2 SURVEY OFFICE (USE ONLY)

PERSONNEL _____ REFERENCE NO. 32 SHEET 19 OF 45
 NOTES HUSS DATE 08-20-09 ROUTE SR 199
 H.C. CANTERBURY WEATHER SUNNY COUNTY WOOD
 R.C. BARNHISEL TEMP. 85° F TOWNSHIP MONTGOMERY
 _____ SECTION 20
 _____ T 4 N R 12 E

TYPE MONUMENT _____ SM. RRSPK
 ON SURFACE - ~~BELOW~~ ON _____
~~LEFT~~ - C PAV'T - ~~RIGHT~~ ON _____
12.1' TO RT. EDGE PAVEMENT
 S.L.M. 525+86

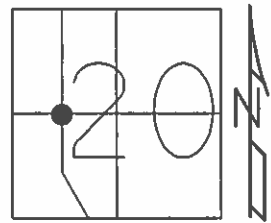

Grid: Northing: 592921.942 Easting: 1691017.424

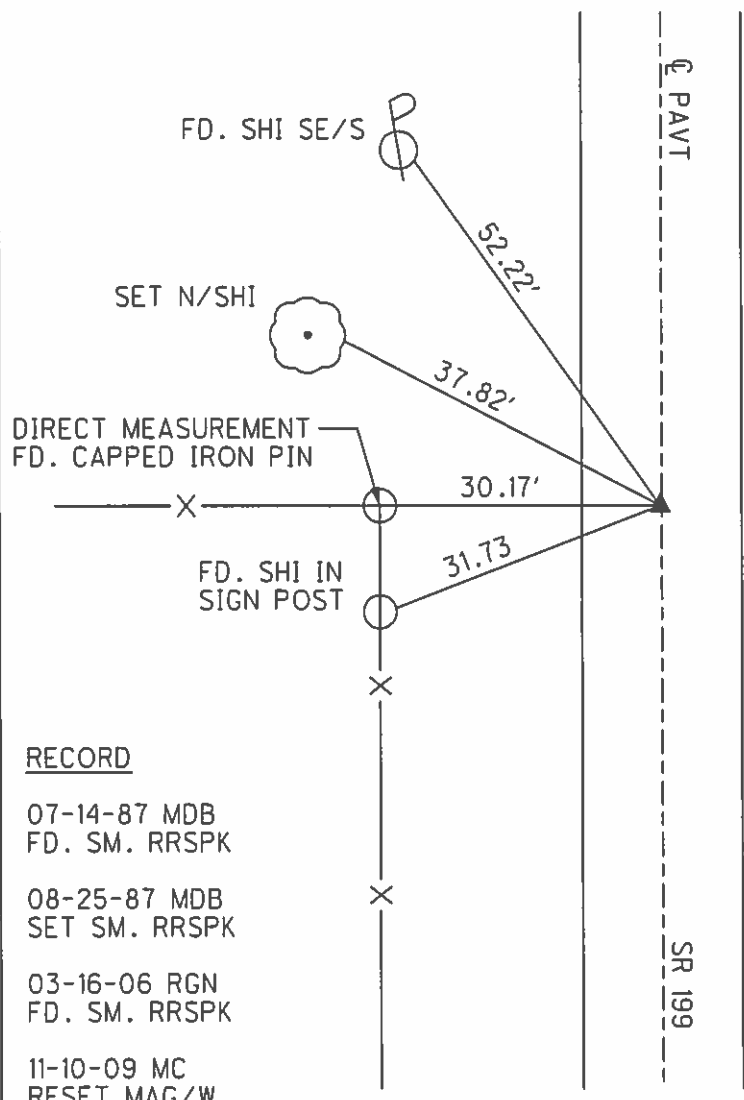

RECORD

PI STA: 291+11.6
 $\Delta = 00^\circ-02'$ LT. (MEAS.)
 $\Delta = 00^\circ-30'$ RT. (REC.)
 FD. NAIL
 SET RRSPK

RECORD

- 07-14-87 MDB
FD. SM. RRSPK
- 08-25-87 MDB
SET SM. RRSPK
- 03-16-06 RGN
FD. SM. RRSPK
- 11-10-09 MC
RESET MAG/W

NOTE:

PERRYSBURG - FOSTORIA
 S.H. (I.C.H.) NO. 273
 1926 PLAN
 SEC. "G" "H" & WEST MILGROVE
 THIS OLD PLAN SHOWS P.I.
 TO ANGLE $00^\circ-30'$ RT.

County WOOD S.R. 199

Township MONTGOMERY

Section 20

T N, R E

Personnel BURNSIDE


SMITH

HOLCOMBE

Date 11-15-71 (CHKD 5-22-78)


Weather CLEAR

Temp. +70°

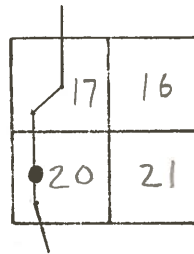

#32

P.I. STA. 291+11.6
 $\Delta = 0^\circ - 02' \text{ LT. (MEAS.)}$
 $\Delta = 0^\circ - 30' \text{ RT. (REC.)}$ *
 FD. NAIL ON Φ
 SET R.R. SPK.

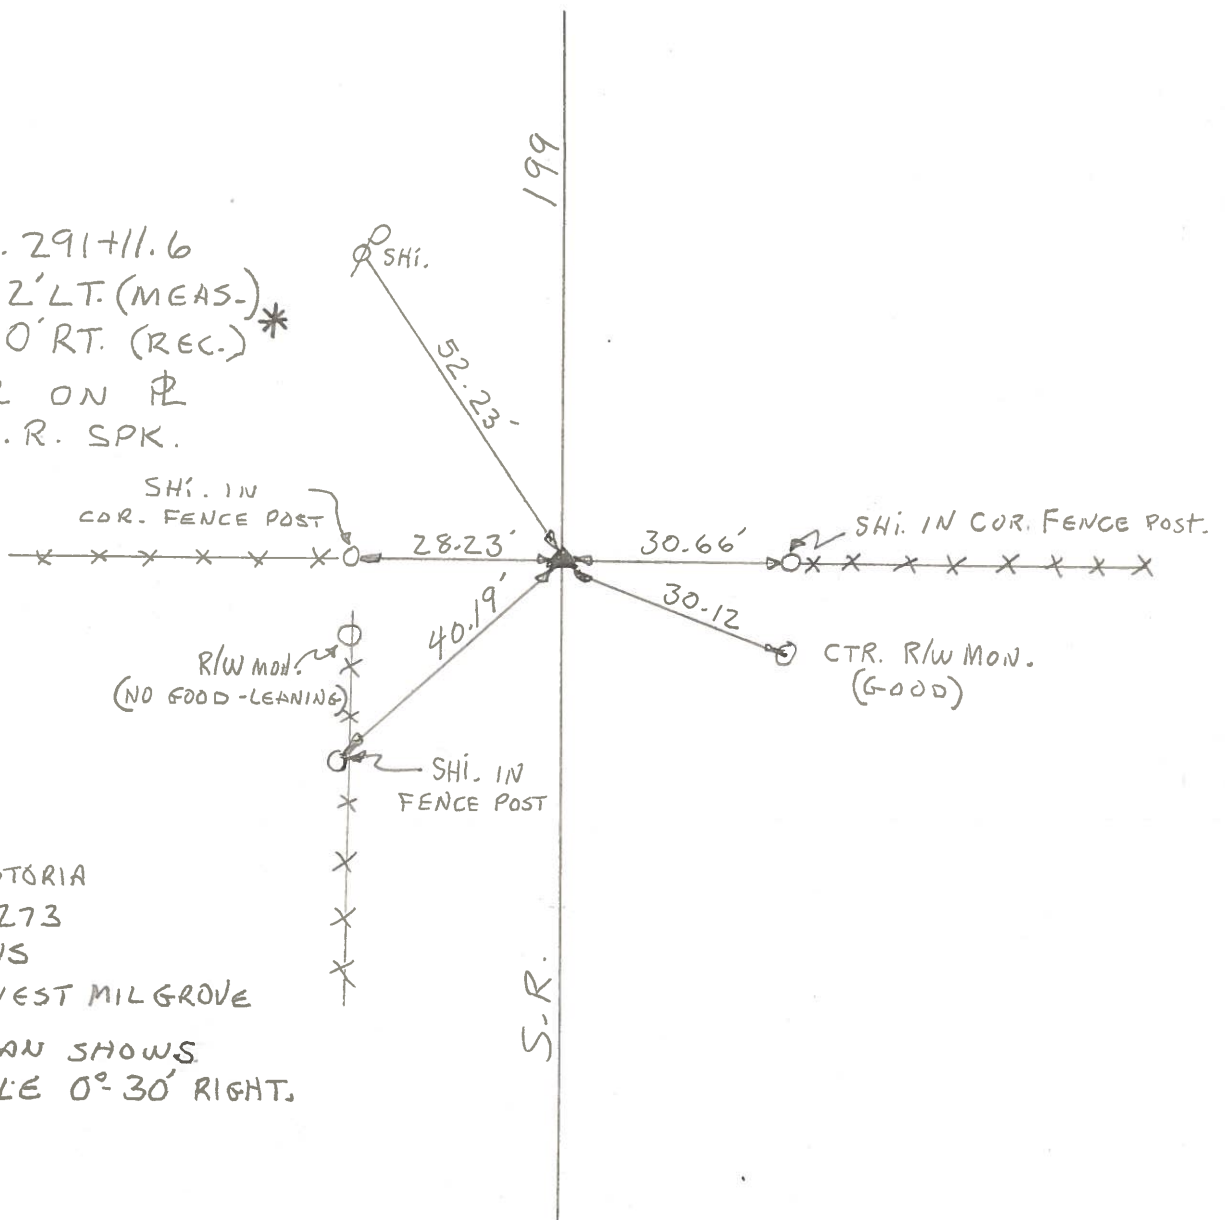

*
 NOTE:
 PERRISBURG-FOSTORIA
 S.H. (I.C.H.) No. 273
 1926 PLANS
 SEC. "C" "H" & WEST MILGROVE
 THIS OLD PLAN SHOWS
 P.I. TO ANGLE $0^\circ - 30'$ RIGHT.

PERSONNEL TITLE PERSONNEL TITLE COUNTY Wood DATE 11-15-71
BURNSIDE _____
SMITH _____ S. R. 199 WEATHER CLEAR
HOLCOMBE _____

SEC. _____ TEMP. +70°

DESCRIPTION P.I. 1/2 mile SOUTH OF MERMILL RD. JOB NO. _____

LEFT CENTER LINE RIGHT

