

O.D.O.T. DISTRICT 2 SURVEY OFFICE (USE ONLY)

PERSONNEL

REFERENCE NO. 33

SHEET 20 OF 45

NOTES HUSS

DATE 8/20/09

ROUTE SR 199

H.C. CANTERBURY

WEATHER CLOUDY

COUNTY WOOD

R.C. BARNHISEL

TEMP. 78°

TOWNSHIP MONTGOMERY

DWG BY RHOADES PID 101286

SECTION 17

T 4 N R 12 E

TYPE MONUMENT MONBOW W/ 1" IPIN

ON SURFACE - ~~BELOW~~ ON

OFFSET ☉ PAVEMENT ON LT : RT

- TO - EDGE PAVEMENT


STATION: 552+24

HORIZ.DATUM: NAD83(2011)


GEOID: 2012A

GRID: NORTHING: 595567.232

EASTING: 1691051.442

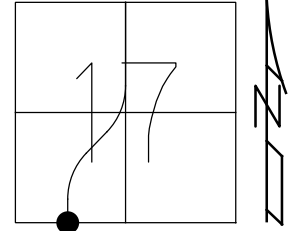


RECORD:
 1926 PLANS
 STA. 317+41.65
 $\Delta = 03^{\circ}15'$ RT
 1962 PLANS
 STA. 551+76
 $\Delta = 03^{\circ}11'$ RT
 FD MONBOX
 7/14/87, MDB
 3/16/06, RGN
 W/1" IPIN
 8/20/09, MDB
 9/10/21, DSA

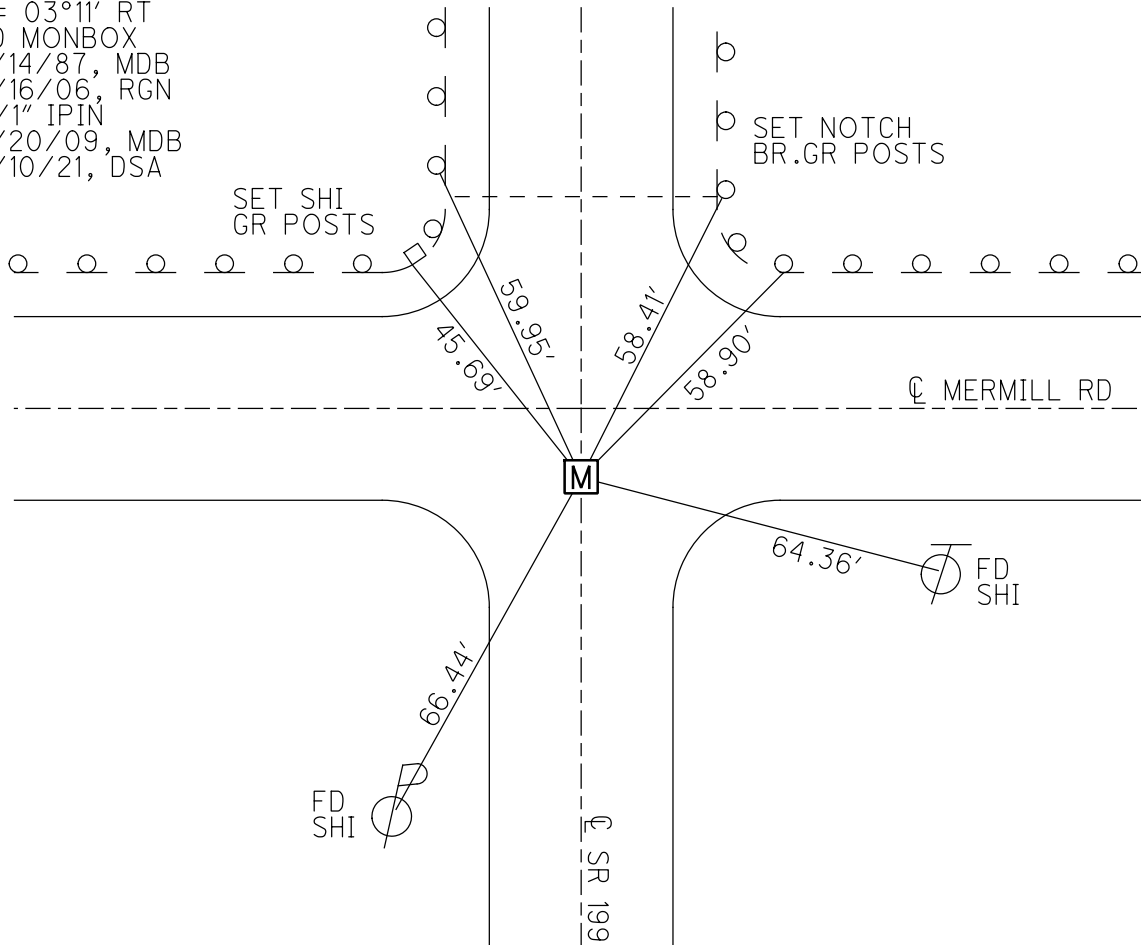

O.D.O.T. DISTRICT 2 SURVEY OFFICE (USE ONLY)

PERSONNEL	REFERENCE NO. <u>33</u>	SHEET <u>20</u> OF <u>45</u>
NOTES <u>HUSS</u>	DATE <u>08-20-09</u>	ROUTE <u>SR 199</u>
H.C. <u>CANTERBURY</u>	WEATHER <u>CLOUDY</u>	COUNTY <u>WOOD</u>
R.C. <u>BARNHISEL</u>	TEMP. <u>78° F</u>	TOWNSHIP <u>MONTGOMERY</u>
		SECTION <u>17</u>
		T <u>4</u> N R <u>12</u> E

TYPE MONUMENT MON. BOX
 ON SURFACE - ~~BELOW~~ ON _____
~~LEFT~~ - Q PAV'T - ~~RIGHT~~ ON Q, 3.6' S. OF Q MERMILL RD.
 - TO - EDGE PAVEMENT
 S.L.M. 552+24
 Grid: Northing: 595567.232 Easting: 1691051.442

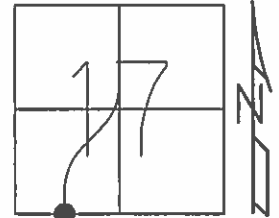


RECORD

07-14-87 MDB
 FD. MON BOX
 03-16-06 RGN
 FD. MON BOX

RECORD

MON BOX @ INTERSECTION
 SR 199 & MERMILL RD.
 STA: 317+41.65 (1926 PLANS)
 $\Delta = 03^{\circ}-15'$ RT. (1926 PLANS)
 STA: 551+76 (1962 PLANS)
 $\Delta = 03^{\circ}-11'$ RT. (1962 PLANS)

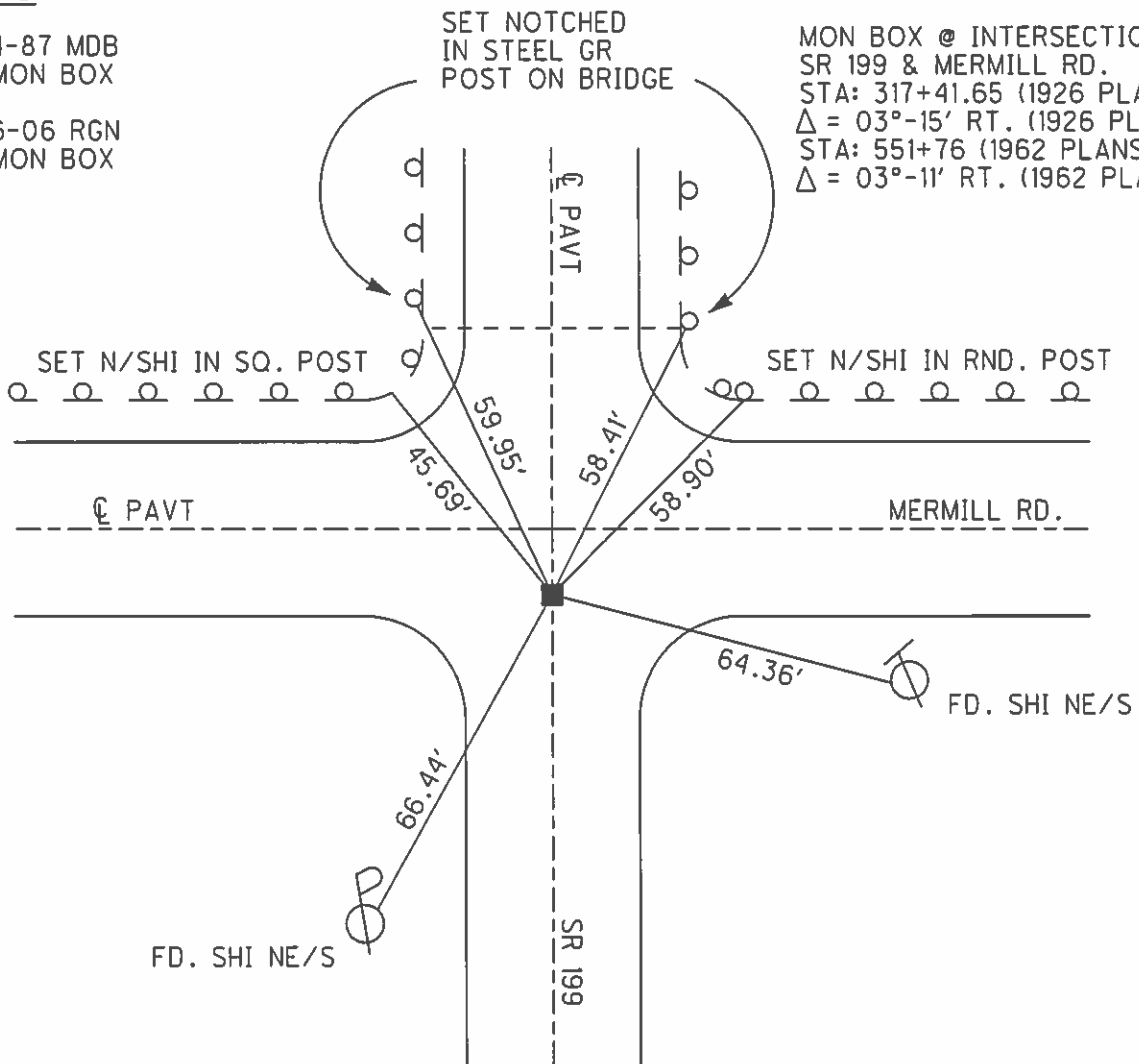

O.D.O.T. DISTRICT 2 SURVEY OFFICE

PERSONNEL _____

REFERENCE NO. 33

SHEET _____ OF _____

NOTES BARNHISEL

H.C. Loehrke

R.C. Hoffman

DATE 7-14-87

WEATHER SUNNY

TEMP. +75°

ROUTE 199

COUNTY WOOD

TOWNSHIP Montgomery

SECTION 17

T 4 N R 12 E

TYPE MONUMENT Mon Box


ON SURFACE - ~~BELOW~~ yes

LEFT - ~~Q~~ PAV'T. - ~~RIGHT~~ 1.1

- TO - EDGE PAVEMENT

S.L.M. 552+20

3.6 S. OF E Merrill Rd W.

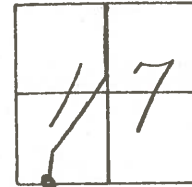


Record

Mon Box @ Inter.
S.R. 199 & Merrill Rd
STA: 317+41.65 } Old Plan
Δ = 30-15' Rt } 1926
STA: 551+76 } New Plan
Δ = 30-11' Rt } 1962

Note:

Figures marked (old)
Represent measurements
From Survey by Silvestor
in 1961

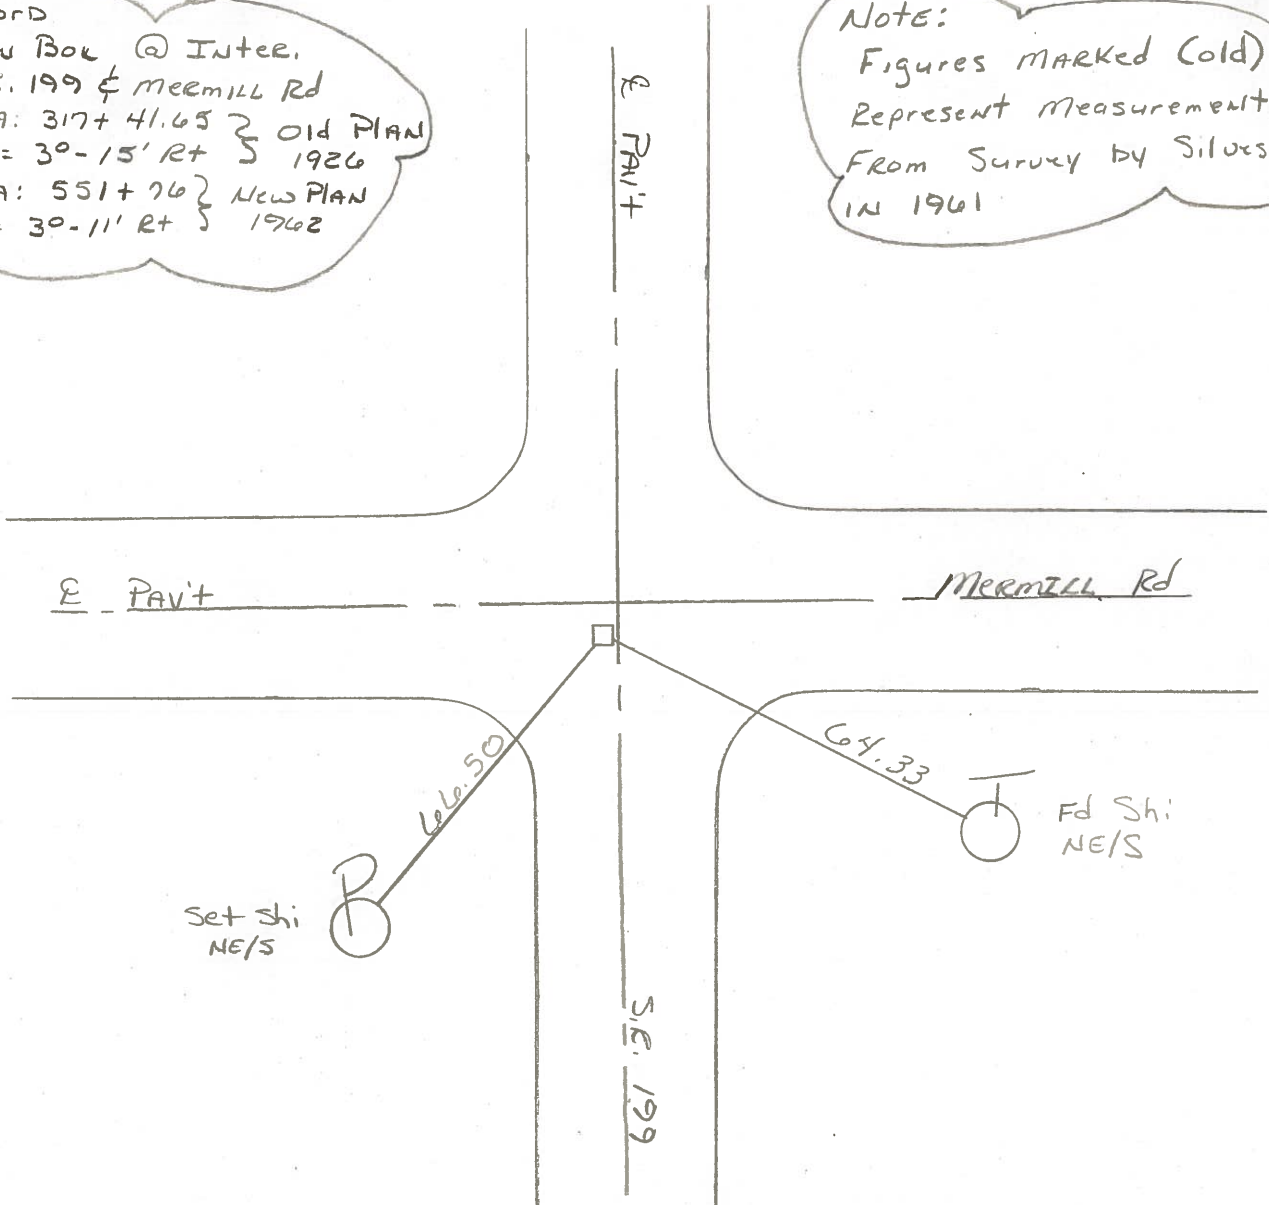

County WOOD S.R. 199

Township MONTGOMERY

Section 17

T N, R E

Personnel BURNSIDE


SMITH

BOWERS


Date 1-10-72 (CHKD. 5-25-78)

Weather CLOUDY

Temp. +42°

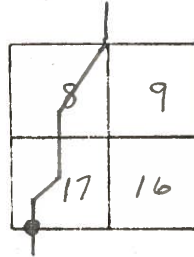


#33

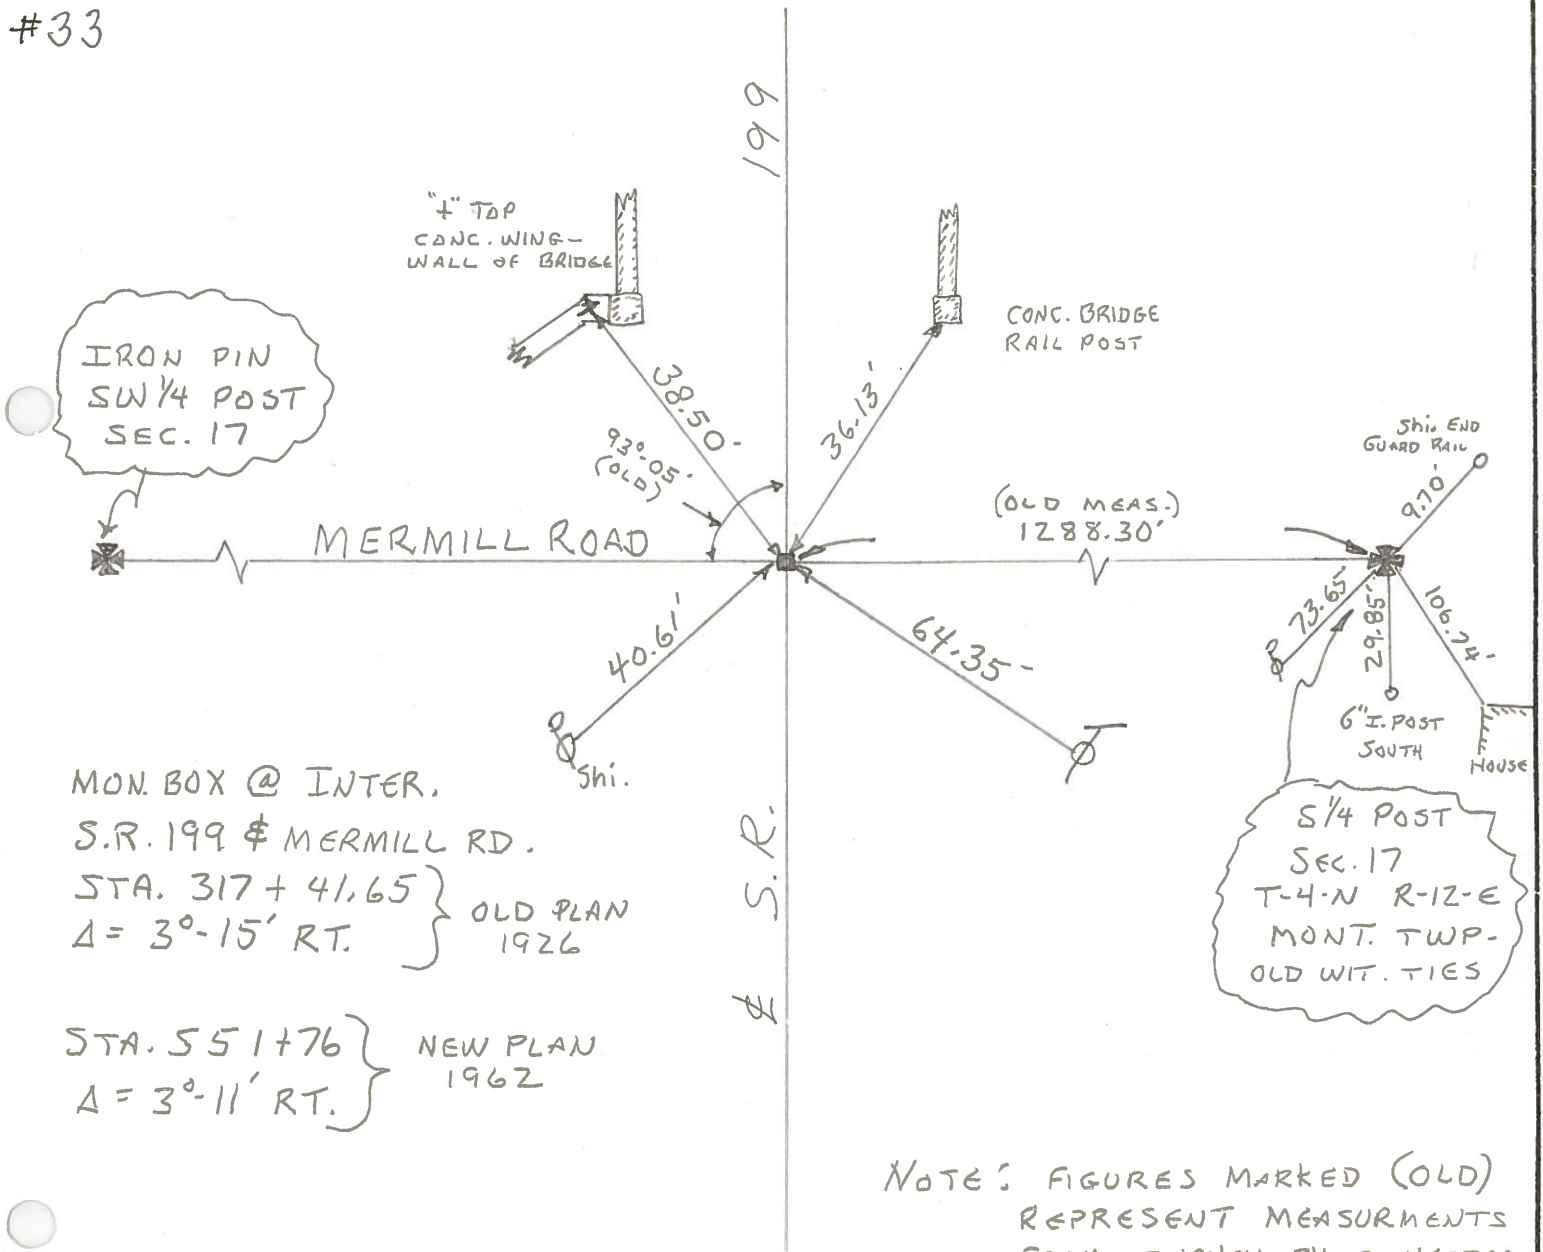

PERSONNEL	TITLE	PERSONNEL	TITLE	COUNTY	DATE
BURNSIDE				WOOD	1-10-72
SMITH				S. R. 199	WEATHER CLOUDY
BOWERS				SEC. 17 MERMILL RD.	TEMP. +42°

DESCRIPTION _____ LEFT _____ CENTER LINE _____ RIGHT _____ JOB NO. _____

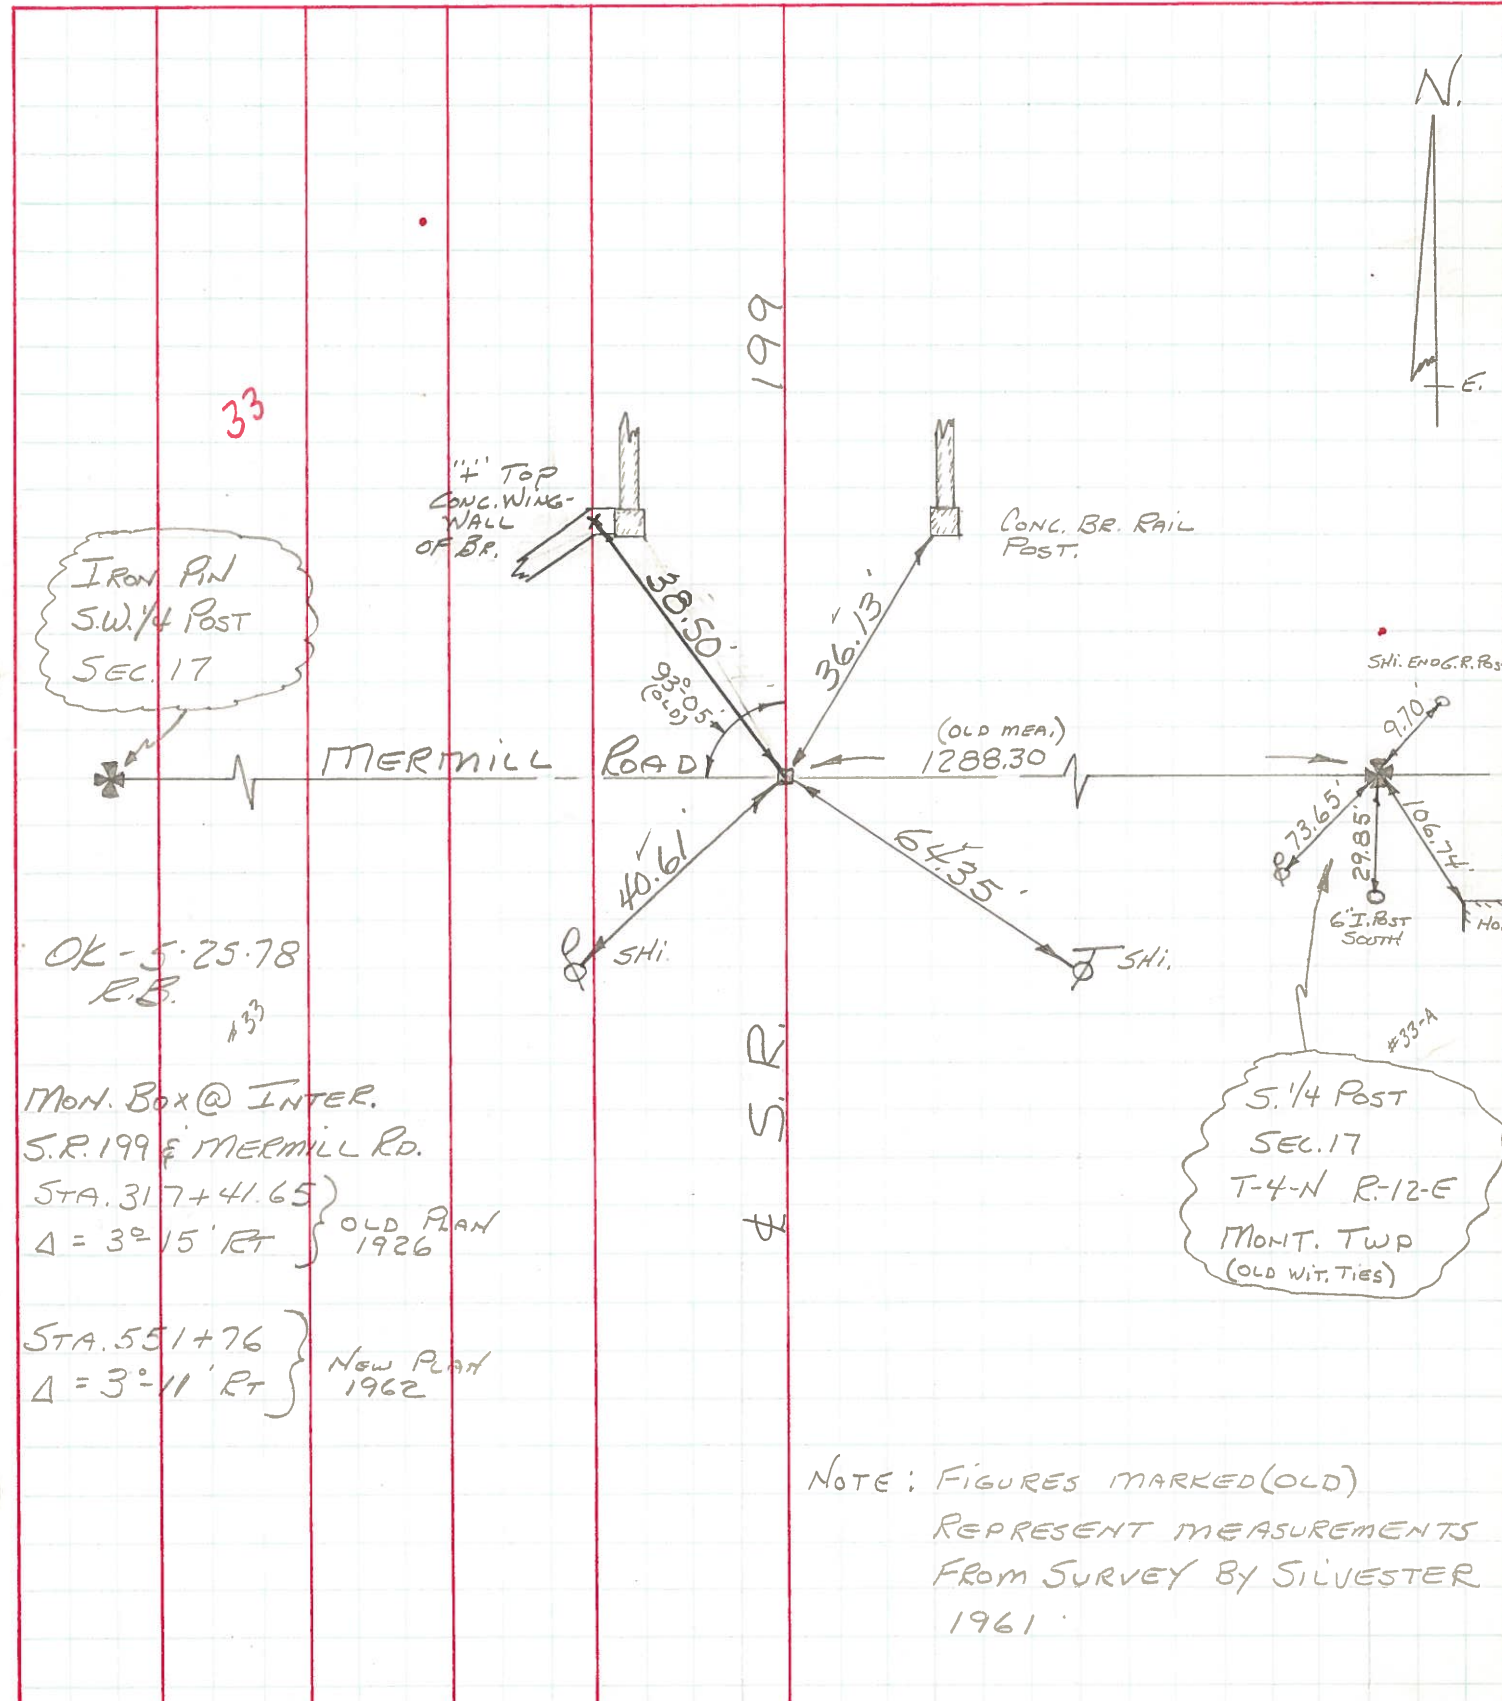


OK-5-25-78
E.B.

MON. BOX @ INTER.
S.R. 199 & MERMILL RD.
STA. 317+41.65 } OLD PLAN 1926
 $\Delta = 3^{\circ}15' RT$
STA. 551+76 } NEW PLAN 1962
 $\Delta = 3^{\circ}11' RT$

NOTE: FIGURES MARKED (OLD) REPRESENT MEASUREMENTS FROM SURVEY BY SILVESTER 1961.

PERSONNEL	TITLE	PERSONNEL	TITLE	COUNTY	DATE	WEATHER	TEMP.
Silvester				Wood	Jan - 1962	Cold & Snow	0
d				S. R. 23			
Crow				SEC.			
DESCRIPTION				JOB NO.			
Left		Center Line		Right			

old Plan + S

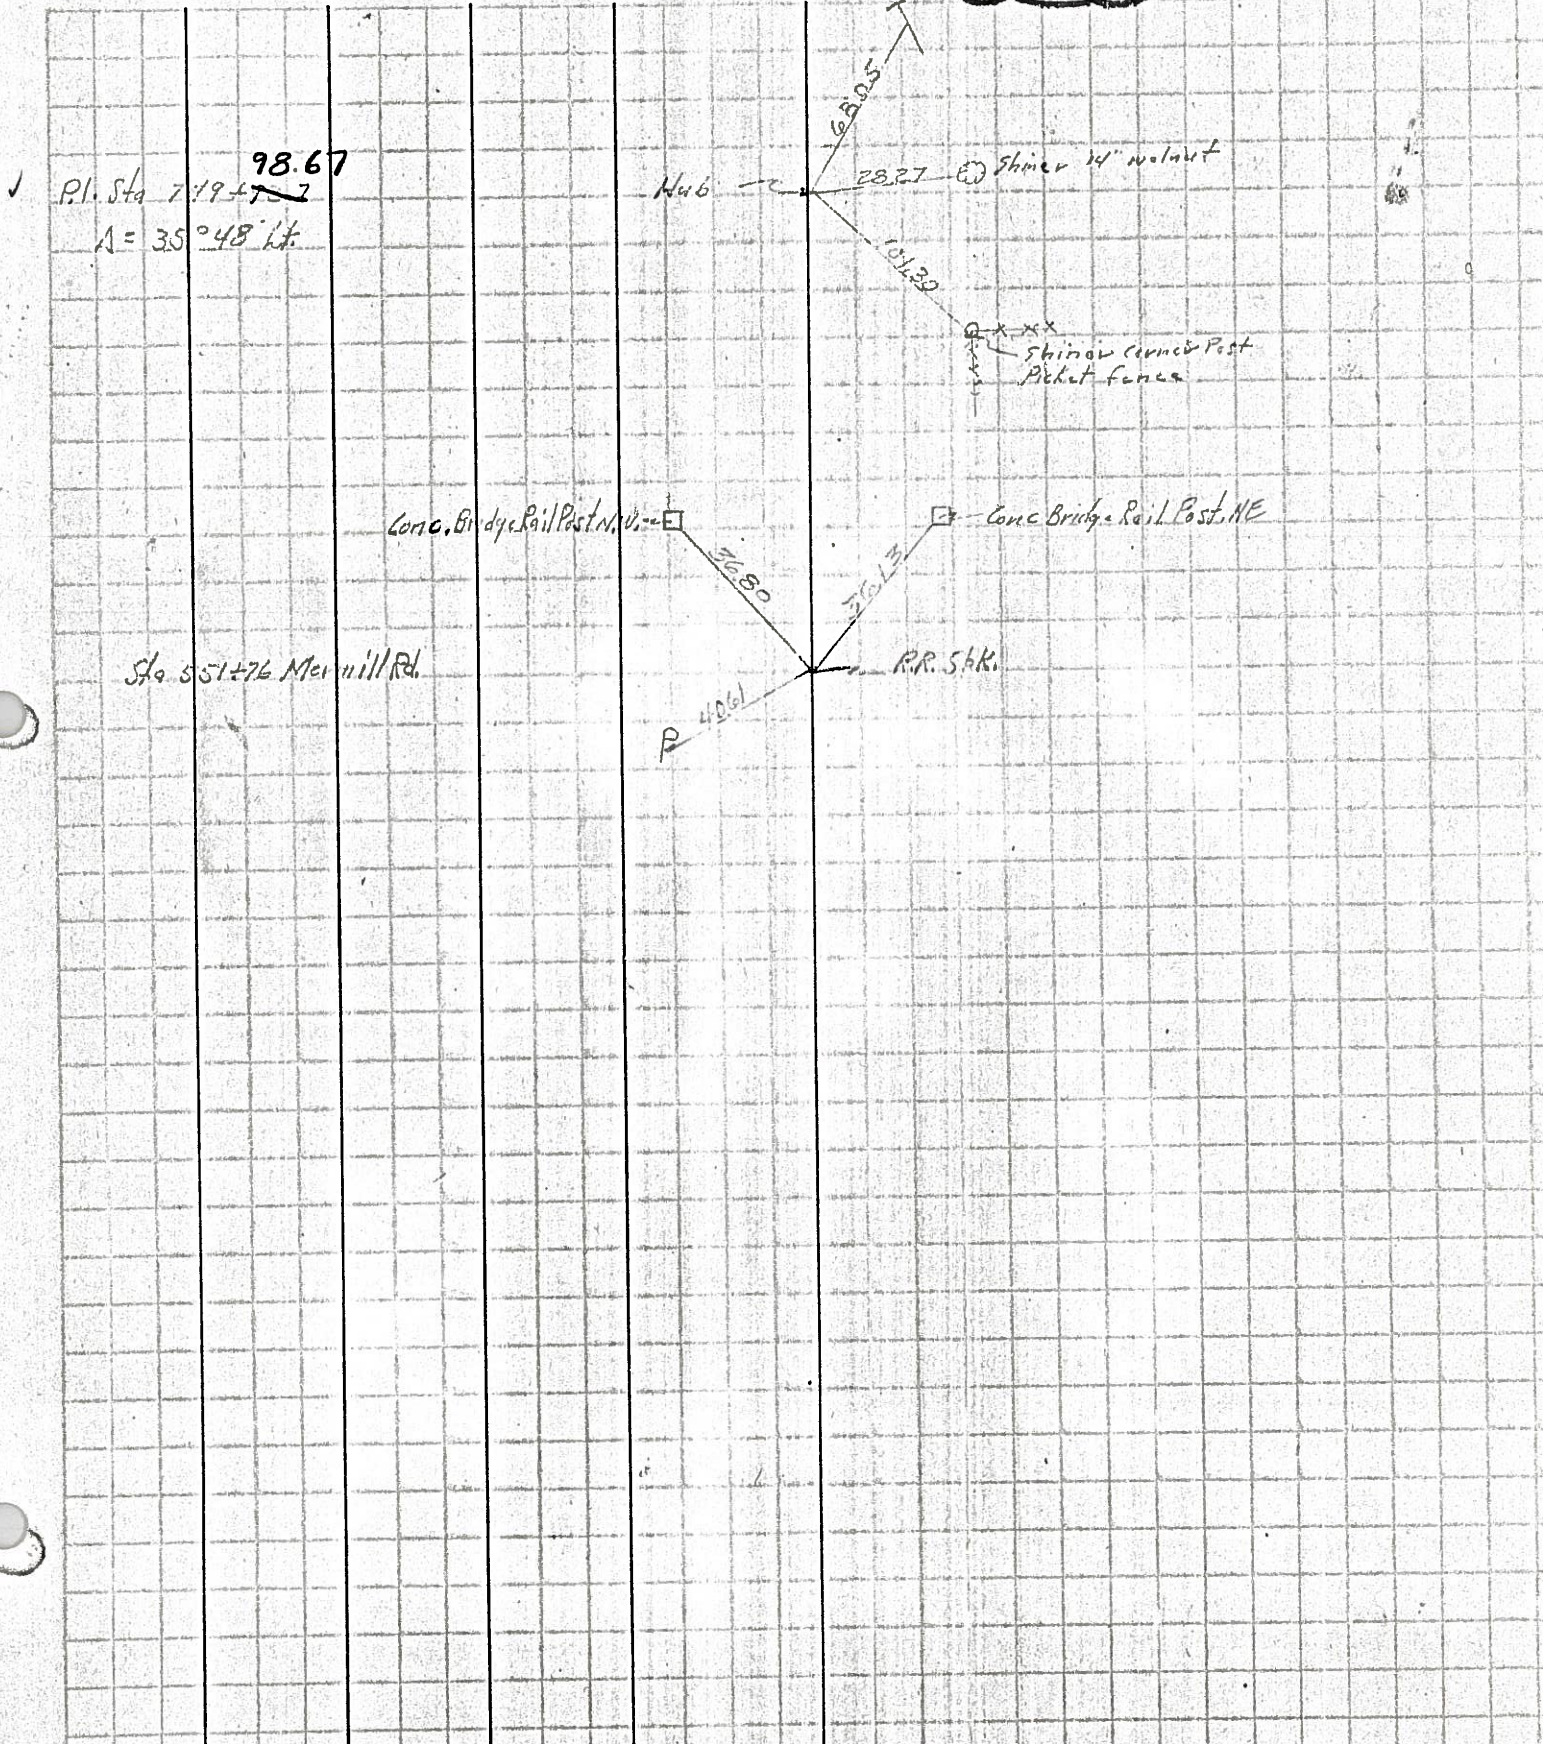

PERSONNEL TITLE PERSONNEL TITLE

COUNTY DATE

S. R. WEATHER

SEC. TEMP.

DESCRIPTION Section #17 Montgomery Twp

JOB NO.

LEFT

CENTER LINE

RIGHT

