

O.D.O.T. DISTRICT 2 SURVEY OFFICE (USE ONLY)

PERSONNEL

REFERENCE NO. 37

SHEET 27 OF 45

NOTES HUSS

DATE 8/21/09

ROUTE SR 199

H.C. CANTERBURY

WEATHER CLOUDY

COUNTY WOOD

R.C. HUSS

TEMP. 85°

TOWNSHIP MONTGOMERY

DWG BY RHOADES PID 101286

SECTION 8

T 4 N R 12 E

TYPE MONUMENT MONBOX

ON SURFACE - ~~BELOW~~ ON

OFFSET Q PAVEMENT ON LT : RT

12.0' TO RT EDGE PAVEMENT


STATION: 618+42

HORIZ.DATUM: NAD83(2011)


GEOID: 2012A

GRID: NORTHING: 601793.351

EASTING: 1692584.636

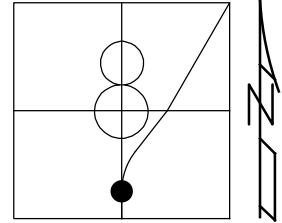

RECORD: T.S.
 STA. 618+43.23
 FD MONBOX
 7/15/87, MDB
 3/16/06, RGN
 8/21/09, MC
 9/16/21, DSA

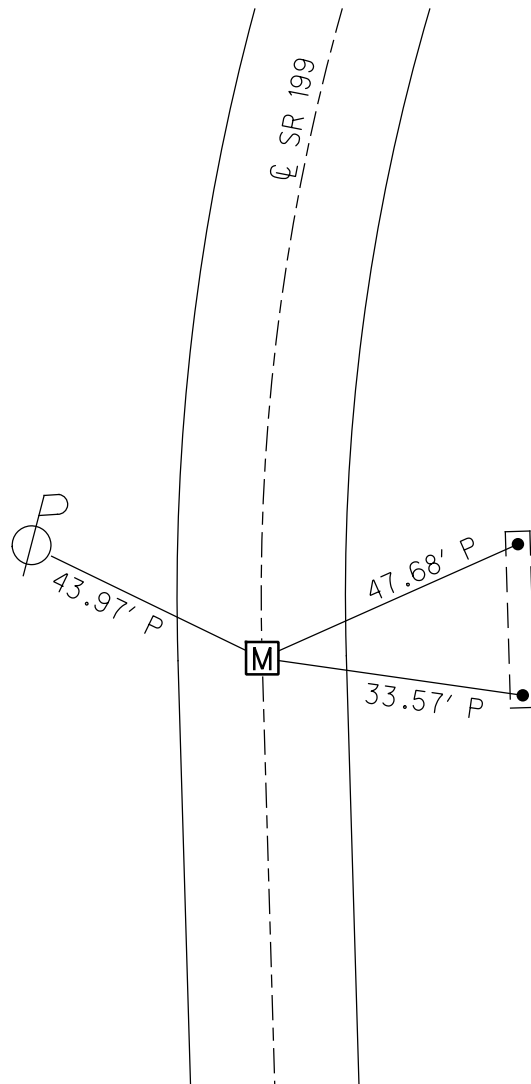


O.D.O.T. DISTRICT 2 SURVEY OFFICE (USE ONLY)


PERSONNEL _____ REFERENCE NO. 37 SHEET 27 OF 45
 NOTES HUSS DATE 08-21-09 ROUTE SR 199
 H.C. CANTERBURY WEATHER CLOUDY COUNTY WOOD
 R.C. HUSS TEMP. 85° F TOWNSHIP MONTGOMERY
 _____ SECTION 8
 _____ T 4 N R 12 E

TYPE MONUMENT _____ MON. BOX _____
 ON SURFACE - ~~BELOW~~ ON _____
~~LEFT~~ - Q PAV'T - ~~RIGHT~~ ON _____
12.0' TO RT. EDGE PAVEMENT
 S.L.M. 618+42

Grid: Northing: 601793.351 Easting: 1692584.636

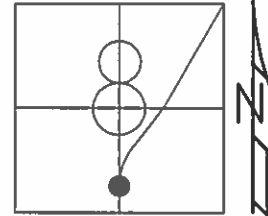

ALL MEASUREMENTS
ARE PLUMBED

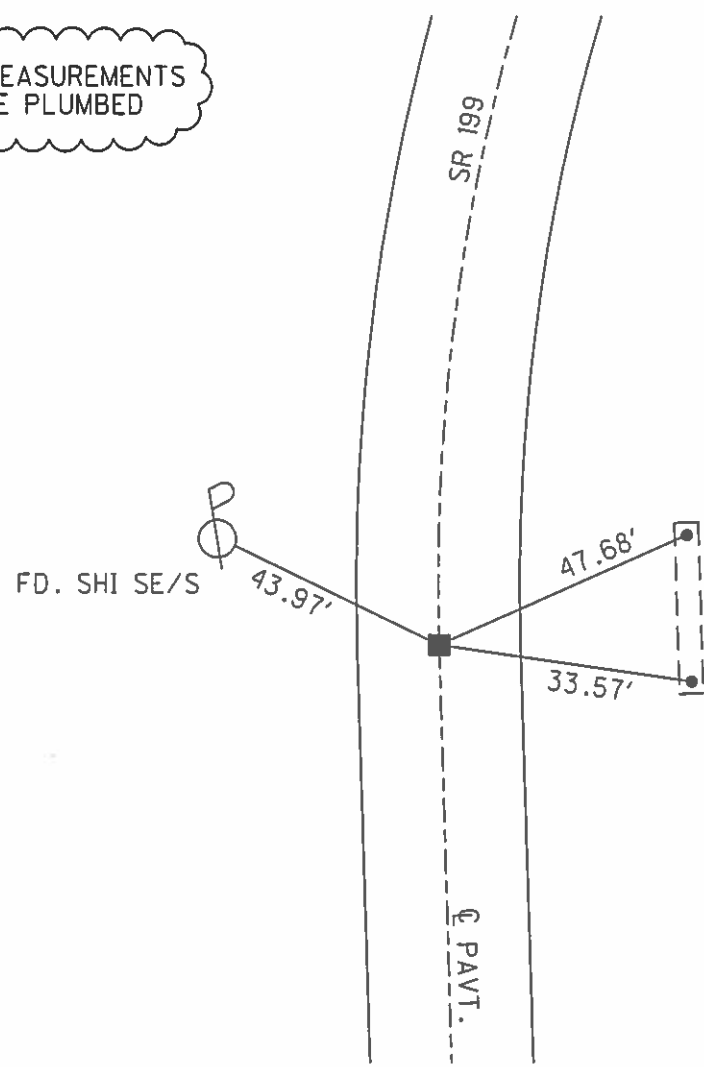

RECORD

T.S.
 STA: 618+43.23
 IRON MON BOX
 07-15-87 MDB
 FD. MON BOX
 03-16-06 RGN
 FD. MON BOX

RECORD
NEW CURVE DATA

$\Delta = 41^\circ-42'$ RT.
 $\Delta_c = 25^\circ-42'$
 DC = $04^\circ-00'$
 LC = 642.50'
 RC = 1432.39'
 $\Theta_s = 08^\circ-00'$
 TS = 747.20'
 LS = 400'
 ES = 105.4'
 Xc = 399.22'
 Yc = 18.59'
 P = 4.65'
 K = 199.87'
 LT = 266.94'
 ST = 133.58'
 LC = 399.65'

O.D.O.T. DISTRICT 2 SURVEY OFFICE

PERSONNEL

REFERENCE NO. 37

SHEET OF

NOTES BARNHISEL

H.C. Loehrke

DATE 7-15-87

ROUTE 199

R.C. Hoffman

WEATHER Sunny

COUNTY WOOD

TEMP. +75°

TOWNSHIP Montgomery

SECTION 8

T 4 N R 12 E


TYPE MONUMENT MON Boxes

ON SURFACE - BELOW yes

~~LEFT - & PAV'T. - RIGHT~~ yes


T.S. 12.3
S.T. 12.0 TO RT EDGE PAVEMENT

S.L.M. T.S. 618+42 P.I. S.T. 632+85

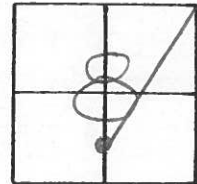

New Curve DATA
 $\Delta = 41^\circ - 42'$ RT
 $\Delta C = 25^\circ - 42'$
 $DC = 4^\circ - 00'$
 $Lc = 642.50'$
 $Rc = 1432.39'$
 $\Theta_s = 8^\circ - 00'$
 $Ts = 747.20$
 $Ls = 400'$
 $Es = 105.4'$
 $Xc = 399.22'$
 $Yc = 18.59'$
 $P = 4.65'$
 $K = 199.87$
 $L.T. = 266.94$
 $S.T. = 133.58'$
 $L.C. = 399.65'$

Note: Did NOT open MON Boxes

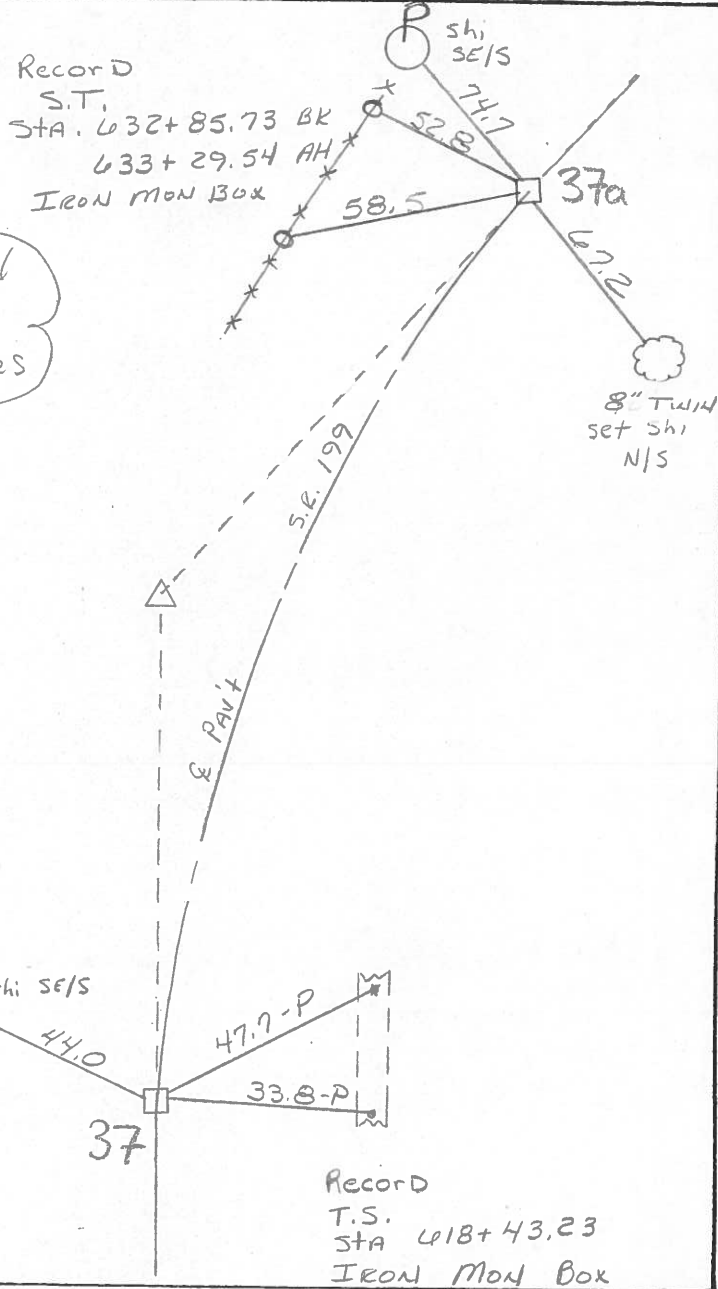

County WOOD S.R. 199

Township MONTGOMERY

Section 8

T N, R E

Personnel BURNSIDE

SMITH


BOWERS

HOLCOMBE

Date 9-28-71 (CHKD 5-25-78)

Weather PT. CLOUDY

Temp. 78°

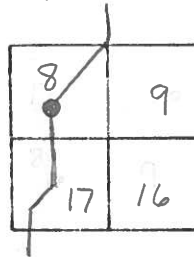


S.T. #37

STA. 632+85.73 BK.

633+29.54 AH.

IRON MONUMENT BOX SHI. IN
10" FENCE POSTS

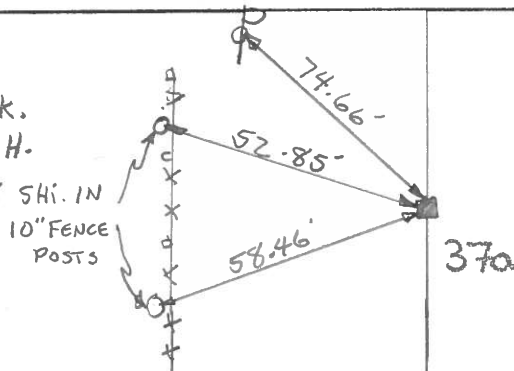

NEW CURVE DATA

$\Delta = 41^{\circ}42' RT.$

$\theta_s = 8^{\circ}00'$

$\Delta_c = 25^{\circ}42'$

TS = 747.20

$D_c = 4^{\circ}00'$

LS = 400'

$L_c = 642.50'$

ES = 105.4'

$R_c = 1432.39'$

$X_c = 399.22'$

$Y_c = 18.59'$

$P = 4.65'$

$K = 199.87'$

L.T. = 266.94'

S.T. 133.58'


L.C. 399.65'

P.I. #37


STA. 625+90.43

CONC. MONUMENT

$\Delta = 41^{\circ}42' RT.$

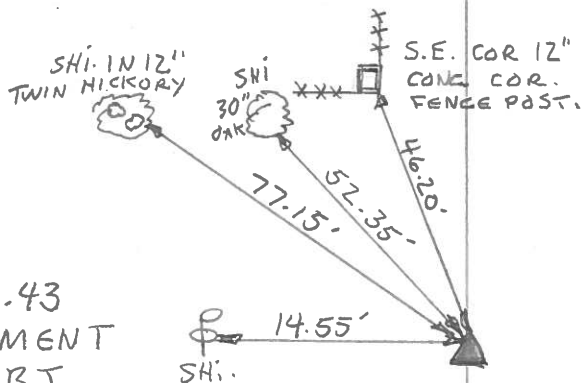

T.S.
STA. 618+43.23 SHI. P
IRON MONUMENT BOX

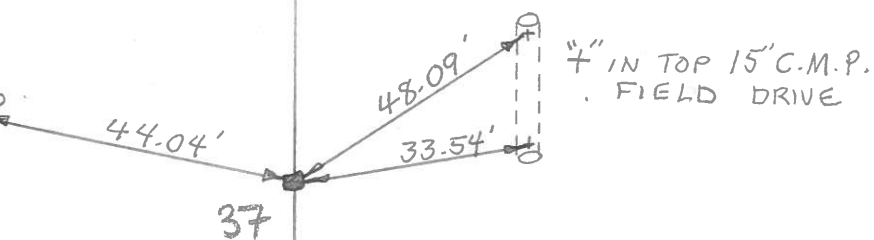

PERSONNEL TITLE PERSONNEL TITLE
 RUPNSIDE _____
 SMITH _____
 BOWERS _____
 HOLCOMBE _____

COUNTY Wood DATE 9-28-71
 S. R. 199 (OLD U.S. 23) WEATHER Pt. Cloudy
 SEC. 1/2 CURVE N. OF GREENSBURG PIKE TEMP. 78°

DESCRIPTION LEFT CENTER LINE RIGHT JOB NO.

