

O.D.O.T. DISTRICT 2 SURVEY OFFICE (USE ONLY)

PERSONNEL

REFERENCE NO. 42

SHEET 38 OF 45

NOTES HUSS DATE 8/25/09

ROUTE SR 199

H.C. CANTERBURY WEATHER SUNNY

COUNTY WOOD

R.C. HUSS TEMP. 84°

TOWNSHIP MONTGOMERY

SECTION 5

DWG BY RHOADES PID 101286

T 4 N R 12 E

TYPE MONUMENT MONBOX W/1" IPIN

ON SURFACE - ~~BELOW~~ ON

OFFSET CL PAVEMENT ON LT : RT

11.7' TO RT EDGE PAVEMENT



STATION: 717+82

HORZ.DATUM: NAD83(2011)

GEOID: 2012A

GRID: NORTHING: 610501.462

EASTING: 1694002.448

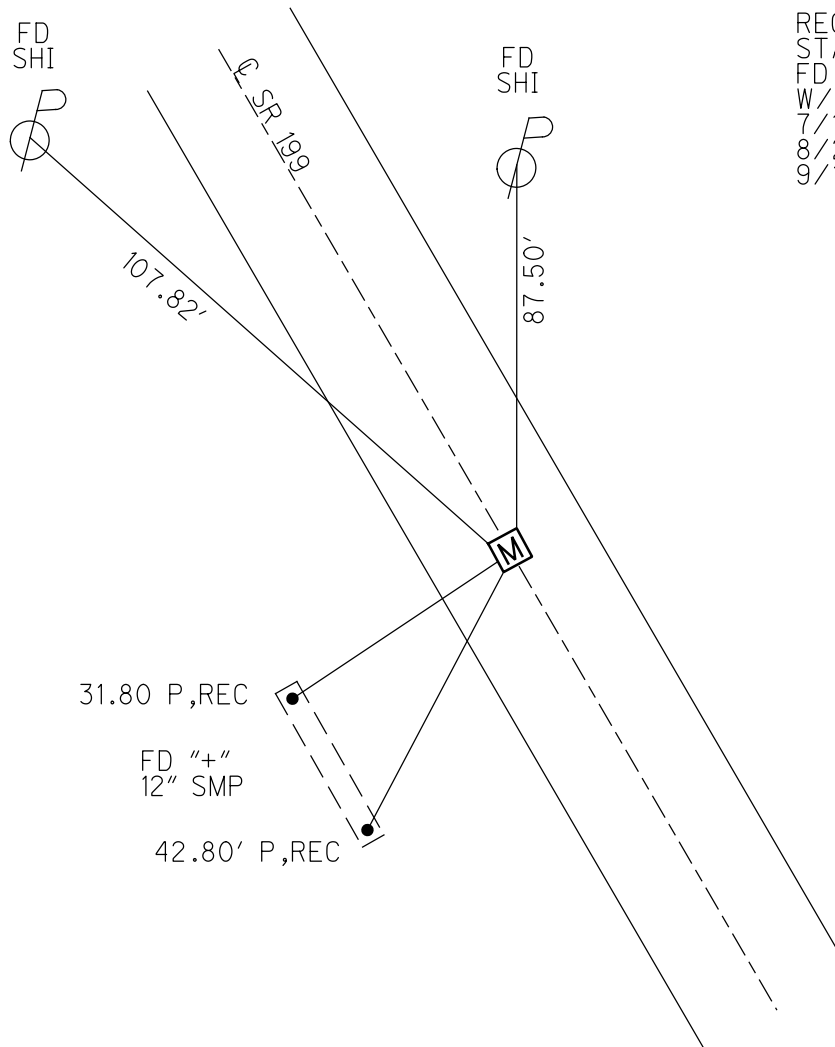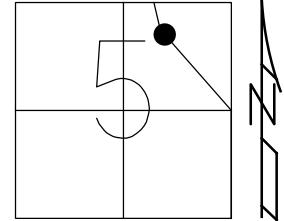


RECORD: T.S.
 STA. 718+59.94
 FD MONBOX
 W/1" IPIN
 7/15/87, MDB
 8/25/09, MC
 9/16/21, DSA

O.D.O.T. DISTRICT 2 SURVEY OFFICE (USE ONLY)

PERSONNEL _____ REFERENCE NO. 42 SHEET 38 OF 45
 NOTES HUSS DATE 08-25-09 ROUTE SR 199
 H.C. CANTERBURY WEATHER SUNNY COUNTY WOOD
 R.C. HUSS TEMP. 84° F TOWNSHIP MONTGOMERY
 _____ SECTION 5
 _____ T. 4 N R. 12 E

TYPE MONUMENT _____ MON. BOX _____
 ON SURFACE - ~~BELOW~~ _____ ON _____
~~LEFT~~ - C PAV'T - ~~RIGHT~~ _____ ON _____
11.7' TO RT. EDGE PAVEMENT
 S.L.M. 717+82
 Grid: Northing: 610501.462 Easting: 1694002.448

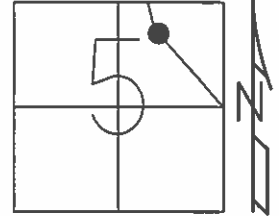


RECORD

T.S.
 STA: 718+59.94
 1" IRON PIN IN MON BOX
 07-15-87 MDB
 FD. MON BOX

RECORD
NEW CURVE DATA

$\Delta = 36^\circ-36'$ RT.
 $\Delta_c = 31^\circ-36'$
 DC = $02^\circ-30'$
 LC = 1264.00'
 RC = 2291.83'
 FORWARD TAN. = 762.83'
 Os = $05^\circ-00'$
 TS = 953.98' (BK)
 LS = 400' (BK)
 Es = 123.62'
 Xc = 399.70'
 Yc = 11.63'
 P = 2.91'
 K = 199.95'

RECORD
 NEW P.I.
 STA: 728+13.92
 DNF

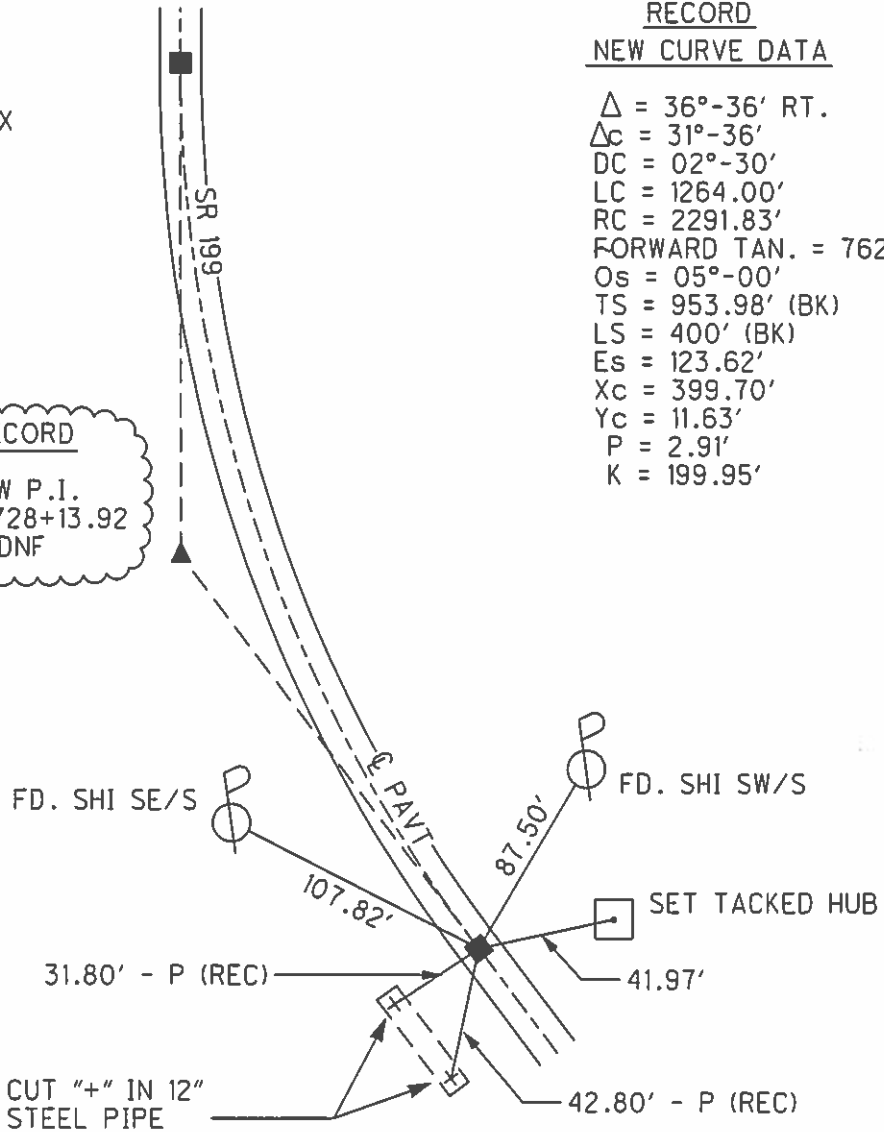

O.D.O.T. DISTRICT 2 SURVEY OFFICE (USE ONLY)

PERSONNEL

NOTES BARNHEISEL

H.C. LOEHRKE

R.C. HOFFMAN

REFERENCE NO. 42

DATE 7/15/87

WEATHER SUNNY

TEMP. 75°

SHEET 1 OF 7

ROUTE 199

COUNTY WOOD

TOWNSHIP MONTGOMERY

SECTION 5

T 4 N R 12 E


TYPE MONUMENT MON. BOX

ON SURFACE - ~~BELOW~~ ON


LEFT - Q PAV'T - RIGHT ON

11.5' TO RT EDGE PAVEMENT

S.L.M. 717+82

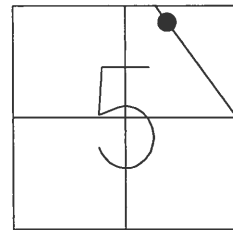

NOTE:
DID NOT
OPEN BOXES

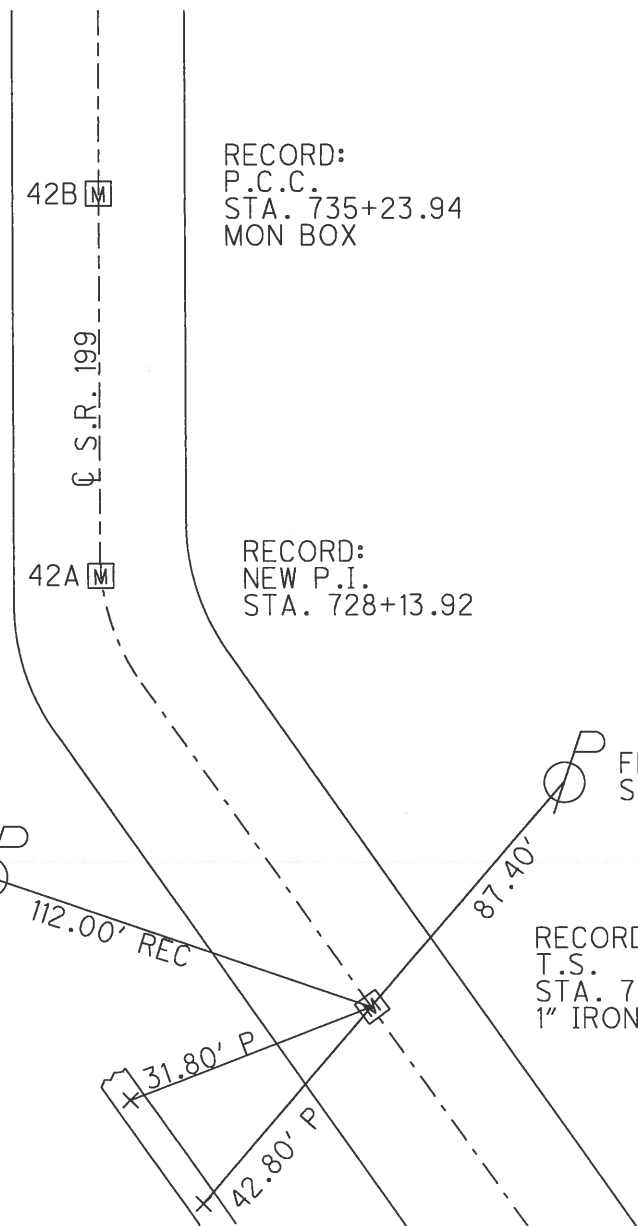

NEW CURVE DATA

- $\Delta = 36^{\circ}36' \text{ RT.}$
- P.I. $728+13.92$
- $\Delta c = 31^{\circ}36'$
- $Dc = 2^{\circ}30'$
- $Lc = 1264.00'$
- $Rc = 2291.88$
- $fd \tan = 762.83'$
- $\Theta_s = 5^{\circ}00'$
- $Ts \text{ (BK)} = 953.98'$
- $LS \text{ (BK)} = 400'$
- $ES = 123.62'$
- $Xc = 399.70'$
- $Yc = 11.63'$
- $P = 2.91'$
- $K = 199.95'$

CUT "X" IN 12"
STEEL PIPE

County WOOD S.R. 199

Date 9-30-71 CHKD 5-25-78

Township MONTGOMERY

Weather CLEAR

Section 5

Temp. +84°


T N, R E

Personnel BURNSIDE

SMITH

BOWERS

HOLCOMBE

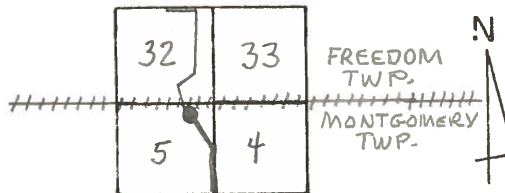

#42

P.I. (OLD)

STA. 723+72.74

$\Delta = 19^\circ - 54' \text{ RT.}$

1" I. PIN IN

CONC. MON.

COR. BLK HO. FDN.
TOP OF 2ND BLK.

HOUSE

COR. BRICK PORCH
(TOP 2ND BRICK UP)

SHI. IN 42"
MAPLE

SHI. ϕ 105.60
(D)

P 172.92
(D)

49.88'

75.89'

75.16'

89.88'

42A

P.C.C.
735+23.94
MON. BOX

NEW CURVE DATA

$\Delta = 36^\circ - 36' \text{ RT.}$ $\Theta_s = 5^\circ - 00'$
P.I. 728+13.92 $T_s \text{ (BK.)} = 953.98'$
 $\Delta E = 31^\circ - 36'$ $L_s \text{ (BK.)} = 400'$
 $D_c = 2^\circ - 30'$ $E_s = 123.62'$
 $L_c = 1264.00'$ $X_c = 399.70'$
 $R_c = 2291.83$ $Y_c = 11.63'$
FORWARD $\overline{WNG.} 76283'$ $P = 2.91'$
 $K = 199.95'$

BACK TANGENT

SHI. ϕ 112.00'

SHI. ϕ 87.41'

T.S. STA. 718+59.94


1" IRON PIN IN MON BOX

42

PERSONNEL TITLE PERSONNEL TITLE
BURNSIDE _____
SMITH _____
BOWERS _____
HOLCOMBE _____

COUNTY Wood DATE 9-30-71
 S. R. 199 WEATHER CLEAR
 SEC. CURVE @ HOLCOMBE RD. TEMP. +84°

DESCRIPTION LEFT CENTER LINE RIGHT JOB NO.

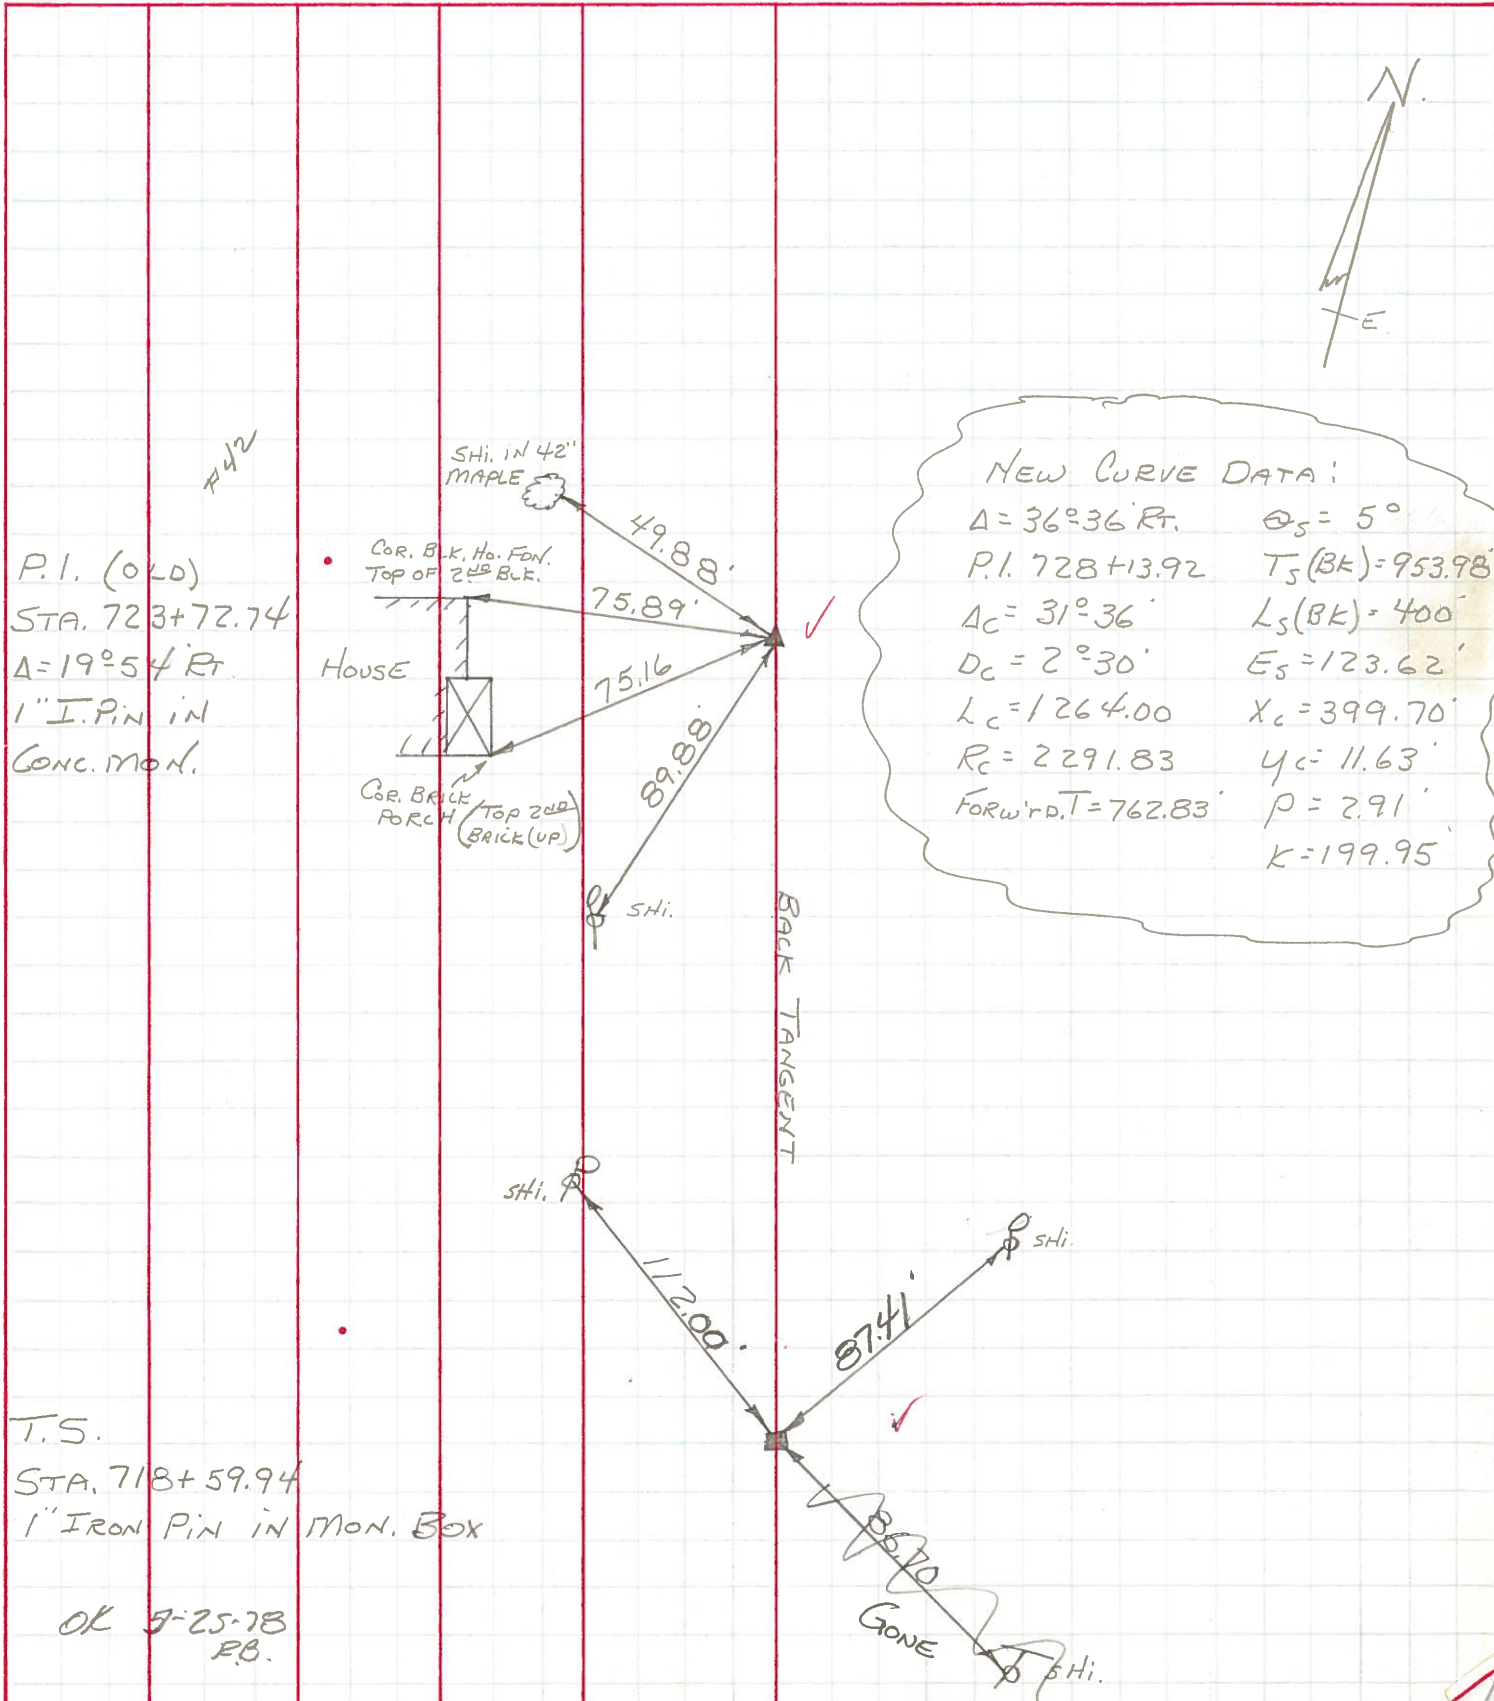

T.S.
 STA. $718+59.94$
 1" IRON PIN IN MON. BOX
 OK 9-25-78
 P.B.