



O.D.O.T. DISTRICT 2 SURVEY OFFICE (USE ONLY)

PERSONNEL _____ REFERENCE NO. 42 A SHEET 39 OF 45
 NOTES HUSS DATE 8/25/09 ROUTE SR 199
 H.C. CANTERBURY WEATHER SUNNY COUNTY WOOD
 R.C. HUSS TEMP. 84° TOWNSHIP MONTGOMERY
 DWG BY RHOADES PID 101286 SECTION 5
 T 4 N R 12 E

TYPE MONUMENT MONBOX
 ON SURFACE - ~~BELOW~~ ON
 OFFSET Q PAVEMENT ON LT : RT
11.7' TO RT EDGE PAVEMENT
 STATION: 734+58

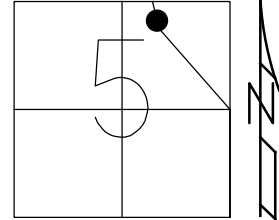

HORZ.DATUM: NAD83(2011) GEOID: 2012A
 GRID: NORTHING: 612073.801 EASTING: 1693571.181


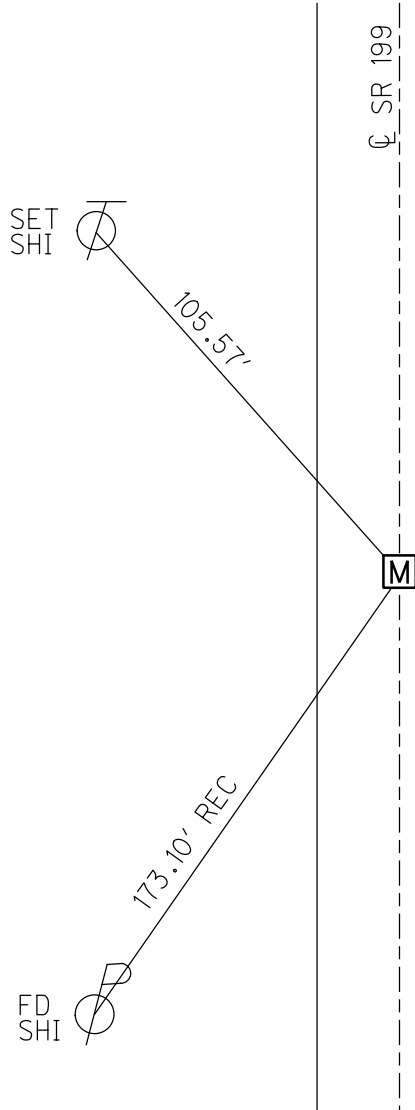


RECORD: P.C.C.
 STA. 735+23.94
 FD MONBOX
 7/15/87, MDB
 8/25/09, MC
 9/16/21, DSA

O.D.O.T. DISTRICT 2 SURVEY OFFICE (USE ONLY)

PERSONNEL _____ REFERENCE NO. 42A SHEET 39 OF 45
 NOTES HUSS DATE 08-25-09 ROUTE SR 199
 H.C. CANTERBURY WEATHER SUNNY COUNTY WOOD
 R.C. HUSS TEMP. 84° F TOWNSHIP MONTGOMERY
 _____ SECTION 5
 _____ T 4 N R 12 E

TYPE MONUMENT MON. BOX
 ON SURFACE - ~~BELOW~~ ON _____
~~LEFT~~ - Q PAV'T - ~~RIGHT~~ ON _____
11.7' TO RT. EDGE PAVEMENT
 S.L.M. 717+81
 Grid: Northing: 612073.801 Easting: 1693571.181

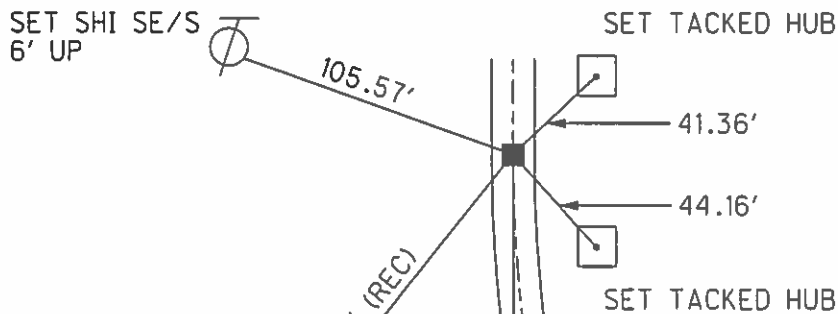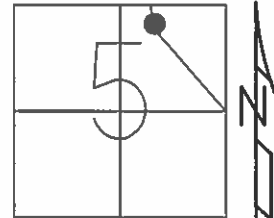

RECORD
NEW CURVE DATA

$\Delta = 36^{\circ}-36'$ RT.
 $\Delta_c = 31^{\circ}-36'$
 DC = $02^{\circ}-30'$
 LC = 1264.00'
 RC = 2291.83'
 FORWARD TAN. = 762.83'
 Os = $05^{\circ}-00'$
 TS = 953.98' (BK)
 LS = 400' (BK)
 Es = 123.62'
 Xc = 399.70'
 Yc = 11.63'
 P = 2.91'
 K = 199.95'

RECORD
 NEW P.I.
 STA: 728+13.92
 DNF

RECORD

P.C.C.
 STA: 735+23.94
 MON BOX

07-15-87 MDB
 FD. MON BOX

O.D.O.T. DISTRICT 2 SURVEY OFFICE (USE ONLY)

PERSONNEL

NOTES BARNHISEL
 H.C. LOEHRKE
 R.C. HOFFMAN



REFERENCE NO. 42 B

DATE 7/15/87
 WEATHER SUNNY
 TEMP. 75°

SHEET 3 OF 7

ROUTE 199
 COUNTY WOOD
 TOWNSHIP MONTGOMERY
 SECTION 5
 T 4 N R 12 E

TYPE MONUMENT MON. BOX
 ON SURFACE - ~~BELOW~~ ON
 LEFT - Q PAV'T - RIGHT ON
11.5' TO RT EDGE PAVEMENT
 S.L.M. 734+45

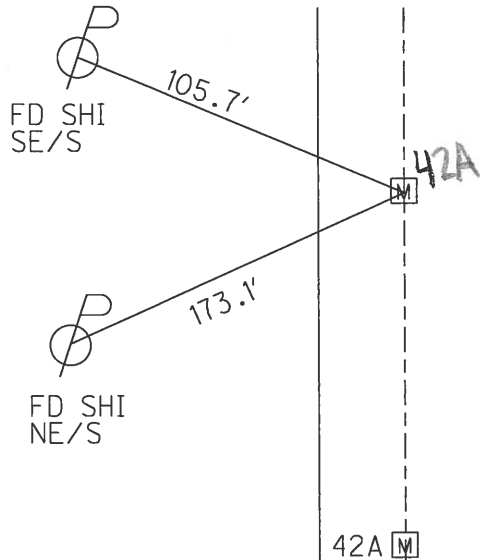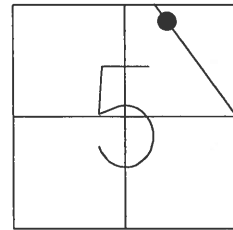

RECORD:
 P.C.C.
 STA. 735+23.94
 MON BOX

RECORD:
 NEW P.I.
 STA. 728+13.92

NEW CURVE DATA



$\Delta = 36^{\circ}36'$ RT.
 P.I. 728+13.92
 $\Delta c = 31^{\circ}36'$
 $Dc = 2^{\circ}30'$
 $Lc = 1264.00'$
 $Rc = 2291.88$
 $fd \tan = 762.83'$
 $\Theta_s = 5^{\circ}00'$
 $Ts (BK) = 953.98'$
 $LS (BK) = 400'$
 $ES = 123.62'$
 $Xc = 399.70'$
 $Yc = 11.63'$
 $P = 2.91'$
 $K = 199.95'$

RECORD:
 T.S.
 STA. 718+59.94
 1" IRON PIN IN MON BOX

NOTE:
 DID NOT
 OPEN BOXES

County WOOD S.R. 199
 Township MONTGOMERY
 Section 5
 T. N, R. E
 Personnel BURNSIDE
SMITH
BOWERS
HOLCOMBE

Date 9-30-71 CHKD
5-25-78
 Weather CLEAR
 Temp. +84°

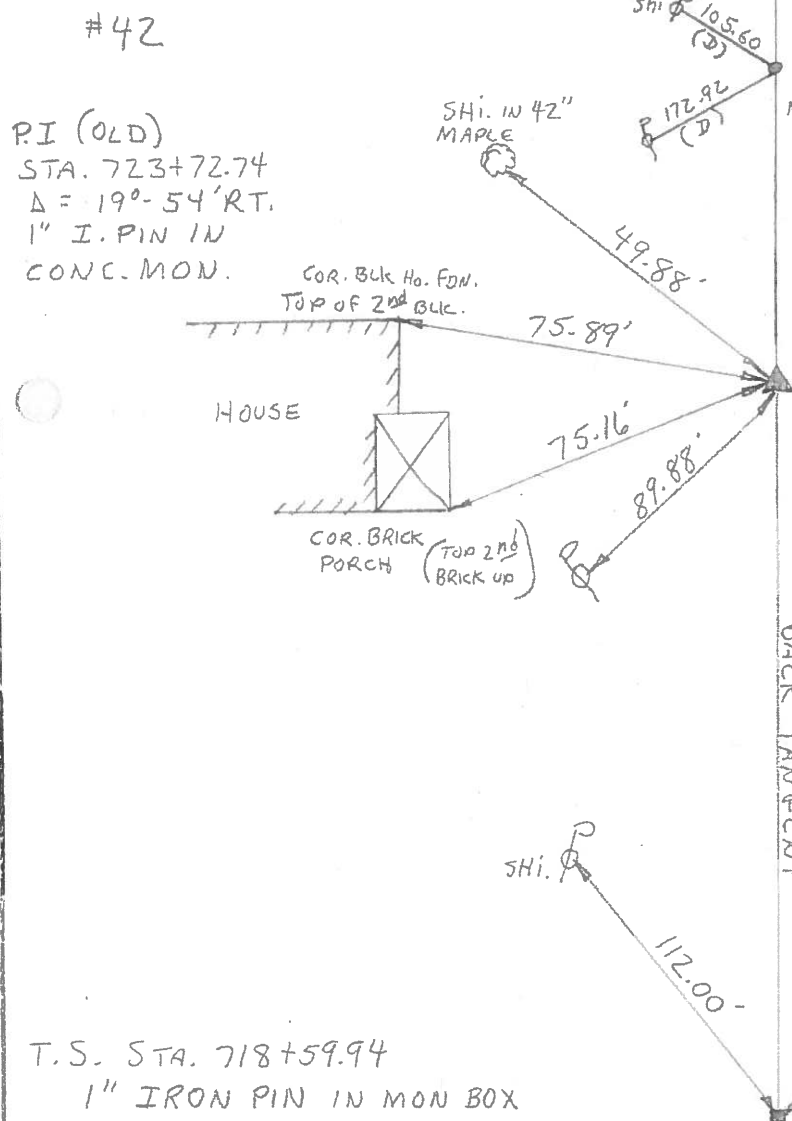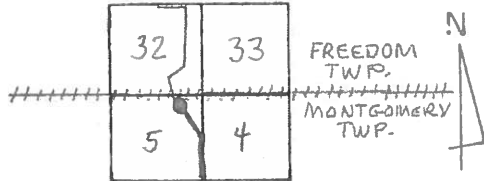

42A
 P.C.C.
 735+23.94
 MON. BOX

NEW CURVE DATA
 $\Delta = 36^\circ-36' RT.$ $\Delta s = 5^\circ-00'$
 P.I. 728+13.92 $T_s (BK.) = 953.98'$
 $\Delta E = 31^\circ-36'$ $L_s (BK.) = 400'$
 $D_c = 2^\circ-30'$ $E_s = 123.62'$
 $L_c = 1264.00'$ $X_c = 399.70'$
 $R_c = 2291.83$ $Y_c = 11.63'$
 FORWARD $\Delta = 76.283'$ $P = 2.91'$
 $K = 199.95'$

BACK TANGENT

42

PERSONNEL	TITLE	PERSONNEL	TITLE
BURNSIDE			
SMITH			
BOWERS			
HOLCOMBE			

COUNTY WOOD DATE 10-4-71
 S. R. 199 WEATHER CLEAR
 SEC. CURVE @ HOLCOMBE RD. TEMP. +72°

DESCRIPTION _____ LEFT _____ CENTER LINE _____ RIGHT _____ JOB NO. _____

