

O.D.O.T. DISTRICT 2 SURVEY OFFICE (USE ONLY)

PERSONNEL

REFERENCE NO. 43

SHEET 40 OF 45

NOTES HUSS

DATE 8/25/09

ROUTE SR 199

H.C. CANTERBURY

WEATHER SUNNY

COUNTY WOOD

R.C. HUSS

TEMP. 84°

TOWNSHIP MONTGOMERY

DWG BY RHOADES PID 101286

SECTION 32

T 5 N R 12 E

TYPE MONUMENT 3/4" IPIN

~~ON SURFACE~~ - BELOW 3"


OFFSET \odot PAVEMENT 164' LT : ~~RT~~

- TO - EDGE PAVEMENT


STATION: 736+65

HORZ.DATUM: _____ GEOID: _____

GRID: NORTHING: _____ EASTING: _____

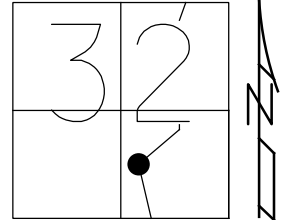

RECORD: P.I.
 STA. 737+96.36
 $\Delta = 48^\circ 06' RT$
 FD R.R.SPIKE
 SET 3/4" IPIN
 FD 3/4" IPIN
 3" DOWN
 8/25/09, MC

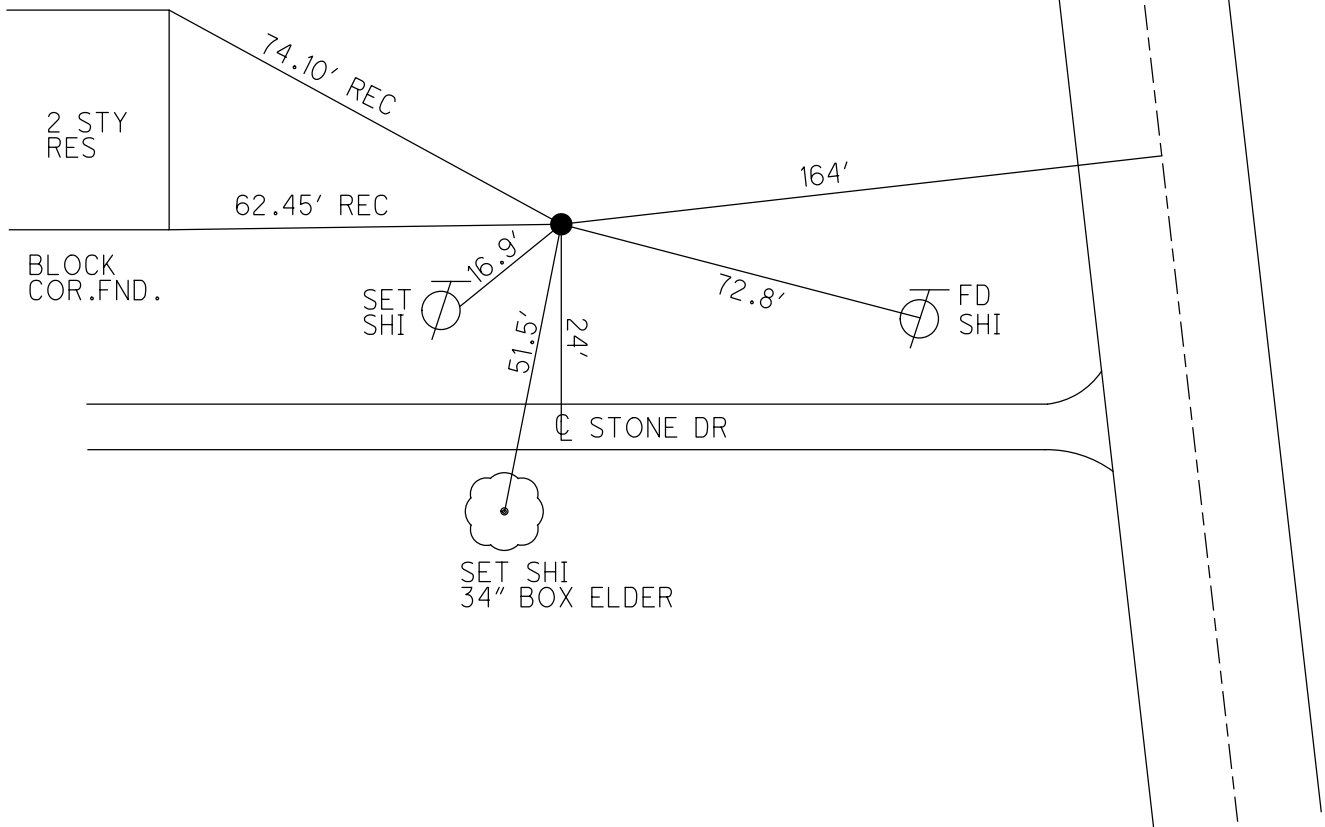

O.D.O.T. DISTRICT 2 SURVEY OFFICE (USE ONLY)

PERSONNEL _____

REFERENCE NO. 43

SHEET 40 OF 45

NOTES HUSS

DATE 8/25/09

ROUTE SR 199

H.C. CANTERBURY

WEATHER SUNNY

COUNTY WOOD

R.C. HUSS

TEMP. 84°

TOWNSHIP FREEDOM

SECTION 32

T 5 N R 12 E

TYPE MONUMENT 3/4" IRON ROD


~~ON SURFACE~~ - BELOW 3"

~~LEFT~~ - Q PAV'T - RIGHT 164'

- TO - EDGE PAVEMENT


S.L.M. 736+65

Grid: Northing: - Easting: -

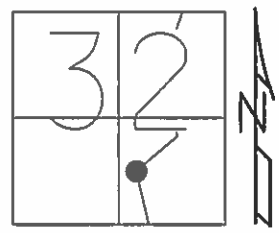

RECORD

OLD P.I.
 STA: 737+96.36
 $\Delta = 48^{\circ}-06'$ RT.
 FD. RRSPK FROM OLD TIES
 SET 3/4" IRON ROD
 3' LONG FLUSH TO GROUND

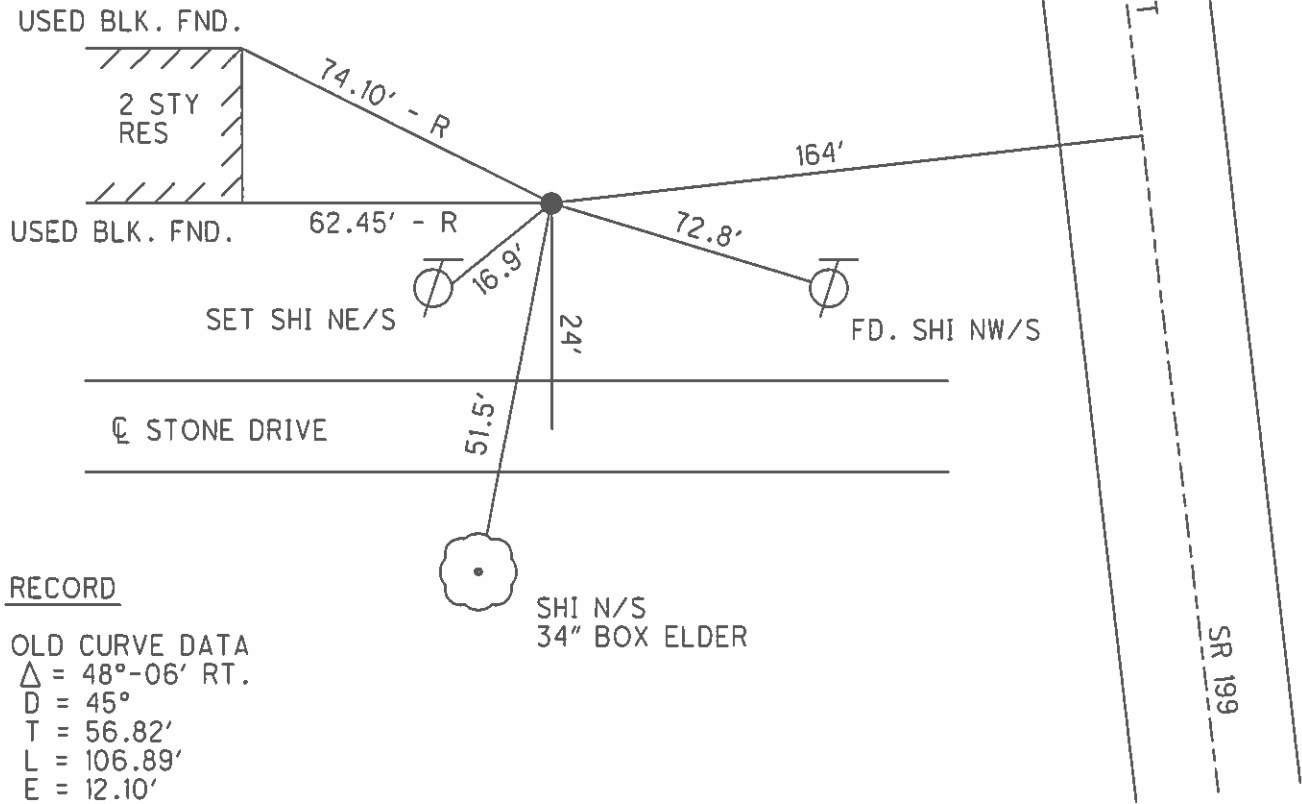

RECORD


OLD CURVE DATA
 $\Delta = 48^{\circ}-06'$ RT.
 D = 45°
 T = 56.82'
 L = 106.89'
 E = 12.10'
 R = 127.32'

SHI N/S
 34" BOX ELDER

O.D.O.T. DISTRICT 2 SURVEY OFFICE (USE ONLY)


PERSONNEL _____ REFERENCE NO. 43 SHEET 4 OF 7
 NOTES BARNHISEL DATE 7/15/82 ROUTE 199
 H.C. LOEHRKE WEATHER SUNNY COUNTY WOOD
 R.C. HOFFMAN TEMP. 75° TOWNSHIP FREEDOM
 _____ SECTION 32
 _____ T 5 N R 12 E

TYPE MONUMENT 3/4" IPIN
~~ON SURFACE~~ - BELOW 3"
 LEFT - Q PAV'T - ~~RIGHT~~ 164'
 _____ TO _____ EDGE PAVEMENT
 S.L.M. 736+65

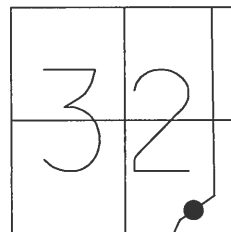

OLD CURVE DATA:

$\Delta = 48^{\circ}06'$ RT.
 D = 45°
 T = 56.82'
 L = 106.89'
 E = 12.10'
 R = 127.32'

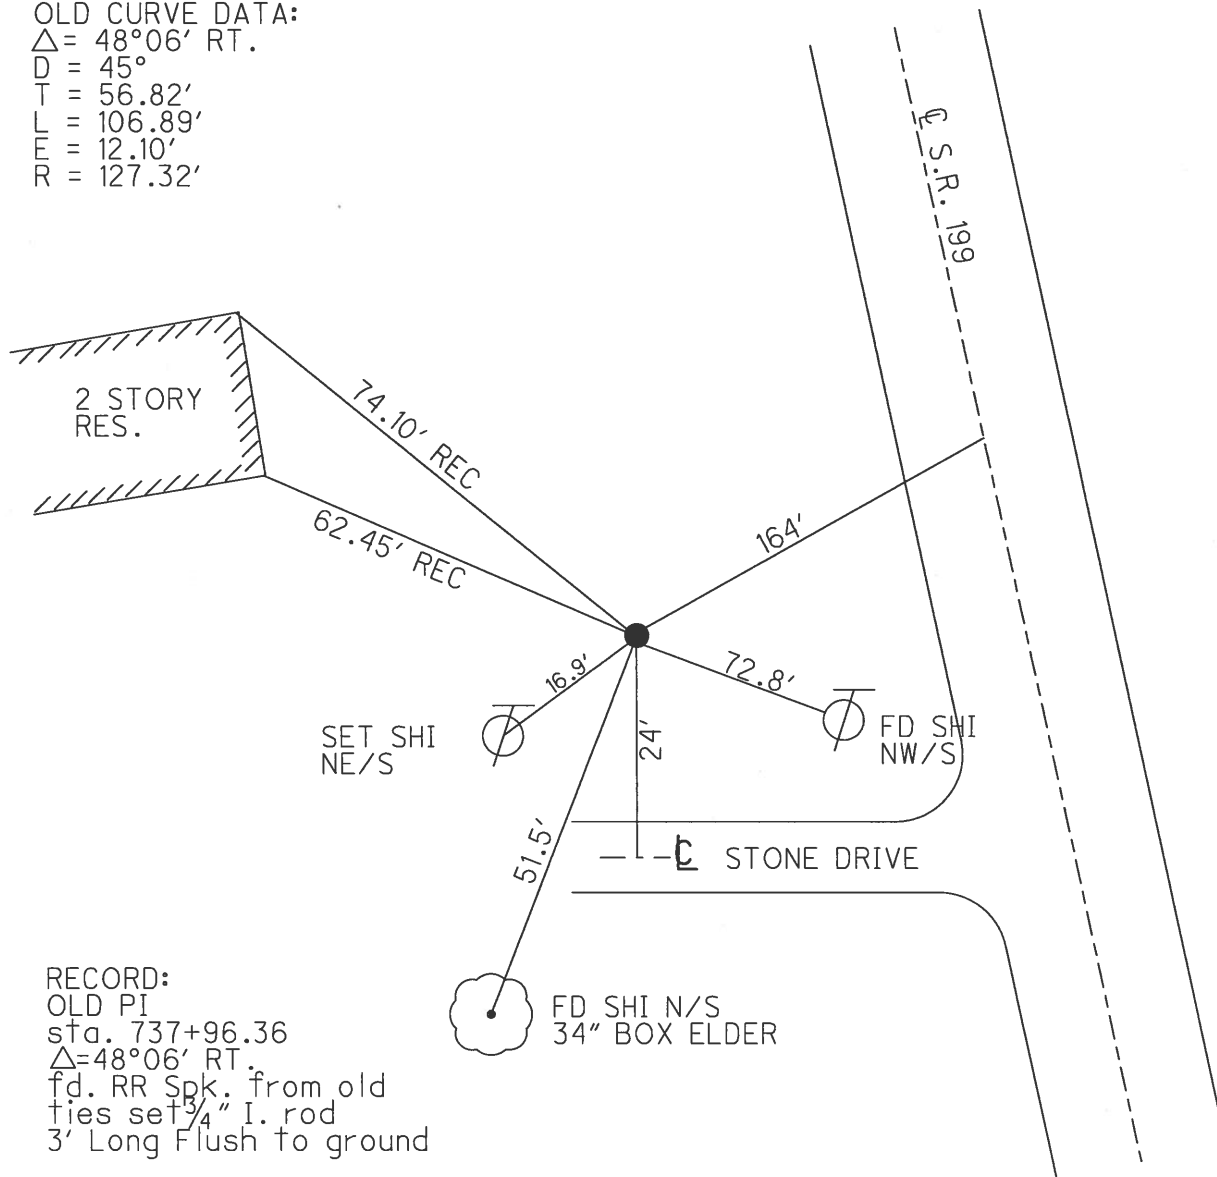

RECORD:
 OLD PI
 sta. 737+96.36
 $\Delta = 48^{\circ}06'$ RT.
 fd. RR Spk. from old
 ties set $3/4"$ I. rod
 3' Long Flush to ground

O.D.O.T. DISTRICT 2 SURVEY OFFICE

PERSONNEL _____

REFERENCE NO. 43

SHEET _____ OF _____

NOTES _____

H.C. _____

R.C. _____

DATE _____

WEATHER _____

TEMP. _____

ROUTE 199

COUNTY WOOD

TOWNSHIP FREEDOM

SECTION 32

T 5 N R 12 E


TYPE MONUMENT 3/4" IRON ROD

ON SURFACE - BELOW 3'



LEFT-~~CE~~ PAV'T. - RIGHT 164'

- TO - EDGE PAVEMENT

S.L.M. 736+65

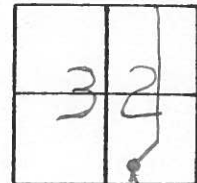

Old Curve DATA
 $\Delta = 48'-06''$ RT
 $D = 45^\circ$
 $T = 56.82'$
 $L = 106.89'$
 $E = 12.10'$
 $R = 127.32'$

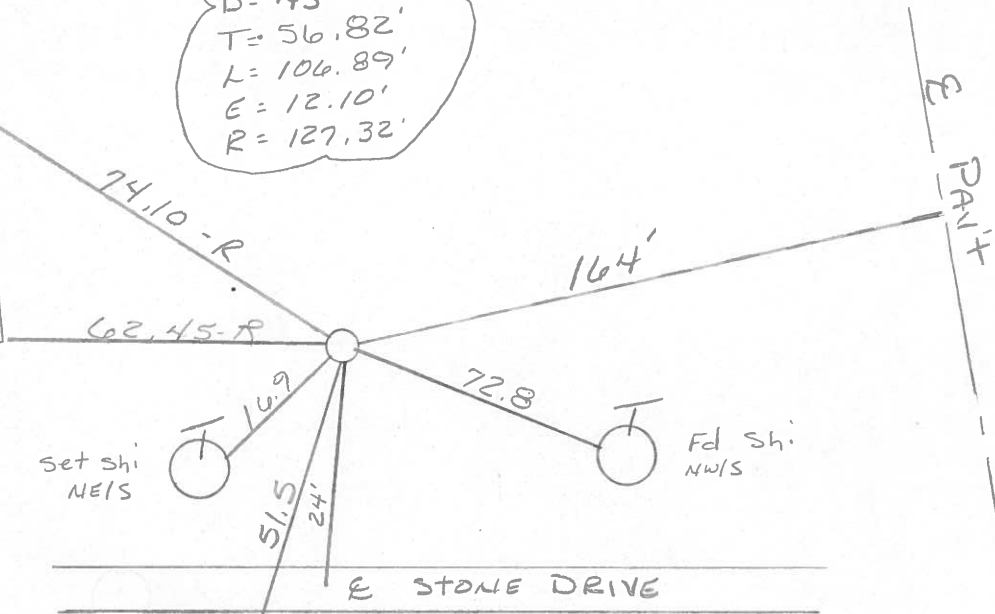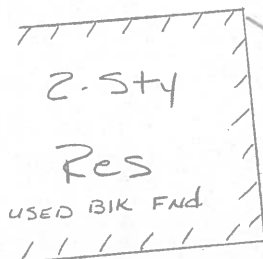

Set Shi
N/S

Fd Shi
NWS

E STONE DRIVE

Shi N/S
34" BOX ELDER

Record
Old P.I.
STA 737+96.36
 $\Delta = 48^\circ-06'$ RT
Fd RR Spk From Old
Ties. Set 3/4" I. Rod
3' Long Flush to ground

S.R. 199

County WOOD S.R. 199

Township FREEDOM

Section 32

T N, R E

Personnel BURNSIDE

SMITH


BOWERS

HOLCOMBE

Date 10-4-71 (CHKD 5-25-78)


Weather CLEAR

Temp. 72°

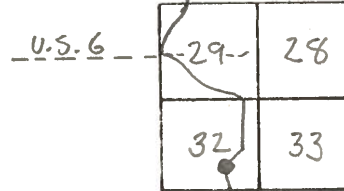

#43

OLD CURVE DATA
 $\Delta = 48^{\circ} 06' RT.$
 $D = 45'$
 $T = 56.82'$
 $L = 106.89'$
 $E = 12.10'$
 $R = 127.32'$

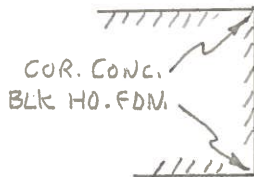


OLD P.I.

STA. 737+96.36

$\Delta = 48^{\circ} 06' RT.$


FD. R.R. SPK. FROM OLD TIES. SET $\frac{3}{4}$ " I. ROD 3' LONG FLUSH TO GROUND.

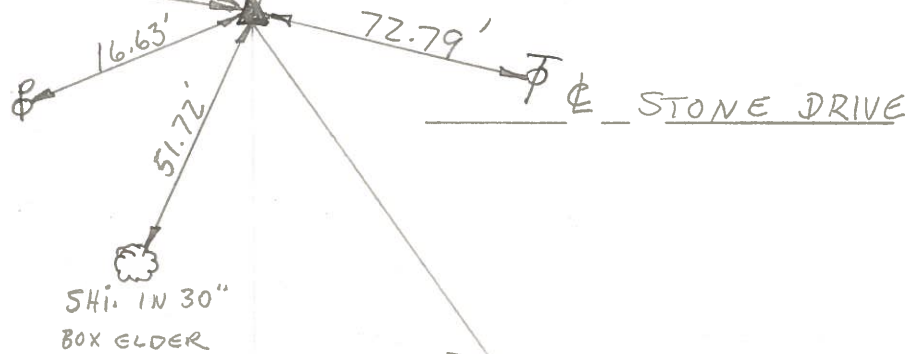

PERSONNEL TITLE PERSONNEL TITLE
 BURNSIDE _____
 SMITH _____
 BOWERS _____
 HOLCOMBE _____

COUNTY Wood DATE 10-4-71
 S. R. 199 WEATHER CLEAR
 SEC. _____ TEMP. +72°

DESCRIPTION OLD P.I. NORTH OF HOLCOMBE RD JOB NO. _____
 LEFT CENTER LINE RIGHT

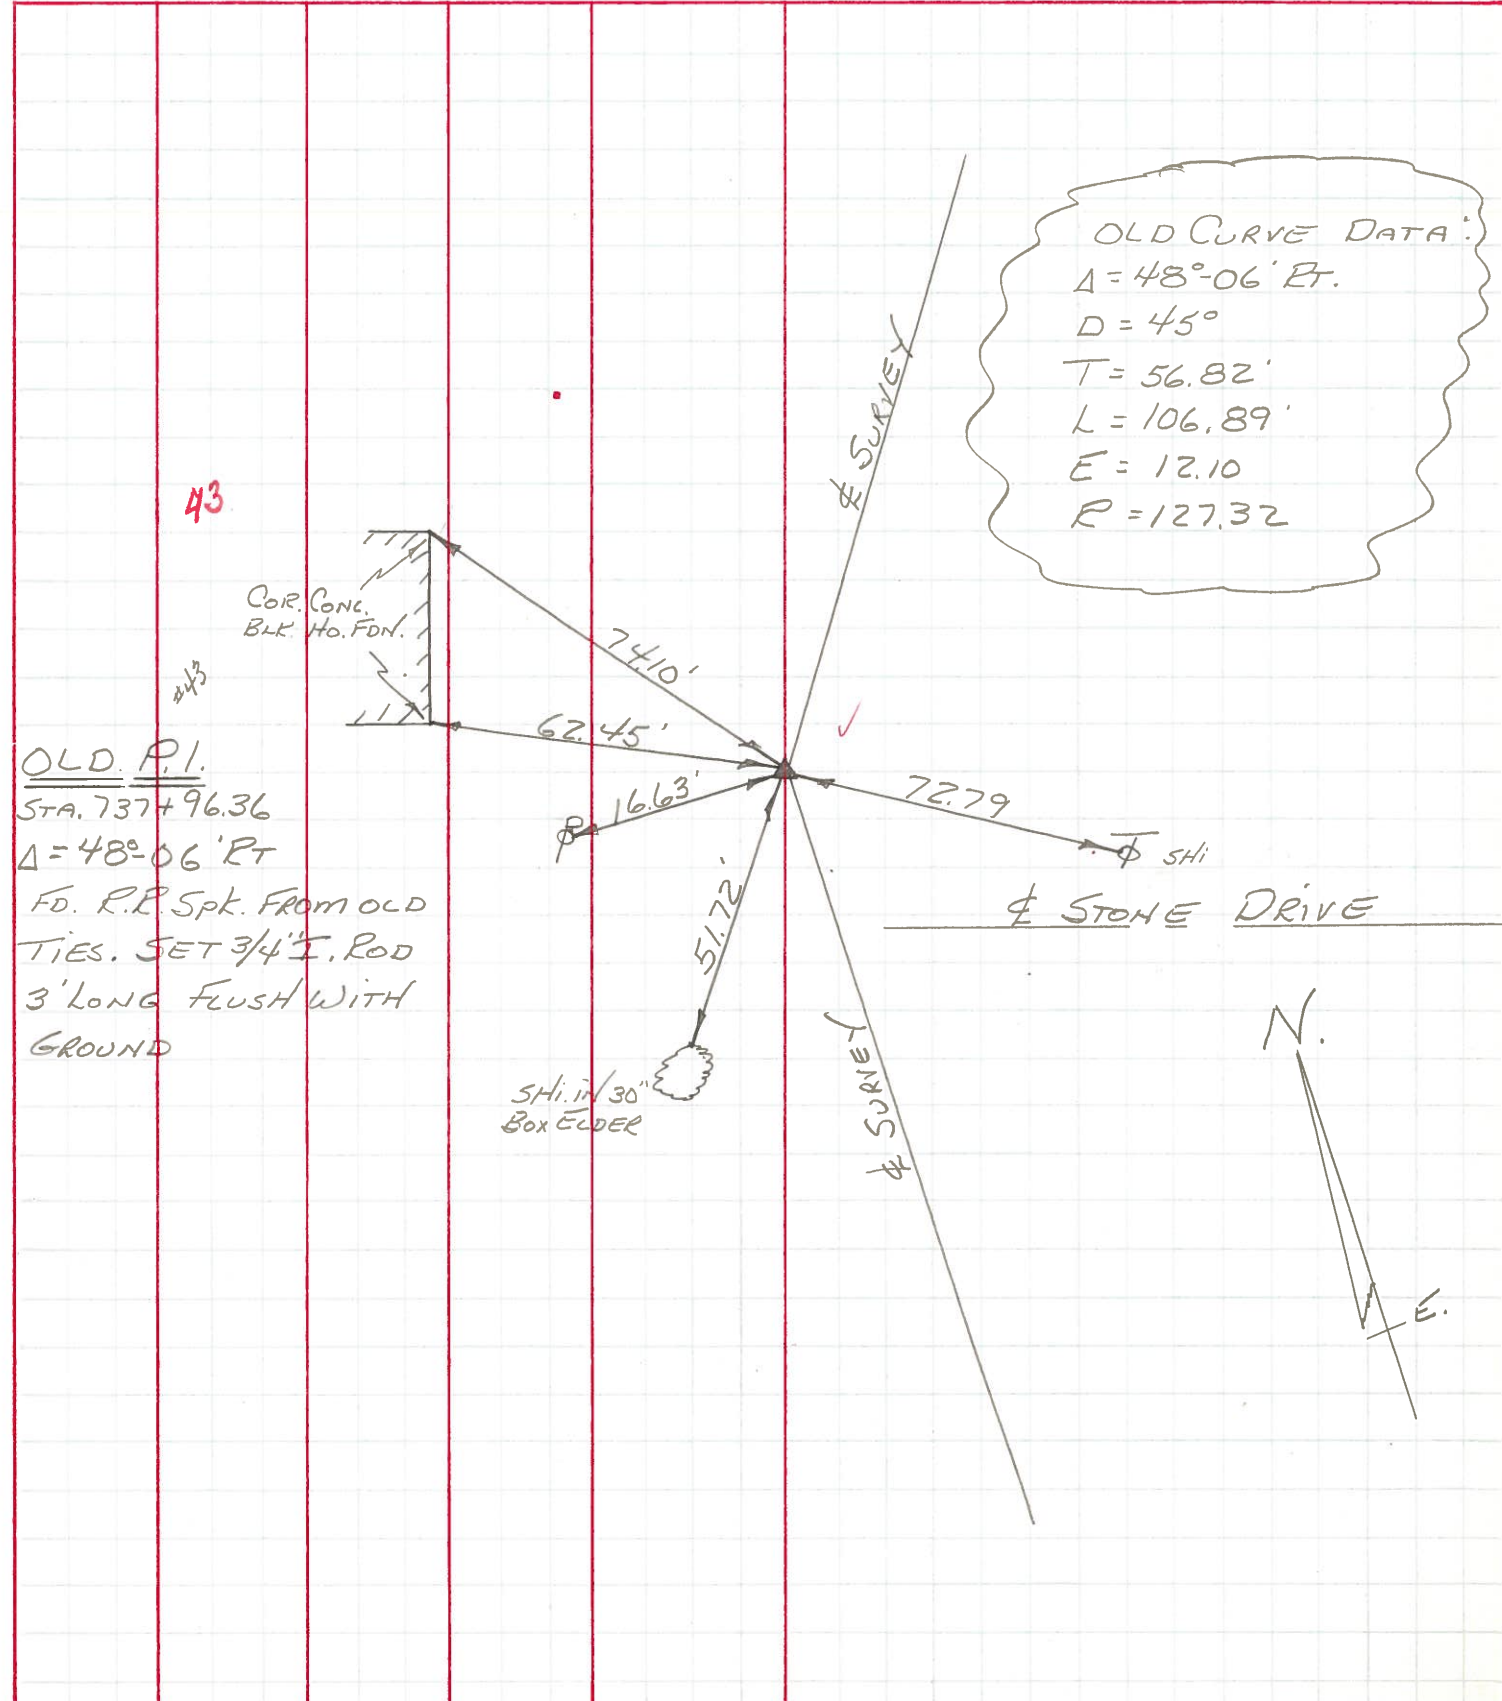

OLD CURVE DATA:
 $\Delta = 48^\circ - 06' \text{ Pt.}$
 $D = 45^\circ$
 $T = 56.82'$
 $L = 106.89'$
 $E = 12.10$
 $R = 127.32$

43
 #43
 COR. CONC. BLK. HO. FON.
 OLD P.I.
 STA. 737+96.36
 $\Delta = 48^\circ - 06' \text{ Pt}$
 FO. R.P. Spk. FROM OLD TIES. SET 3/4" I. ROD 3' LONG FLUSH WITH GROUND

3" I. in 30" BOX ELDER

STONE DRIVE

